


ORIGINAL SURVEY NOTE BOOK No. \_\_\_\_\_  
 SURVEYED BY \_\_\_\_\_  
 PLANNED BY \_\_\_\_\_  
 DRAWN BY \_\_\_\_\_  
 CHECKED BY \_\_\_\_\_

ORIGINAL SURVEY NOTE BOOK No. \_\_\_\_\_  
 SURVEYED BY \_\_\_\_\_  
 PLANNED BY \_\_\_\_\_  
 DRAWN BY \_\_\_\_\_  
 CHECKED BY \_\_\_\_\_

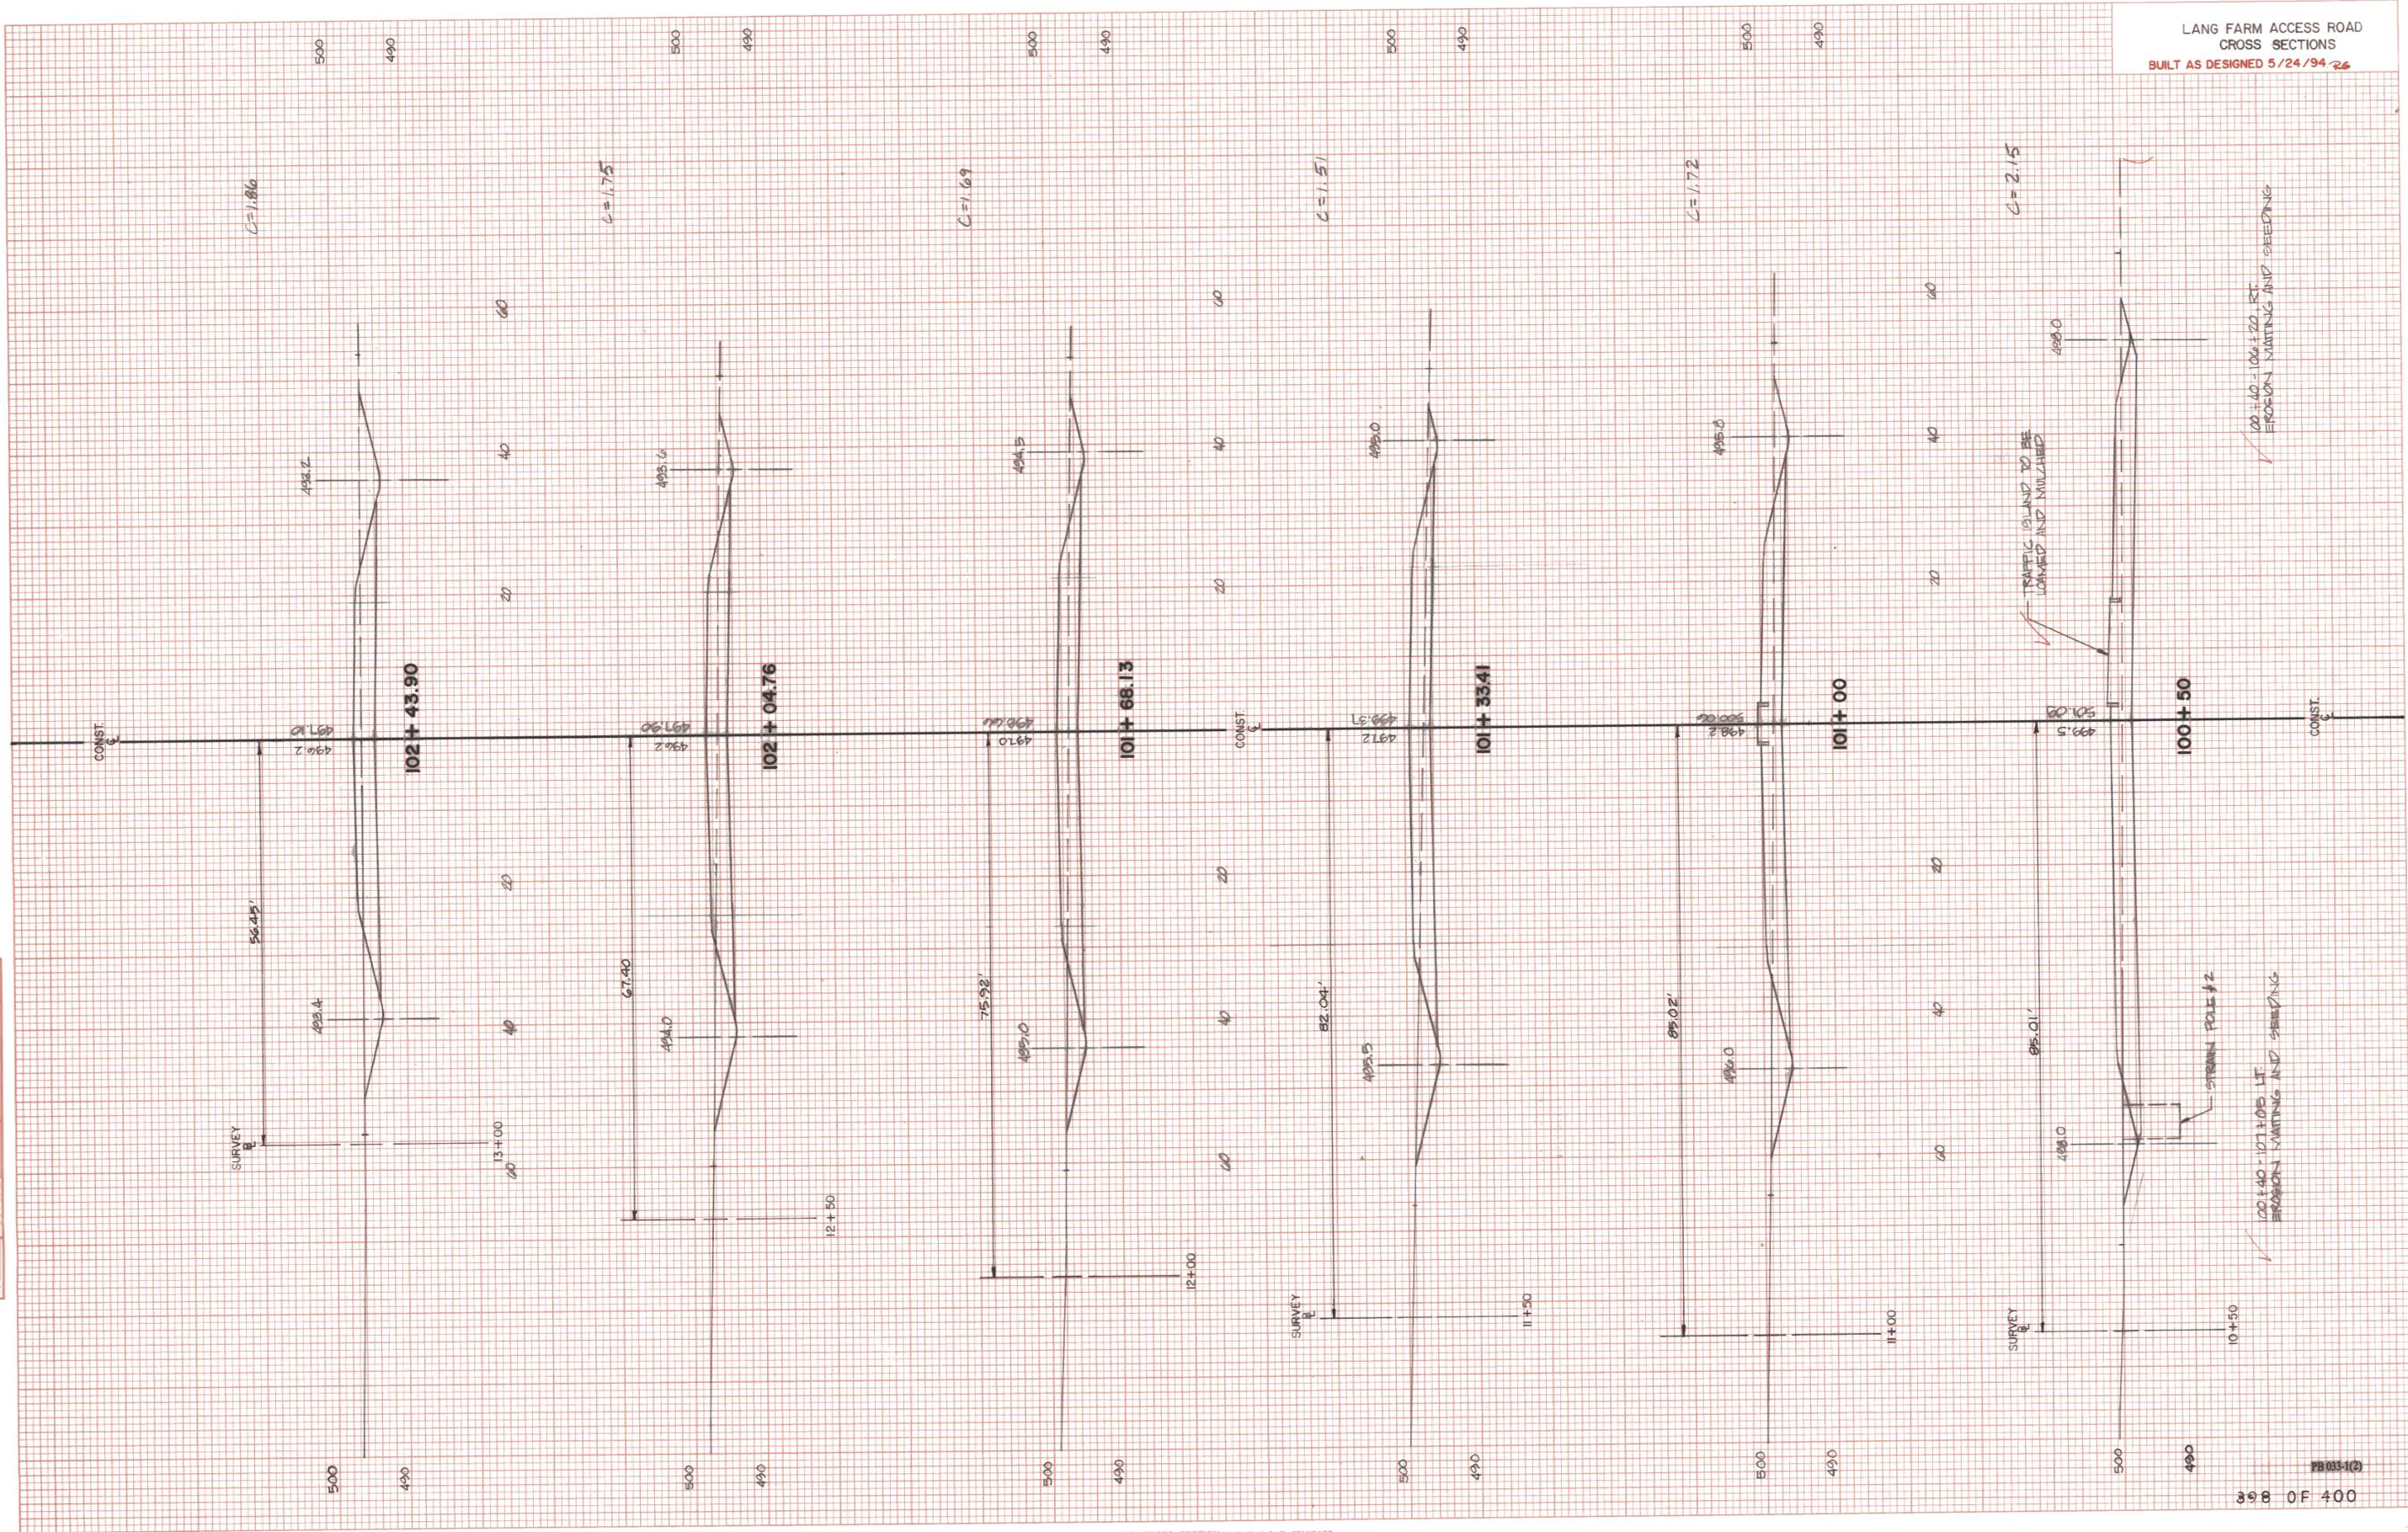

100+40-106+20 RT.  
EROSION MATING AND SEEDING

100+40-107+05 LT.  
EROSION MATING AND SEEDING