

TEMPORARY AND DURABLE 150 mm YELLOW LINE
 STA 0+080 TO 9+656 LT (SOLID)

TEMPORARY AND DURABLE 150 mm WHITE LINE
 STA 0+080 TO 9+656 C.L. (DASHED)
 STA 0+080 TO 9+656 RT (SOLID)

STEEL BEAM GUARDRAIL
 REFER TO SHEET 7 FOR LOCATIONS
 AND QUANTITIES OF GUARDRAIL ITEMS.

BITUMINOUS CONCRETE GUTTERS
 AND TRAFFIC ISLANDS
 REFER TO SHEET 3 FOR PAVING
 DETAILS AND SHEET 7 FOR LOC-
 ATIONS AND QUANTITIES.

CHANGING ELEV. OF DI, CB, MH
 REHABILITATION OF DI, CB, OR MH, CLASS I


INTERSTATE 89 NORTHBOUND

STA 0+137 RT	STA 6+655 RT
STA 0+226 RT	STA 6+792 RT
STA 0+278 RT	STA 6+945 RT
STA 0+362 RT	STA 7+797 RT
STA 1+610 RT	STA 8+336 RT
STA 1+670 RT	STA 8+412 RT
STA 3+773 RT	STA 8+519 RT
STA 4+034 RT	STA 8+611 RT
STA 4+126 RT	STA 9+217 RT
STA 4+232 RT	STA 9+297 RT
STA 4+309 RT	STA 9+372 RT
STA 5+452 RT	STA 9+577 RT

U-TURN LOCATIONS
 (REFER TO U-TURN PAVING
 DETAILS ON SHEET 3)

STA. 0+169 (MM 0.108)
 STA. 1+360 (MM 0.845)
 STA. 1+878 (MM 1.155)
 STA. 5+179 (MM 3.218)
 STA. 6+801 (MM 4.226)

INTERSTATE ROUTE 89
STA 0+080.467
(MM 0.050)
BEGIN PROJECT
AC IM 089-1(51)

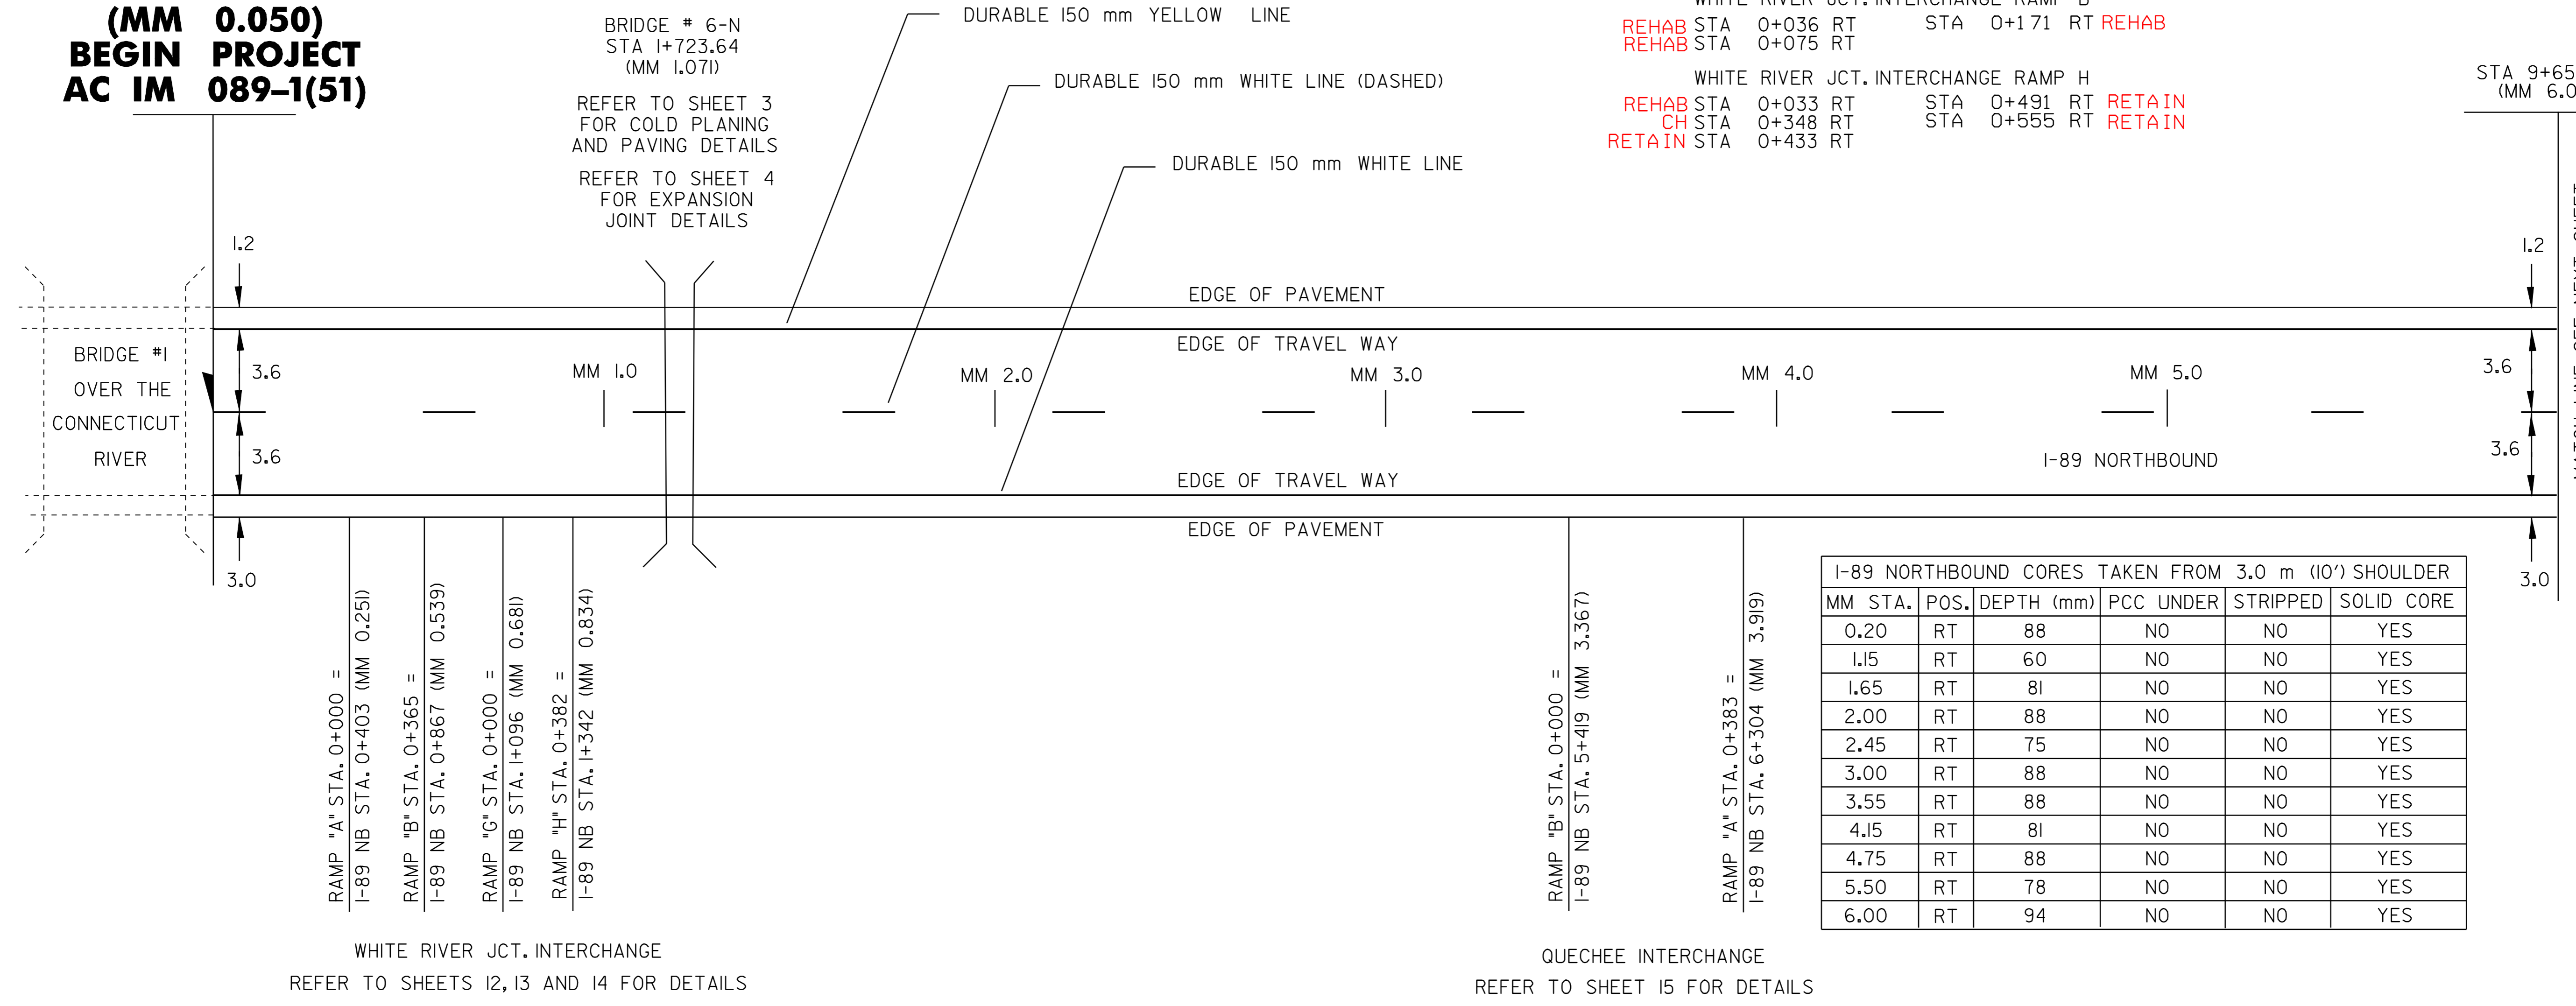

WHITE RIVER JCT. INTERCHANGE RAMP A/RAMP C

REHAB STA 0+035 RT	STA 0+232 LT	REHAB
REHAB STA 0+111 RT	STA 0+278 RT	CH
REHAB STA 0+186 RT	STA 0+585 RT	REHAB

WHITE RIVER JCT. INTERCHANGE RAMP B

REHAB STA 0+036 RT	STA 0+171 RT	REHAB
REHAB STA 0+075 RT		

WHITE RIVER JCT. INTERCHANGE RAMP H

REHAB STA 0+033 RT	STA 0+491 RT	REHAB
CH STA 0+348 RT	STA 0+555 RT	REHAB
REHAB STA 0+433 RT		

I-89 NORTHBOUND CORES TAKEN FROM 3.0 m (10') SHOULDER

MM STA.	POS.	DEPTH (mm)	PCC UNDER	STRIPPED	SOLID CORE
0.20	RT	88	NO	NO	YES
1.15	RT	60	NO	NO	YES
1.65	RT	81	NO	NO	YES
2.00	RT	88	NO	NO	YES
2.45	RT	75	NO	NO	YES
3.00	RT	88	NO	NO	YES
3.55	RT	88	NO	NO	YES
4.15	RT	81	NO	NO	YES
4.75	RT	88	NO	NO	YES
5.50	RT	78	NO	NO	YES
6.00	RT	94	NO	NO	YES

WHITE RIVER JCT. INTERCHANGE
 REFER TO SHEETS 12, 13 AND 14 FOR DETAILS

QUECHEE INTERCHANGE
 REFER TO SHEET 15 FOR DETAILS

NOTE: ALL DIMENSIONS IN METERS EXCEPT AS INDICATED

NOT TO SCALE

PAVING PROJECT LAYOUT #1	PROJECT: HARTFORD - SHARON	PROJECT NO.: AC IM 089-1(51)
	DESIGN FILE NAME: /pave/01a028/p01a028.dgn	
	IPARM FILE NAME: p01a028p01.i	PLOT DATE: 31-JAN-2006 13:
	SURVEYED BY: CLD_ENGINEERS_INC	SURVEY DATE: 9/01
SQUAD LEADER: WRH	DRAWN BY: MPS	SHEET: 8 OF 21