

**TEMPORARY AND DURABLE 150 mm YELLOW LINE**

WHITE RIVER JCT. INTERCHANGE  
 RAMP A/RAMP C  
 NORTHBOUND OFF RAMP STA. 0+156 TO 0+395 LT (RAMP A STATIONS) (SOLID)  
 NORTHBOUND OFF RAMP STA. 0+395 TO 0+670 LT (RAMP A STATIONS) (SOLID)

**TEMPORARY AND DURABLE 150 mm WHITE LINE**

WHITE RIVER JCT. INTERCHANGE  
 RAMP A/RAMP C  
 NORTHBOUND OFF RAMP STA. 0+000 TO 0+106 RT (RAMP A STATIONS) (DOTTED)  
 NORTHBOUND OFF RAMP STA. 0+106 TO 0+670 RT (RAMP A STATIONS) (SOLID)

**TEMPORARY AND DURABLE 300 mm WHITE LINE**













WHITE RIVER JCT. INTERCHANGE  
 RAMP A/RAMP C  
 NORTHBOUND OFF RAMP STA. 0+121 TO 0+156 LT (RAMP A STA.)  
 (GORE AREA W/DIAGONALS)  
 NORTHBOUND OFF RAMP STA. 1+022 TO 1+049 RT (RAMP C STA.)  
 (GORE AREA)

~~NORTHBOUND OFF RAMP STA. 1+297 TO 1+333 LT (RAMP C STA.)  
 (GORE AREA W/ I-91 NB)~~



**TEMPORARY AND DURABLE LETTER OR SYMBOL**

WHITE RIVER JCT. INTERCHANGE  
 RAMP A  
 NORTHBOUND OFF RAMP A STA. 0+275 "YIELD AHEAD"  
 NORTHBOUND OFF RAMP A STA. 0+385 "YIELD LINE" (5 - ▾)

REMOVING SIGNS  
 AS SHOWN = 5

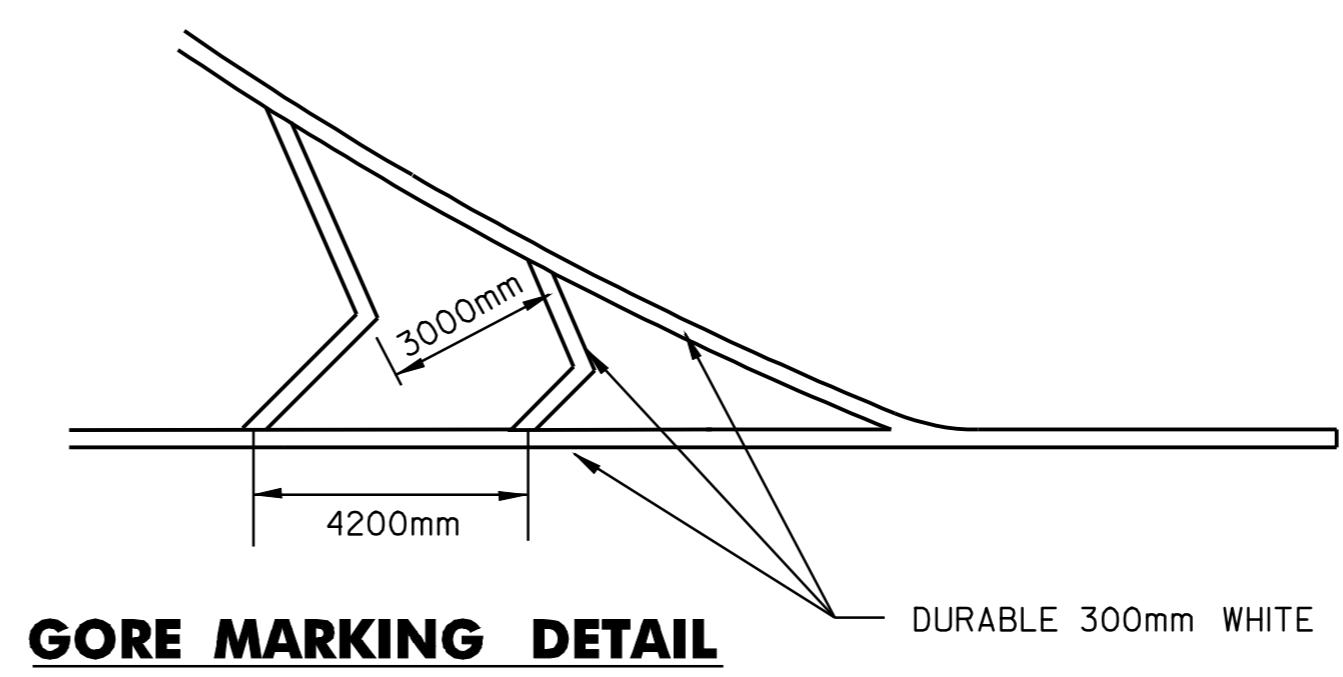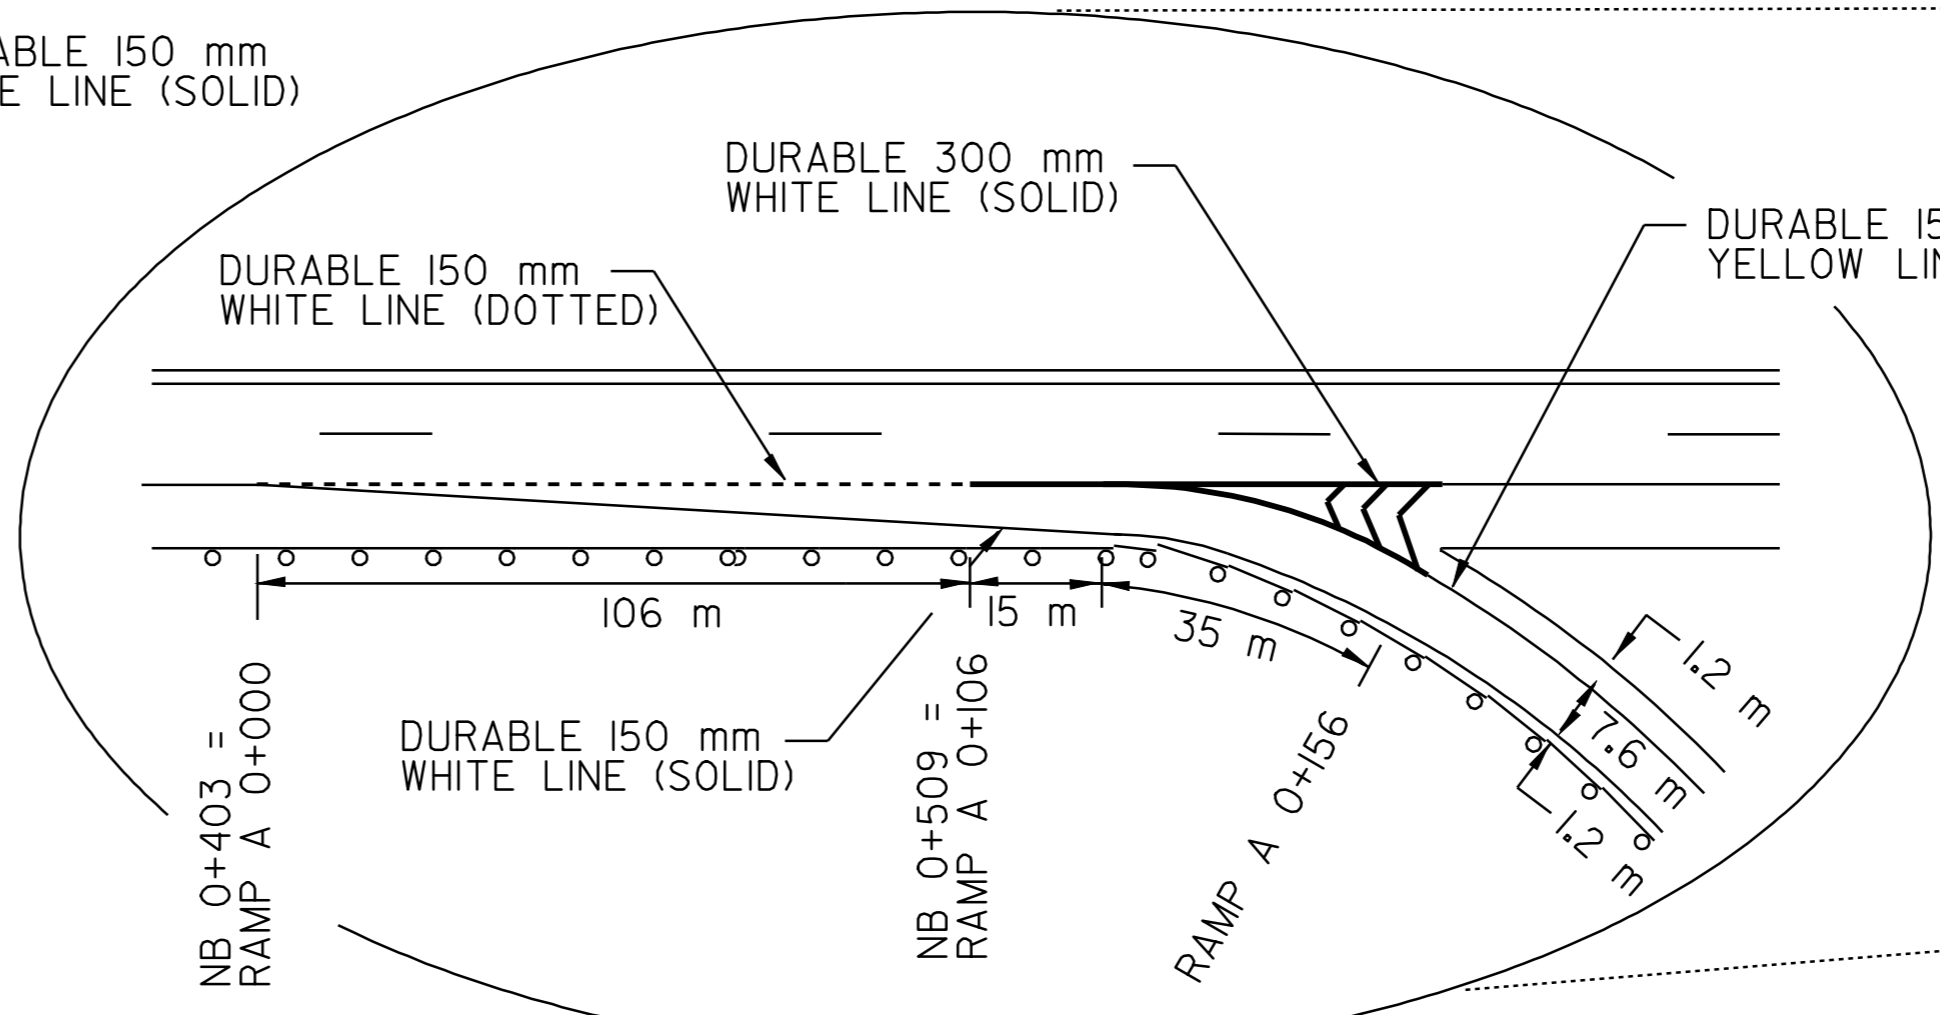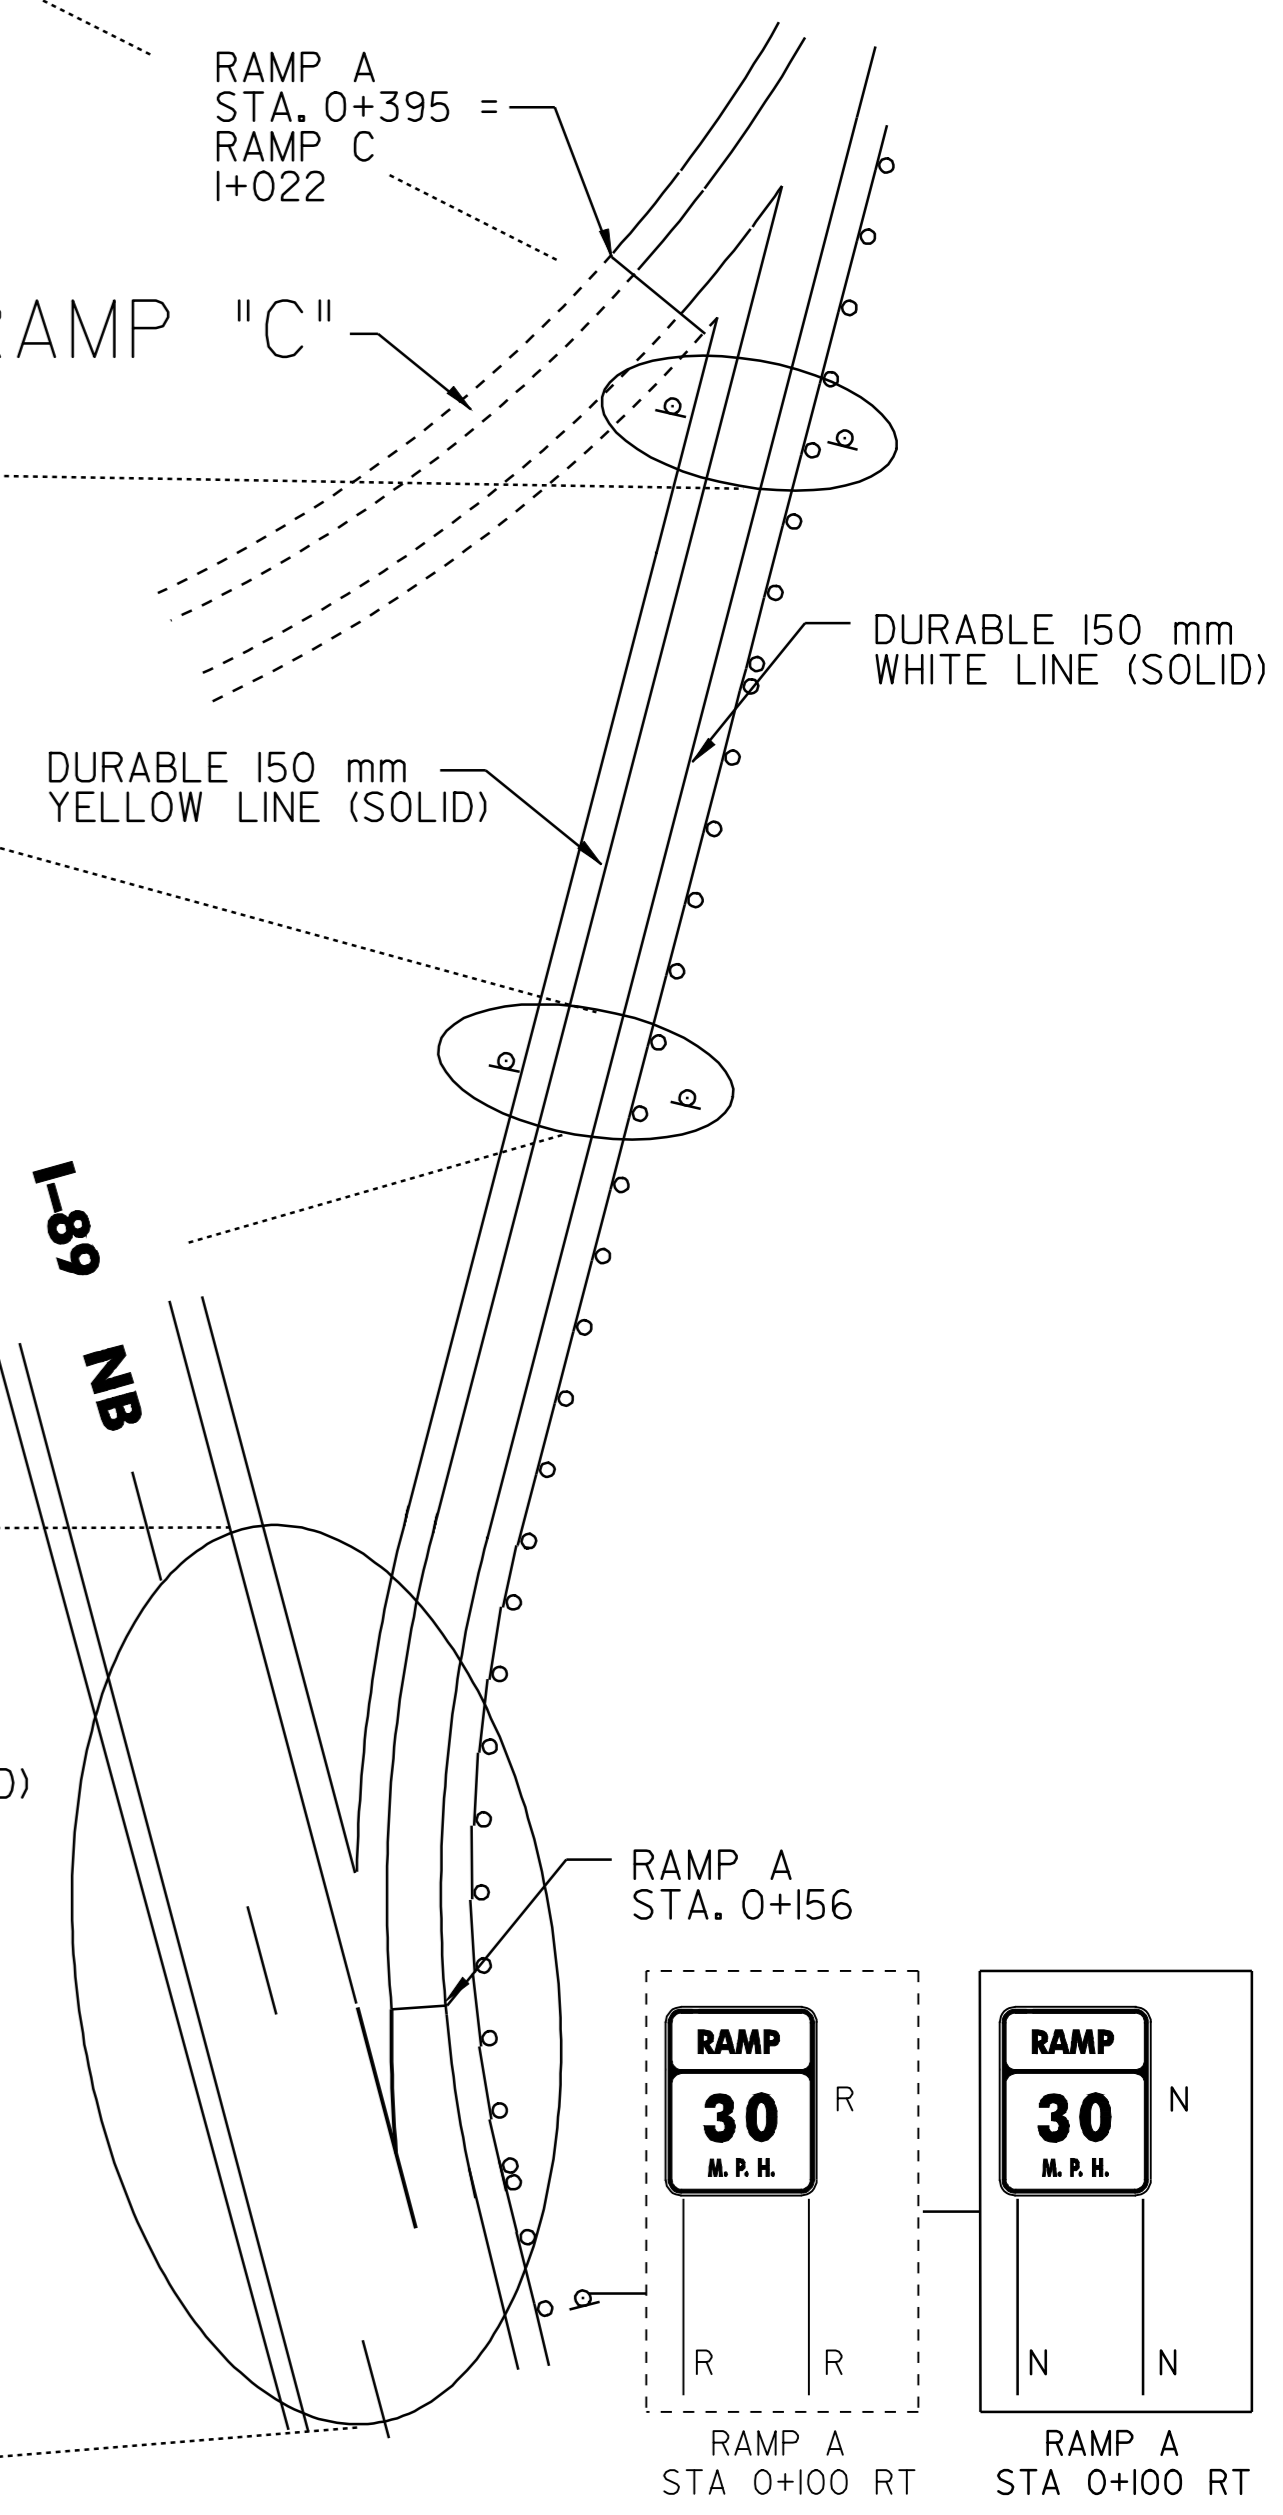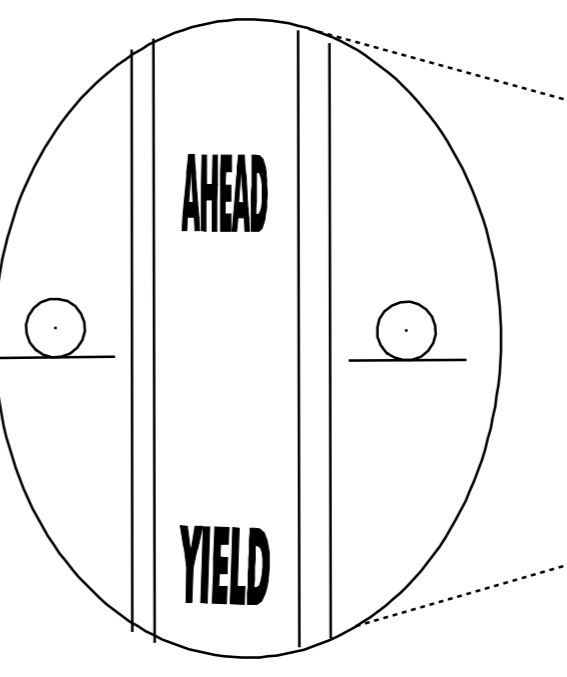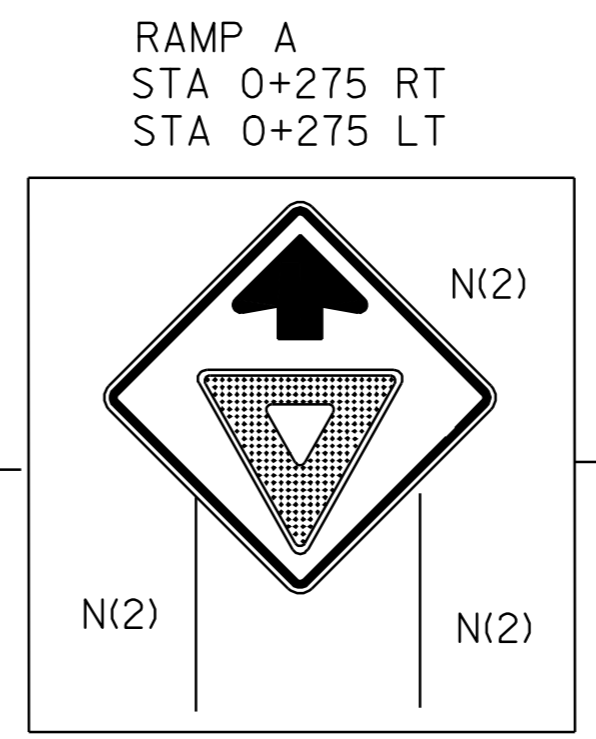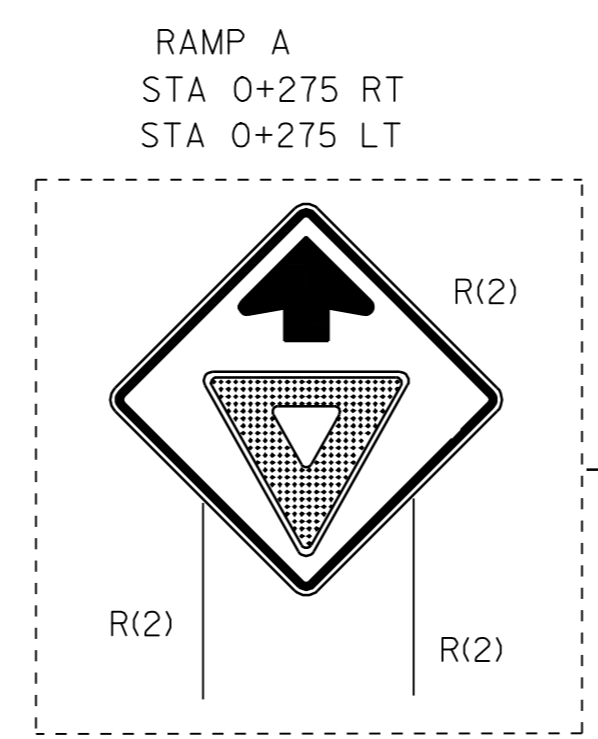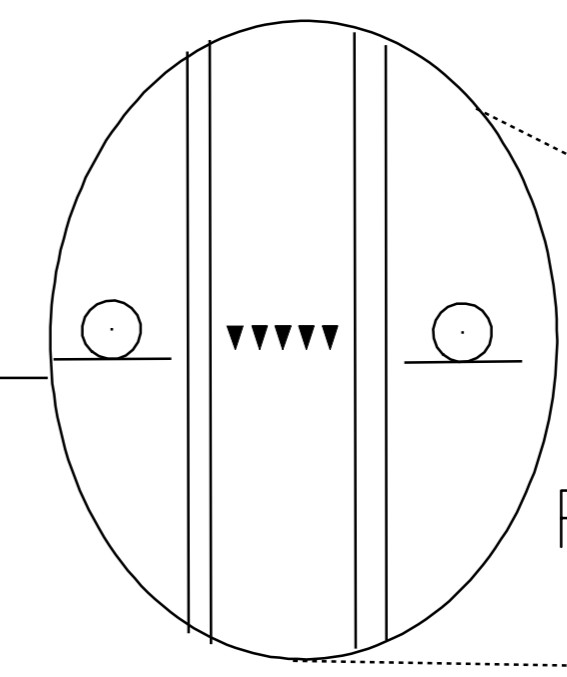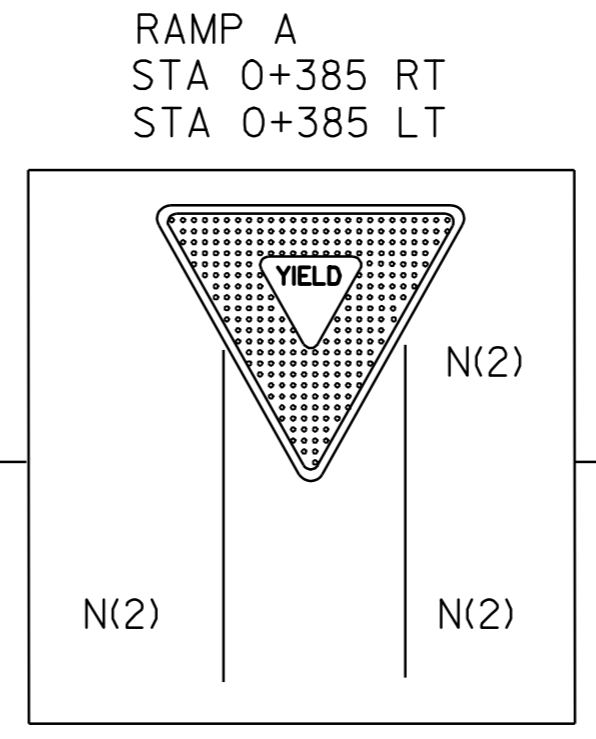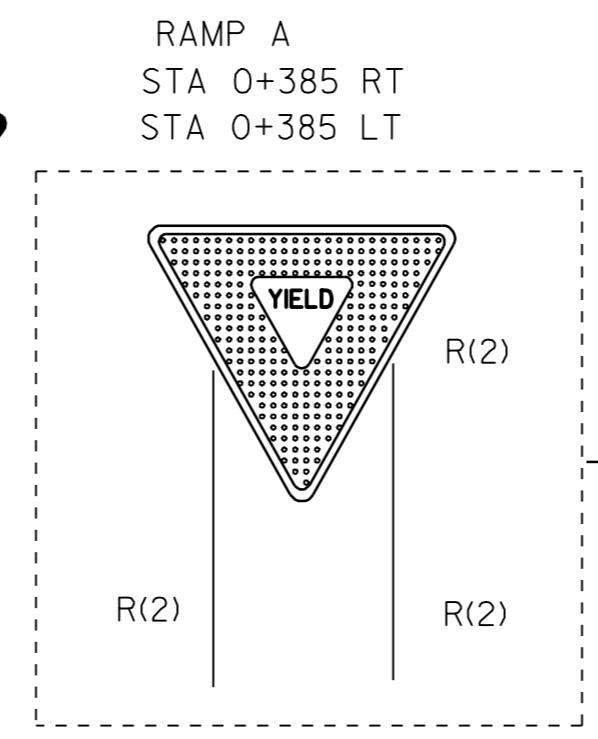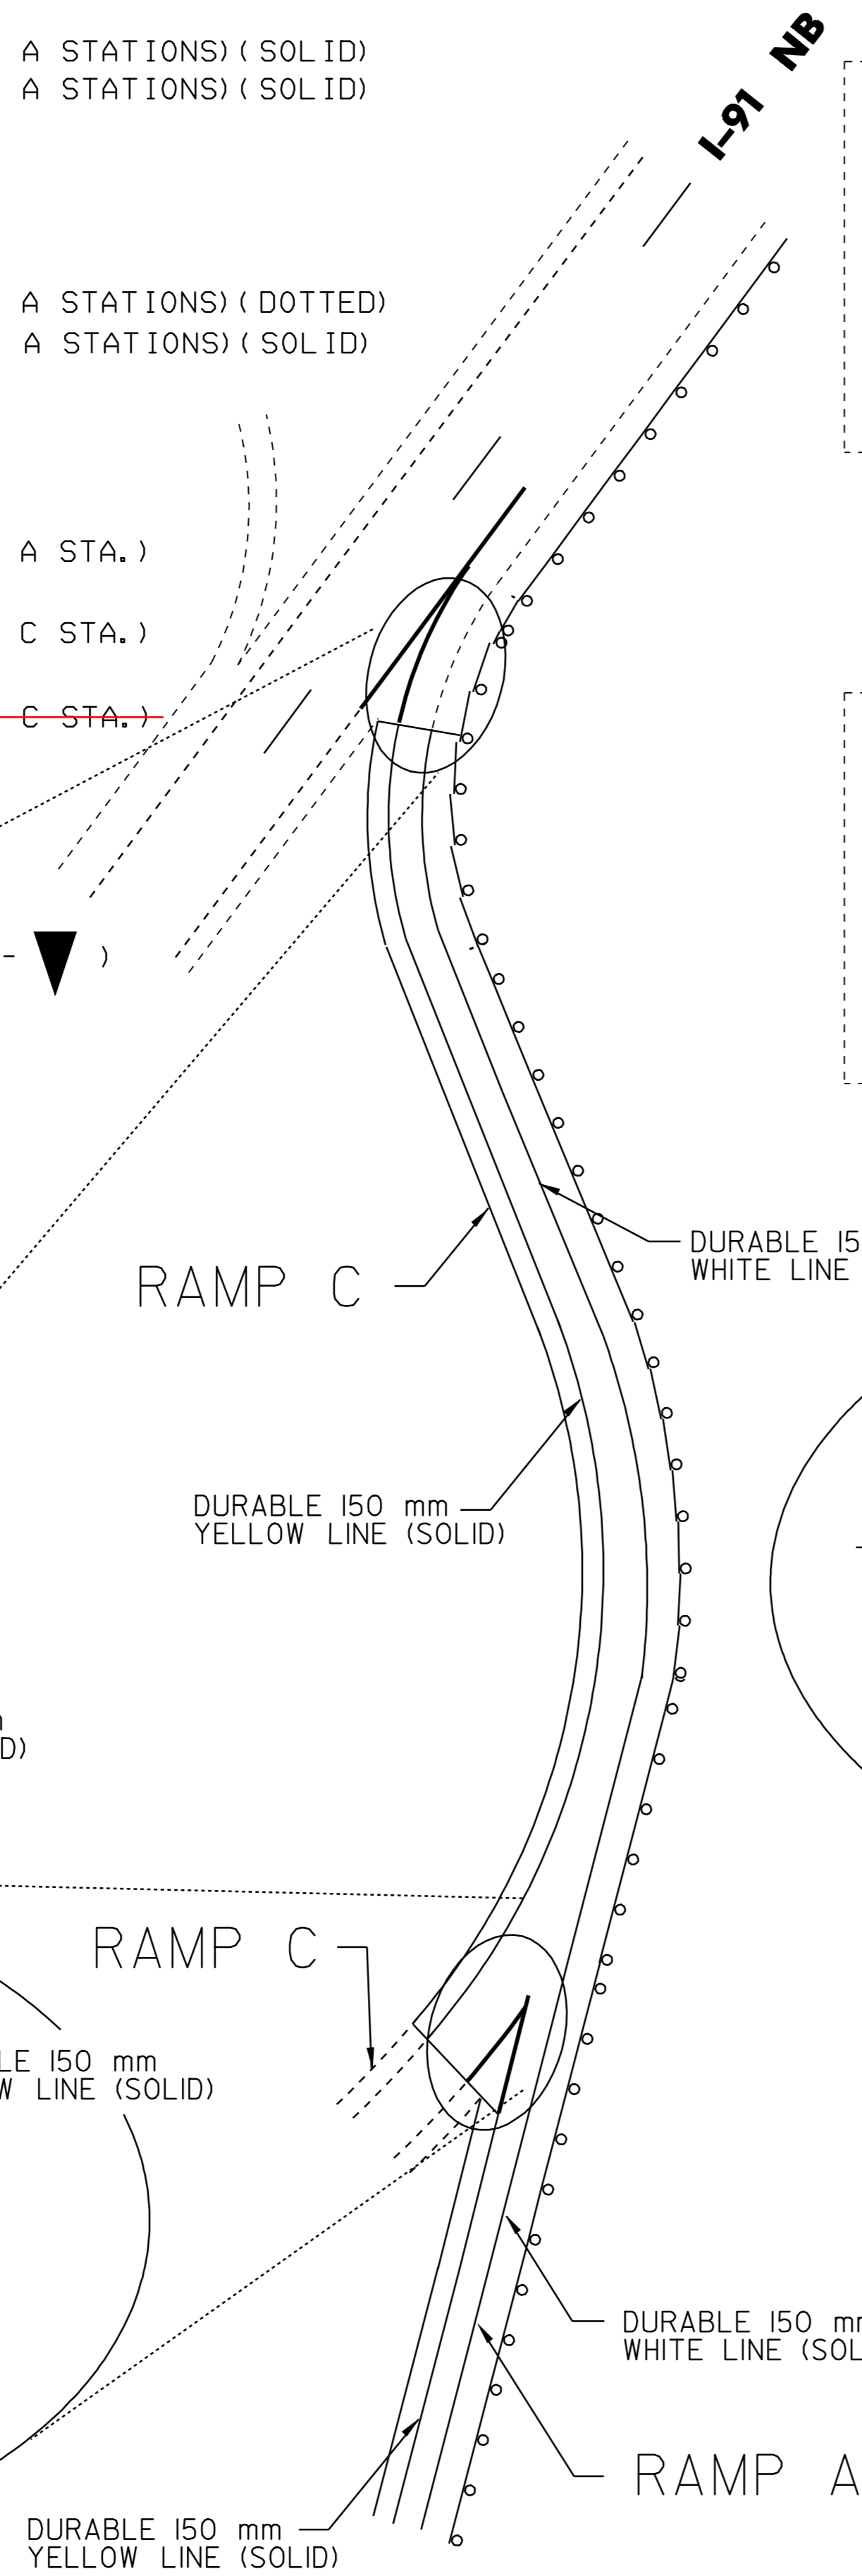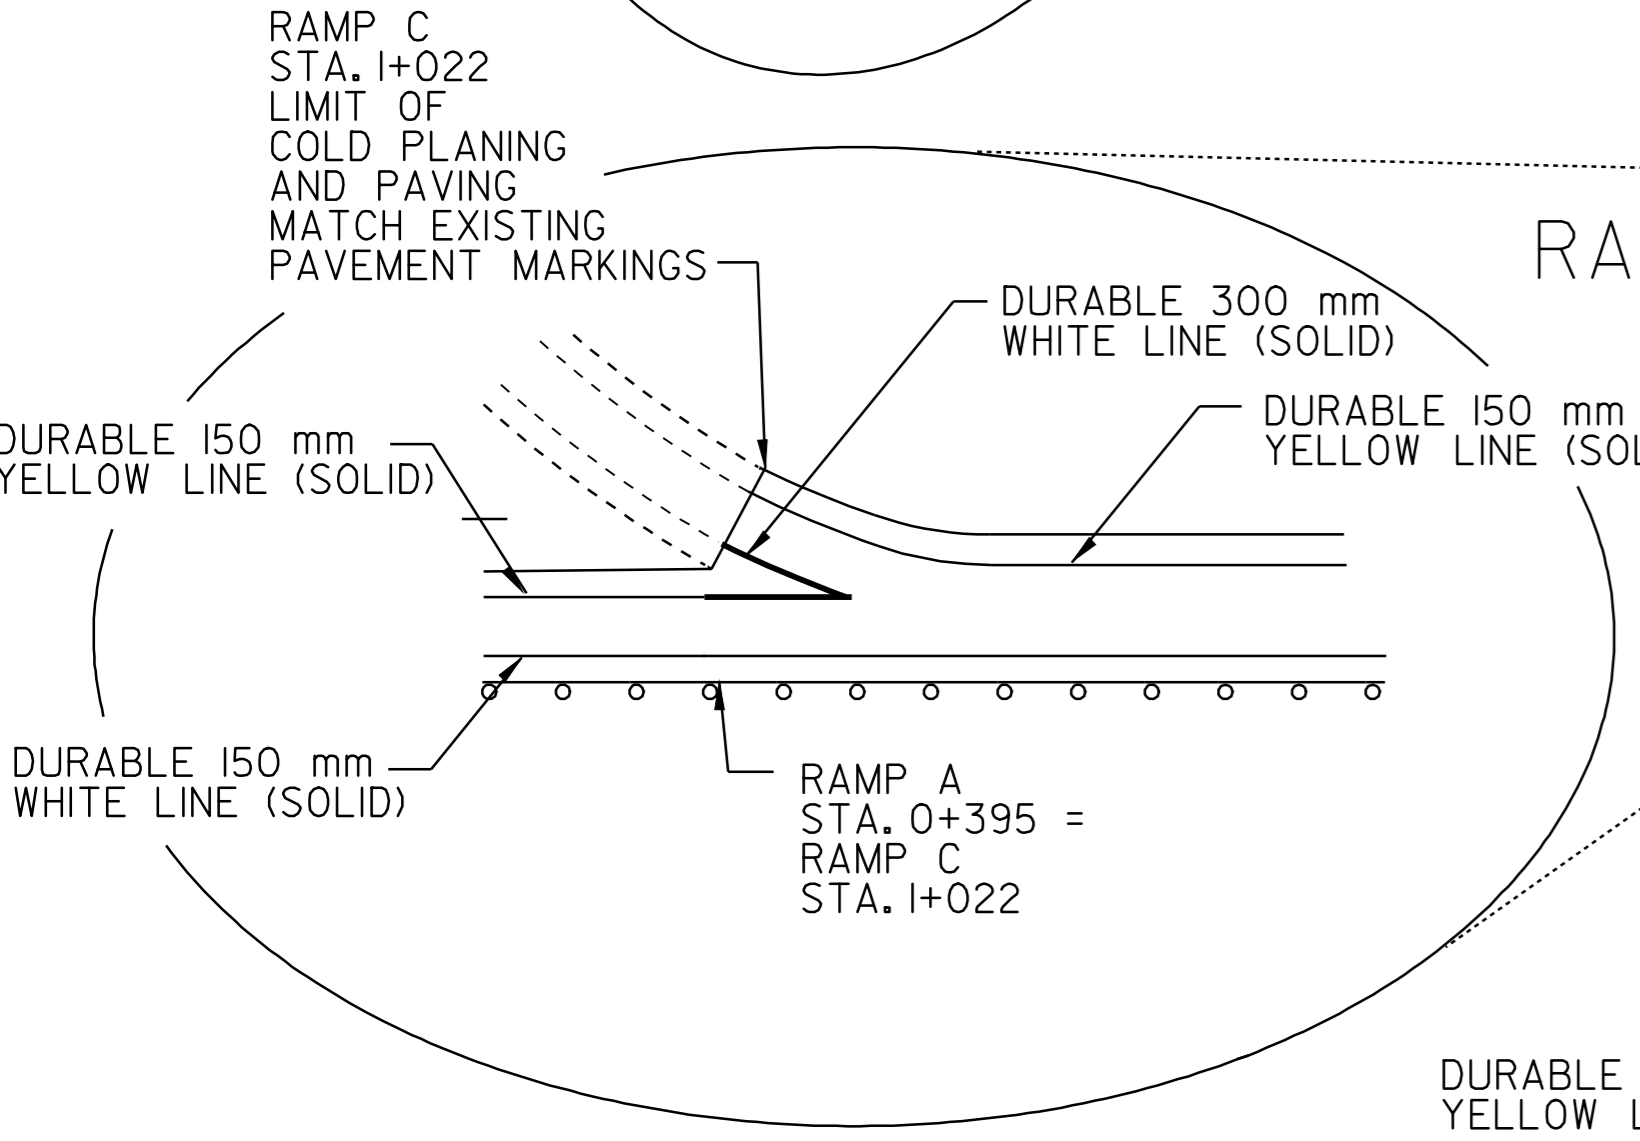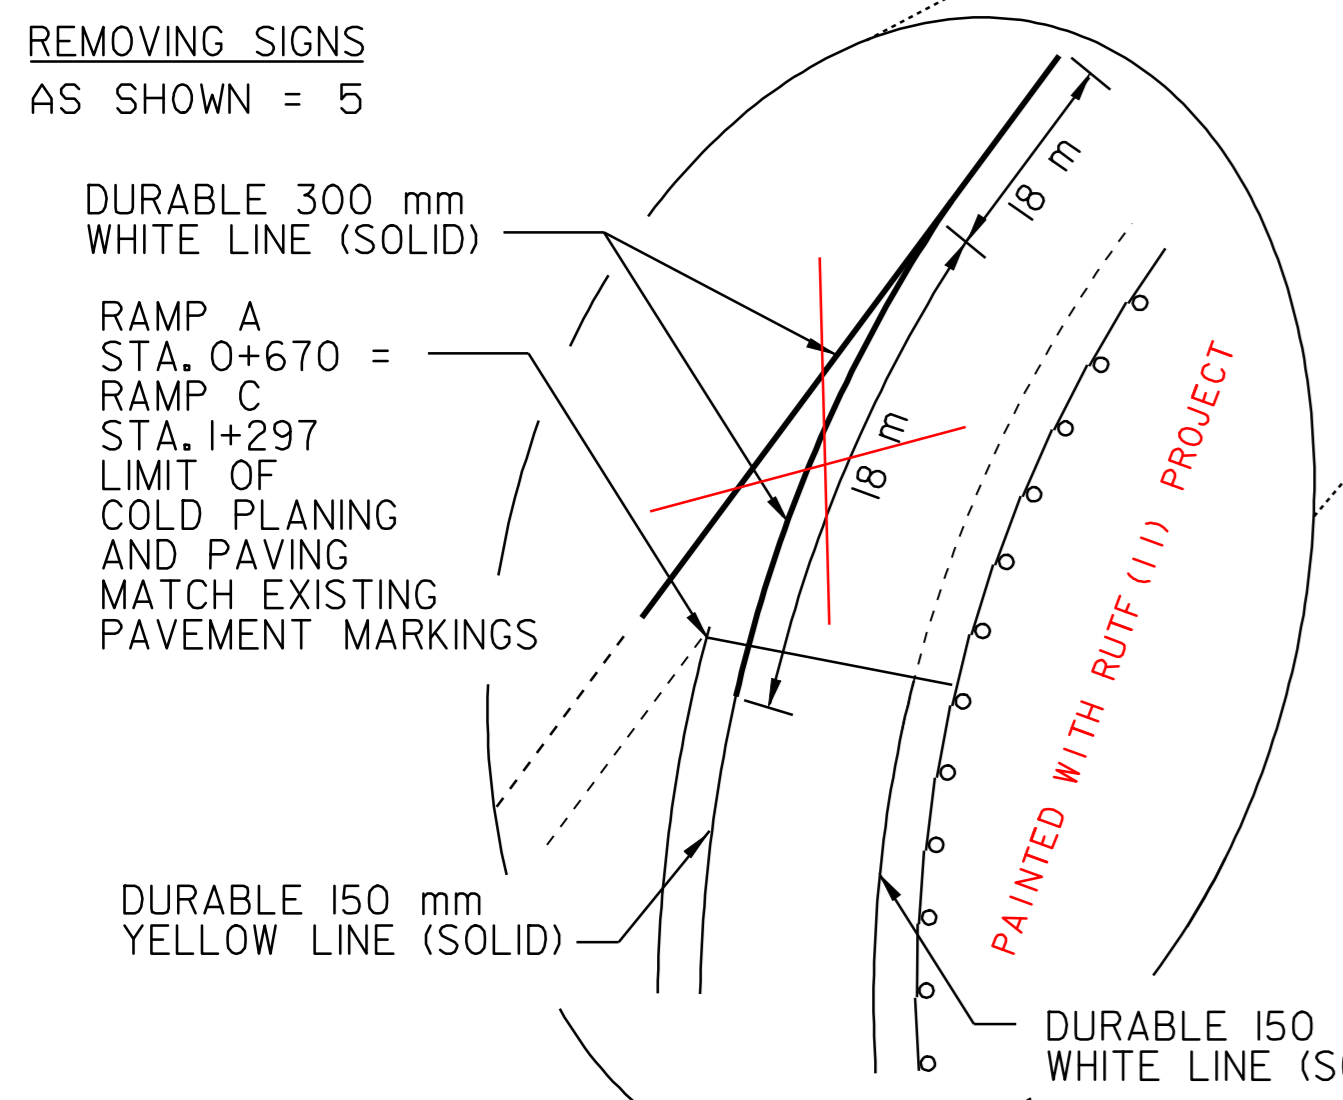

**WHITE RIVER JCT. INTERCHANGE  
 I-89 - RAMP A  
 NORTHBOUND OFF RAMP**

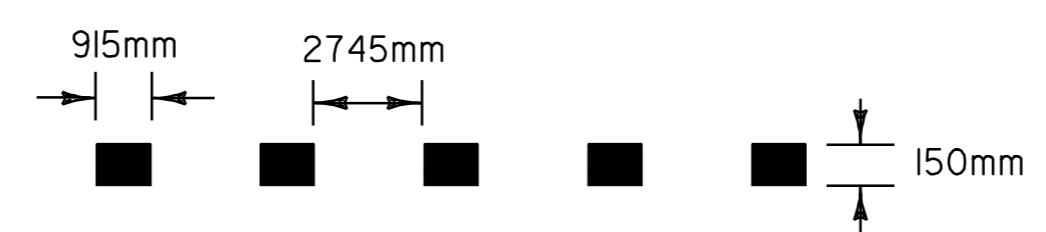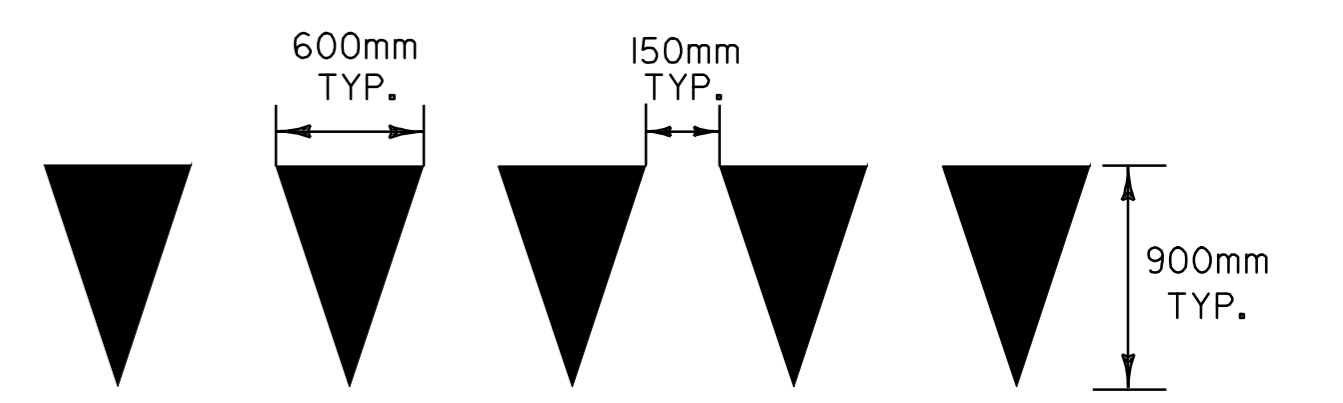

**WHITE YIELD LINE DETAILS**  
 TO BE INSTALLED AS INDICATED IN THE PROJECT PLANS OR AS DIRECTED BY THE RESIDENT ENGINEER. TO BE PAID AS ONE LETTER OR SYMBOL PER TRIANGLE.

**DOTTED WHITE LINE DETAILS**  
 TO BE INSTALLED AS INDICATED IN THE PROJECT PLANS OR AS DIRECTED BY THE RESIDENT ENGINEER.

<b>RAMP DETAIL #1</b>	PROJECT:	HARTFORD - SHARON	PROJECT NO.:	AC IM 089-(51)
	DESIGN FILE NAME:	z_pave/01a028/p01a028.dgn	PLOT DATE:	31-JAN-2006 13:
	IPARM FILE NAME:	p01a028int1.i	SURVEY DATE:	9/01
	SQUAD LEADER:	WRH	DRAWN BY:	MPS
			SHEET:	12 OF 21

REFER TO STANDARDS E-191 AND E-192 FOR ADDITIONAL DETAILS  
 NOTE: ALL DIMENSIONS IN METERS EXCEPT AS INDICATED. DETAILS NOT TO SCALE