
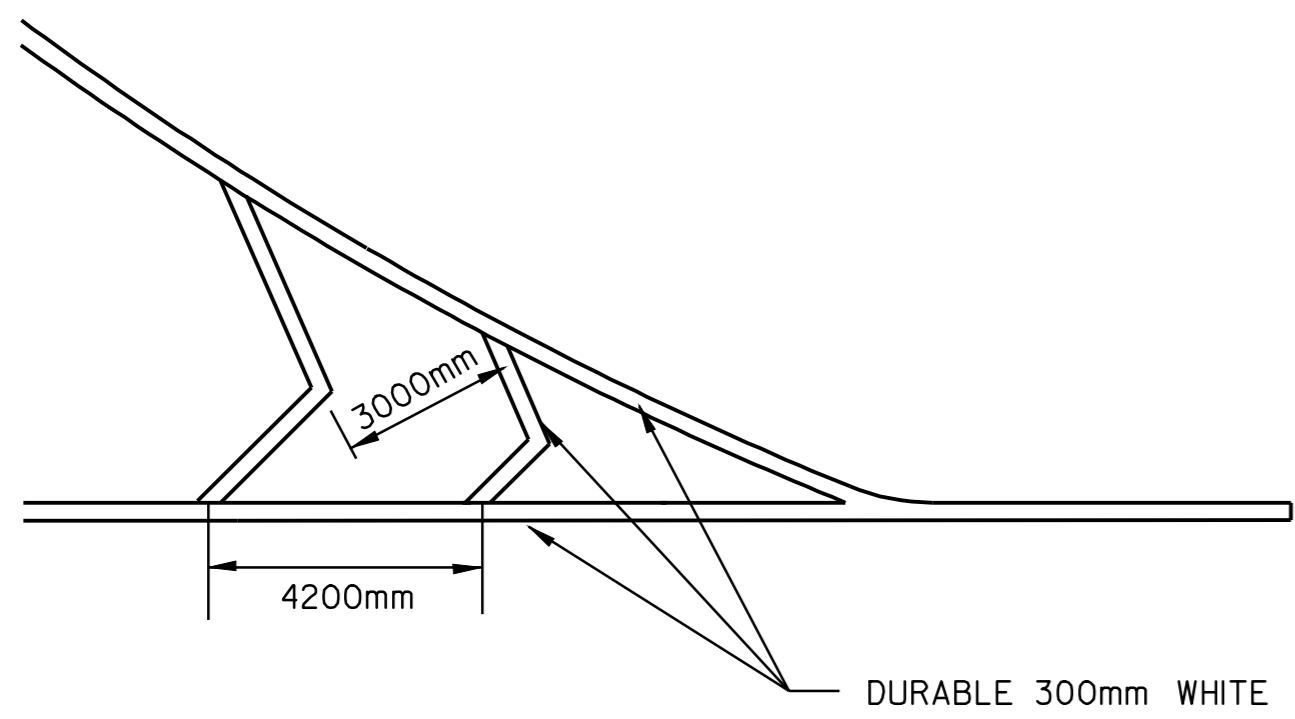


TEMPORARY AND DURABLE 150 mm YELLOW LINE
 WHITE RIVER JCT, INTERCHANGE
 RAMP H
 NORTHBOUND ON RAMP STA. 0+000 TO 0+336 LT (SOLID)

TEMPORARY AND DURABLE 150 mm WHITE LINE
 WHITE RIVER JCT, INTERCHANGE
 RAMP H
 NORTHBOUND ON RAMP STA. 0+000 TO 0+382 RT (SOLID)
 NORTHBOUND ON RAMP STA. 0+382 TO 0+444 RT (DASHED)

TEMPORARY AND DURABLE 300 mm WHITE LINE
 WHITE RIVER JCT, INTERCHANGE
 RAMP H
 NORTHBOUND ON RAMP STA. 0+336 TO 0+382 LT (GORE AREA)
~~NORTHBOUND ON RAMP STA. 0+000 LT (GORE AREA W/DIAG. AT I-91 SB)~~

WHITE RIVER JCT. INTERCHANGE
I-89 - RAMP H
SOUTHBOUND ON RAMP

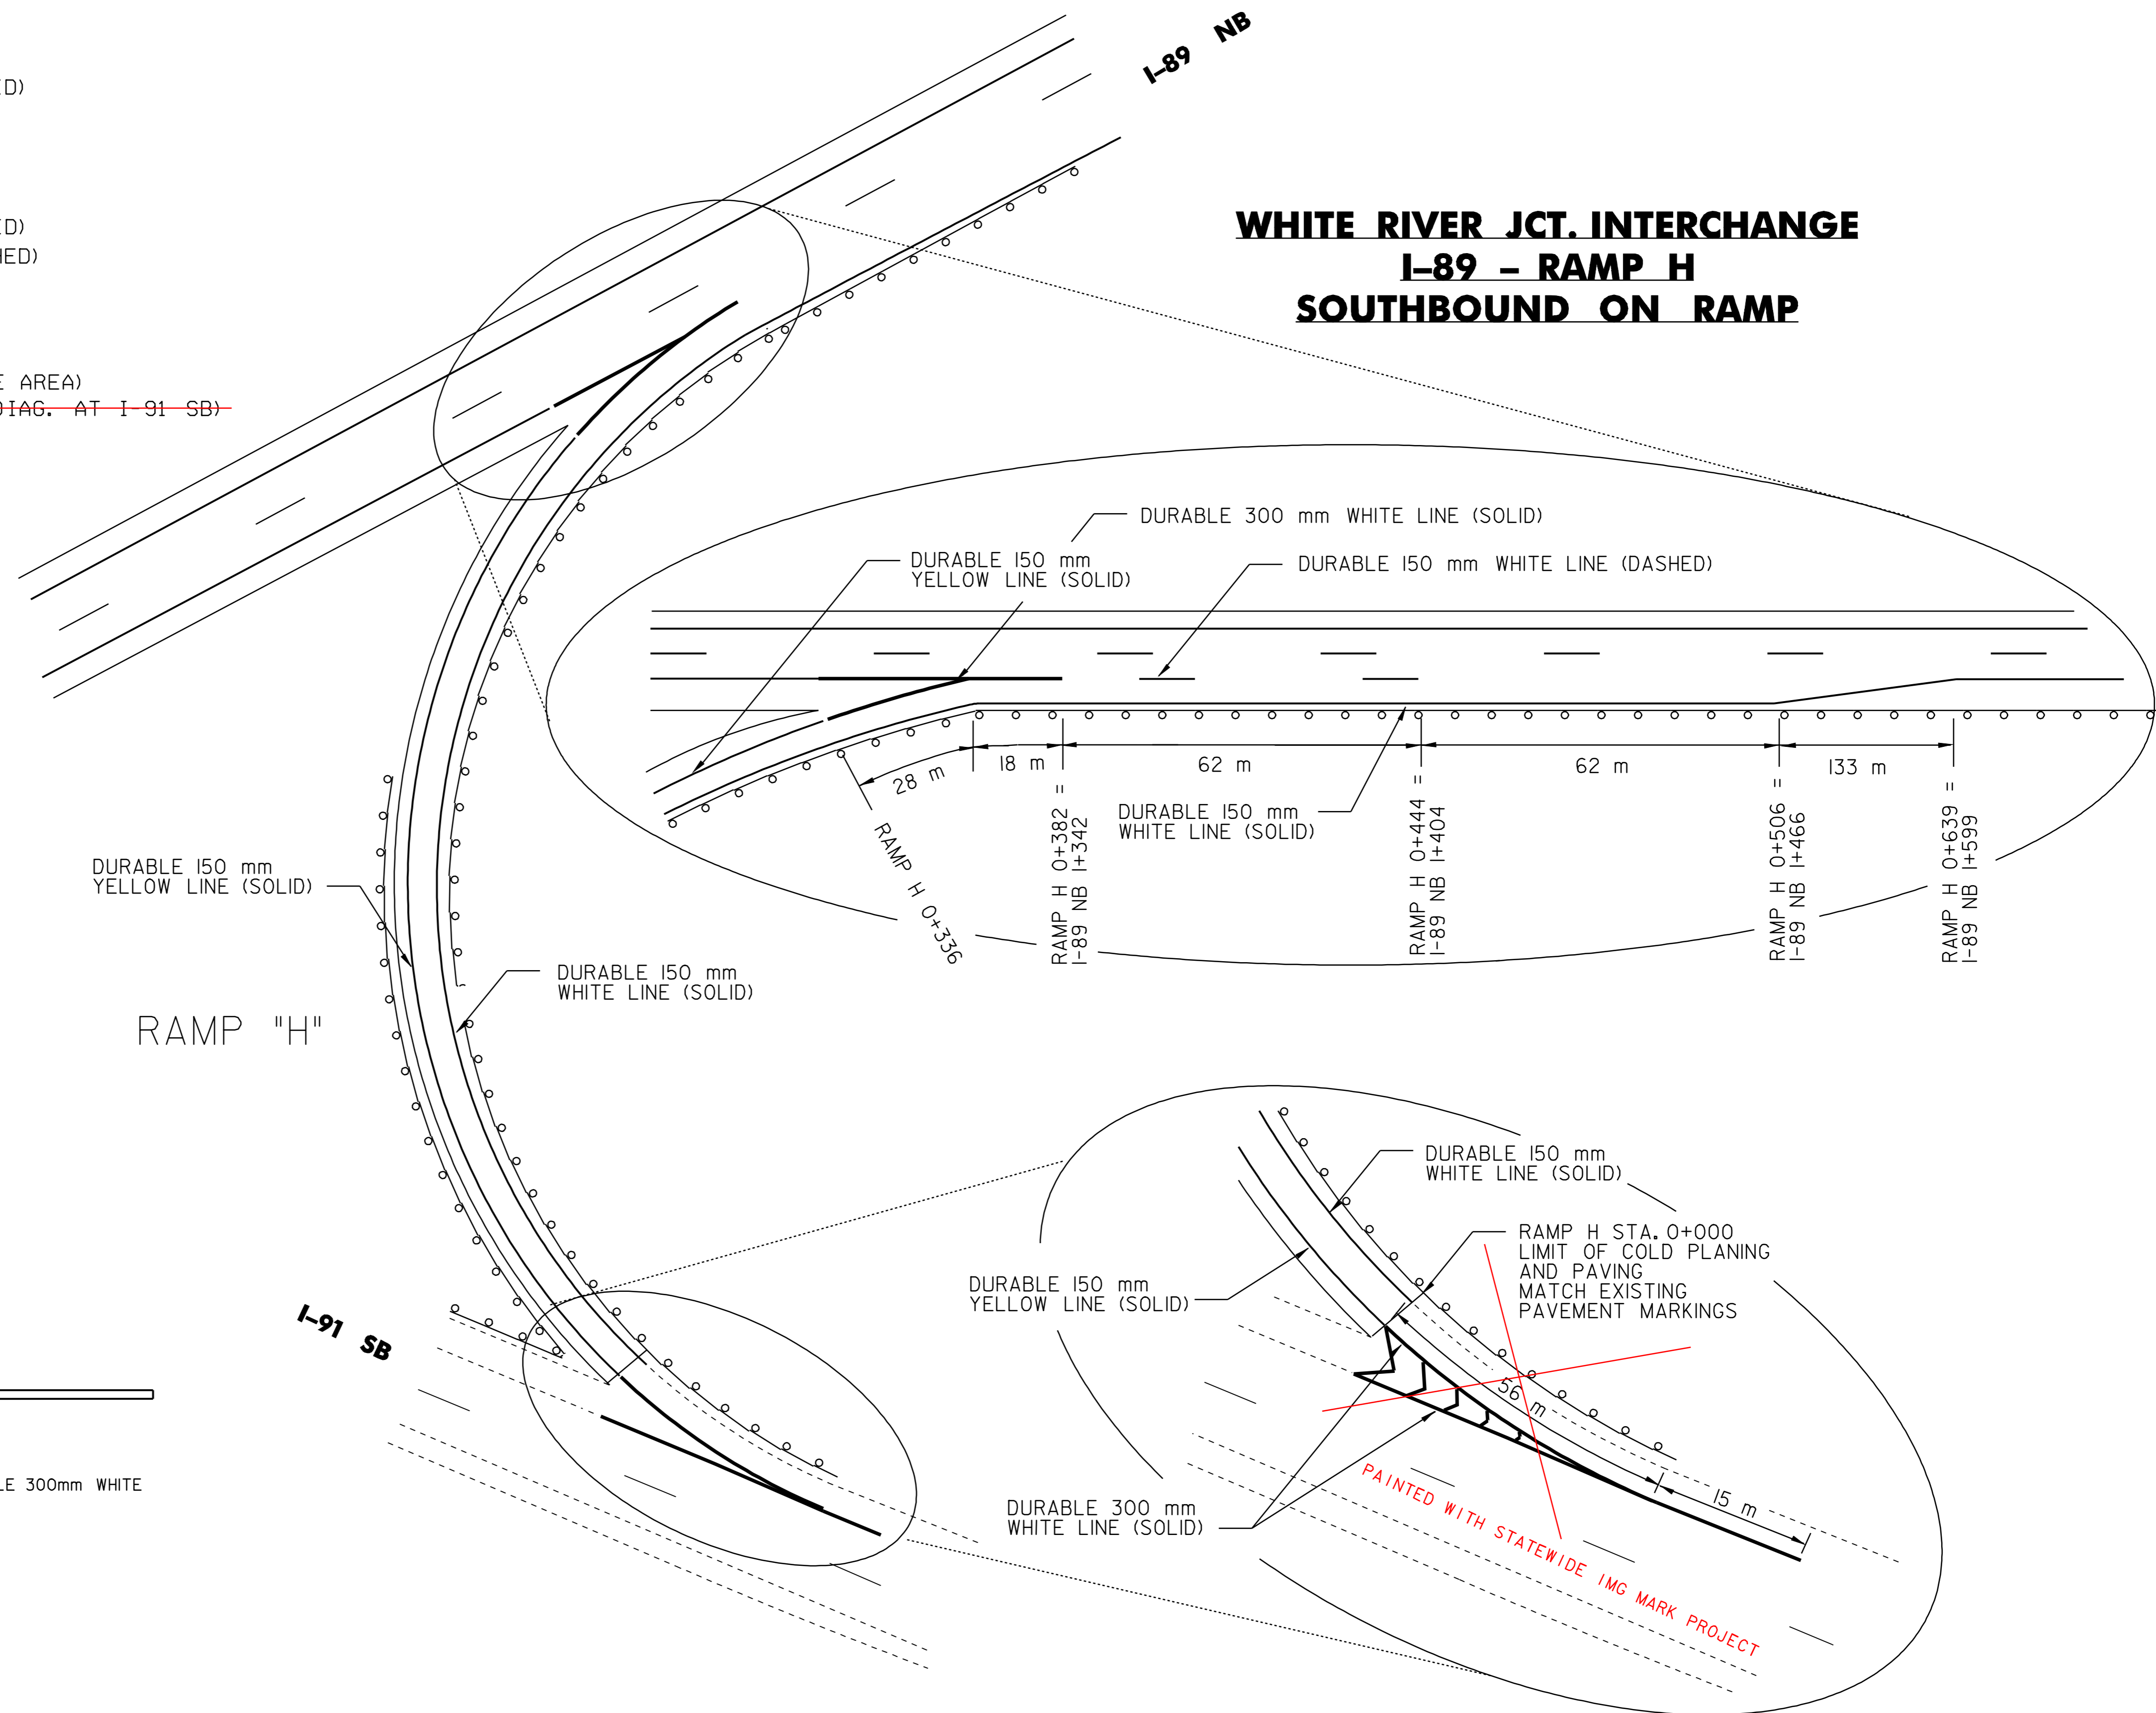

GORE MARKING DETAIL

**RAMP
 DETAIL #3**

PROJECT:	HARTFORD - SHARON	PROJECT NO.:	AC IM 089-(51)
DESIGN FILE NAME:	_/pave/01a028/p01a028.dgn	PLOT DATE:	31-JAN-2006 13:
IPARM FILE NAME:	_p01a028int3.i	SURVEY DATE:	9/01
SURVEYED BY:	_CLD_ENGINEERS_INC_	DRAWN BY:	_MPS_
SQUAD LEADER:	_WRH_	SHEET:	14 OF 21

REFER TO STANDARDS E-191 AND E-192 FOR ADDITIONAL DETAILS
 NOTE: ALL DIMENSIONS IN METERS EXCEPT AS INDICATED. DETAILS NOT TO SCALE