


RAMP PAVEMENT TYPICAL

LOCATION

EXIT 4 OFF & ON RAMPS - SEE SHEETS 12 & 13 FOR DETAILS
 EXIT 5 OFF & ON RAMPS - SEE SHEETS 14 & 15 FOR DETAILS

CONCRETE UNDER THE ASPHALTIC PLUG-TYPE JOINTS REPAIRED WITH ITEM NOS:
 501.21 - CONCRETE CLASS AA (MOD) (3000 PSI) @24 HOURS)
 580.20 - RAPID SETTING CONCRETE REPAIR MATERIAL

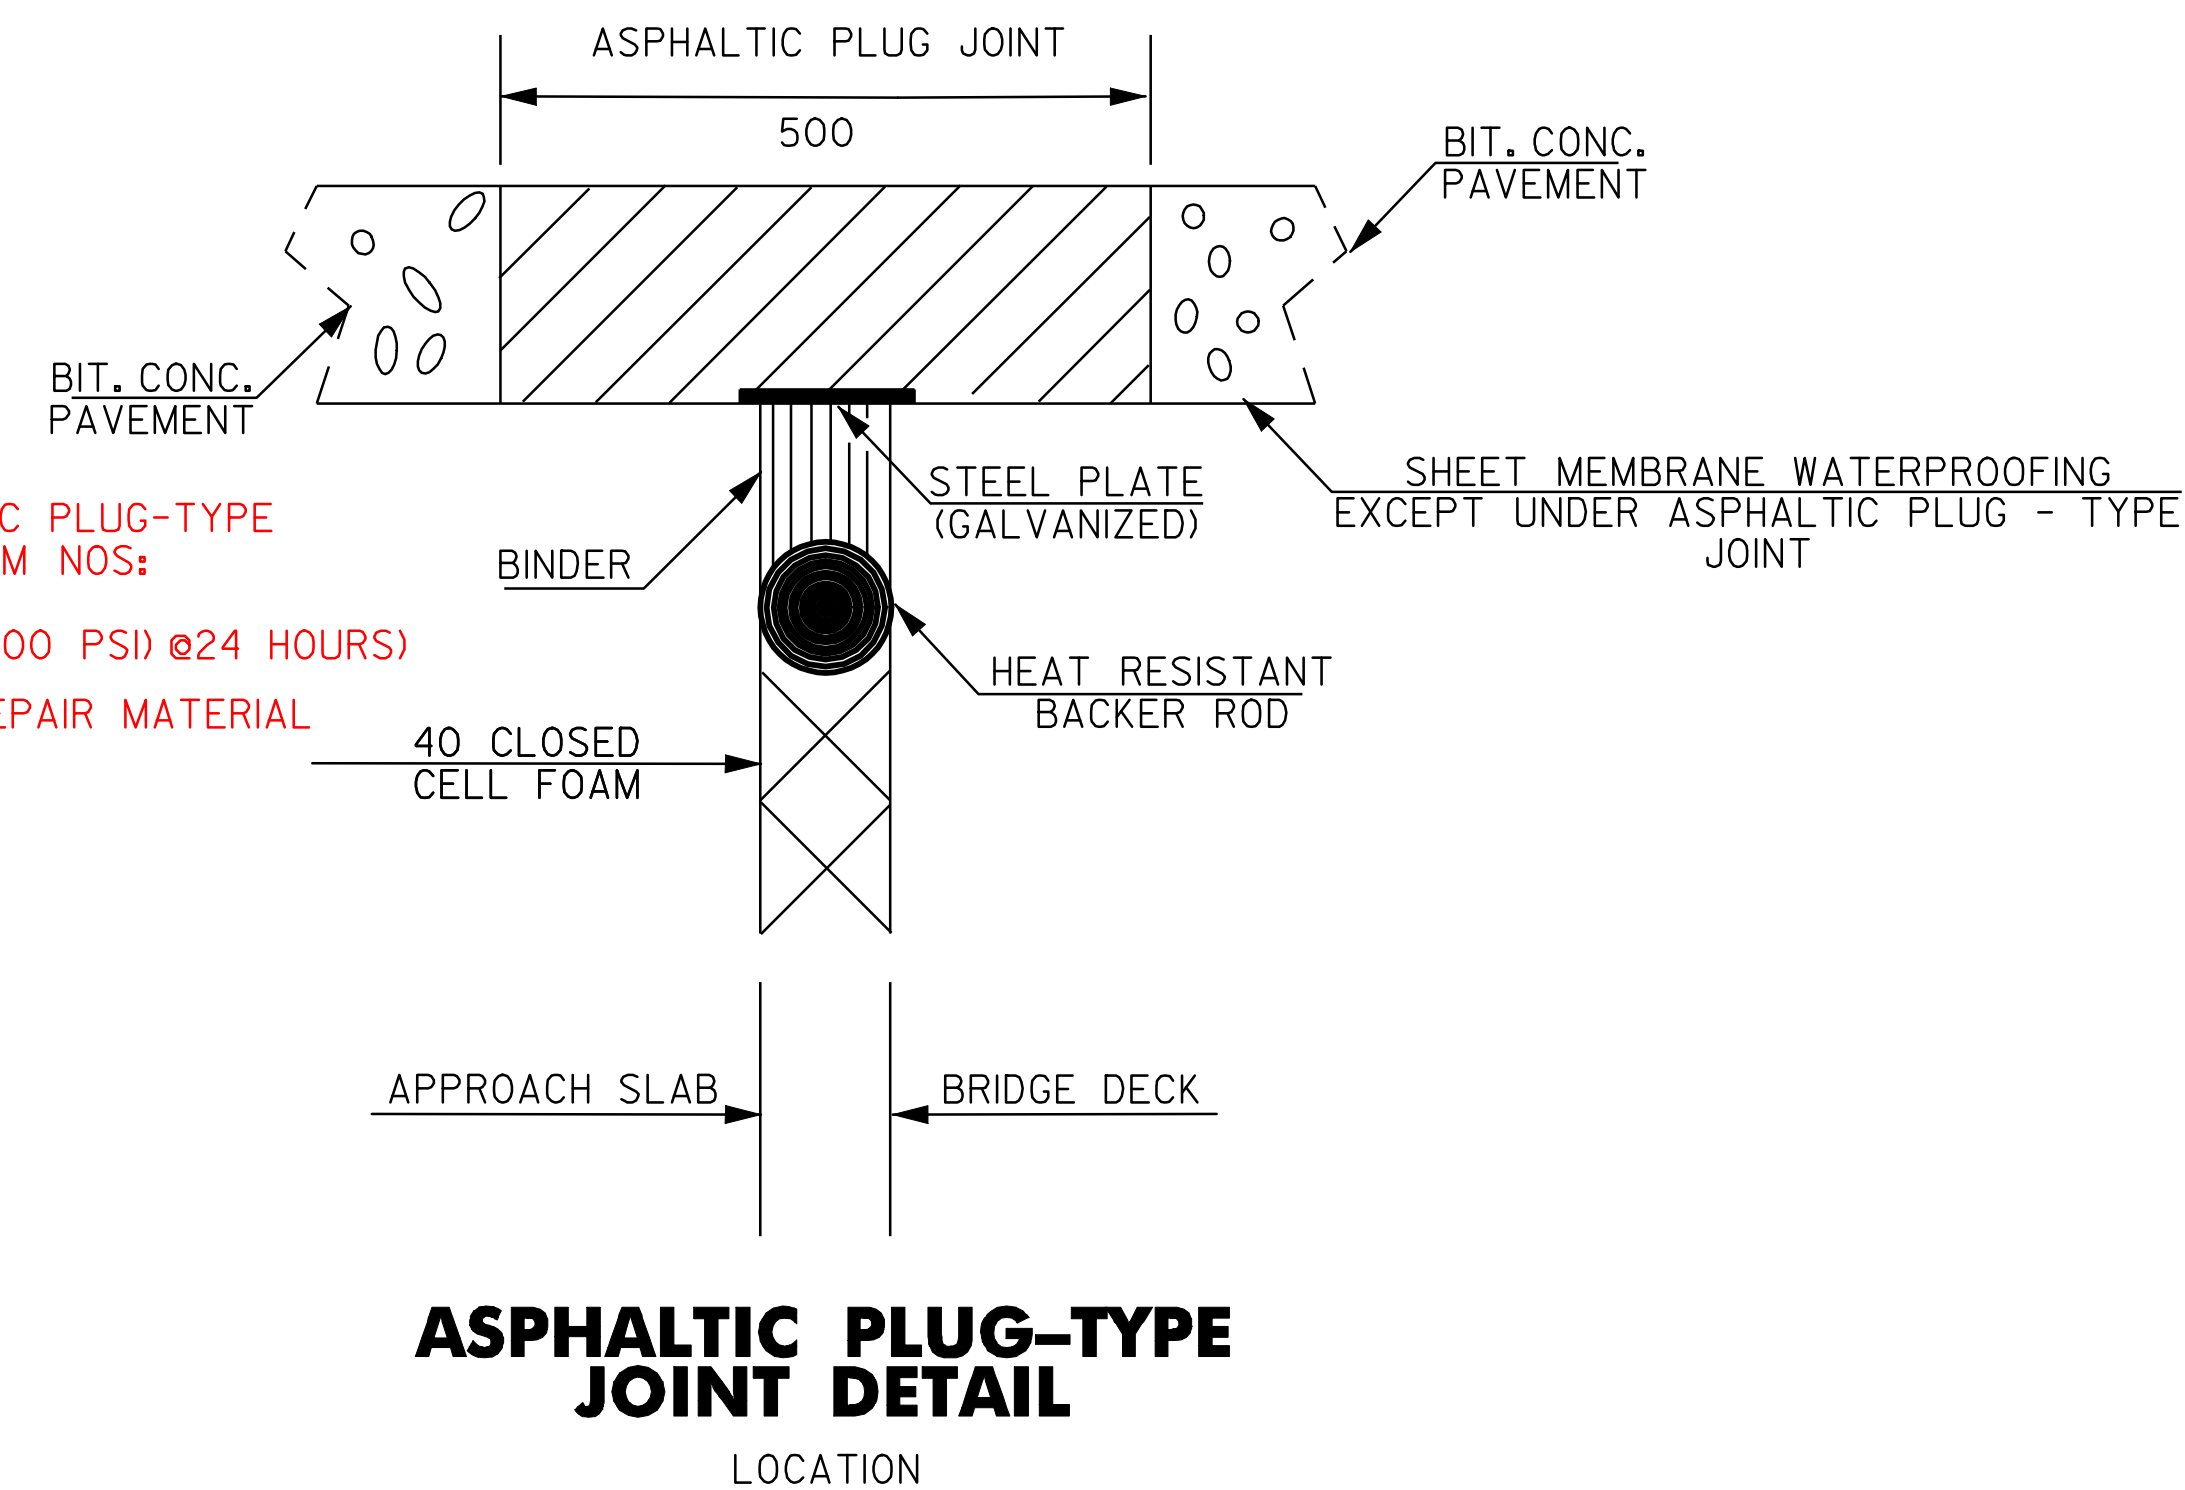

ASPHALTIC PLUG-TYPE JOINT DETAIL

LOCATION

TOWN	BRIDGE	EXISTING CONDITION AS PER BRIDGE INVENTORY	TREATMENT	LENGTHS
PUTNEY	BR. # 14N 3 SPAN, SIMPLE, ROLLED BEAM BRIDGE	2'-3' +/- OF EXISTING PAVEMENT WITH MEMBRANE ON BRIDGE	3 PLUG JOINTS REQUIRED SOUTH ABUTMENT AND 2 PIERS	4 @ 11.4 m
PUTNEY	BR. # 15N 5 SPAN, SIMPLE, ROLLED BEAM BRIDGE	2-1/2' +/- OF EXISTING PAVEMENT WITH NO MEMBRANE ON BRIDGE	5 PLUG JOINTS REQUIRED NORTH ABUTMENT AND 4 PIERS	6 @ 11.4 m
PUTNEY	BR. # 16N 4 SPAN, SIMPLE, ROLLED BEAM BRIDGE	2' +/- OF EXISTING PAVEMENT WITH MEMBRANE ON BRIDGE	4 PLUG JOINTS REQUIRED SOUTH ABUTMENT AND 3 PIERS	5 @ 11.4 m
WESTMINSTER	BR. # 18N 3 SPAN, SIMPLE, ROLLED BEAM BRIDGE	3' +/- OF EXISTING PAVEMENT WITH NO MEMBRANE ON BRIDGE	3 PLUG JOINTS REQUIRED SOUTH ABUTMENT AND 2 PIERS	4 @ 11.4 m
WESTMINSTER	BR. # 20N 3 SPAN, SIMPLE, ROLLED BEAM BRIDGE	3' +/- OF EXISTING PAVEMENT WITH NO MEMBRANE ON BRIDGE	3 PLUG JOINTS REQUIRED NORTH ABUTMENT AND 2 PIERS	4 @ 11.4 m

NOTE: EXISTING PAVEMENT THICKNESSES ARE BASED ON BRIDGE INSPECTION AND FILE INFORMATION WHICH HAVE NOT BEEN FIELD VERIFIED.

NOTE: ALL DIMENSIONS IN MILLIMETERS EXCEPT AS INDICATED

NOT TO SCALE

PROJECT TYPICAL SHEET 2

PROJECT NAME: BRATTLEBORO - WESTMINSTER
 PROJECT NUMBER: IM 09I-(K4I)
 FILE NAME: ZpqveZQa008Zpq008.dgn PLOT DATE: 06-APR-2005 11:55
 PROJECT LEADER: WRH DRAWN BY: JAC
 DESIGNED BY: CHECKED BY: EIS
 IPARM NAME: pa008ty02.i SHEET 3 OF 24