


### EXIT 4 - RAMP D NORTHBOUND ON RAMP

SEE STANDARD E-191M FOR  
RAMP STRIPING DETAILS

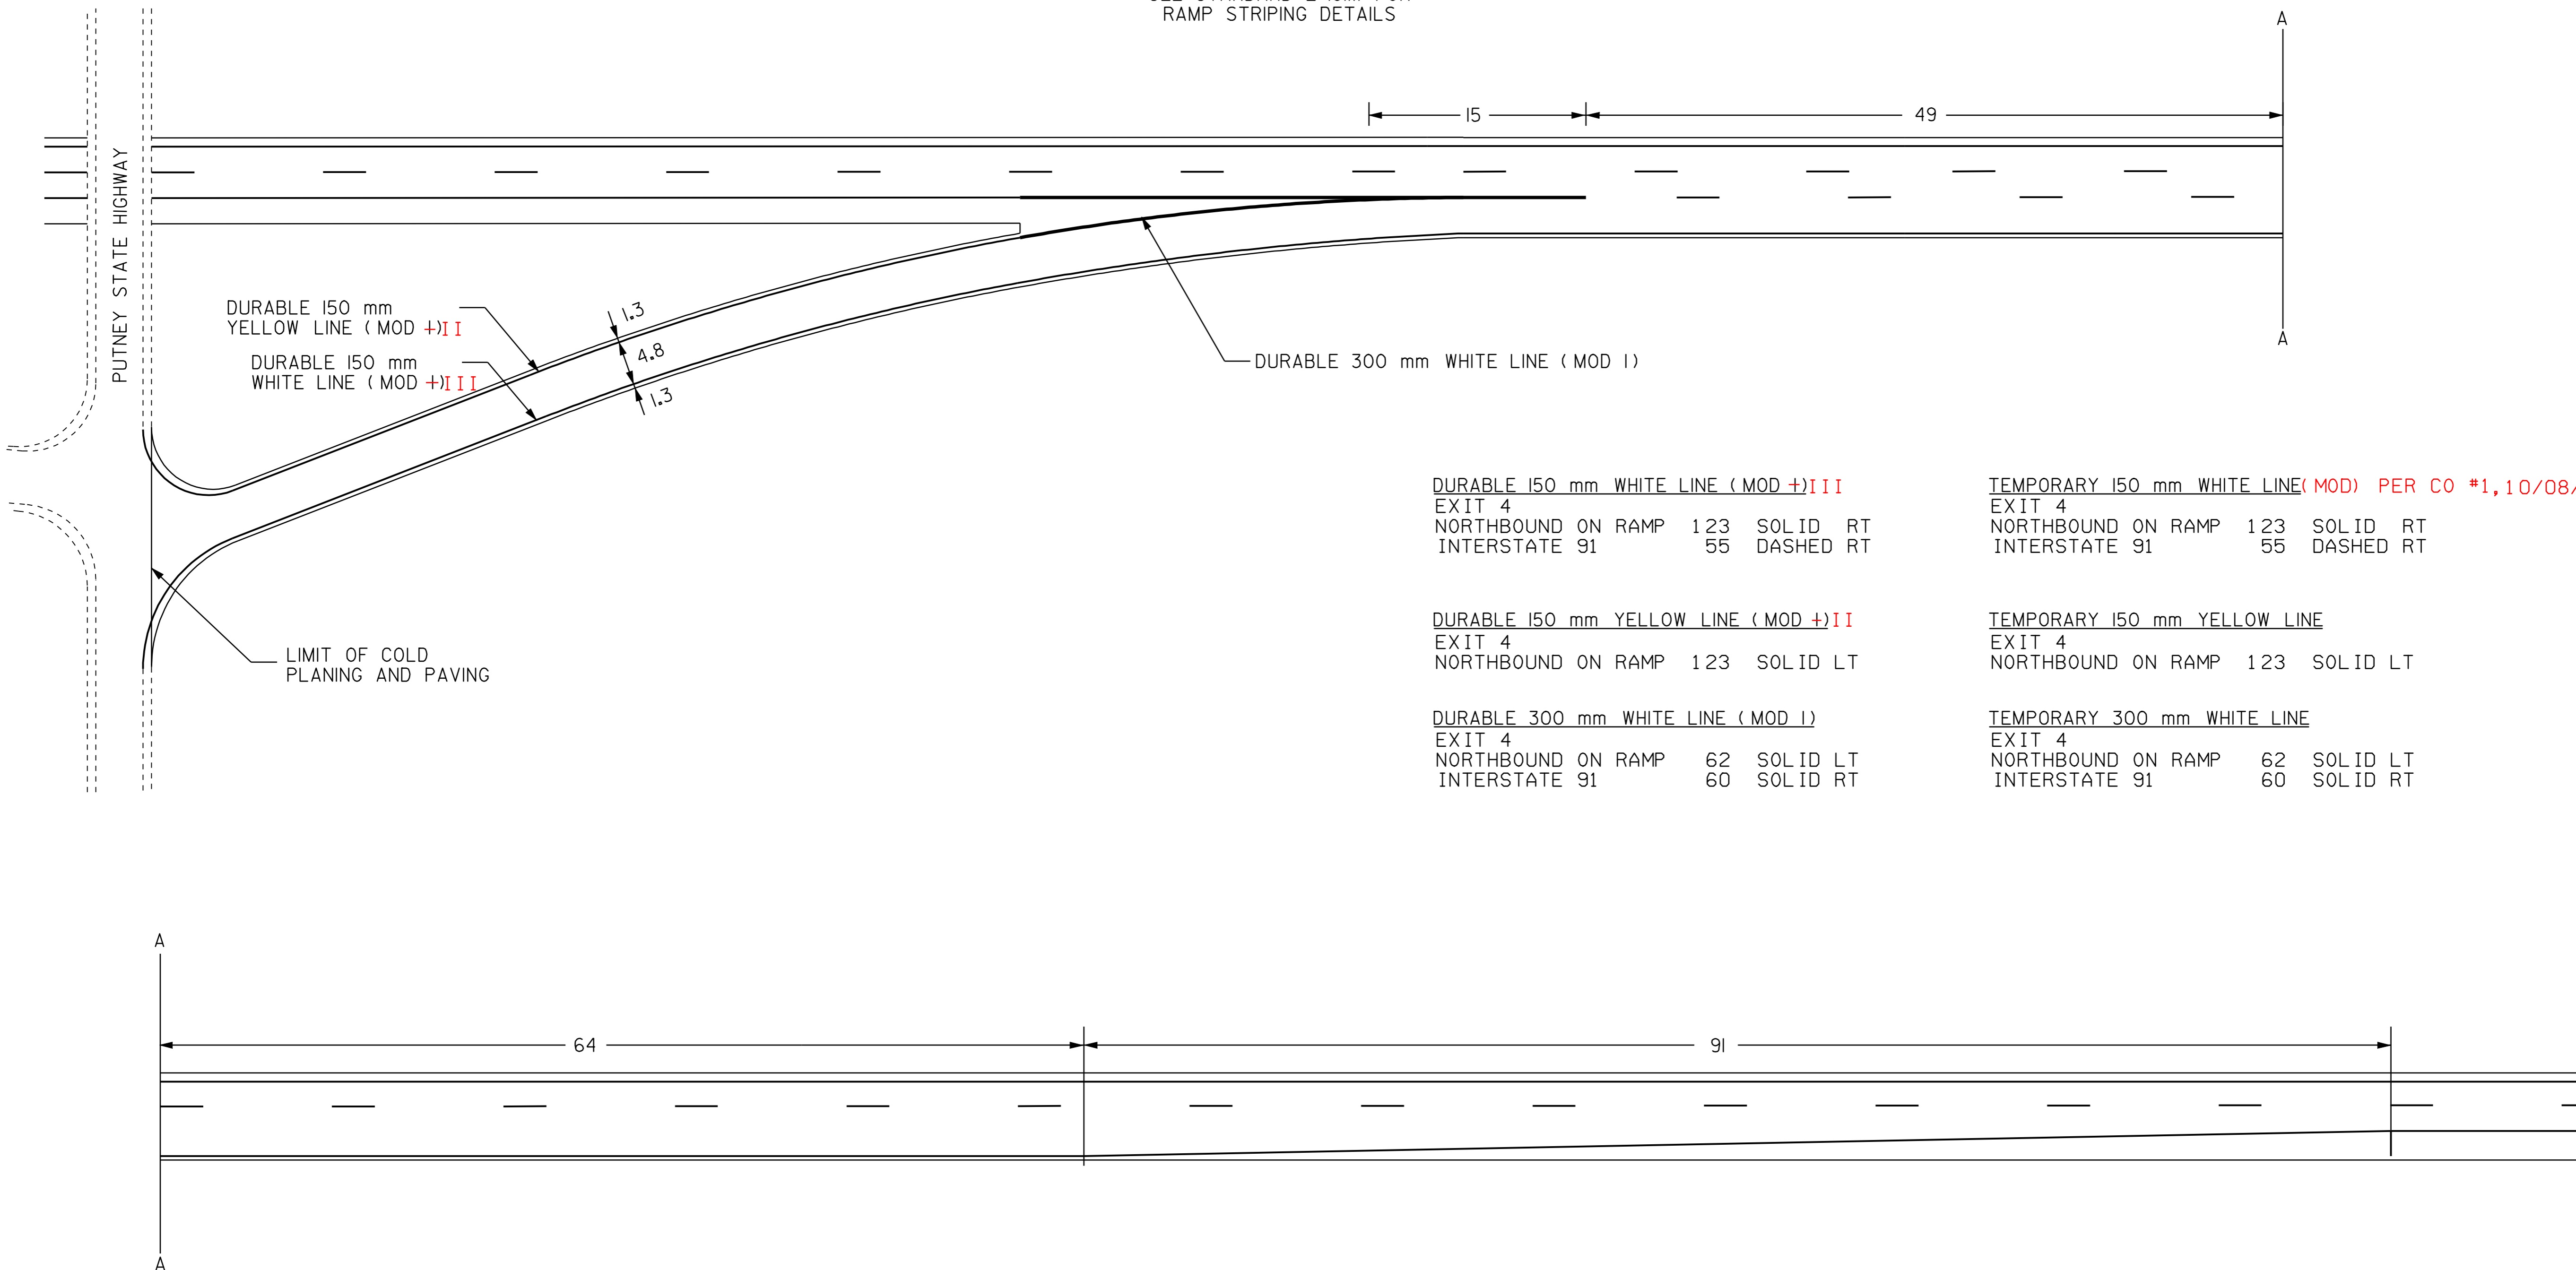

**DURABLE 150 mm WHITE LINE (MOD +)III**  
EXIT 4  
NORTHBOUND ON RAMP 123 SOLID RT  
INTERSTATE 91 55 DASHED RT

**TEMPORARY 150 mm WHITE LINE (MOD) PER CO #1, 10/08/03**  
EXIT 4  
NORTHBOUND ON RAMP 123 SOLID RT  
INTERSTATE 91 55 DASHED RT

**DURABLE 150 mm YELLOW LINE (MOD +)II**  
EXIT 4  
NORTHBOUND ON RAMP 123 SOLID LT

**TEMPORARY 150 mm YELLOW LINE**  
EXIT 4  
NORTHBOUND ON RAMP 123 SOLID LT

**DURABLE 300 mm WHITE LINE (MOD I)**  
EXIT 4  
NORTHBOUND ON RAMP 62 SOLID LT  
INTERSTATE 91 60 SOLID RT

**TEMPORARY 300 mm WHITE LINE**  
EXIT 4  
NORTHBOUND ON RAMP 62 SOLID LT  
INTERSTATE 91 60 SOLID RT

LIMIT OF COLD  
PLANING AND PAVING

#### LEGEND

- R = REMOVE EXISTING
- S = SALVAGE
- R&S = REMOVE AND SALVAGE
- N = NEW
- RET = RETAIN
- B-B = BACK TO BACK
- = GUARD RAIL

NOTE: ALL DIMENSIONS IN METERS EXCEPT AS INDICATED

NOT TO SCALE

<b>RAMP DETAIL INTERCHANGE #4 ON RAMP</b>	PROJECT NAME: BRATTLEBORO - WESTMINSTER	PLOT DATE: 06-APR-2005 11:55
	PROJECT NUMBER: IM 091-(41)	DRAWN BY: JAC
	FILE NAME: /pave/01a008/pa008.dgn	CHECKED BY: PIS
	PROJECT LEADER: WRH	SHEET 13 OF 24