


**EXIT 5 - RAMP D
NORTHBOUND ON RAMP**

SEE STANDARD E-191M FOR
RAMP STRIPING DETAILS

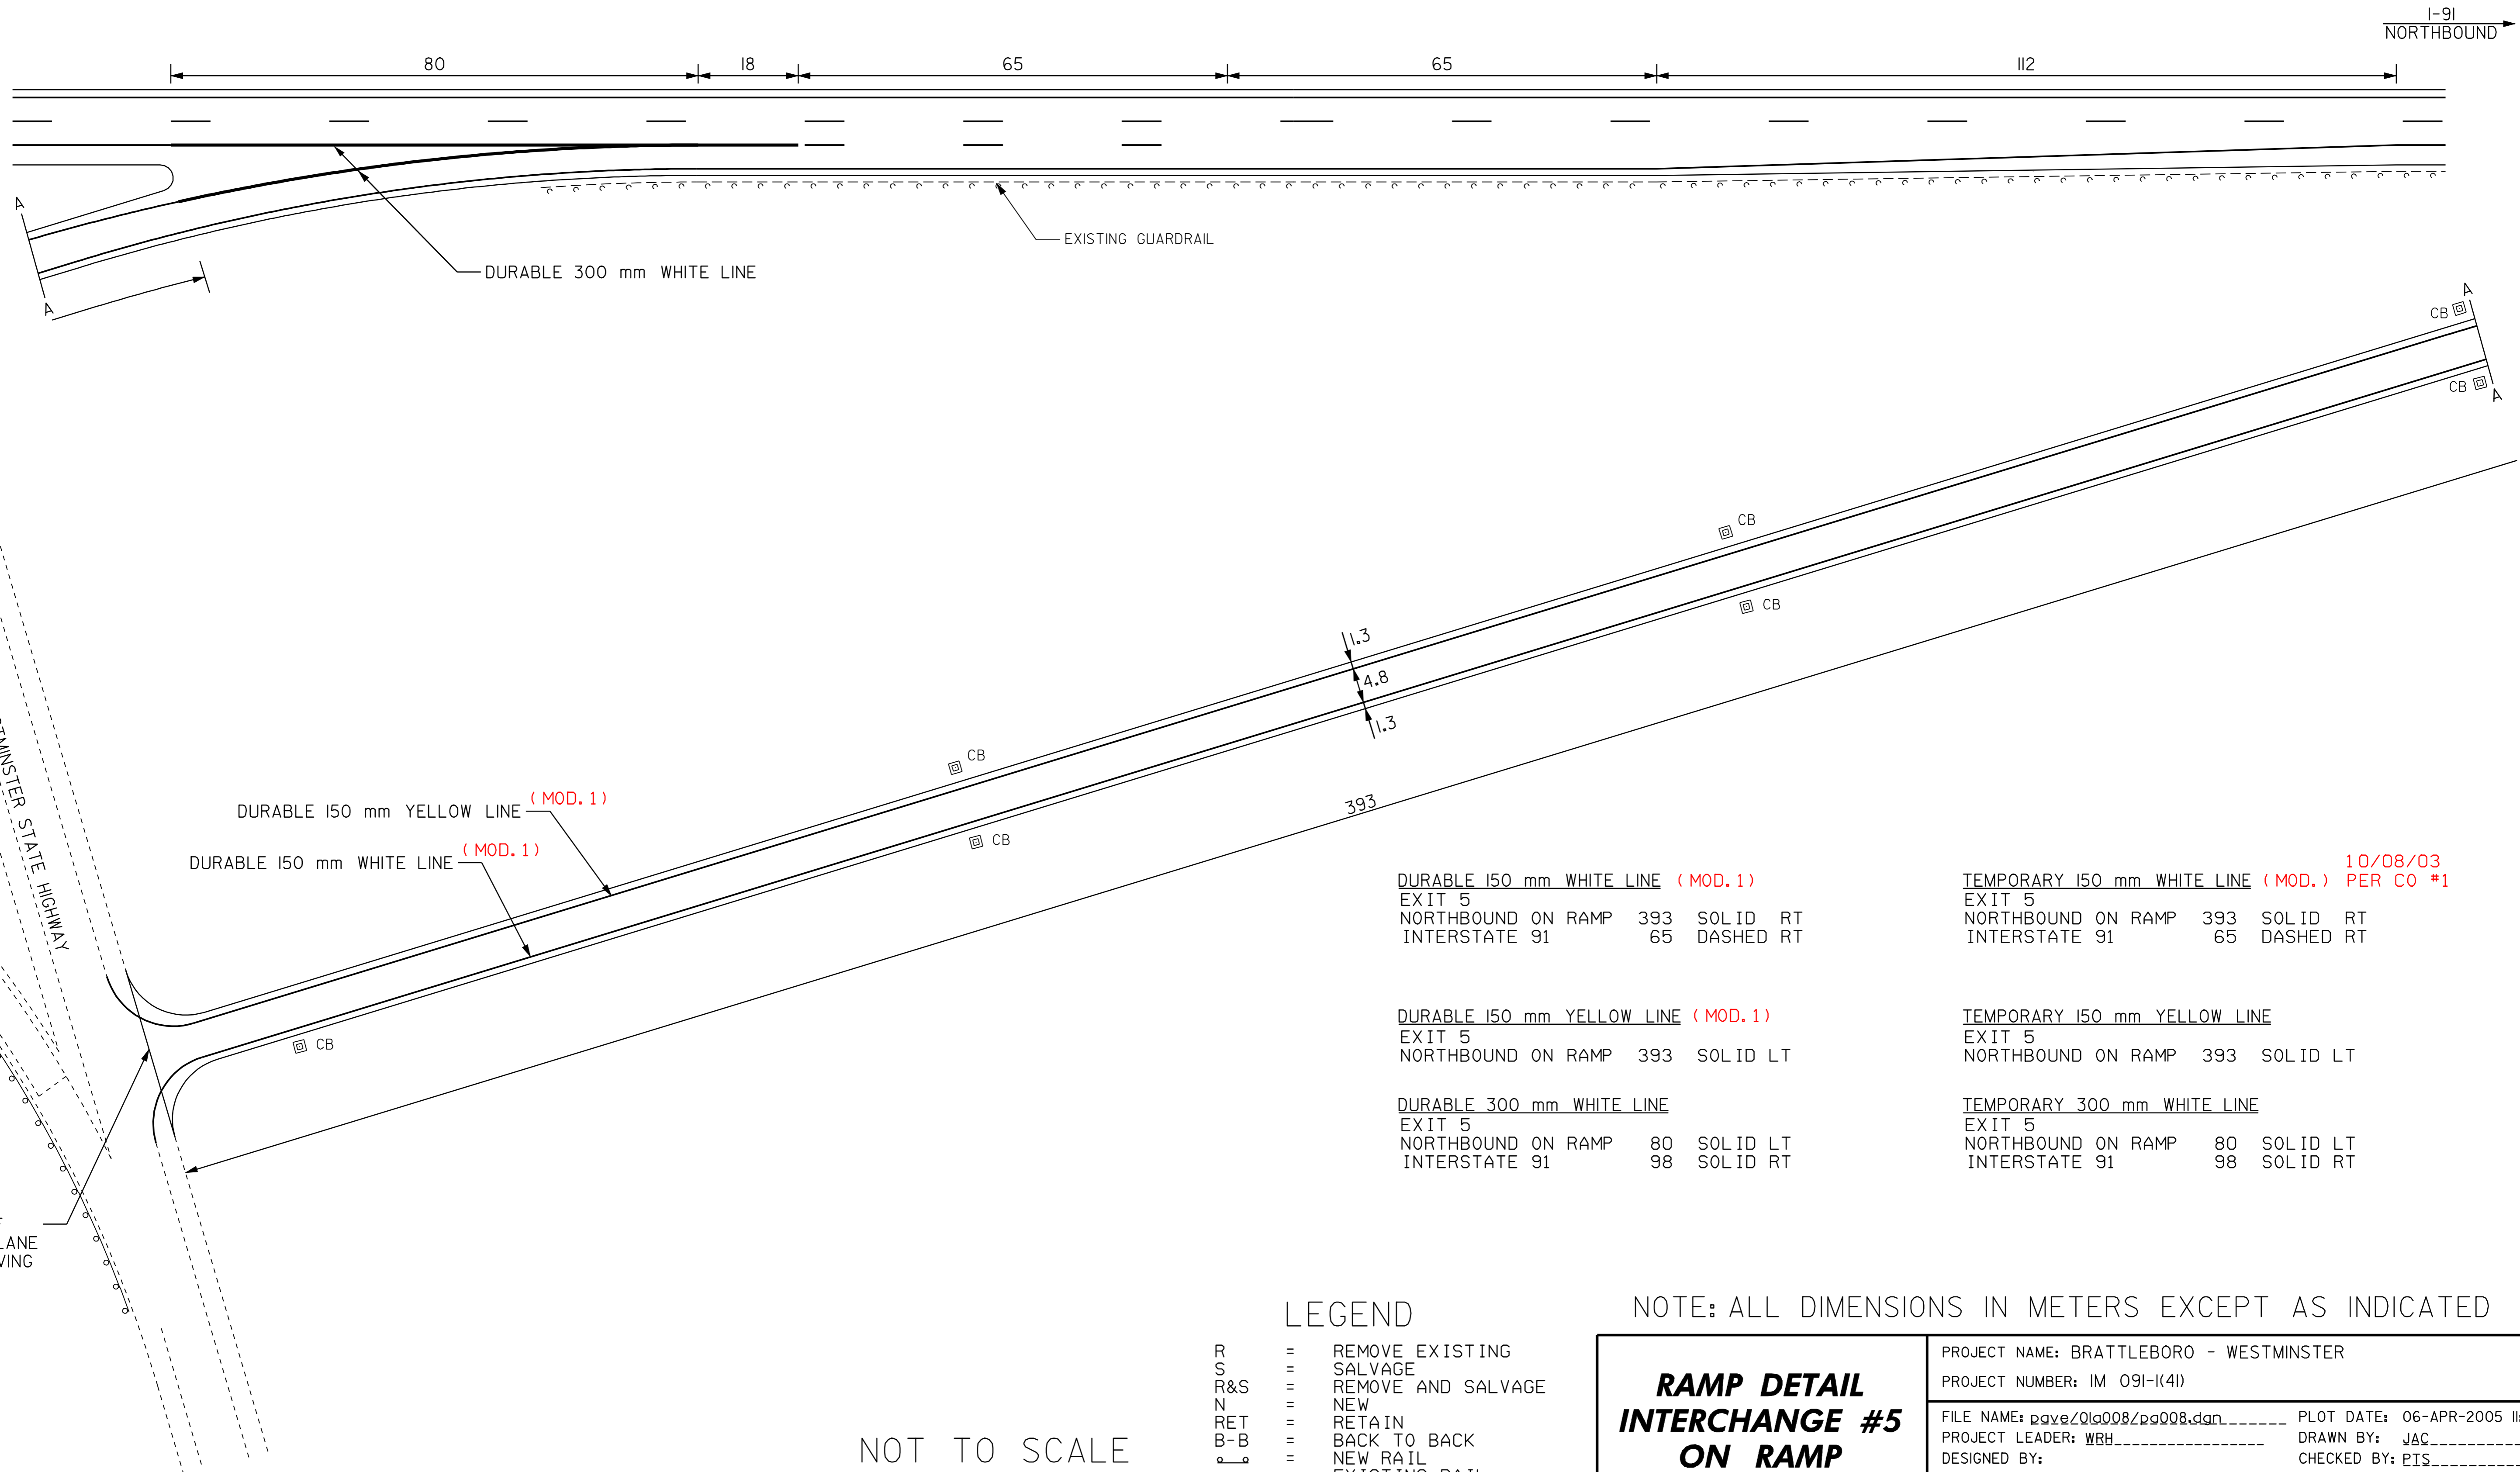

DURABLE 150 mm WHITE LINE (MOD.1)	TEMPORARY 150 mm WHITE LINE (MOD.) PER CO #1
EXIT 5	EXIT 5
NORTHBOUND ON RAMP 393 SOLID RT	NORTHBOUND ON RAMP 393 SOLID RT
INTERSTATE 91 65 DASHED RT	INTERSTATE 91 65 DASHED RT
DURABLE 150 mm YELLOW LINE (MOD.1)	TEMPORARY 150 mm YELLOW LINE
EXIT 5	EXIT 5
NORTHBOUND ON RAMP 393 SOLID LT	NORTHBOUND ON RAMP 393 SOLID LT
DURABLE 300 mm WHITE LINE	TEMPORARY 300 mm WHITE LINE
EXIT 5	EXIT 5
NORTHBOUND ON RAMP 80 SOLID LT	NORTHBOUND ON RAMP 80 SOLID LT
INTERSTATE 91 98 SOLID RT	INTERSTATE 91 98 SOLID RT

LEGEND

- R = REMOVE EXISTING
- S = SALVAGE
- R&S = REMOVE AND SALVAGE
- N = NEW
- RET = RETAIN
- B-B = BACK TO BACK
- o-o = NEW RAIL
- o-o-o = EXISTING RAIL

NOTE: ALL DIMENSIONS IN METERS EXCEPT AS INDICATED

NOT TO SCALE

**RAMP DETAIL
INTERCHANGE #5
ON RAMP**

PROJECT NAME: BRATTLEBORO - WESTMINSTER	PLOT DATE: 06-APR-2005 11:55
PROJECT NUMBER: IM 091-(41)	DRAWN BY: JAC
FILE NAME: p008\091\091.dgn	CHECKED BY: EIS
PROJECT LEADER: WRH	SHEET 17 OF 24
DESIGNED BY:	
IPARM NAME: pa008#5on.1	