

STONE FILL DETAIL

LOCATION

SLOPE STABILIZATION { 32.505 LT
36.787 RT @ CULVERT (18" RCP) REPAIR

39.540 RT REMOVE PAVED SWALE
37.020 RT REMOVE PAVED SWALE
40.592 RT REMOVE PAVED SWALE
40.393 LT RELOCATED NEW SWALE

} TYPE II

37.790 RT REMOVE PAVED SWALE
40.425 RT REMOVE PAVED SWALE
42.720 RT REMOVE PAVED SWALE
42.950 RT REMOVE PAVED SWALE

} TYPE I


EXIT 7 OFF RAMP "C" @ MM 0.107 RT REMOVE PAVED SWALE
@ MM 0.269 RT REMOVE PAVED SWALE

32.397 LT REMOVE PAVED SWALE
35.260 RT REMOVE PAVED SWALE
EXIT 6 OFF RAMP "A" @ MM 0.191 RT REMOVE PAVED SWALE
@ MM 0.391 RT REMOVE PAVED SWALE
@ MM 0.459 RT REMOVE PAVED SWALE

} TYPE I

WORK COMPLETED IN 2010
ADDITIONAL LOCATIONS TO REMOVE EXISTING
PAVED SWALES NOT IDENTIFIED ON SHEET #19
OF 43 APPROVED BY JIM REDMOND (PROJECT
SUPERVISOR) ON 9/14/10

WORK COMPLETED IN 2011

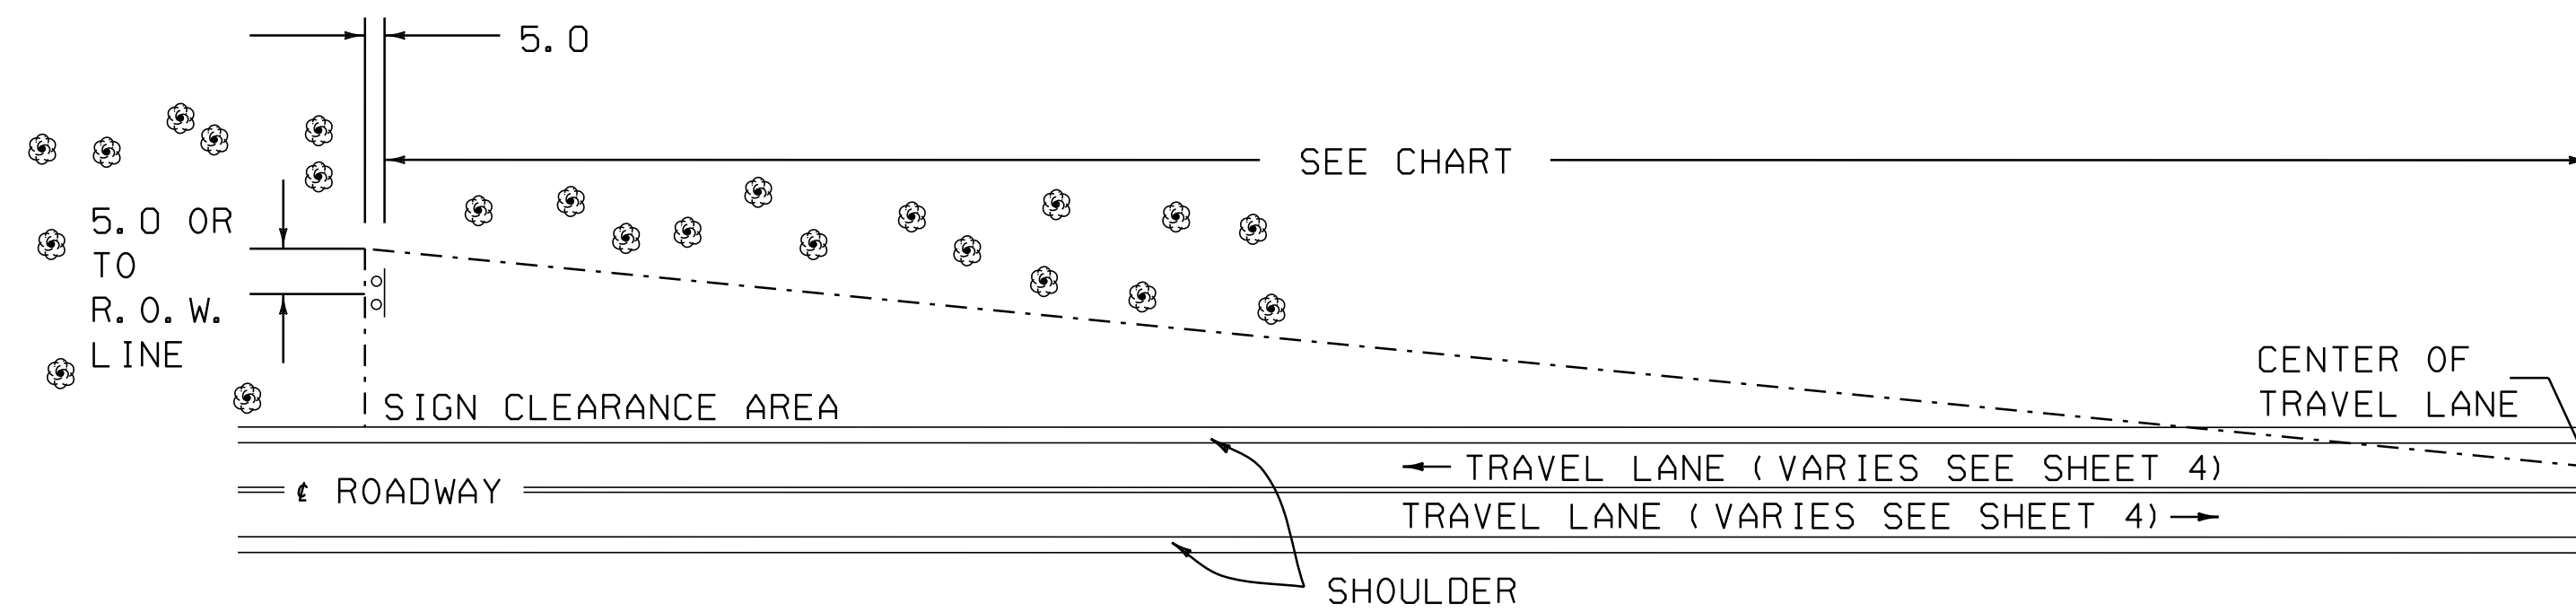

THE CONTRACTOR SHALL REMOVE ALL WOODY
STEMMED GROWTH INCLUDING BRUSH, SAPPLINGS
AND TREE LIMBS GROWING WITHIN OR
PROJECTING INTO THE CLEARANCE AREA AND
DOWN TO GROUND LEVEL. PAYMENT WILL BE
UNDER ITEM 201.31, THINNING AND TRIMMING
FOR SIGNS. NO CHEMICALS (POISONS OR
DEFOLIANTS) WILL BE ALLOWED.


MINIMUM SIGN SIGHT DISTANCE CHART

APPROACH SPEED (mph)	SIGHT DISTANCE (feet)
30 OR LESS	300
35	350
40	400
45	450
50	500
55	550

THINNING AND TRIMMING DETAIL

LOCATION

MM ~~33.596~~ RT 33.550 RT
MM 40.443 RT
MM 40.638 RT
MM 40.857 RT
MM 41.373 RT

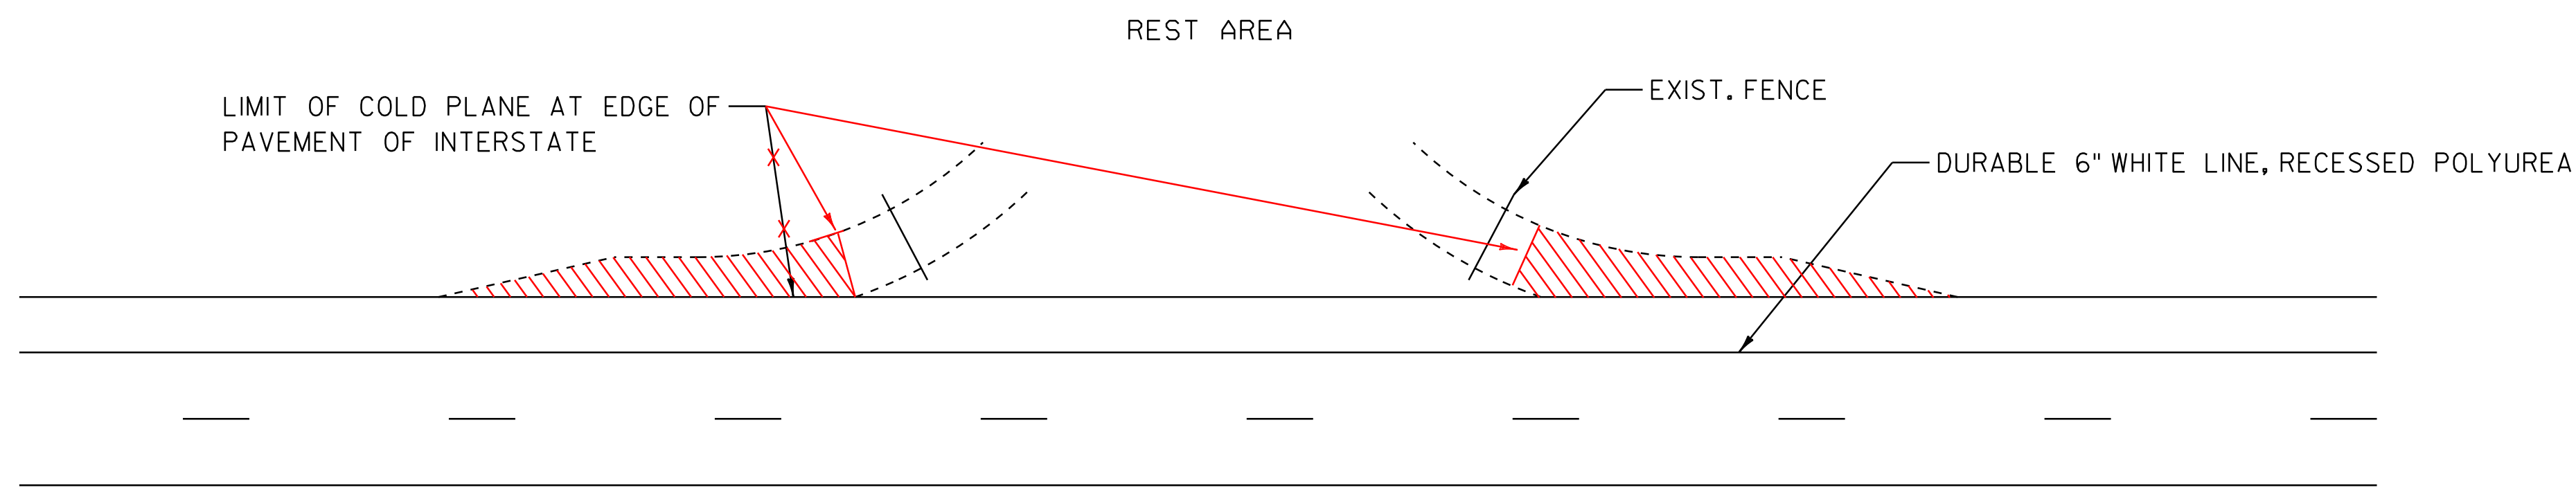

REST AREA DETAIL

LOCATION

MM 39.2 RT

LEGEND

- R = REMOVE EXISTING
- S = SALVAGE
- R&S = REMOVE AND SALVAGE
- N = NEW
- RET = RETAIN
- B-B = BACK TO BACK
- = EXISTING GUARDRAIL
- - - = PROPOSED GUARDRAIL
- = TYPE I DELINEATOR, WHITE
- = TYPE I DELINEATOR, AMBER
- = TYPE II DELINEATOR, WHITE
- = TYPE III DELINEATOR, RIGHT
- = TYPE III DELINEATOR, LEFT

PROJECT TYPICAL SHEET 4

PROJECT NAME: WESTMINSTER-SPRINGFIELD
PROJECT NUMBER: IM 091-1(62)

FILE NAME: /pave/01a014/pa014
PROJECT LEADER: PTS
DESIGNED BY: NULL
IPARM FILE NAME: 01a014_07
PLOT DATE: 17-JAN-2013 12:43
DRAWN BY: JBZ
CHECKED BY: PTS
SHEET 7 OF 43

NOT TO SCALE