


# EXIT 6 - RAMP B & F NORTHBOUND ON RAMP

SEE STANDARDS E-191, E-192 AND E-193  
FOR PAVEMENT MARKING GUIDELINES

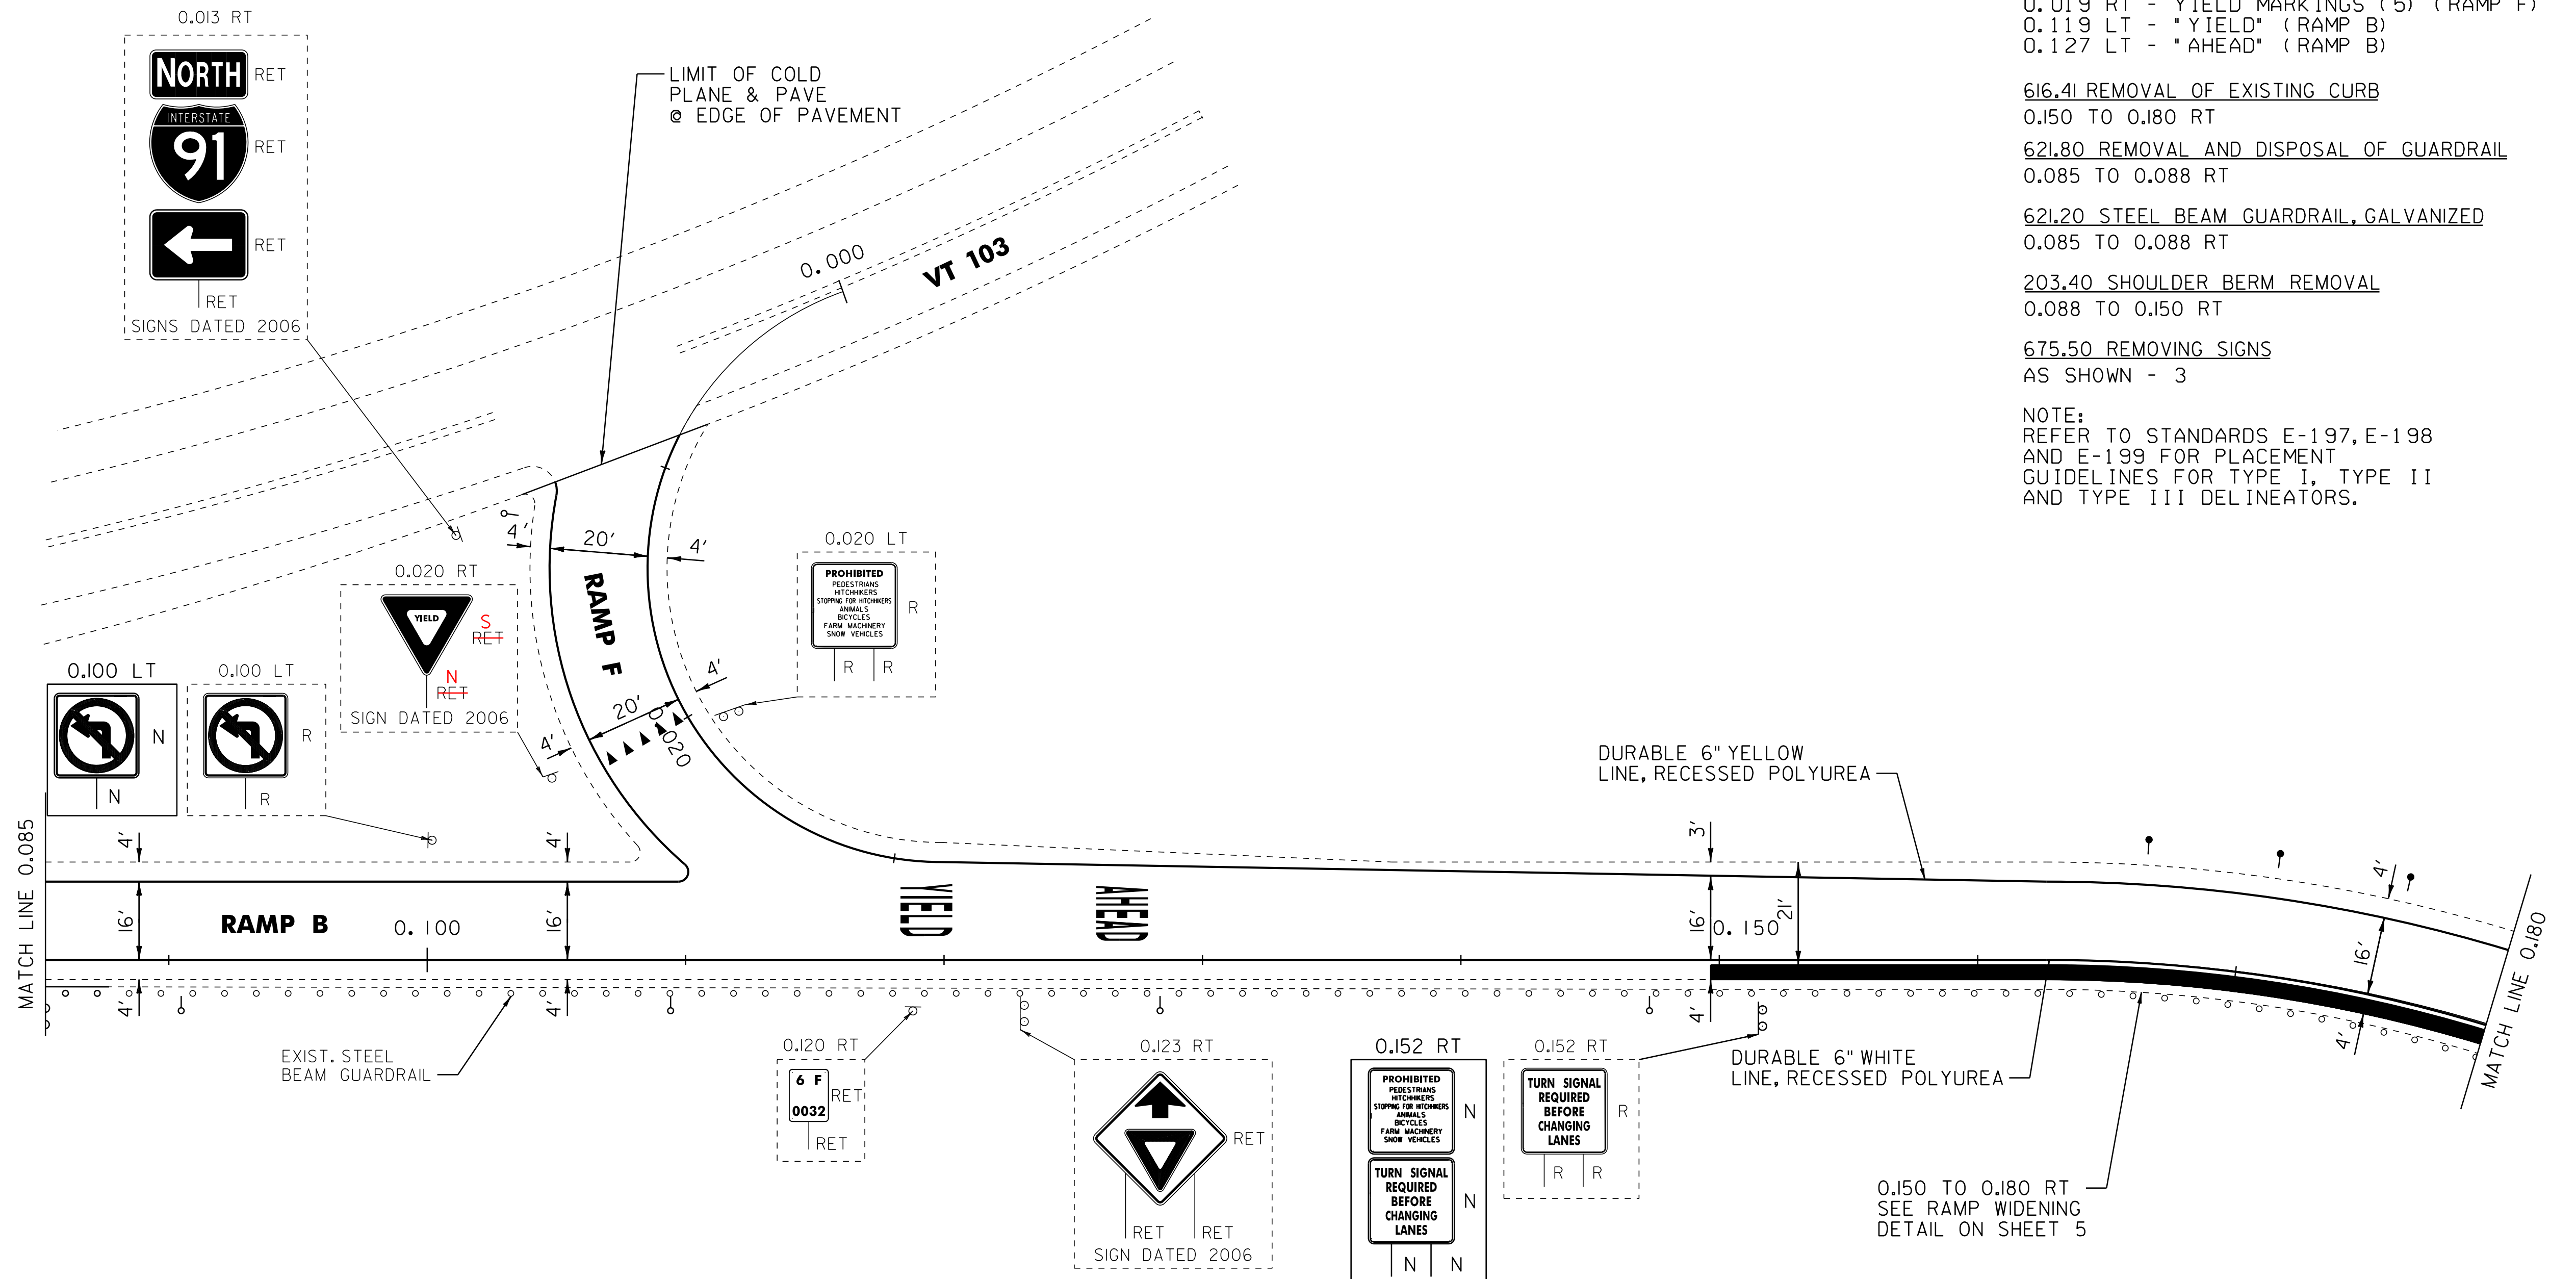

- 646.622 TEMPORARY 6" WHITE LINE, PAINT
- 646.426 DURABLE 6" WHITE LINE, RECESSED POLYUREA
- 0.011 TO 0.022 SOLID RT (RAMP F)
- 0.085 TO 0.180 SOLID RT (RAMP B)
- 646.632 TEMPORARY 6" YELLOW LINE, PAINT
- 646.436 DURABLE 6" YELLOW LINE, RECESSED POLYUREA
- 0.008 TO 0.032 SOLID RT (RAMP F)
- 0.085 TO 0.108 SOLID LT (RAMP B)
- 0.120 TO 0.180 SOLID LT (RAMP B)
- 646.662 TEMPORARY 12" WHITE LINE, PAINT
- 646.466 DURABLE 12" WHITE LINE, RECESSED POLYUREA
- 0.022 TO 0.024 SOLID RT (RAMP F)
- 0.108 TO 0.111 SOLID LT (RAMP B)

- 646.692 TEMPORARY LETTER OR SYMBOL, PAINT
- 646.492 DURABLE LETTER OR SYMBOL, THERMOPLASTIC
- 0.019 RT - YIELD MARKINGS (5) (RAMP F)
- 0.119 LT - "YIELD" (RAMP B)
- 0.127 LT - "AHEAD" (RAMP B)

616.41 REMOVAL OF EXISTING CURB  
0.150 TO 0.180 RT

621.80 REMOVAL AND DISPOSAL OF GUARDRAIL  
0.085 TO 0.088 RT

621.20 STEEL BEAM GUARDRAIL, GALVANIZED  
0.085 TO 0.088 RT

203.40 SHOULDER BERM REMOVAL  
0.088 TO 0.150 RT

675.50 REMOVING SIGNS  
AS SHOWN - 3

NOTE:  
REFER TO STANDARDS E-197, E-198  
AND E-199 FOR PLACEMENT  
GUIDELINES FOR TYPE I, TYPE II  
AND TYPE III DELINEATORS.

- LEGEND**
- R = REMOVE EXISTING
  - S = SALVAGE
  - R&S = REMOVE AND SALVAGE
  - N = NEW
  - RET = RETAIN
  - B-B = BACK TO BACK
  - = EXISTING GUARDRAIL
  - - - = PROPOSED GUARDRAIL
  - = TYPE I DELINEATOR, WHITE
  - = TYPE I DELINEATOR, AMBER
  - ⊗ = TYPE II DELINEATOR, WHITE
  - ⊙ = TYPE III DELINEATOR, RIGHT
  - ⊖ = TYPE III DELINEATOR, LEFT

## EXIT 6 NB ON RAMP DETAIL SHEET 2

PROJECT NAME: WESTMINSTER-SPRINGFIELD	FILE NAME: /pave/01a014/pa014	PLOT DATE: 17-JAN-2013 12:44
PROJECT NUMBER: IM 091-1(62)	PROJECT LEADER: PTS	DRAWN BY: MRS
	DESIGNED BY: NLL	CHECKED BY: PTS
	IPARM FILE NAME: 01a014_24	SHEET 24 OF 43

NOT TO SCALE