

EXIT 6 - RAMP B NORTHBOUND ON RAMP

SEE STANDARDS E-191, E-192 AND E-193
FOR PAVEMENT MARKING GUIDELINES

646.622 TEMPORARY 6" WHITE LINE, PAINT
646.426 DURABLE 6" WHITE LINE, RECESSED POLYUREA
0.180 TO 0.188 SOLID RT
35.402 TO 35.478 DOTTED RT

646.632 TEMPORARY 6" YELLOW LINE, PAINT
646.436 DURABLE 6" YELLOW LINE, RECESSED POLYUREA
0.180 TO 0.188 SOLID LT

646.662 TEMPORARY 12" WHITE LINE, PAINT
646.466 DURABLE 12" WHITE LINE, RECESSED POLYUREA
0.188 TO 0.200 SOLID LT (RAMP B)
35.384 TO 35.402 SOLID RT (I-91)


646.692 TEMPORARY LETTER OR SYMBOL, PAINT
646.492 DURABLE LETTER OR SYMBOL, THERMOPLASTIC
0.188 LT - YIELD MARKINGS (-4) 5

604.40 CHANGING ELEVATION OF DROP INLETS,
CATCH BASINS OR MANHOLES
0.198 RT (CB)

616.41 REMOVAL OF EXISTING CURB
0.180 TO 0.198 RT

675.50 REMOVING SIGNS
AS SHOWN - 1

NOTE:
REFER TO STANDARDS E-197, E-198
AND E-199 FOR PLACEMENT
GUIDELINES FOR TYPE I, TYPE II
AND TYPE III DELINEATORS.

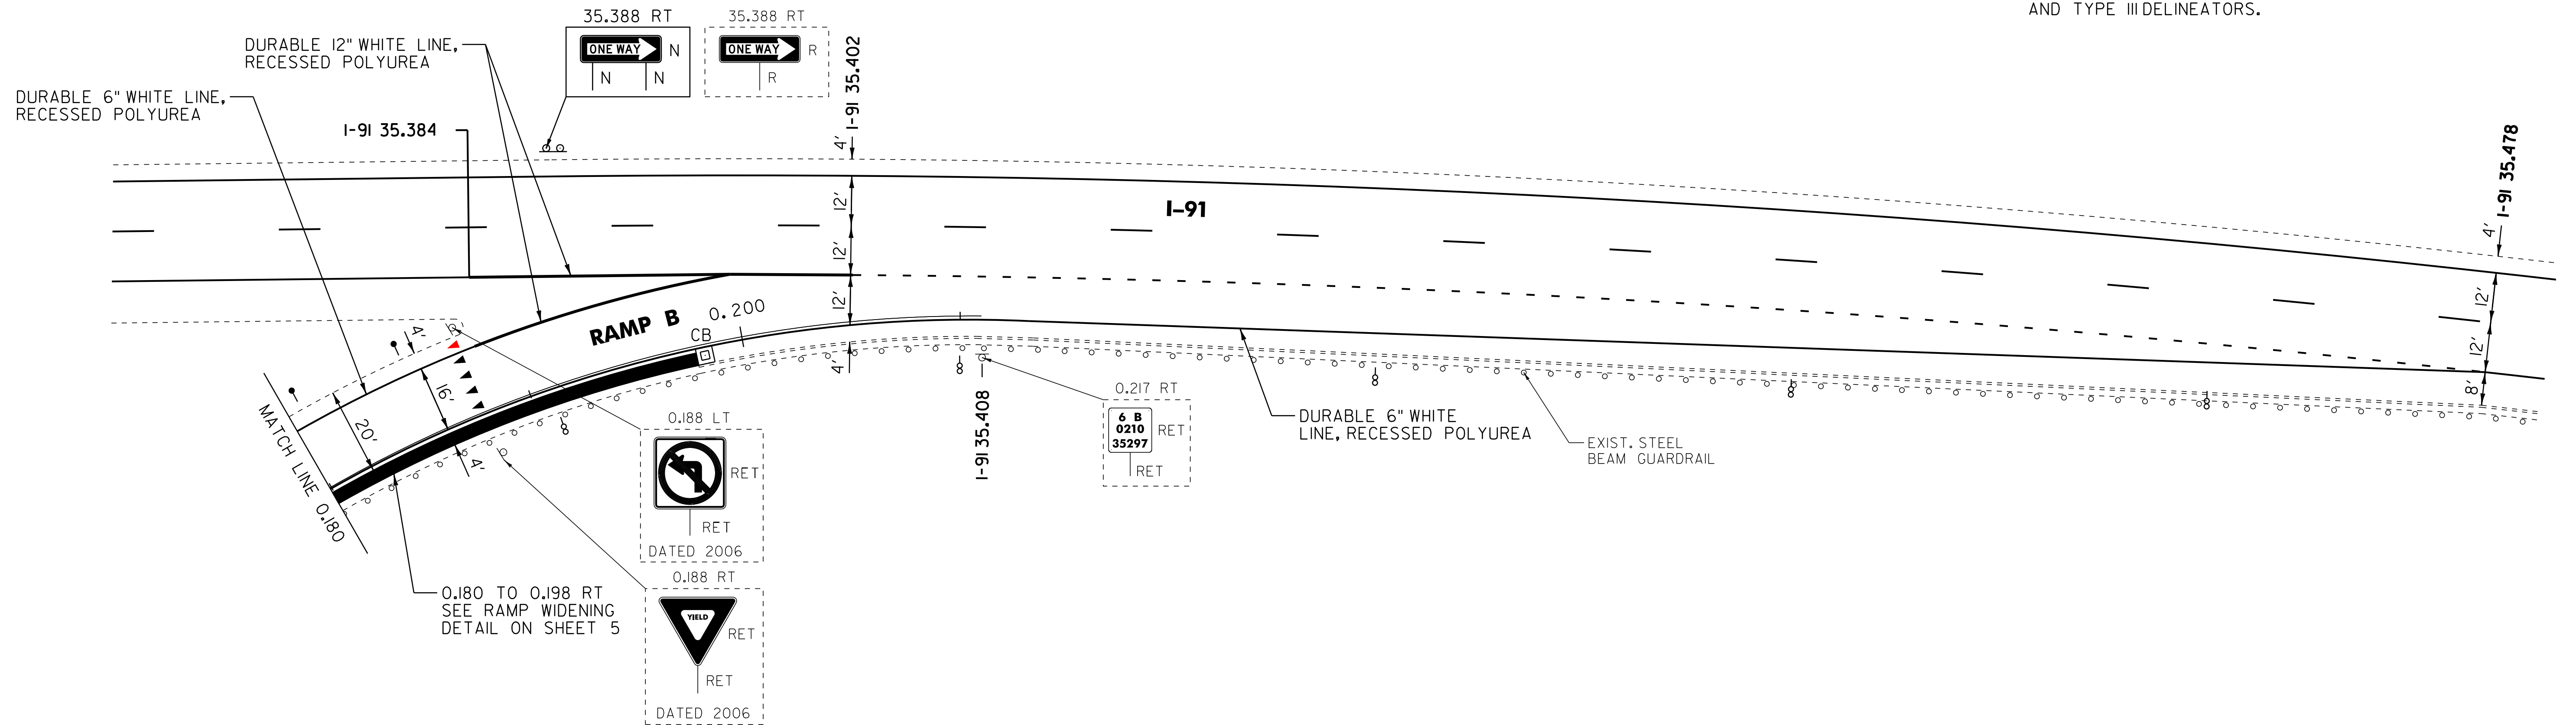

LEGEND

- R = REMOVE EXISTING
- S = SALVAGE
- R&S = REMOVE AND SALVAGE
- N = NEW
- RET = RETAIN
- B-B = BACK TO BACK
- = EXISTING GUARDRAIL
- - - = PROPOSED GUARDRAIL
- = TYPE I DELINEATOR, WHITE
- = TYPE I DELINEATOR, AMBER
- ⊙ = TYPE II DELINEATOR, WHITE
- ⊙ = TYPE III DELINEATOR, RIGHT
- ⊙ = TYPE III DELINEATOR, LEFT

EXIT 6 NB ON RAMP DETAIL SHEET 3

PROJECT NAME: WESTMINSTER-SPRINGFIELD
PROJECT NUMBER: IM 091-1(62)

FILE NAME: /pave/01a014/pa014
PROJECT LEADER: PTS
DESIGNED BY: NULL
IPARM FILE NAME: 01a014_25

PLOT DATE: 17-JAN-2013 12:44
DRAWN BY: MRS
CHECKED BY: PTS
SHEET 25 OF 43

NOT TO SCALE