

EXIT 7 - RAMP C & G NORTHBOUND OFF RAMP

SEE STANDARDS E-191, E-192 AND E-193
FOR PAVEMENT MARKING GUIDELINES

646.622 TEMPORARY 6" WHITE LINE, PAINT
646.426 DURABLE 6" WHITE LINE, RECESSED POLYUREA
0.180 TO 0.285 SOLID RT (RAMP C)
0.271 TO 0.285 SOLID RT (RAMP G)

646.632 TEMPORARY 6" YELLOW LINE, PAINT
646.436 DURABLE 6" YELLOW LINE, RECESSED POLYUREA
0.180 TO 0.246 SOLID LT (RAMP C)
0.246 TO 0.285 SOLID LT (RAMP G)
0.270 TO 0.285 SOLID LT (RAMP C)

646.662 TEMPORARY 12" WHITE LINE, PAINT
646.466 DURABLE 12" WHITE LINE, RECESSED POLYUREA
0.265 TO 0.270 SOLID LT (RAMP C)
0.265 TO 0.271 SOLID RT (RAMP G)


616.41 REMOVAL OF EXISTING CURB
0.247 TO 0.285 RT (RAMP C)

613.10 STONE FILL, TYPE I
0.269 RT (RAMP C)

675.50 REMOVING SIGNS
AS SHOWN - 23

675.60 ERECTING SALVAGED SIGNS
AS SHOWN - 10

NOTE:
REFER TO STANDARDS E-197, E-198
AND E-199 FOR PLACEMENT
GUIDELINES FOR TYPE I, TYPE II
AND TYPE III DELINEATORS.

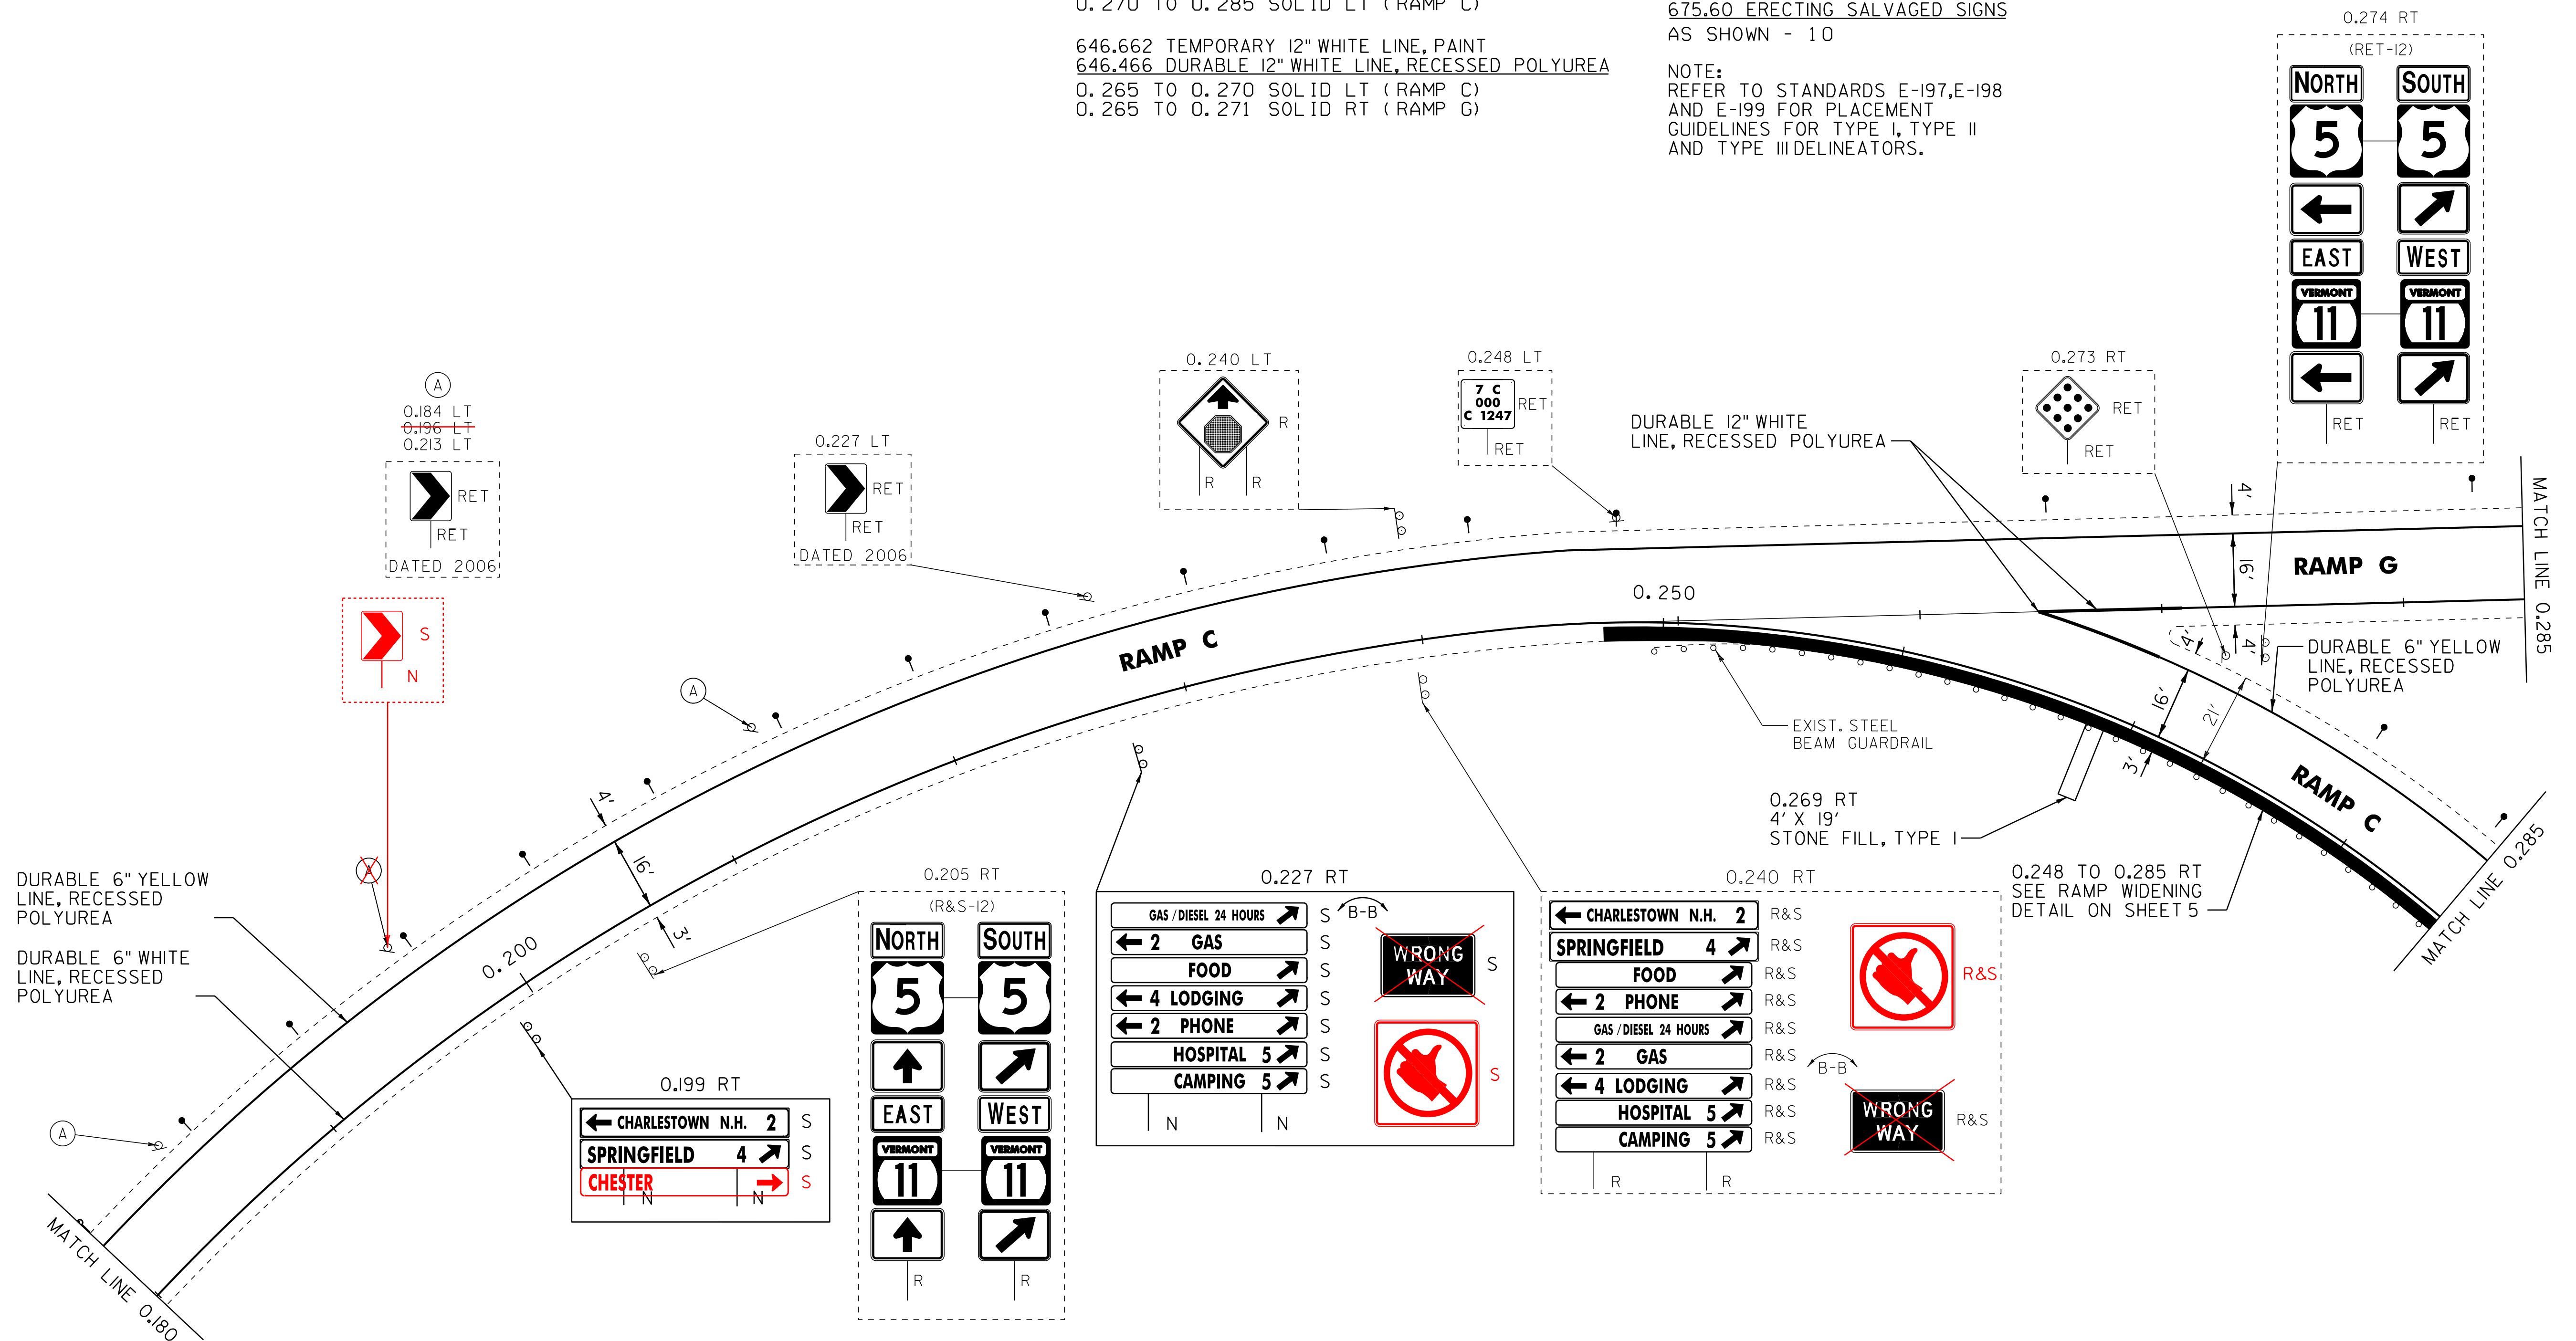

NOTE:
TOWN SIGN INSTALLED ACCORDING TO
PLANS IN 2010. SIGN WAS HIT OVER
THE WINTER AND INSTALLED OVER THE
HOSPITALITY SIGN AT 0.227 RT BY
DISTRICT. CHESTER SIGN WAS ADDED
OVER THE WINTER AND INSTALLED AT
THE CORRECT LOCATION AGAIN DURING
2011 CONSTRUCTION.

LEGEND

R	=	REMOVE EXISTING
S	=	SALVAGE
R&S	=	REMOVE AND SALVAGE
N	=	NEW
RET	=	RETAIN
B-B	=	BACK TO BACK
---	=	EXISTING GUARDRAIL
- - -	=	PROPOSED GUARDRAIL
○	=	TYPE I DELINEATOR, WHITE
○	=	TYPE I DELINEATOR, AMBER
○	=	TYPE II DELINEATOR, WHITE
○	=	TYPE III DELINEATOR, RIGHT
○	=	TYPE III DELINEATOR, LEFT

EXIT 7 NB OFF RAMP DETAIL SHEET 2

PROJECT NAME: WESTMINSTER-SPRINGFIELD
PROJECT NUMBER: IM 091-1(62)

FILE NAME: /pave/01a014/pa014
PROJECT LEADER: PTS
DESIGNED BY: NULL
IPARM FILE NAME: 01a014_30

PLOT DATE: 17-JAN-2013 12:44
DRAWN BY: MRS
CHECKED BY: PTS
SHEET 30 OF 43

NOT TO SCALE