



GUARDRAIL TREATMENT AT BULLNOSE LOCATION - BRIDGE 25N

BRIDGE 25N NORTHBOUND & SOUTHBOUND MM 40.922
INTERSTATE 91 OVER US ROUTE 5

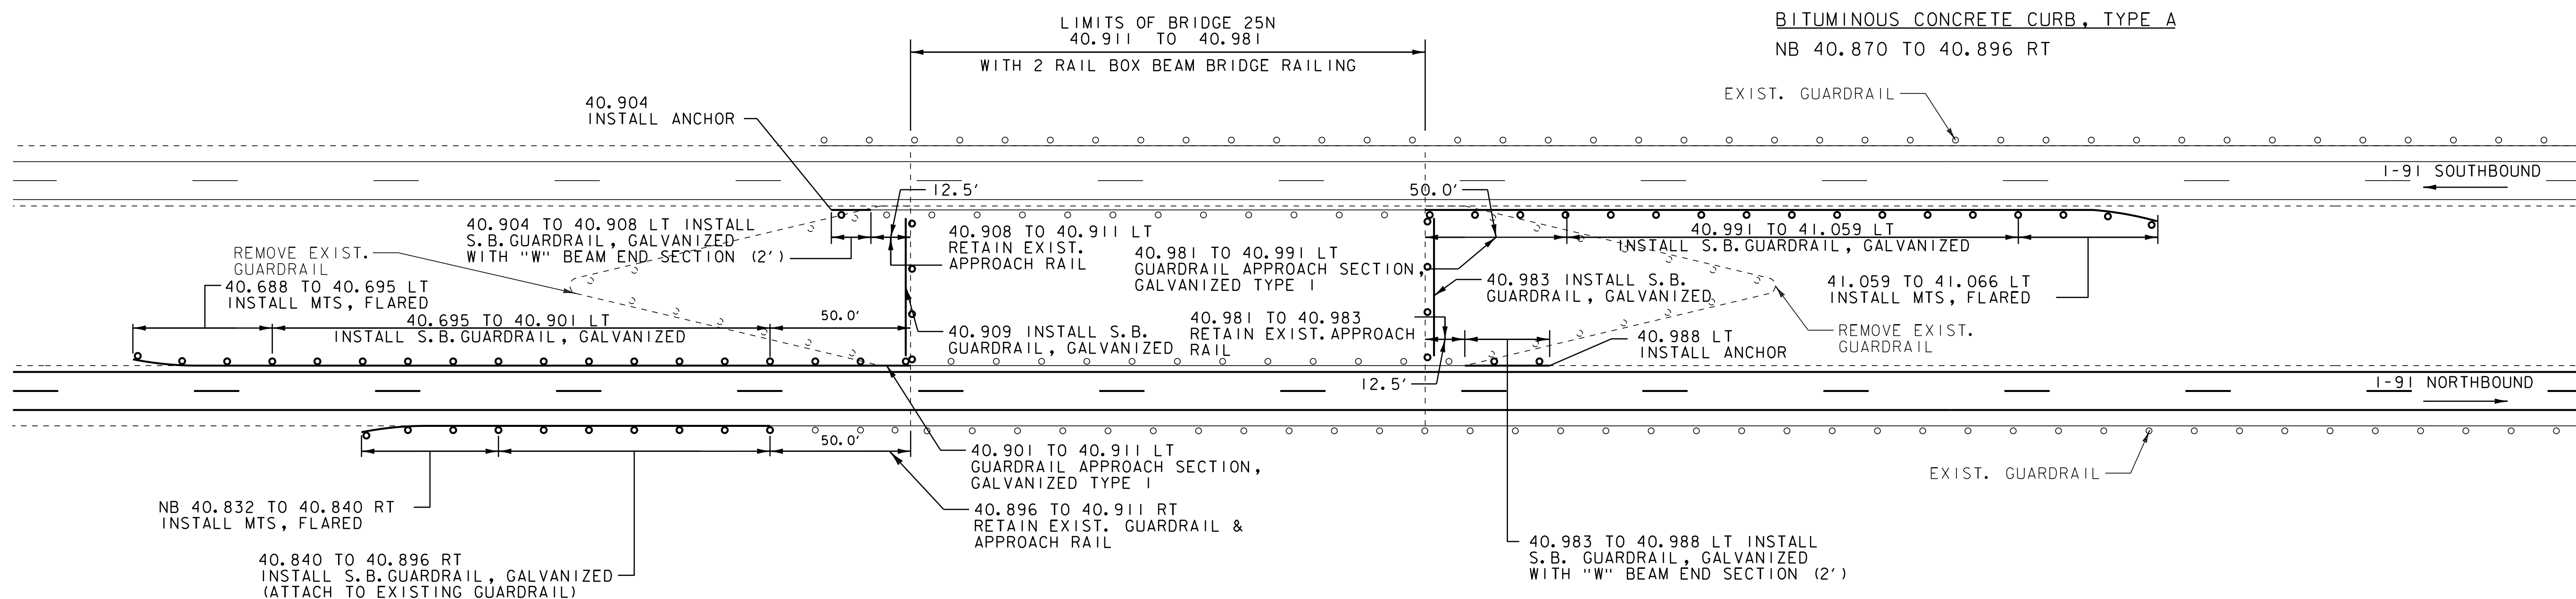

GUARDRAIL TREATMENT AT BULLNOSE LOCATION - BRIDGE 26N

BRIDGE 26N NORTHBOUND & SOUTHBOUND MM 41.264
INTERSTATE 91 OVER BLACK RIVER

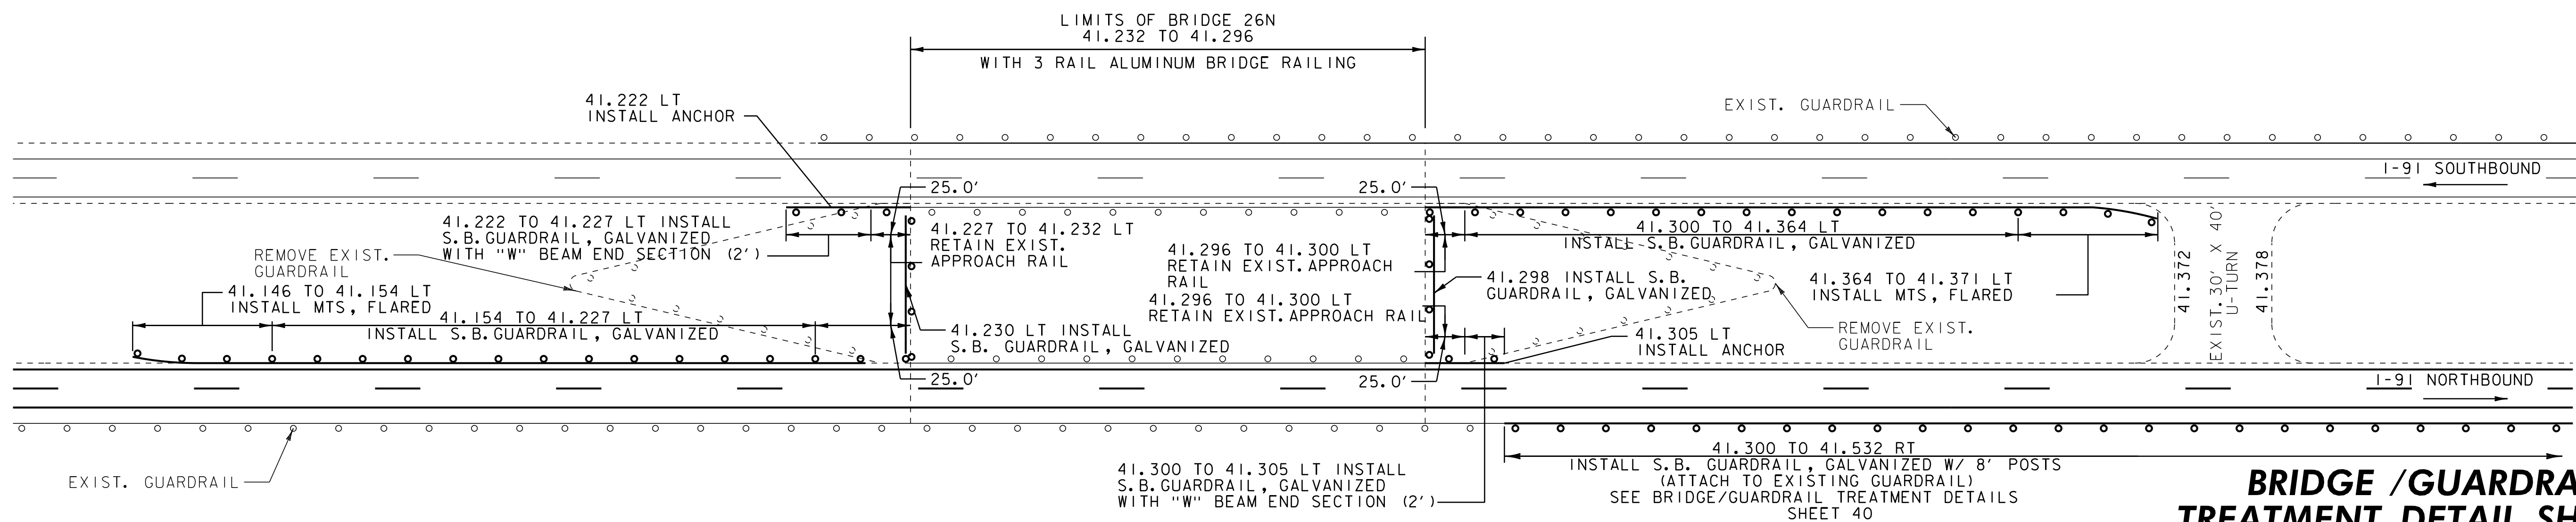

BRIDGE / GUARDRAIL TREATMENT DETAIL SHEET 2

PROJECT NAME: WESTMINSTER-SPRINGFIELD
PROJECT NUMBER: IM 091-1(62)

FILE NAME: /pave/01a014/pa014
PROJECT LEADER: PTS
DESIGNED BY: NULL
IPARM FILE NAME: 01a014_39

PLOT DATE: 17-JAN-2013 12:44
DRAWN BY: JBZ
CHECKED BY: PTS
SHEET 39 OF 43

NOT TO SCALE