


# GUARDRAIL TREATMENT - BRIDGE 27N

BRIDGE 27N NORTHBOUND MM 41.550  
INTERSTATE 91 OVER SPRINGFIELD BIKE PATH

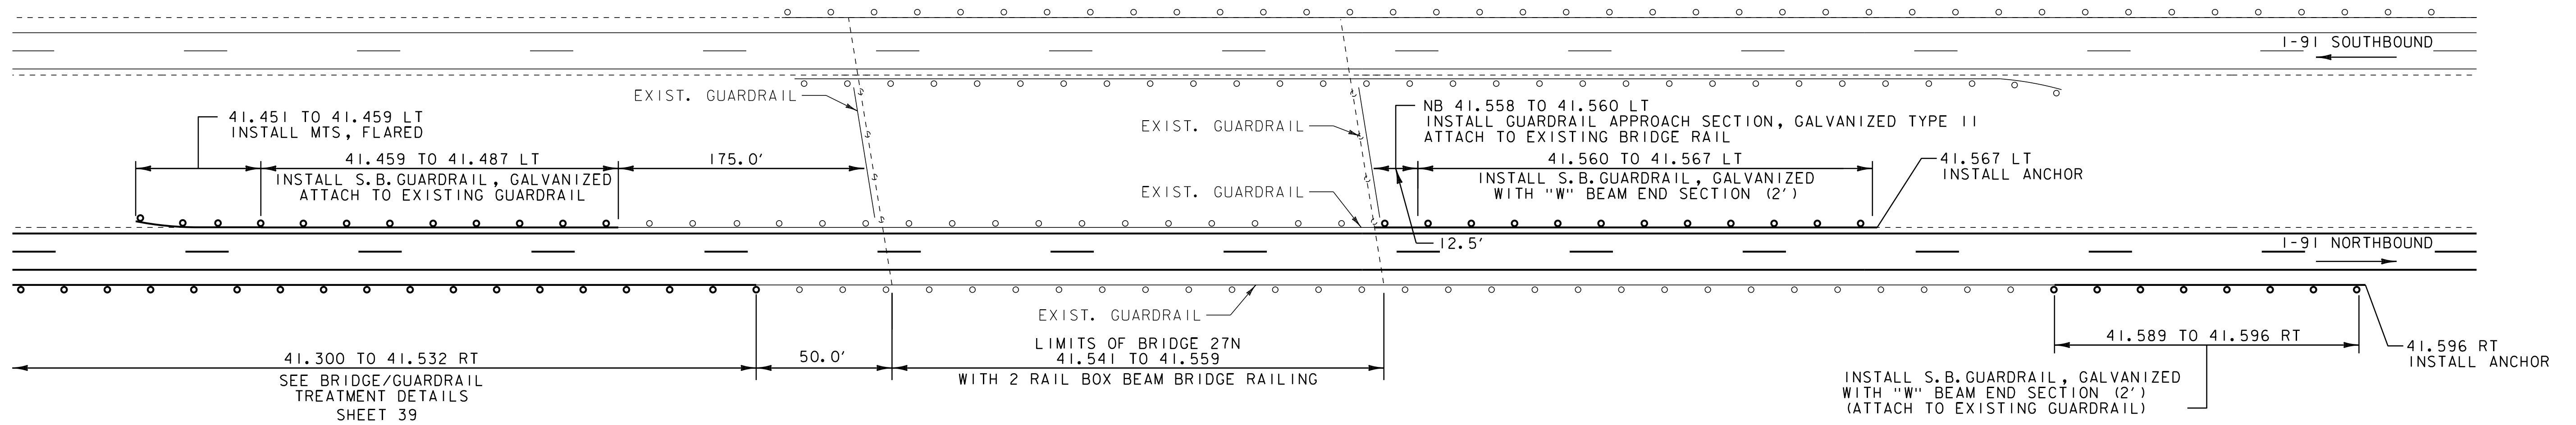

# GUARDRAIL TREATMENT - BRIDGE 28N

SEE SHEETS 28 AND 29

## BRIDGE / GUARDRAIL TREATMENT DETAIL SHEET 3

PROJECT NAME: WESTMINSTER-SPRINGFIELD

PROJECT NUMBER: IM 091-1(62)

FILE NAME: /pave/01a014/pa014

PLOT DATE: 17-JAN-2013 12:44

PROJECT LEADER: PTS

DRAWN BY: HJD

DESIGNED BY: NULL

CHECKED BY: PTS

IPARM FILE NAME: 01a014\_40

SHEET 40 OF 43

NOT TO SCALE