

NORTHERN REGION


I-89

I-89 SB S.BURLINGTON
MM86.93 - 87.35

I-89 NB S.BURLINGTON
MM85.80 - 86.35

**I-89 NB WILLISTON-
S.BURLINGTON**
MM84.50 - 85.35

I-89 NB RICHMOND-WILLISTON
MM79.00 - 79.60

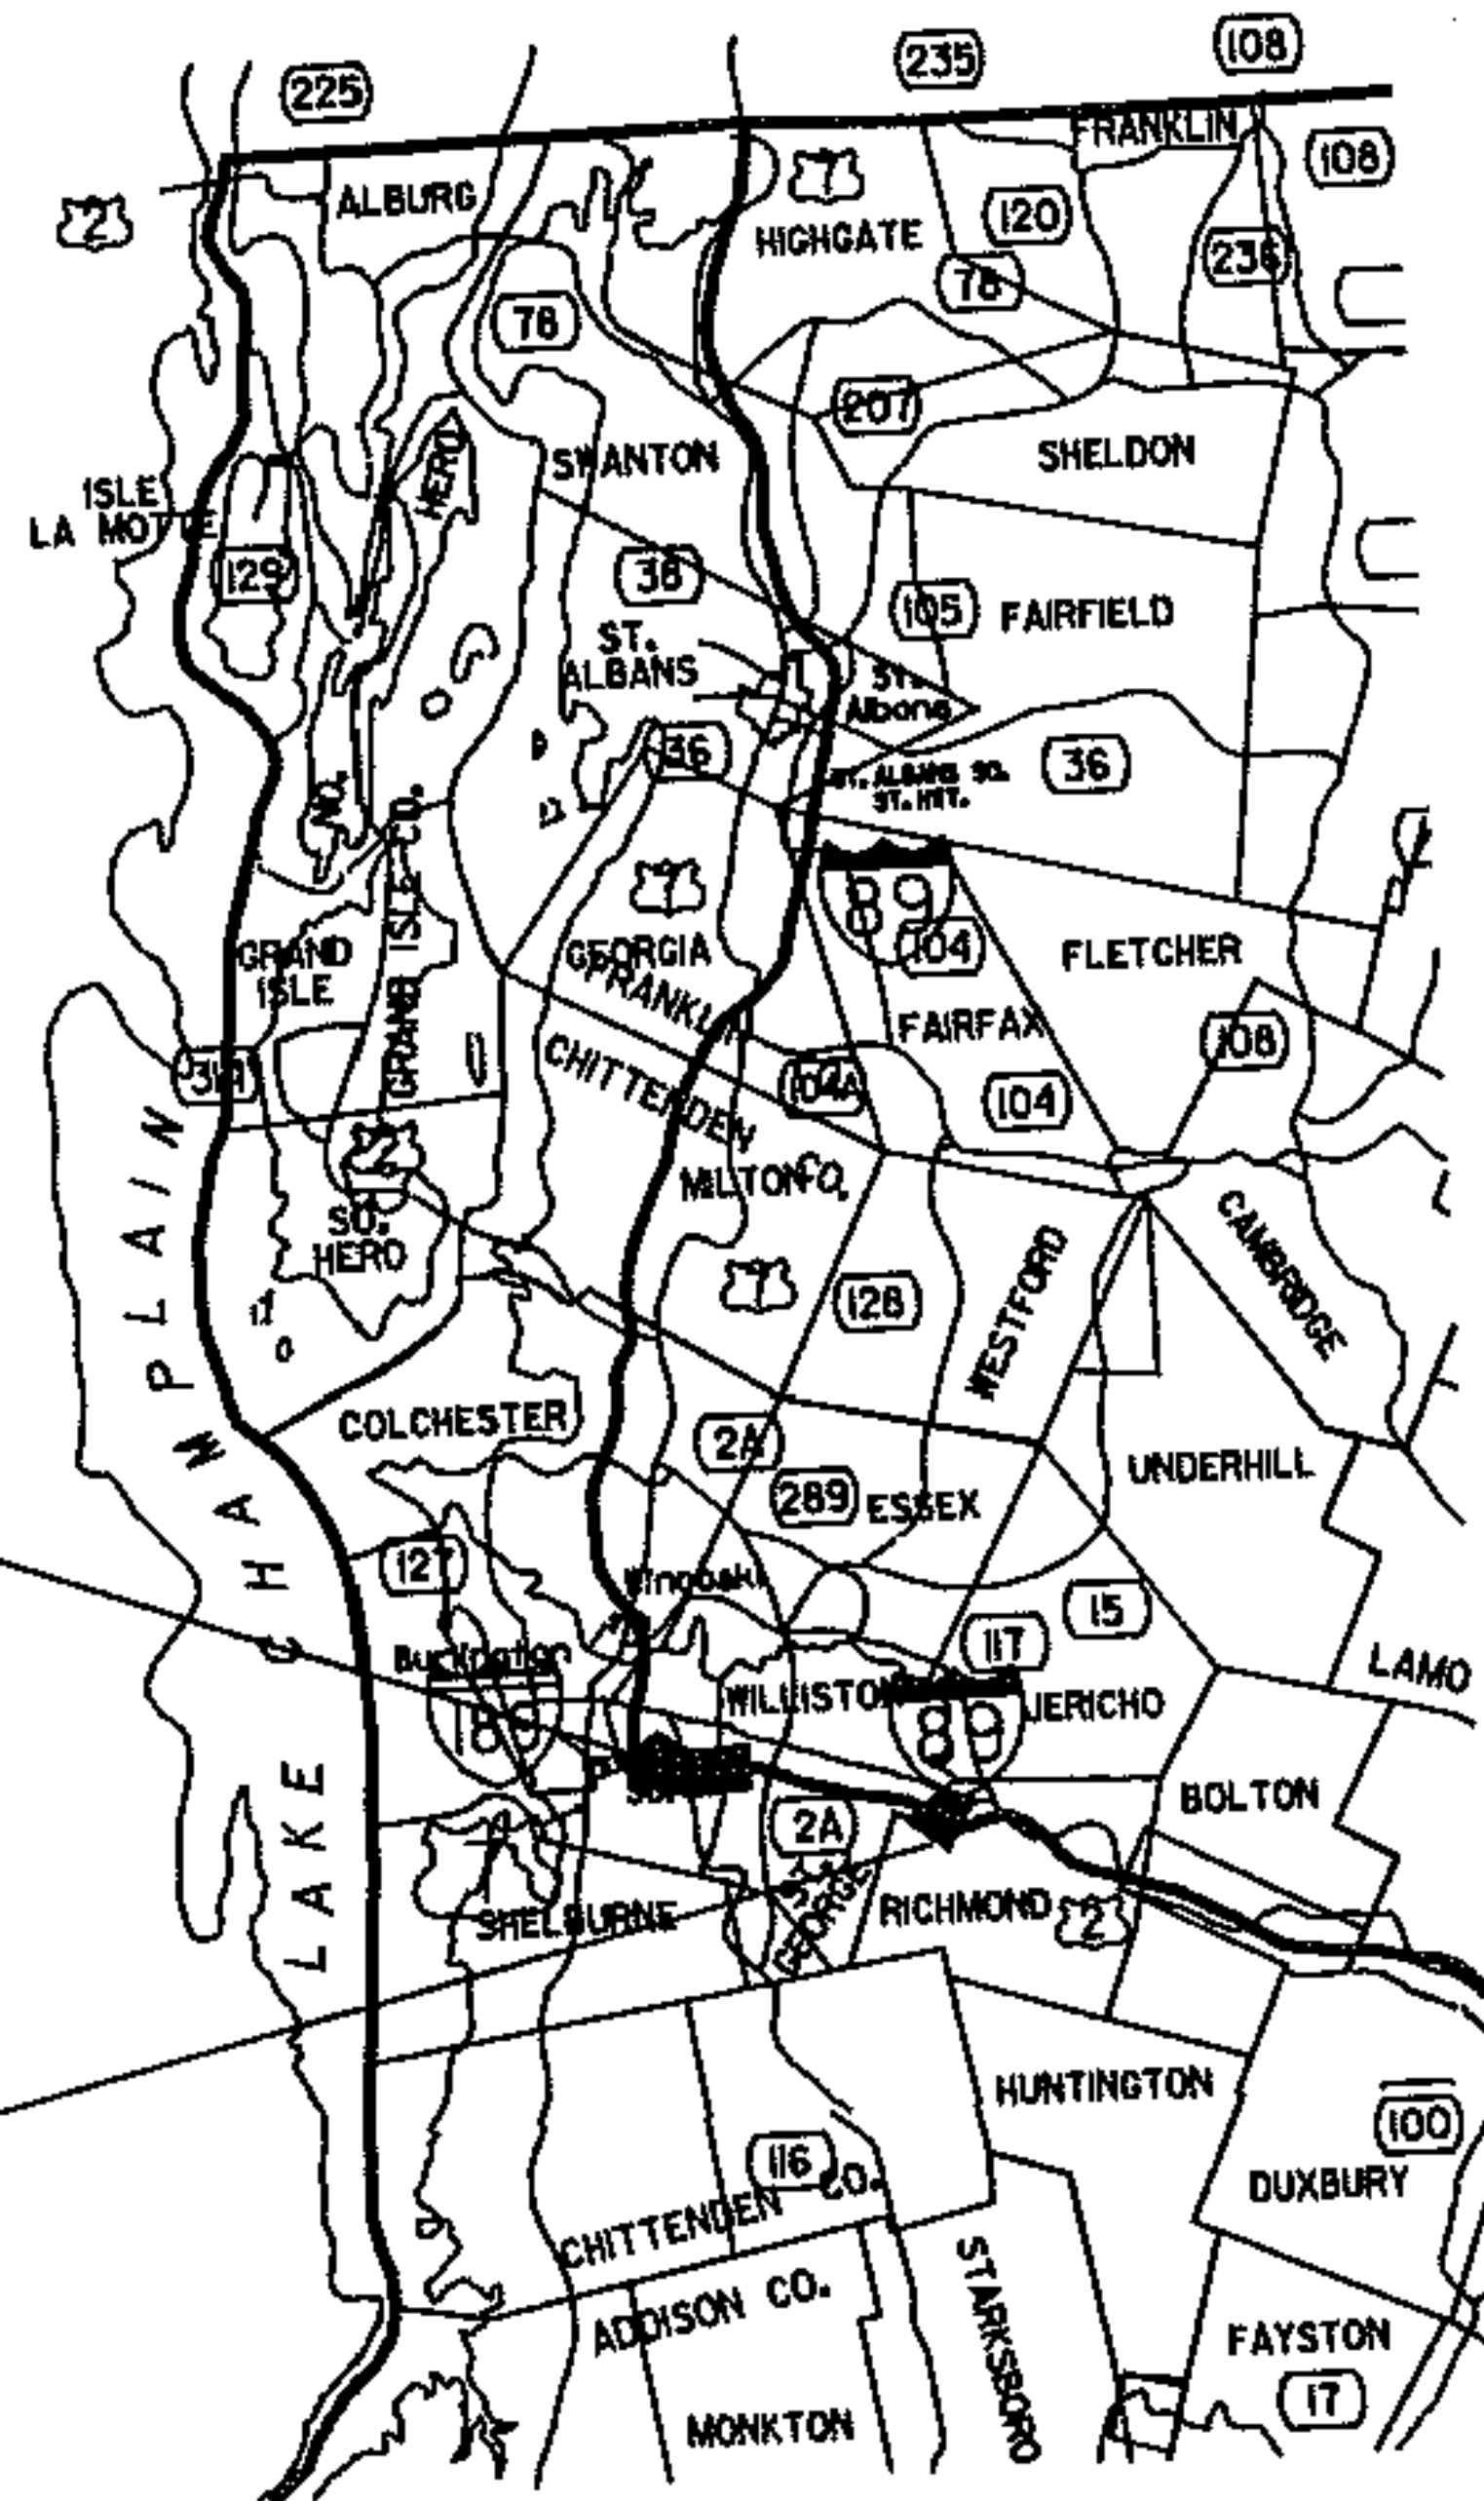

**RUT
LOCATION
DETAIL**

PROJECT: STATEWIDE

PROJECT NO.:
IM RUT(6)

DESIGN FILE NAME: /pave/0k076/pk07a.dgn
PARM FILE NAME: pk07b.d21
SURVEYED BY:
SQUAD LEADER:

PLOT DATE: 15-MAY-200
SURVEY DATE:
DRAWN BY:
SHEET: 5 OF 6