

REINFORCED ELASTOMERIC BEARING FABRICATION SHEET 1103- Page #: 1

Project #: 53218-1103-1(24 OF 24) Customer: BECK & BELLUCCI

County: WINDHAM State: VT Structure: 5N/5S ⁴⁸

Pad I.D./Loc.: ABUT 1 & PIER 1 Quantity (Including Full Size Sample(s) - If Req'd): 48

Certifications Are Required YES, see below NO, random in-house only
 Sample Req'd: YES - (If not full size, create another sheet) NO

State D.O.T. Spec. Number (If Specified): - Project # (req'd for cert.'s) 111 091-1(50)

Special Notes: BEVELED SHIM

Shim Steel Spec. (Circle One) A709 GR.36 (250) A1011 GR.36 (250)-Type 1 Other: -

Durometer Requirement (Circle One) 50±5 60±5 Other: - Shear Modulus Requirement: 140psi min


Neoprene Grade (Circle One): 3 4 Other Grade or Natural Rubber: NATURAL RUBBER

TYLIN INTERNATIONAL SUBMITTAL REVIEW


Review is for general conformance with the contract plans. Neither the presence nor the absence of markings or notations on this submittal shall be construed as relieving the contractor from compliance with the contract plans and specifications. The preparer of this submittal is solely responsible for the accuracy of dimensions, selection of proper materials, development of techniques, safety, and proper construction in performance of the work depicted hereon.

- No Exceptions Taken
- Make Corrections Noted
- Amend and Resubmit
- Rejected
- Review Not Required

By: Anthony Joly Date: 7/12/11

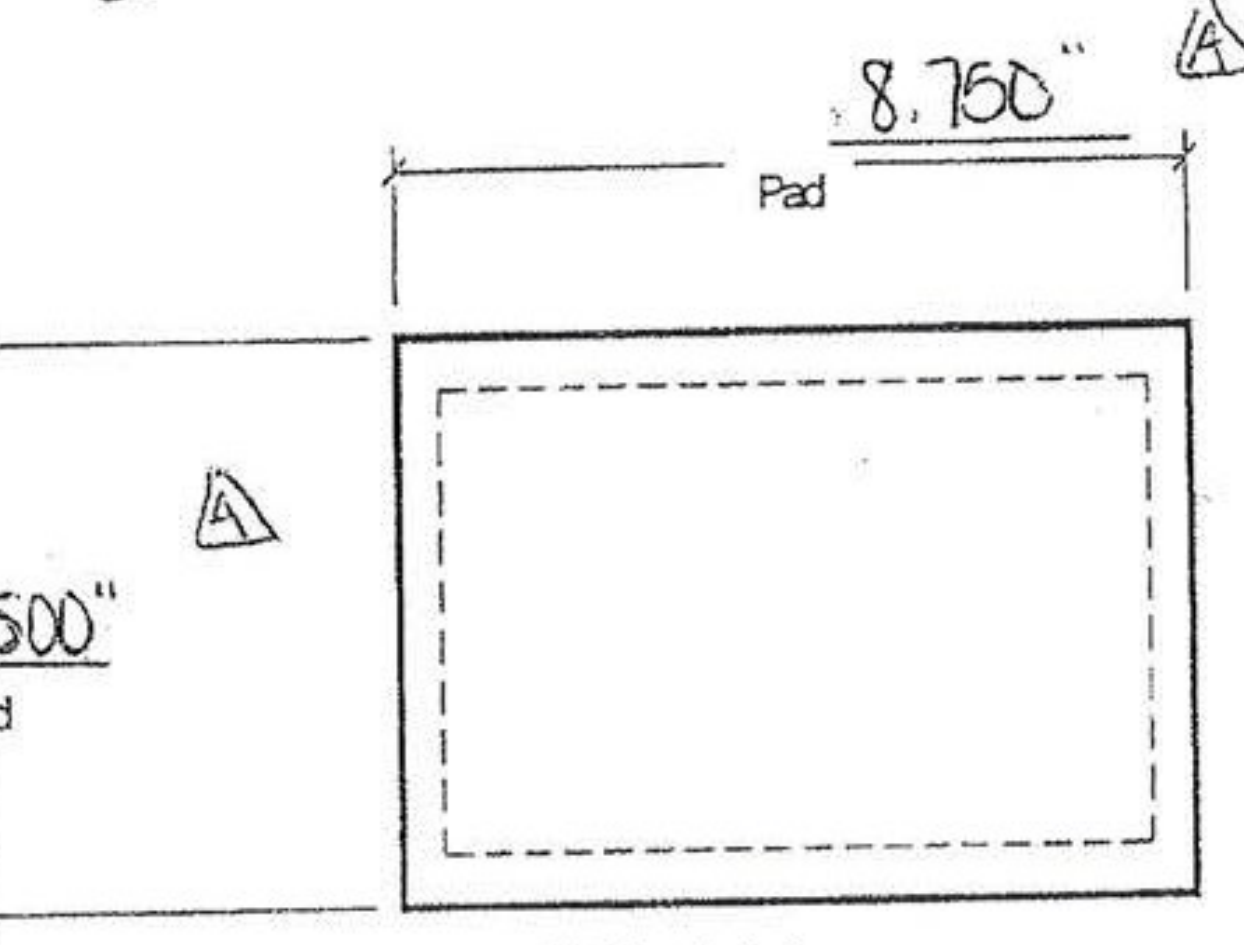

PLAN
NOT TO SCALE

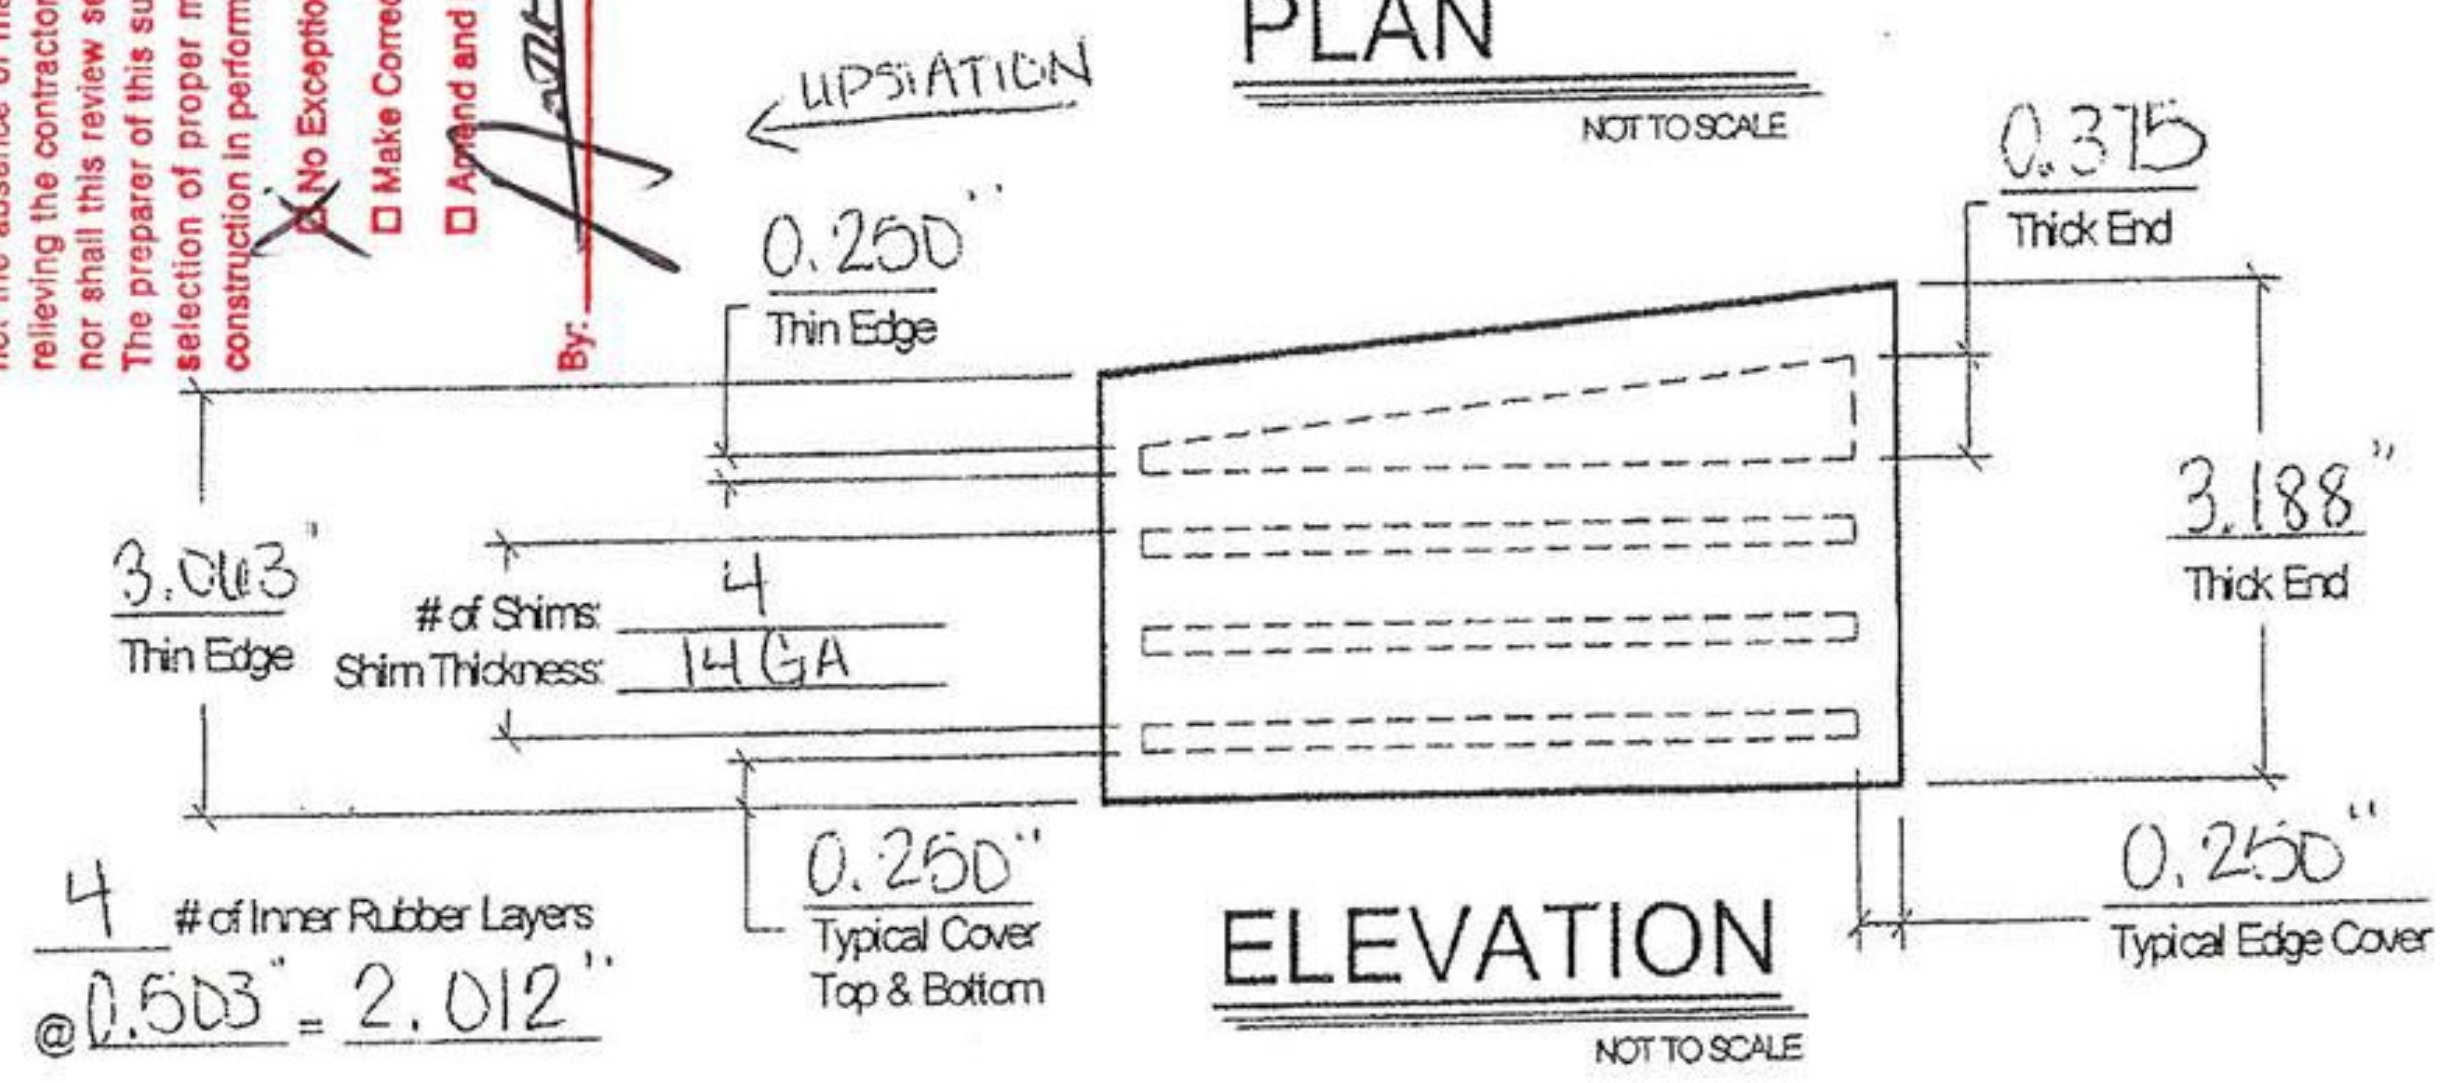

ELEVATION
NOT TO SCALE

Name: Martina Ariss Date: 7-7-11
 This shop drawing was prepared in accordance with the contract plans and specifications. The D.S. Brown Company does not accept liability for the design of the products detailed in the shop drawings.