

REINFORCED ELASTOMERIC BEARING FABRICATION SHEET 1103- Page #: 2

Project #: 33218-1103-2 (24 of 24) Customer: BECK & BELLUCCI
 County: WINDHAM State: VT Structure: 5N/5S ^A
 Pad I.D./Loc.: PIER 2 & ABUT 2 Quantity (Including Full Size Sample(s) - If Req'd): 48

Certifications Are Required YES, see below NO, random in-house only
 Testing Req'd: YES - (If not full size, create another sheet) NO

State D.O.T. Spec. Number (If Specified): — Project # (req'd for cert.'s) 1M 091-1(50)

Special Notes: BEVELED SHIM

Shim Steel Spec. (Circle One): A709 GR.36 (250) A1011 GR.36 (250)-Type 1 Other: —


Durometer Requirement (Circle One): 50x5 60x5 Other: — Shear Modulus Requirement: 140 psi min. ^A

Neoprene Grade (Circle One): 3 (4) Other Grade or Natural Rubber: NATURAL RUBBER

TYL INTERNATIONAL SUBMITTAL REVIEW

Review is for general conformance with the contract plans. Neither the presence nor the absence of markings or notations on this submittal shall be construed as relieving the contractor from compliance with the contract plans and specifications. The preparer of this submittal is solely responsible for the accuracy of dimensions, selection of proper materials, development of techniques, safety, and proper construction in performance of the work depicted hereon.

- No Exceptions Taken
- Rejected
- Make Corrections Noted
- Review Not Required
- Amend and Resubmit

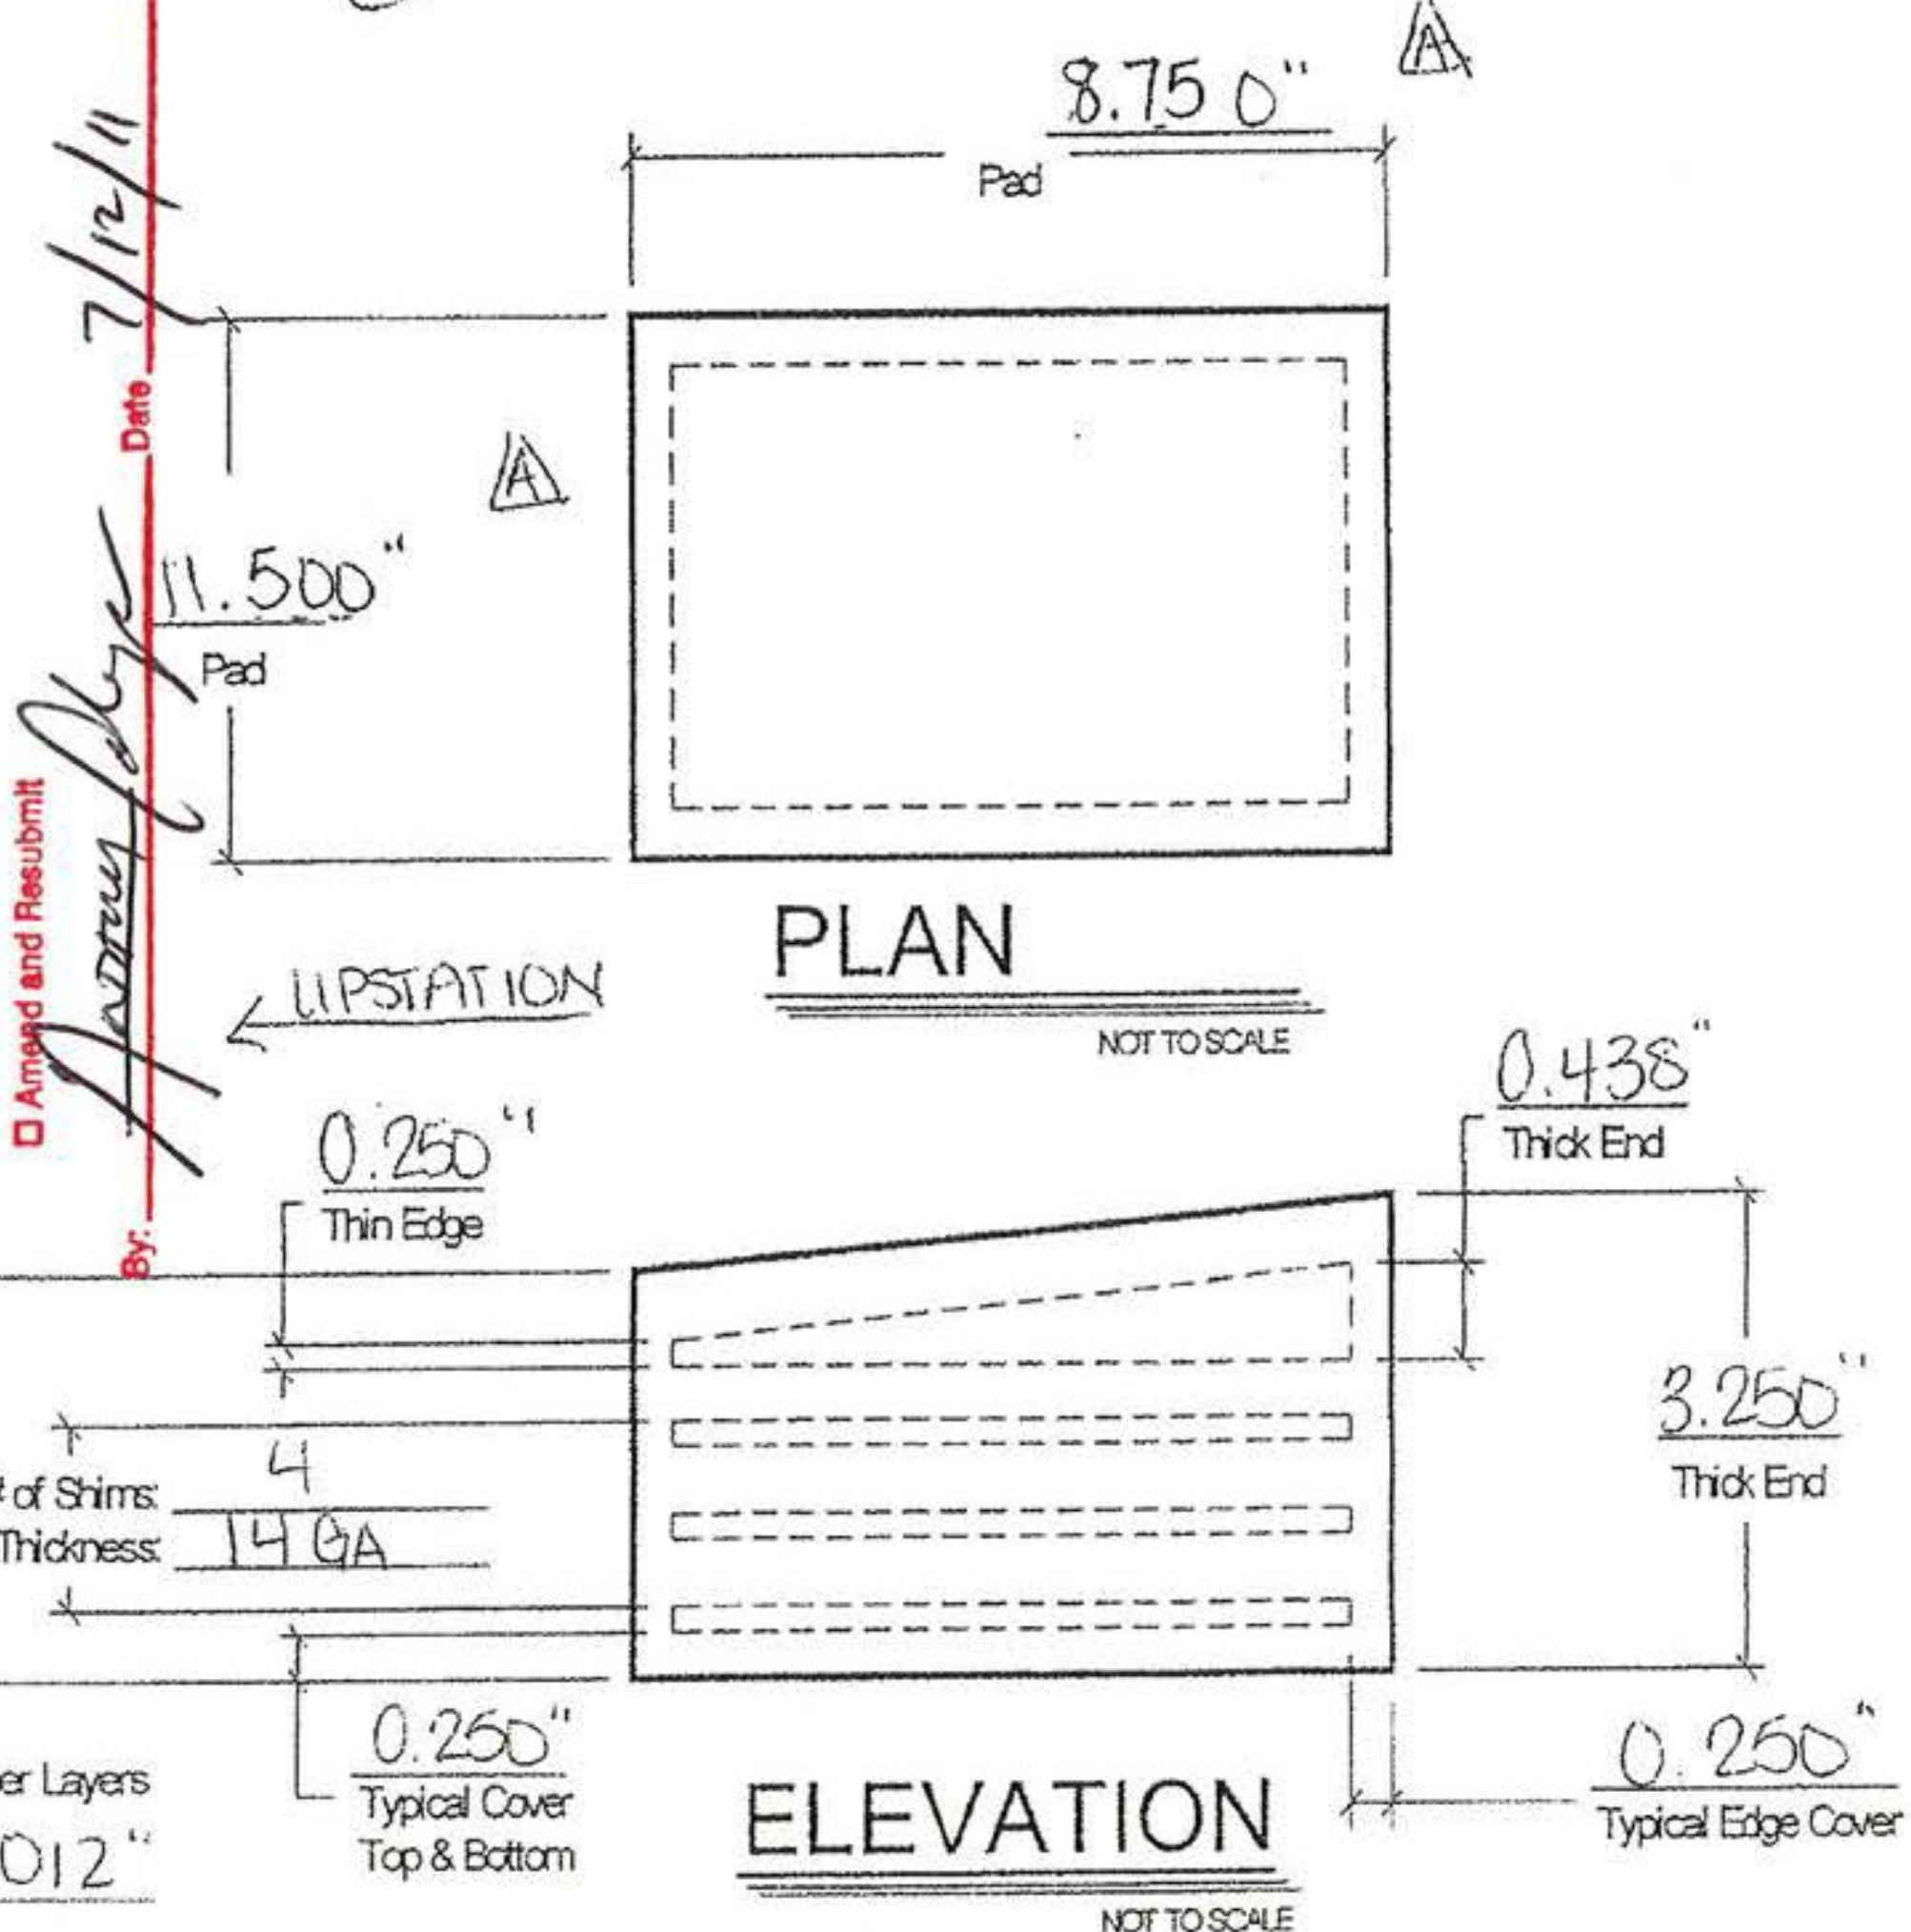

Name: Anthony Pige Date: 7-7-11
 This shop drawing was prepared in accordance with the contract plans and specifications. The D.S. Brown Company does not accept liability for the design of the products detailed in the shop drawings.