
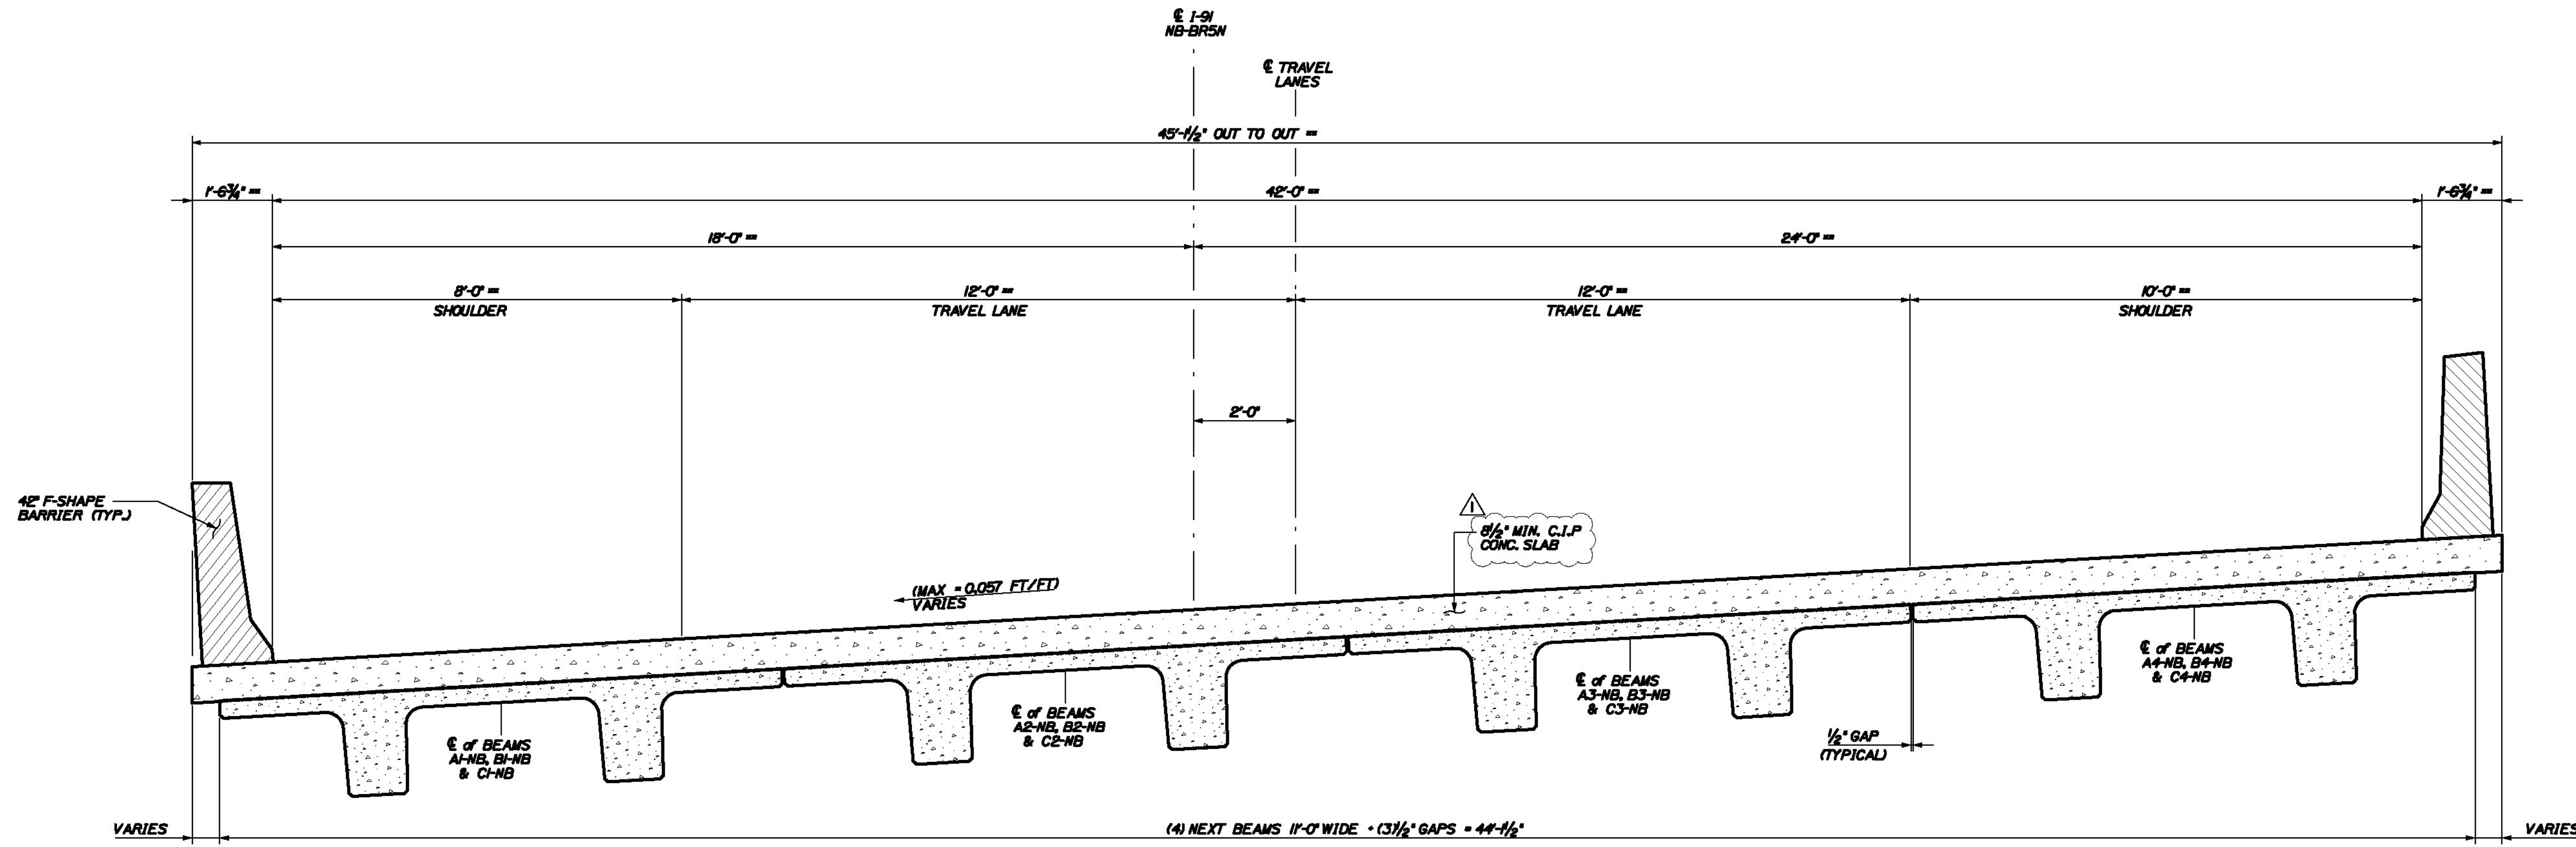


Date: 7/20/2011

Username: common



Filename: ... \001.Layout\_Brattleboro.mkggroup: Structures Division

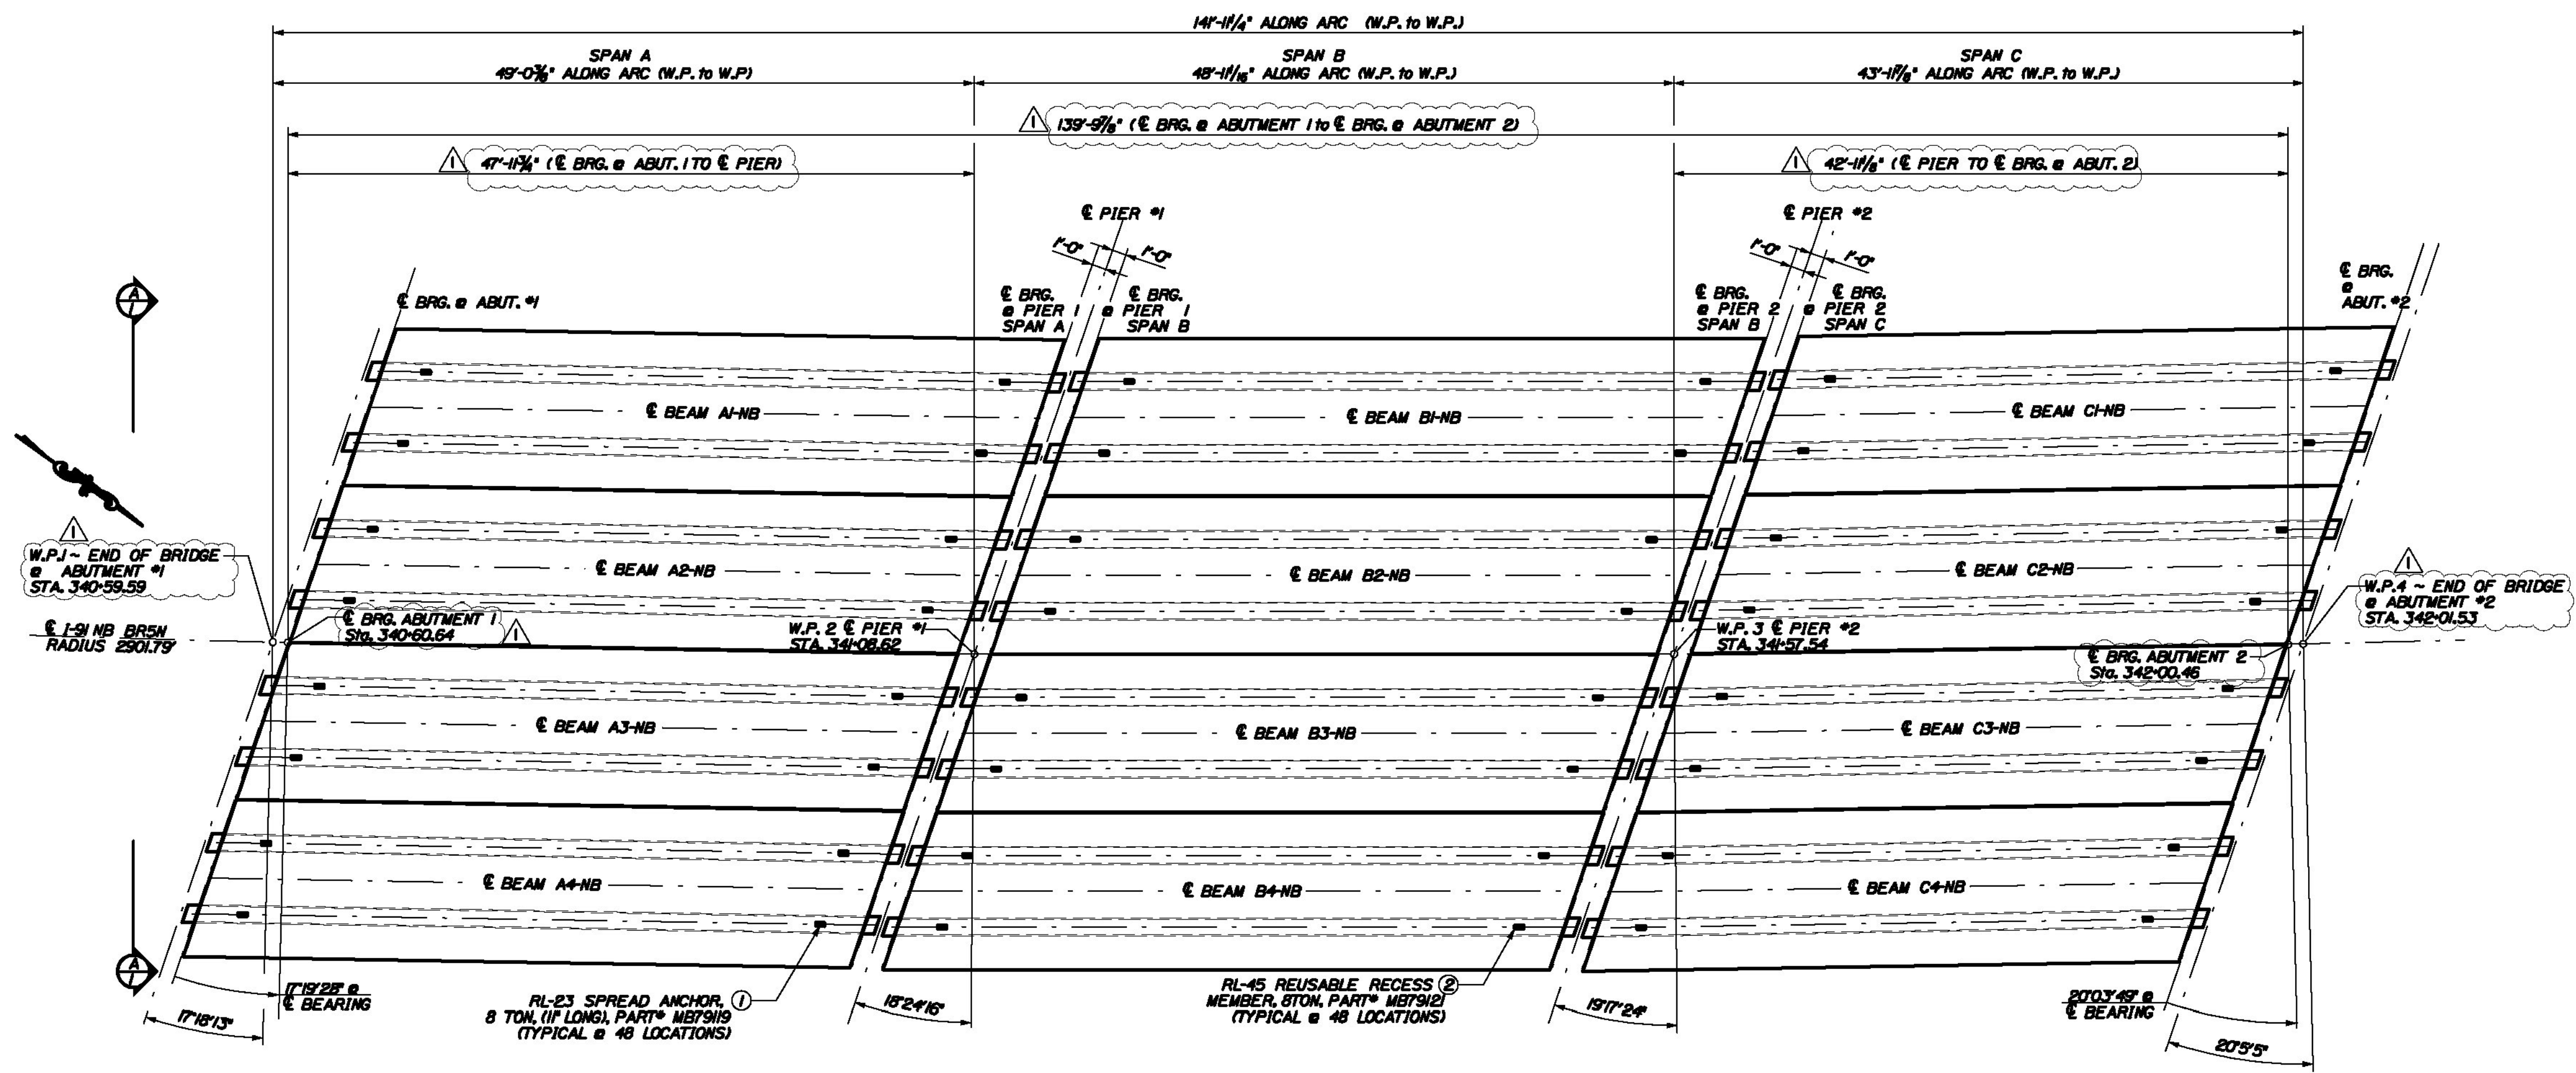

NOTE:  
- - - RADIAL DIMENSIONS

THE PROFESSIONAL ENGINEER'S STAMPS  
WERE PREPARED UNDER THE DIRECT  
SUPERVISION OF A REGISTERED PROFESSIONAL  
ENGINEER AND COMPLY WITH THE DESIGN AND  
DETAILS SHOWN ON THE CONTRACT DRAWING  
UNLESS REQUESTED OTHERWISE.

CONTRACTOR: BECK & BELLUCCI, INC.  
PROJECT: BRATTLEBORO, VERMONT  
IM 019-1(60)

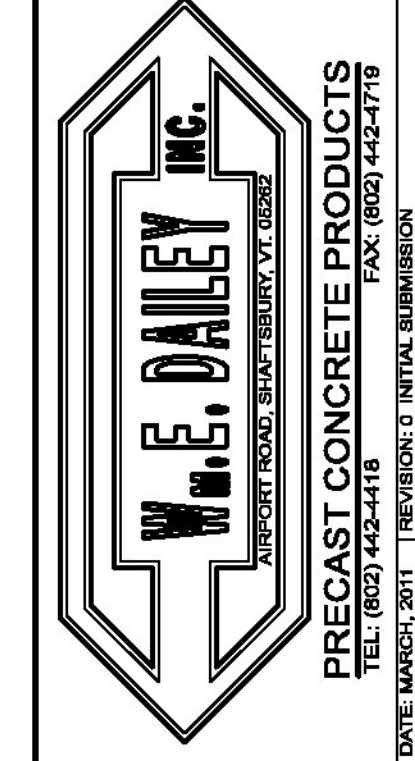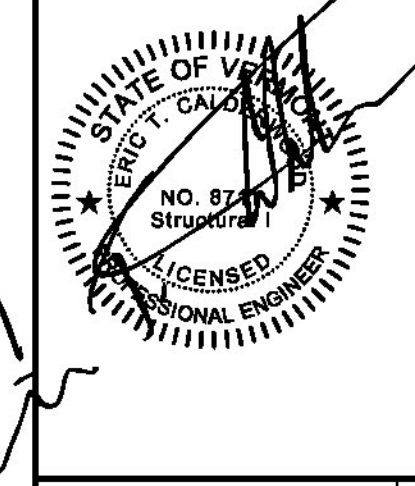

I-91 BRATTLEBORO, VERMONT  
OVER MAPLE ST.  
GENERAL LAYOUT &  
RELATED DETAILS

SHEET NUMBER  
1