


PLAN VIEW SCALE: 1/8" = 1'-0"

**T-Y-LIN INTERNATIONAL**

Checked by: *[Signature]* Date: June 11, 2012

Reviewed by: *[Signature]* Date: June 11, 2012

Checking is for general compliance with the design concept of the project and general compliance with the information given in the contract documents only. Any action shown is not an approval and is subject to the requirements of the plans and specifications. Any action shown on a specific item shall not preclude the checking of an assembly of which the item is a component. Contractor is solely responsible for dimensions which shall be confirmed and correlated at the job site, fabrication processes, techniques of construction, safety precautions and coordination of its work with that of all other trades and the satisfactory performance of its work.


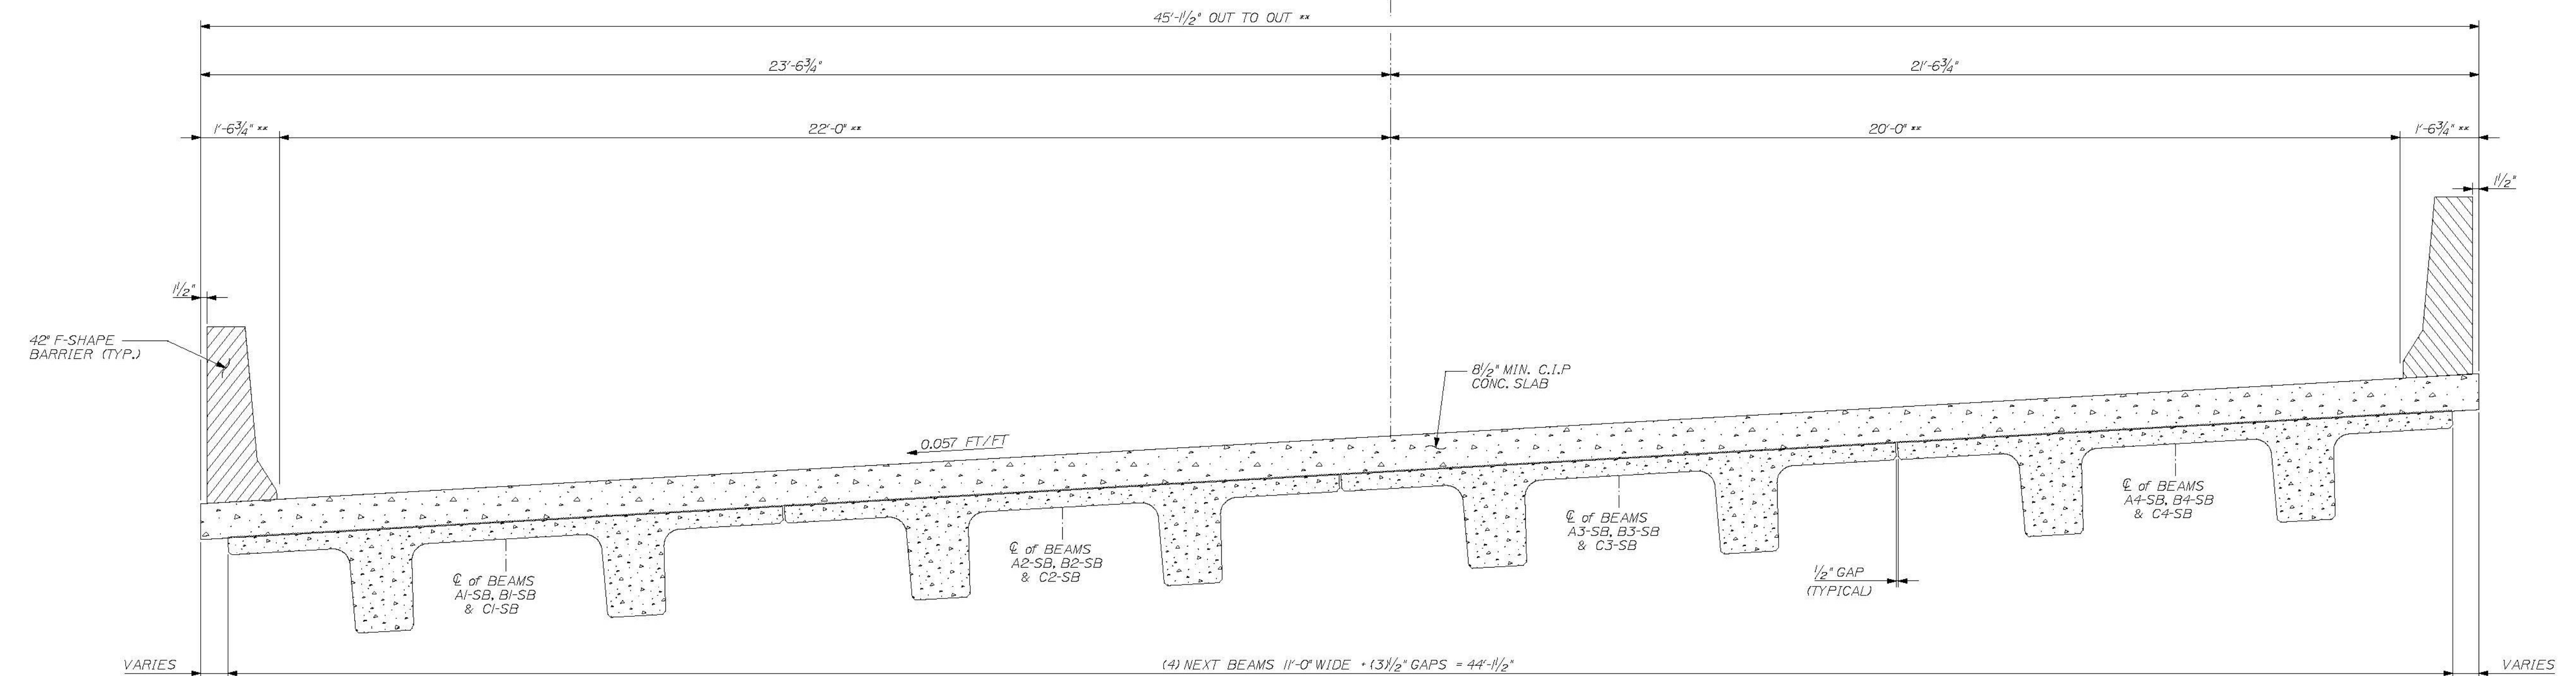


TYPICAL TRANSVERSE SECTION SCALE: 1/2" = 1'-0"

NOTE: \*\* = RADIAL DIMENSIONS

THE PROFESSIONAL ENGINEER'S STAMP IS THE PROPERTY OF THE CONTRACTOR. IT IS TO BE USED ONLY FOR THE PROJECT AND UNDER THE DIRECT SUPERVISION OF A REGISTERED PROFESSIONAL ENGINEER AND COMPLY WITH THE DESIGN AND DETAILS SHOWN ON THE CONTRACT DRAWING UNLESS REQUESTED OTHERWISE.

CONTRACTOR: BECK & BELLUCCI, INC.

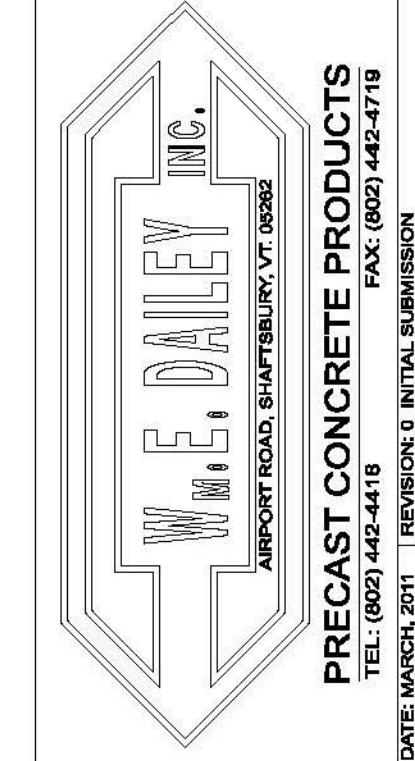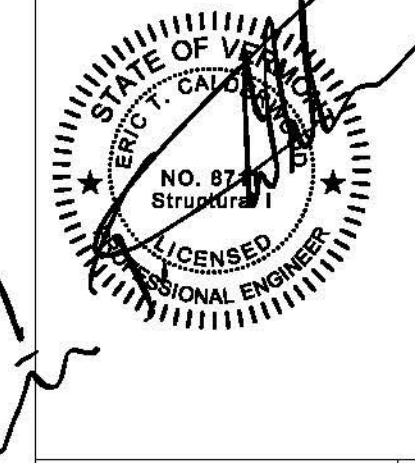

I-91 BRATTLEBORO, VERMONT OVER MAPLE ST.

GENERAL LAYOUT & RELATED DETAILS

SHEET NUMBER