


REINFORCEMENT PLAN VIEW ~ BEAM "A1-SB"
SCALE: 1/2" = 1'-0"

IF WWF NEEDS TO BE CUT TO PLACE OVER STIRRUPS USE PROCEDURE BELOW:
 1. FOR CUT TRANSVERSE WIRE, SPLICE A #3 x 45" EPOXY COATED REBAR ORIENTED IN THE SAME DIRECTION OF THE CUT WIRE AND CENTERED.
 2. FOR CUT LONGITUDINAL WIRE, SPLICE A #3 x 28" EPOXY COATED REBAR ORIENTED IN THE SAME DIRECTION OF THE CUT WIRE AND CENTERED.

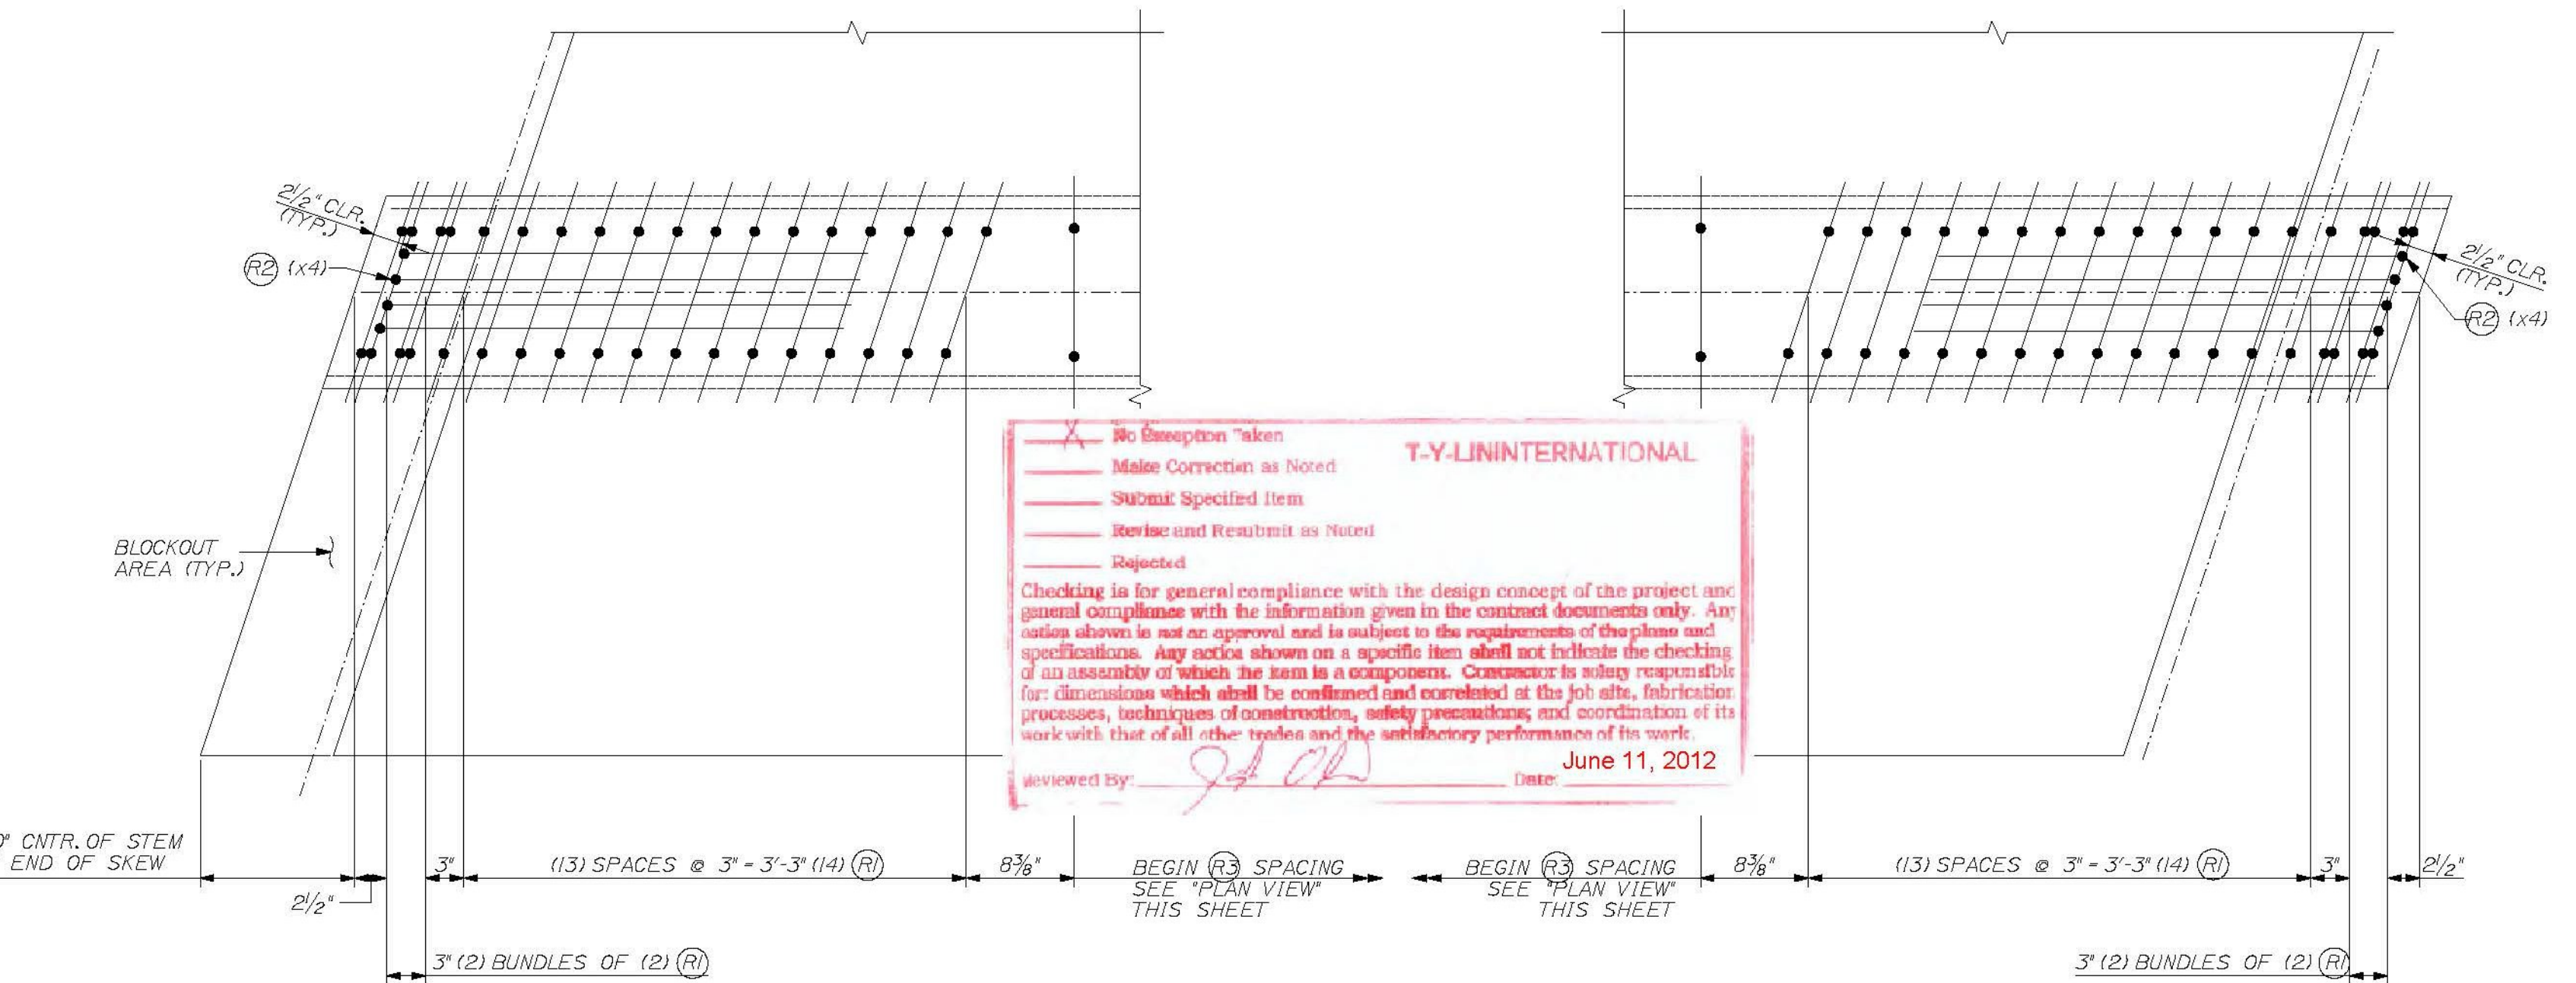


T-Y LIN INTERNATIONAL

No Exception Taken
 Make Correction as Noted
 Submit Specified Item
 Review and Resubmit as Noted
 Rejected


Checking is for general compliance with the design concept of the project and general compliance with the information given in the contract documents only. Any action shown is not an approval and is subject to the requirements of the plans and specifications. Any action shown on a specific item shall not indicate the checking of an assemblage of which the item is a component. Contractor is solely responsible for dimensions which shall be confirmed and controlled at the job site, fabrication processes, techniques of construction, safety precautions, and coordination of its work with that of all other trades and the satisfactory performance of its work.

Reviewed by: *[Signature]* Date: June 11, 2012

NOTE: STRAIGHT #4 BARS & WELDED WIRE FABRIC NOT SHOWN FOR CLARITY, SEE PLAN VIEW THIS SHEET.
 STEM END DETAIL
 SCALE: 1" = 1'-0"

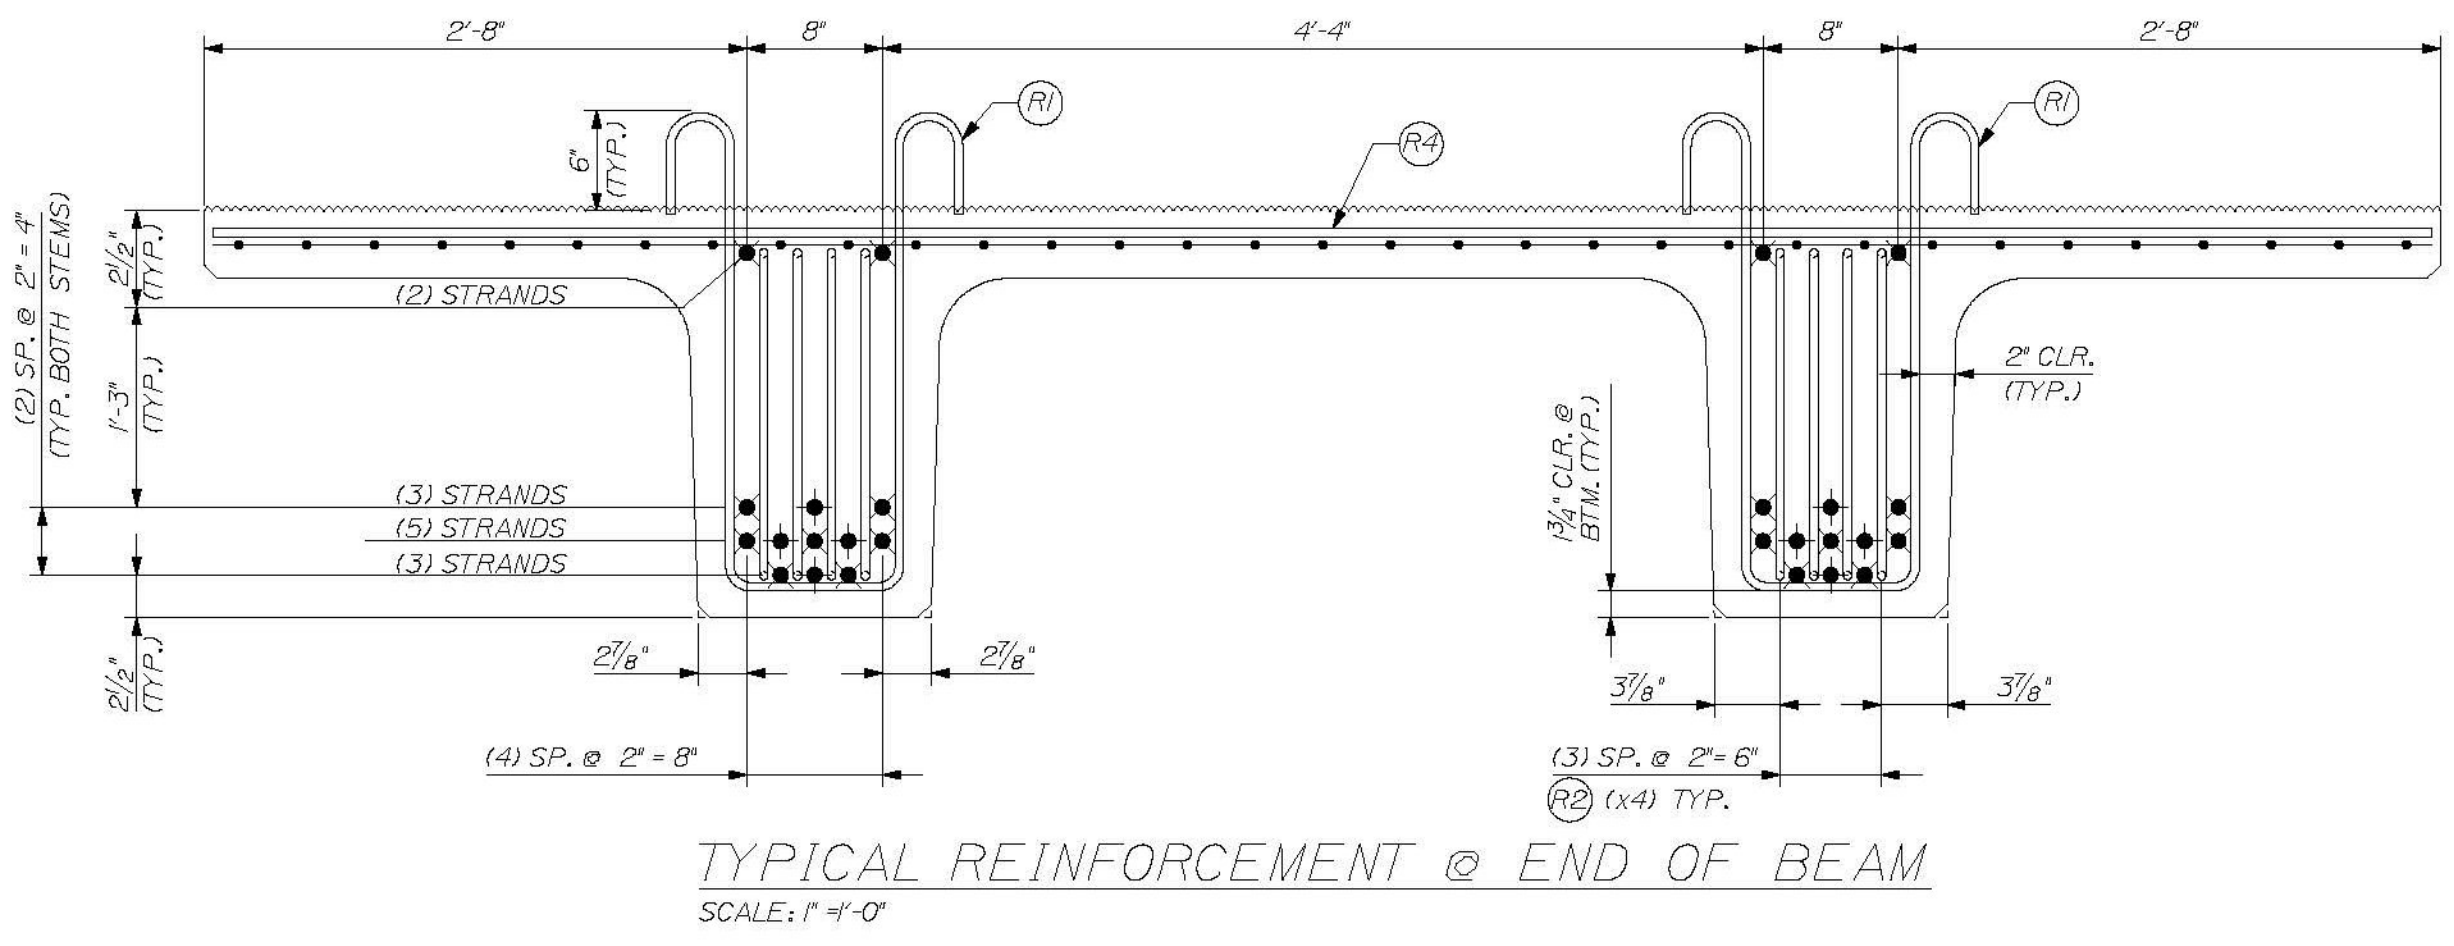

TYPICAL REINFORCEMENT @ END OF BEAM
 SCALE: 1" = 1'-0"

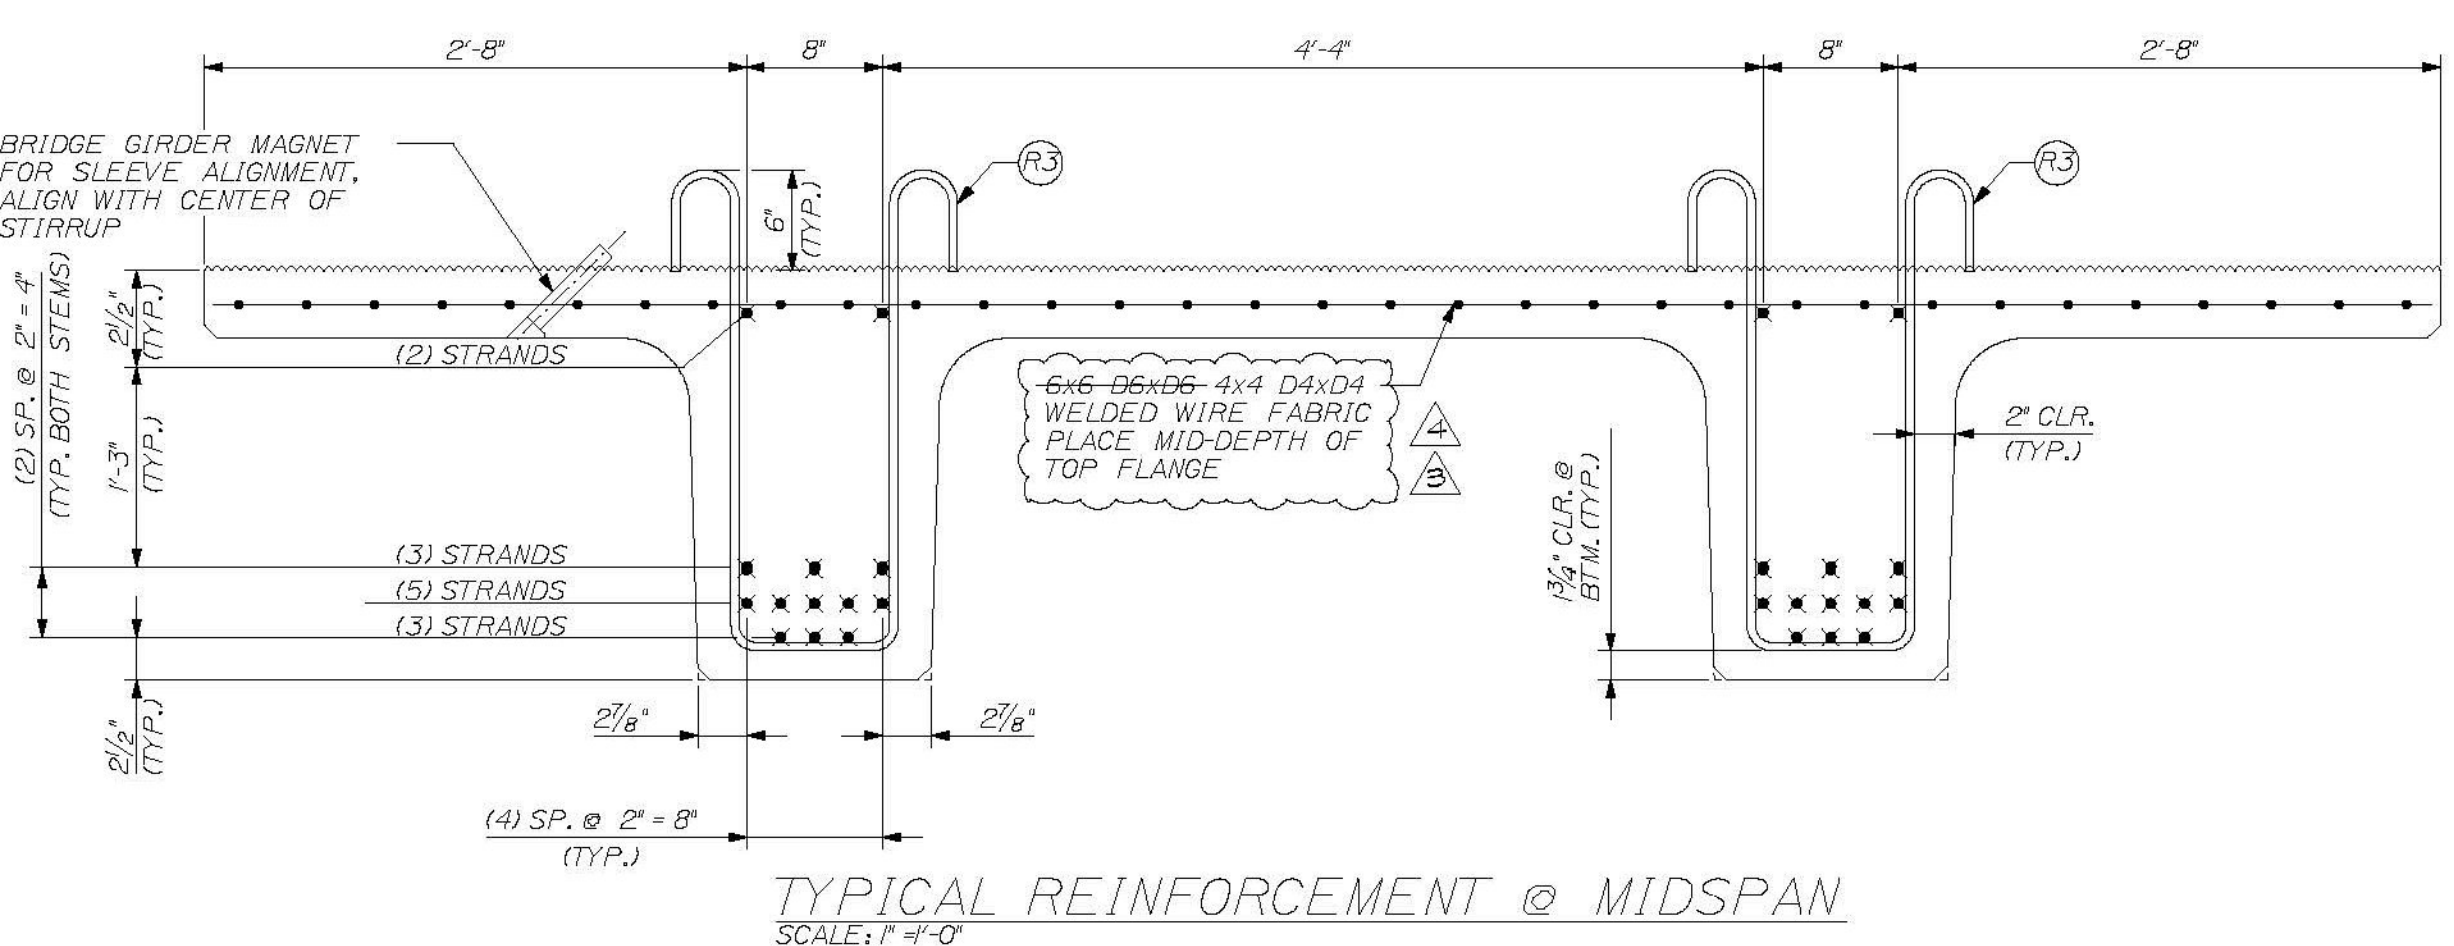


TYPICAL REINFORCEMENT @ MIDSPAN
 SCALE: 1" = 1'-0"

| STRAND LEGEND | |
|---------------|---|
| ● | 0.6" FULLY TENSIONED STRAND |
| ○ | 0.6" FULLY TENSIONED STRAND (DEBOUND 0.50 FEET) |
| ⊗ | 0.6" FULLY TENSIONED STRAND (DEBOUND 6 FEET) |
| ⊕ | 0.6" FULLY TENSIONED STRAND (DEBOUND 12 FEET) |


*EXTEND STRANDS 1, 4, 5, 9, 21 & 94 IN THE "LEFT" STEM AND STRANDS 2, 3, 6, 10, 22 & 23 IN THE "RIGHT" STEM BY A LENGTH OF 12" BEYOND THE END OF THE BEAM. BEND PER DETAILS NOTED ABOVE.

ALL OTHER STRANDS SHALL EXTEND 4" BEYOND THE END OF THE BEAM.

NOTES:
 BENT BAR LENGTHS SHOWN REPRESENT BAR LENGTHS BEFORE BENDING.
 TENSION LOAD = 43.94 KIPS/ STRAND
 STRAND: 16 #4, 270 KSI LOW RELAXATION, ASTM M203 REBAR; 4ASHTO WSI, GRADE 60, EPOXY COATED ALL TOLERANCES TO PCI STANDARDS
 (1) "A1-SB" NEXT BEAM BEAM REQUIRED
 SEE SHEET #3 FOR GEOMETRIC DETAILS
 SEE SHEET #2 FOR BENT REBAR DETAILS

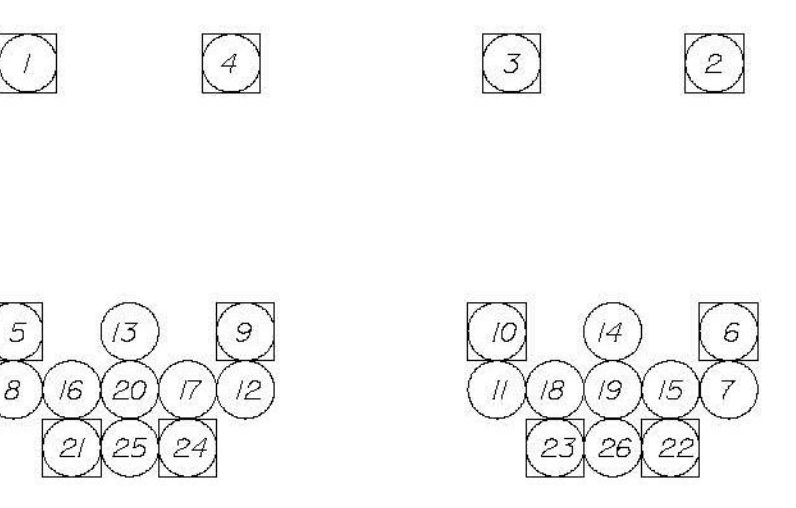

DE-TENSION SEQUENCE
 N.T.S.

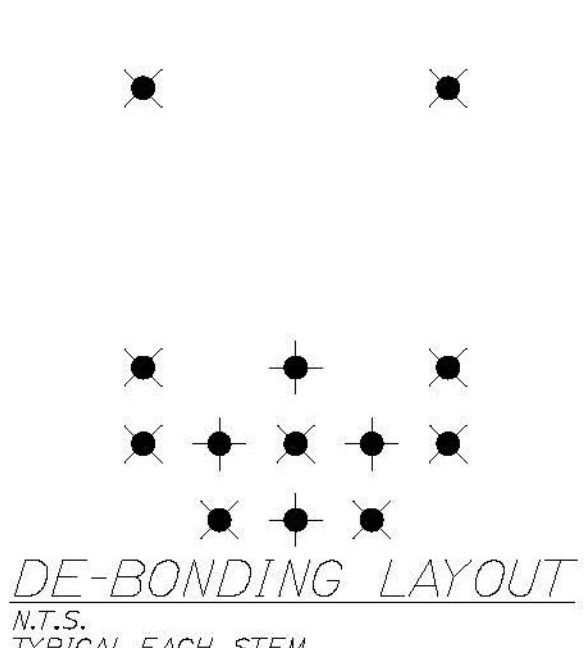

DE-BONDING LAYOUT
 N.T.S.
 TYPICAL EACH STEM

| REINFORCING CHART | | | | |
|-------------------|---------|---------|--------|------------------------------|
| ITEM | QTY. | TOTAL | SIZE | TYPE |
| R1 | 72 | 72 | 4 | BENT |
| R2 | 16 | 16 | 4 | BENT |
| R3 | 70 | 70 | 4 | BENT |
| R4 | 16 | 16 | 4 | STRT. |
| --- | 460 sf. | 460 sf. | 11'-3" | 4x4 D4x04 WELDED WIRE FABRIC |

| BAR SIZE | WT./BEAM | TOTAL WT. |
|----------|----------|-----------|
| 4 | 853 | 853 |
| WWF | 390 | 390 |

THE PROFESSIONAL ENGINEER'S STAMP WAS PREPARED UNDER THE DIRECT SUPERVISION OF A REGISTERED PROFESSIONAL ENGINEER AND COMPLY WITH THE DESIGN AND DETAILS SHOWN ON THE CONTRACT DRAWING UNLESS REQUESTED OTHERWISE.

CONTRACTOR: BECK & BELLUCCI, INC.
 PROJECT: BRATTLEBORO, VERMONT
 IM 019-1(60)

STATE OF VERMONT
 BRUCE C. DALEY
 NO. 87
 LICENSED PROFESSIONAL ENGINEER

W.E. DALEY, INC.
 PRECAST CONCRETE PRODUCTS
 1000 W. 14th St., Brattleboro, VT 05301
 TEL: 802/442-7178
 FAX: 802/442-7179
 DATE: MARCH 2011
 REVISIONS: 01: INITIAL SUBMISSION
 02: REVISION

I-91 BRATTLEBORO, VERMONT
 OVER MAPLE ST.
 BEAM TYPE "A1-SB"
 REINFORCEMENT DETAILS

SHEET NUMBER
 4