

WEB CUTTING DIAGRAM FOR 205G1B, 206G2B, 207G3B & 208G4B


MARK	BL	LE	RE	SPL	WC1	C1	C2	C3	C4	C5	C6	C7	C8	C9
205G5B	89'-11 3/4	3/4	11/16	2 1/8	3/8	19/16	1/16	1/8	2 1/8	2 3/16	2 1/16	1 3/4	1 5/16	3/4
206G6B	89'-11 3/4	3/4	11/16	2 1/8	3/8	3/4	1/16	1 13/16	2 1/16	2 3/16	2 1/16	1 13/16	1 3/8	3/4
207G7B	89'-11 7/8	3/4	9/16	2 1/16	5/16	3/4	1 3/8	1 3/4	2	2 1/16	2	1 11/16	1 5/8	11/16
208G8B	89'-11 7/8	11/16	5/8	2	5/16	3/4	1 5/16	1 11/16	1 5/8	2	1 5/8	1 5/8	1 1/4	11/16

T-Y-LININTERNATIONAL

No Exception Taken
 Make Correction as Noted
 Submit Specified Item
 Revise and Resubmit as Noted
 Rejected

Checking is for general compliance with the design concept of the project and general compliance with the information given in the contract documents only. Any action shown is not an approval and is subject to the requirements of the plans and specifications. Any action shown on a specific item shall not indicate the checking of an assembly of which the item is a component. Contractor is solely responsible for: dimensions which shall be confirmed and correlated at the job site, fabrication processes, techniques of construction, safety precautions, and coordination of its work with that of all other trades and the satisfactory performance of its work.

Reviewed By: *Jed CL* Date: **11/28/11**

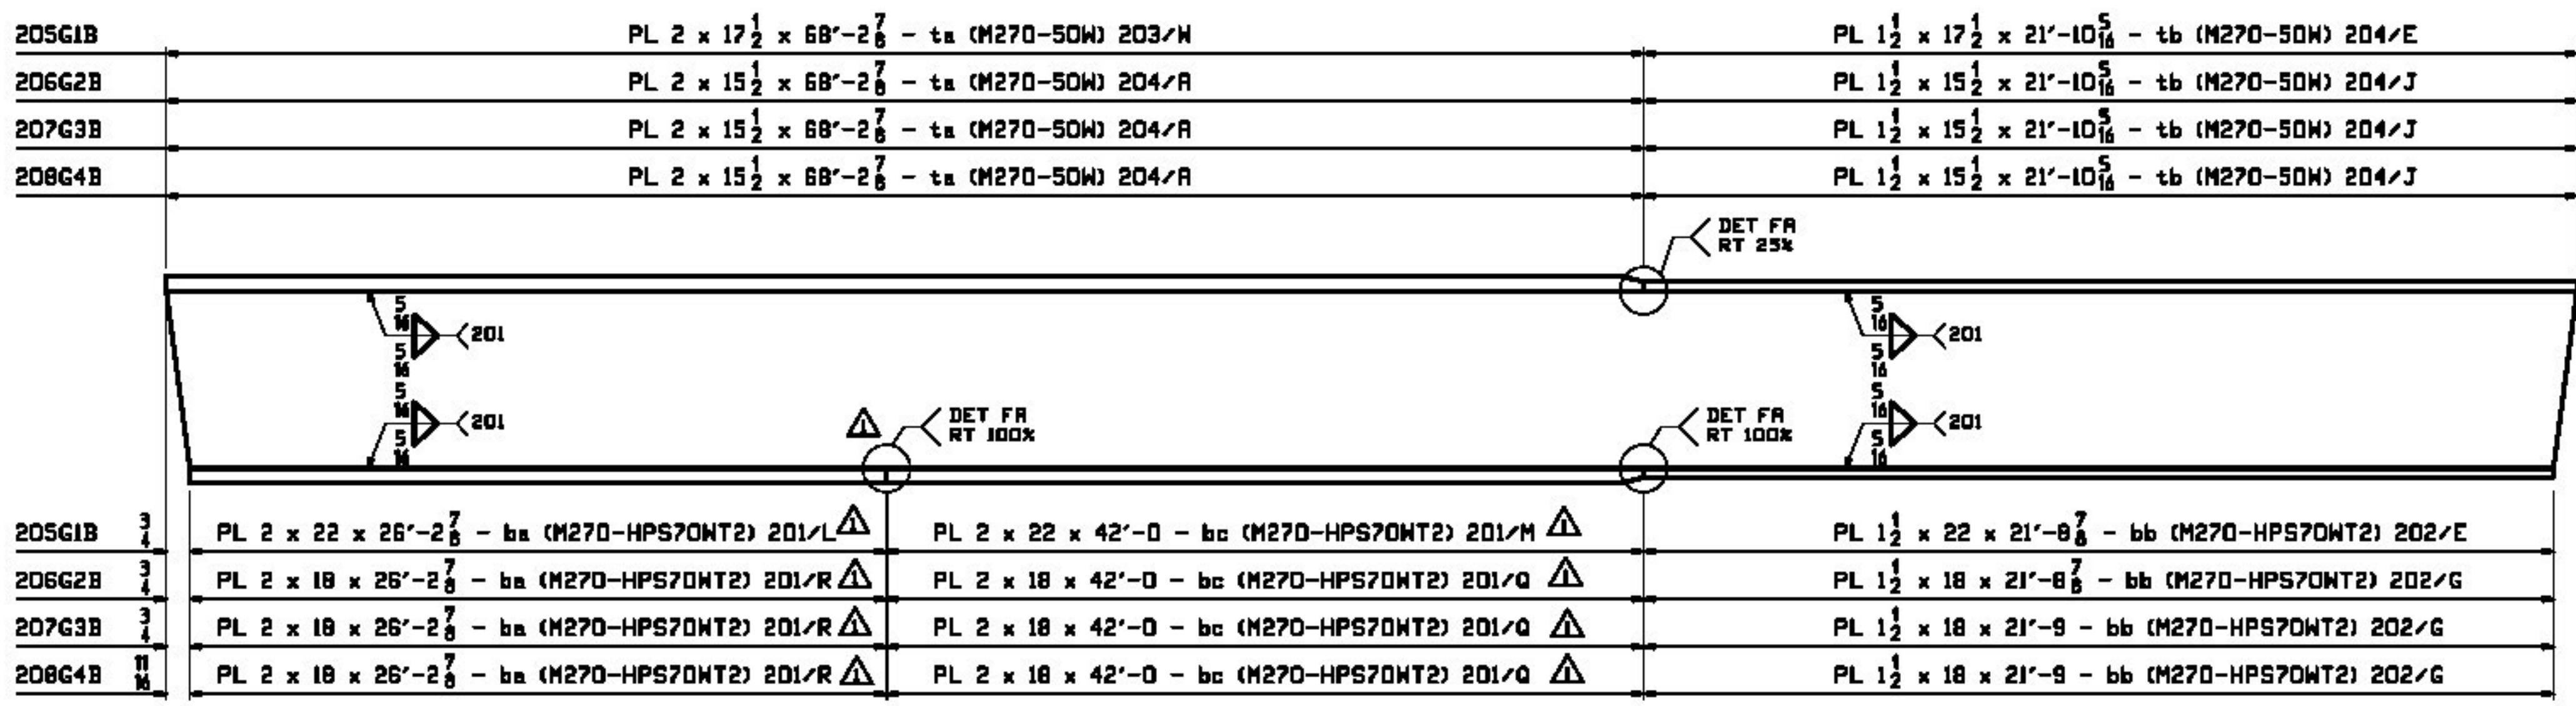

FLANGE DIAGRAM FOR 205G1B, 206G2B, 207G3B & 208G4B

FOR GENERAL NOTES SEE SHEET GNI
SEE DRAWING GNI FOR WELD DETAILS 'FA' & 'MB'.

REV.	DATE	REMARKS	DMN	CHK	APVL	SHOP
1	11/17/11	ADD SPLICE TO BOTTOM FLG G1B-G4B	KC	HL		
MATERIAL: M270-50W (UN) SURFACE PREP. & PAINT: SEE GNI HOLES: AS NOTED SHOP BOLTS: AS NOTED						
DESCRIPTION: CAMBER AND FLANGE DIAGRAMS						
CASCO BAY STEEL STRUCTURES, INC. 1 WALLACE AVE. SOUTH PORTLAND, ME 04106 PHONE (207) 780-6722 FAX (207) 780-6726						
STRUCTURE: I-91 BRIDGE 6S OVER WHITESTONE BROOK & WILLIAMS STREET COUNTY OF MINDHAM				DRAWN: HL DATE: 06/25		
LOCATION: Town of Brattleboro, VT.				CHECKED: JTB DATE: 07/08		
PROJ NO. IM 091-1(SD)				JOB NO. 479 DWG NO. C202		
CUSTOMER: BECK & BELLUCCI				REV. 1		