

BRIDGE 6N SPAN 2
 BRIDGE DECK FORM PLAN
 INTERSTATE 91 BRIDGE 6N

T-Y-LIN INTERNATIONAL

No Exception Taken
 Make Correction as Noted
 Submit Specified Item
 Revise and Resubmit as Noted
 Rejected

Checking is for general compliance with the design concept of the project and general compliance with the information given in the contract documents only. Any action shown is not an approval and is subject to the requirements of the plans and specifications. Any action shown on a specific item shall not indicate the checking of an assembly of which the item is a component. Contractor is solely responsible for: dimensions which shall be confirmed and corrected at the job site, fabrication processes, techniques of construction, safety precautions, and coordination of its work with that of all other trades and the satisfactory performance of its work.


Reviewed By: *[Signature]* Date: **08/31/11**

FILL IN REVISION BLOCK FOR LAST ROUND OF COMMENTS

REVISION LOG		
NO.	DATE	DESCRIPTION


CUSTOMER:
EDM CONSTRUCTION CO

PROJECT:
VERMONT DEPT. OF TRANSPORTATION
BRATTLEBORO, VT
PROJECT NO. IM 091-1(50)
BRIDGE 6N

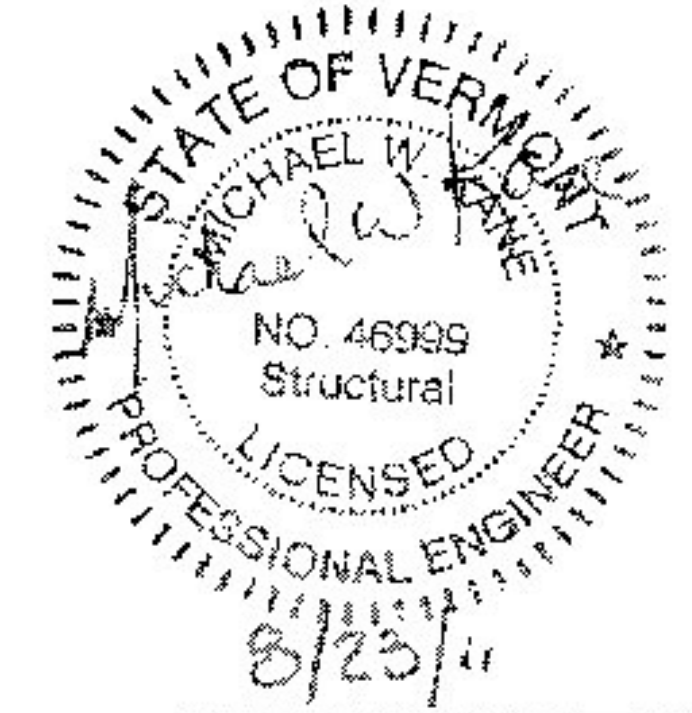

CLEARSPAN CONSTRUCTION PRODUCTS
 P.O. BOX 12708 PITTSBURGH, PA. 15241
 PHONE: (412)-445-2765
 FAX: (412)-341-2846

DRAWING NO. **A2 0**

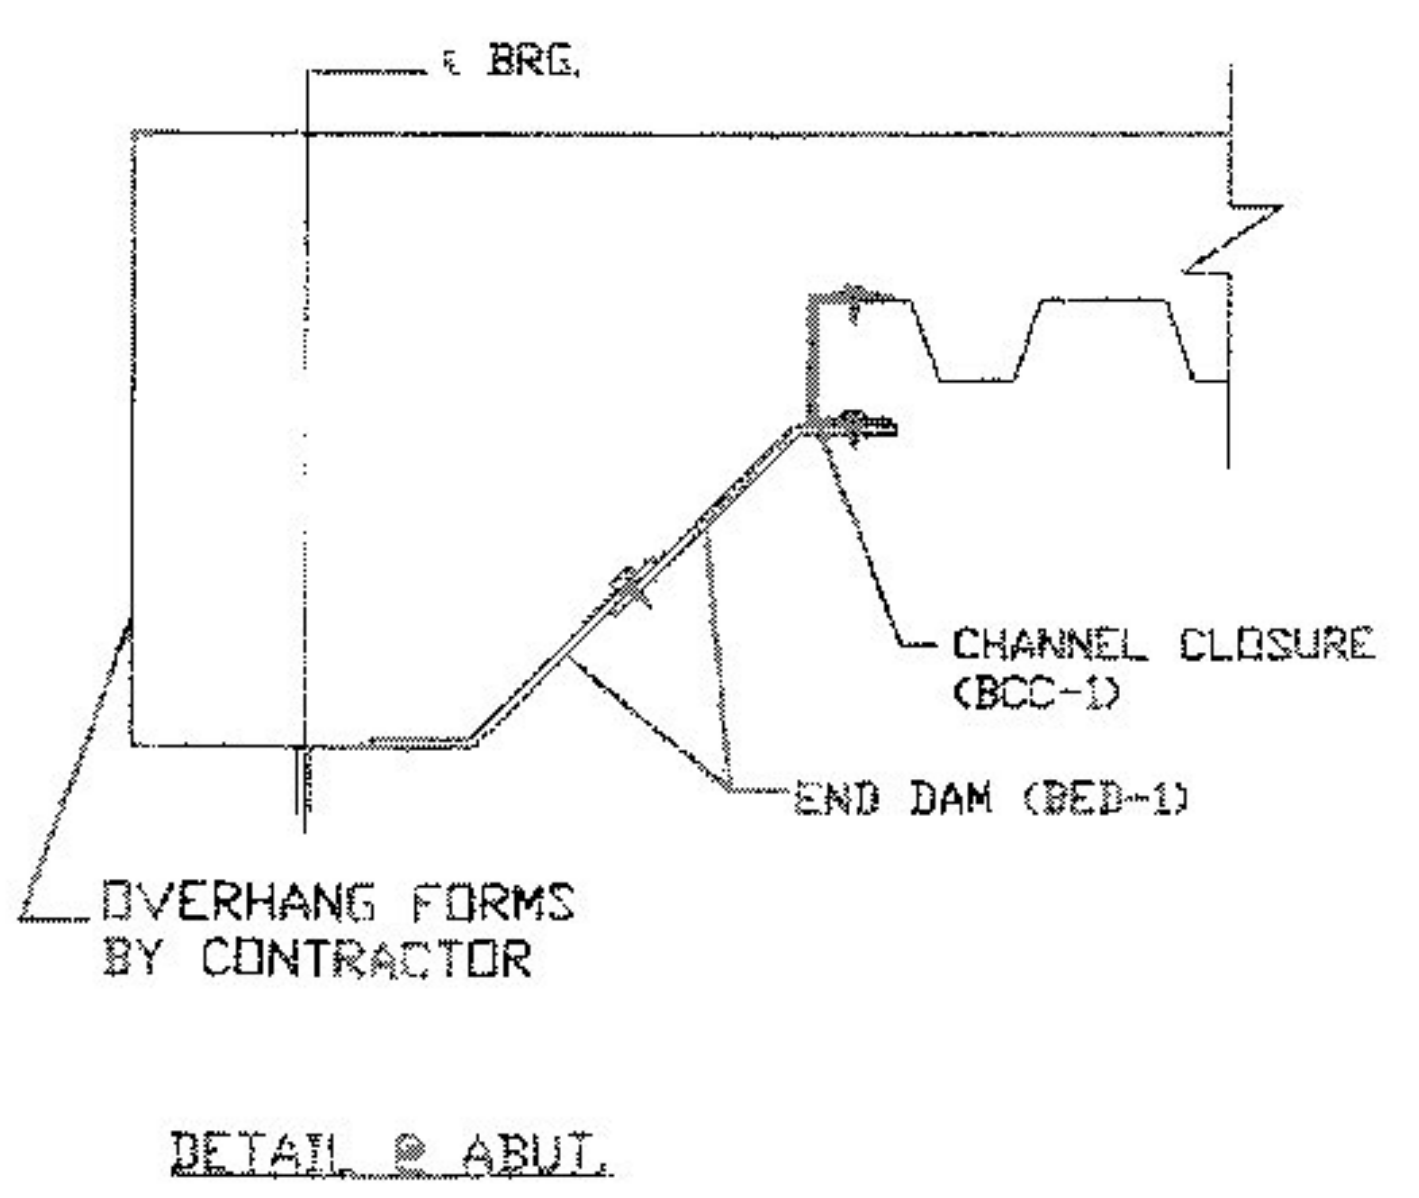

EACH SHEET MUST BE FASTENED TO SUPPORTS IMMEDIATELY UPON PLACEMENT TO AVOID HAZARD THAT COULD RESULT FROM HORIZONTAL MOVEMENT OR SUDDEN UPLIFT

DRAWN	DATE	CHECKED	DATE	APPROVAL DATE
HW	8/31/2011	GAB	9/28/11	10/2/2011/SSCK