
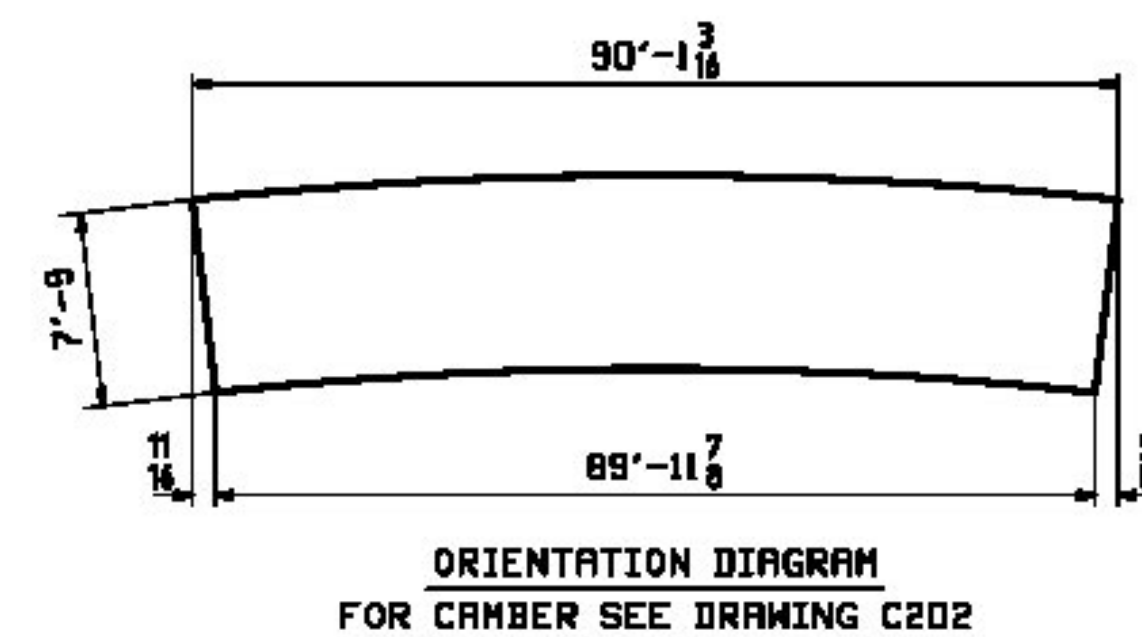


ONE - GIRDER - 208G4B

FOR FIELD SPLICE STANDARD DETAILS SEE DRAWINGS X201 & X202.
 FOR GIRDER STANDARD DETAILS SEE DRAWING X205.
 FOR CAMBER & FLANGE DIAGRAMS SEE DRAWING C202.
 FOR GENERAL NOTES SEE DRAWING GNI.
 T2 DENOTES MATERIAL SUBJECT TO CHARPY V-NOTCH TESTING.

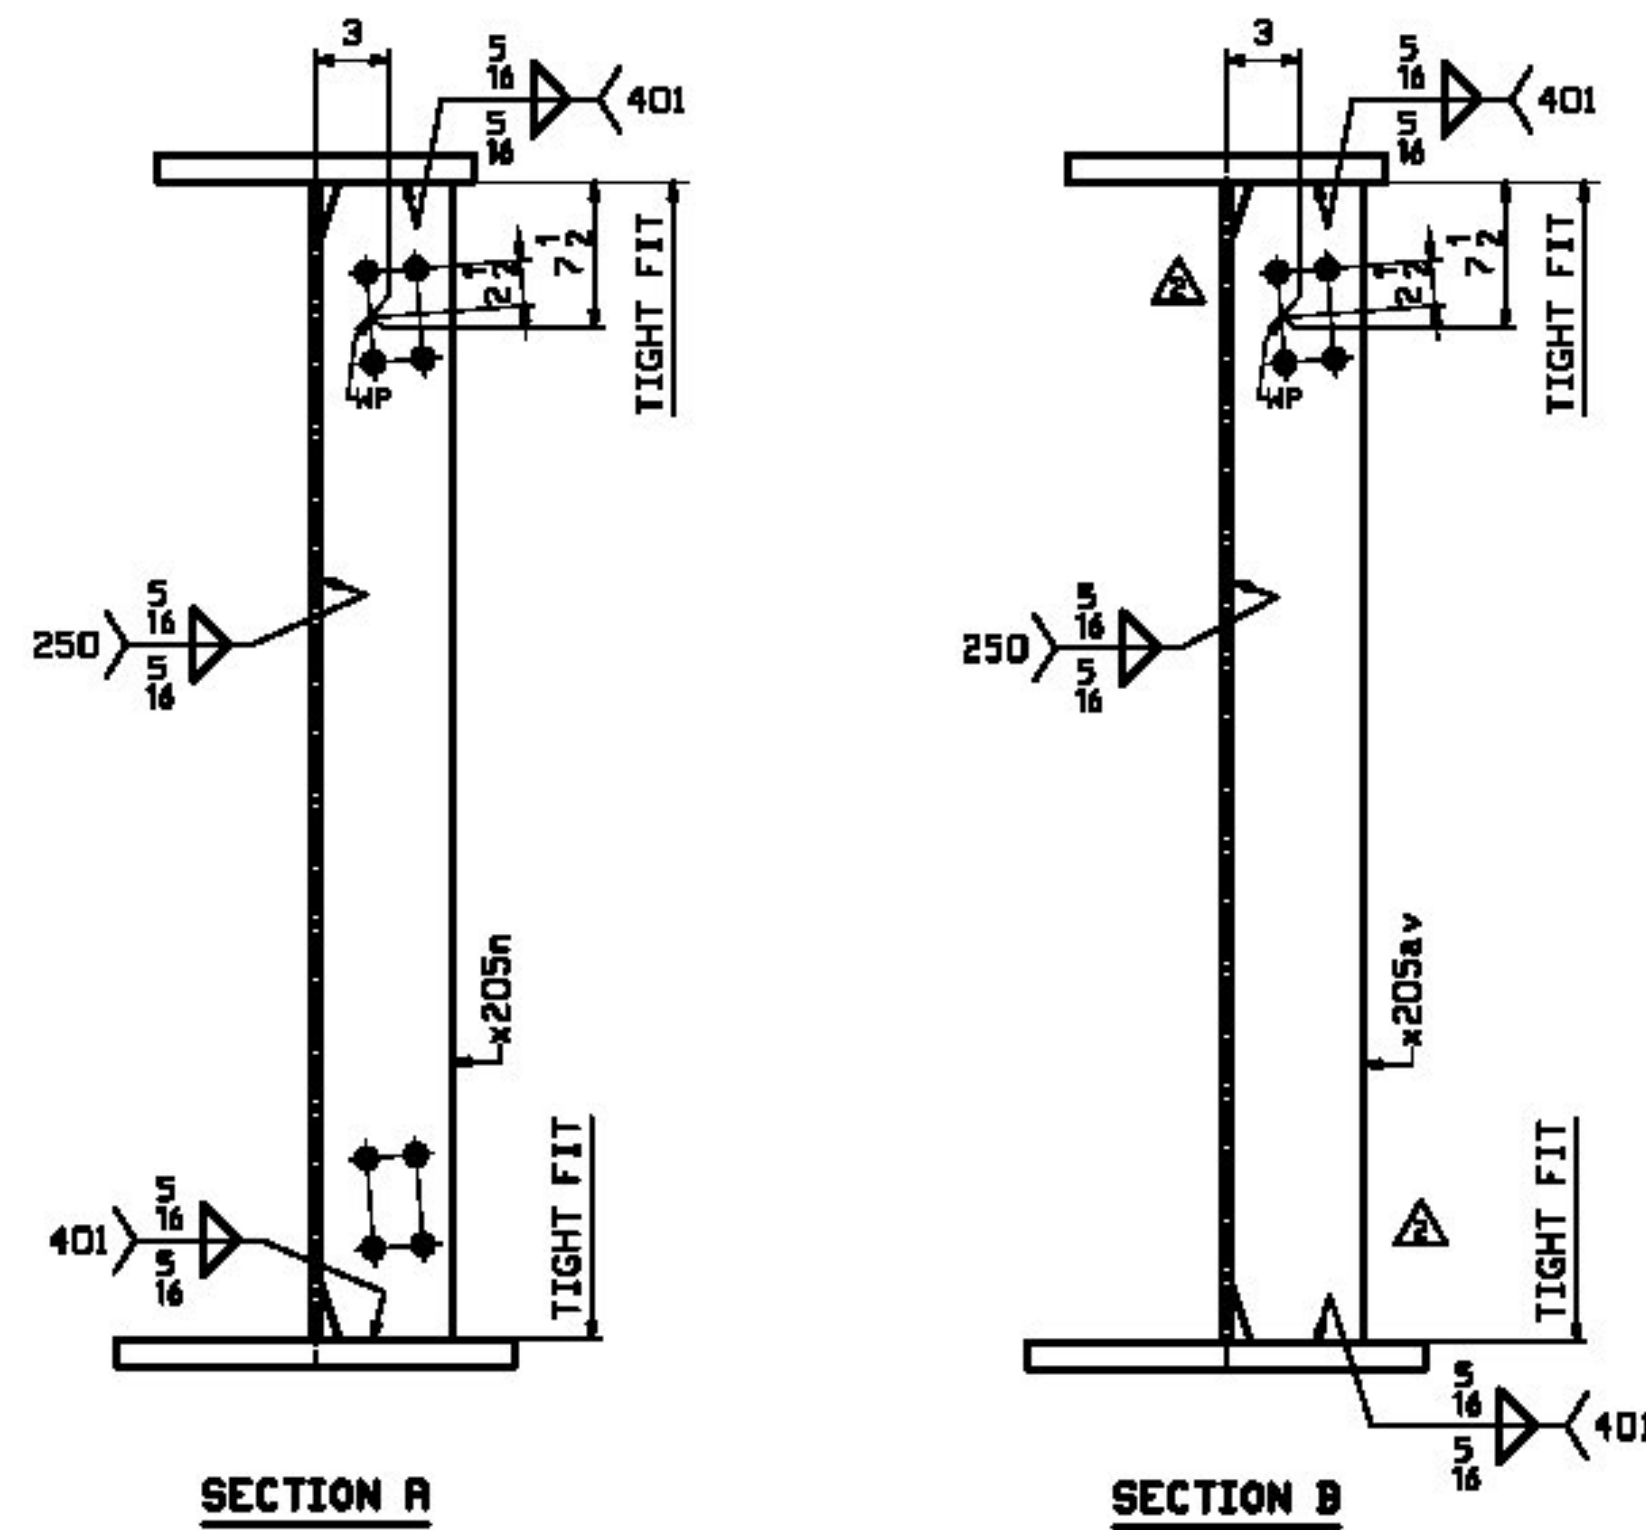

BILL OF MATERIAL					JOB NO.	DRAWING NO.	REV.	
					479	208	A	
ROW INFO	SHOP	MARK	QTY	MATERIAL	LENGTH	REMARKS	MT	PROCUREMENT NOTES
LINE					FT			
	208G4B	1		GIRDER			3825	
203	L	1	wa	PL 5/8x93	47 5/8	M270-SOWT2		
203	Q	1	wb	PL 5/8x93	42 2/8	M270-SOWT2		
204	A	1	tw	PL 2x15 1/2	68 2/8	M270-SOW		
204	J	1	tb	PL 1 1/2x15 1/2	21 10 5/8	M270-SOW		
201	R	1	ba	PL 2x18	26 2/8	M270-HPSOWT2		
201	Q	1	bc	PL 2x18	42 0	M270-HPSOWT2		
202	C	1	bb	PL 1 1/2x18	21 9	M270-HPSOWT2		
208	Q	6	x205av	PL 1 1/2x7 1/4	7 9	M270-SOW		
208	E	6	x205n	PL 1 1/2x7 1/4	7 9	M270-SOW		

T-Y-LIN INTERNATIONAL

No Exception Taken
 Make Correction as Noted
 Submit Specified Item
 Revise and Resubmit as Noted
 Rejected

Checking is for general compliance with the design concept of the project and general compliance with the information given in the contract documents only. Any action shown is not an approval and is subject to the requirements of the plans and specifications. Any action shown on a specific item shall not indicate the checking of an assembly of which the item is a component. Contractor is solely responsible for dimensions which shall be confirmed and correlated at the job site, fabrication processes, techniques of construction, safety precautions, and coordination of its work with that of all other trades and the satisfactory performance of its work.

Reviewed By: *[Signature]* Date: May 29, 2012

REV. DATE	REMARKS	DMN	CHK	APVL	SHOP
07/17/11	ADD BTM FLG SPLICE, PL ba	KC	ML		
MATERIAL: M270-SOW (UN)		SURFACE PREP. & PAINT: SEE DWG GNI		HOLES: 15 1/8\"/>	
DESCRIPTION: GIRDER - 208G4B					
CASCO BAY STEEL STRUCTURES, INC. 1 WALLACE AVE. SOUTH PORTLAND, ME 04106 PHONE (207) 780-6722 FAX. (207) 780-6726					
STRUCTURE: I-91 BRIDGE 6S OVER WHITESTONE BROOK & WILLIAMS STREET COUNTY OF MINDHAM			DRAWN: JTB DATE: 07/11 CHKD: TJB DATE: 07/23		
LOCATION: Town of Brattleboro, VT.			JOB NO. 479		
PROJ NO. IM 091-1(SD)			DWG NO. 208		
CUSTOMER: BECK & BELLUCCI			REV. A		