


JOB NO.		DRAWING NO.		REV.					
479		211		△					
ROW INFO	SHOP	MARK	QTY	MARK	MATERIAL	LENGTH FT	REMARKS	MT	PROCUREMENT NOTES
	211G3C	1			GIRDER			41415	
203	M	1	wa		PL 5/8 x 93	68	10 5/8		M270-SOWT2
202	L	1	wb		PL 3/4 x 93	10	3 3/8		M270-HPSOWT2
202	Q	1	tw		PL 1/2 x 25 1/2	54	3		M270-SOWT2
201	G	1	tb		PL 2 x 25 1/2	25	9 7/8		M270-HPSOWT2
201	M	1	tw		PL 1/2 x 25 1/2	38	3 1/2		M270-HPSOWT2
201	R	1	bb		PL 2 x 25 1/2	42	0 7/8		M270-HPSOWT2
208	E	6	x205a		PL 1/2 x 7	7	9		M270-SOW
208	Q	4	x205af		PL 2 x 7 1/4	7	9		M270-SOW
208	E	6	x205n		PL 1/2 x 7	7	9		M270-SOW

No Exception Taken  
 Make Correction as Noted  
 Submit Specified Item  
 Revise and Resubmit as Noted  
 Rejected

T-Y-LININTERNATIONAL  
 Checked by: *Jed* Date: May 29, 2012

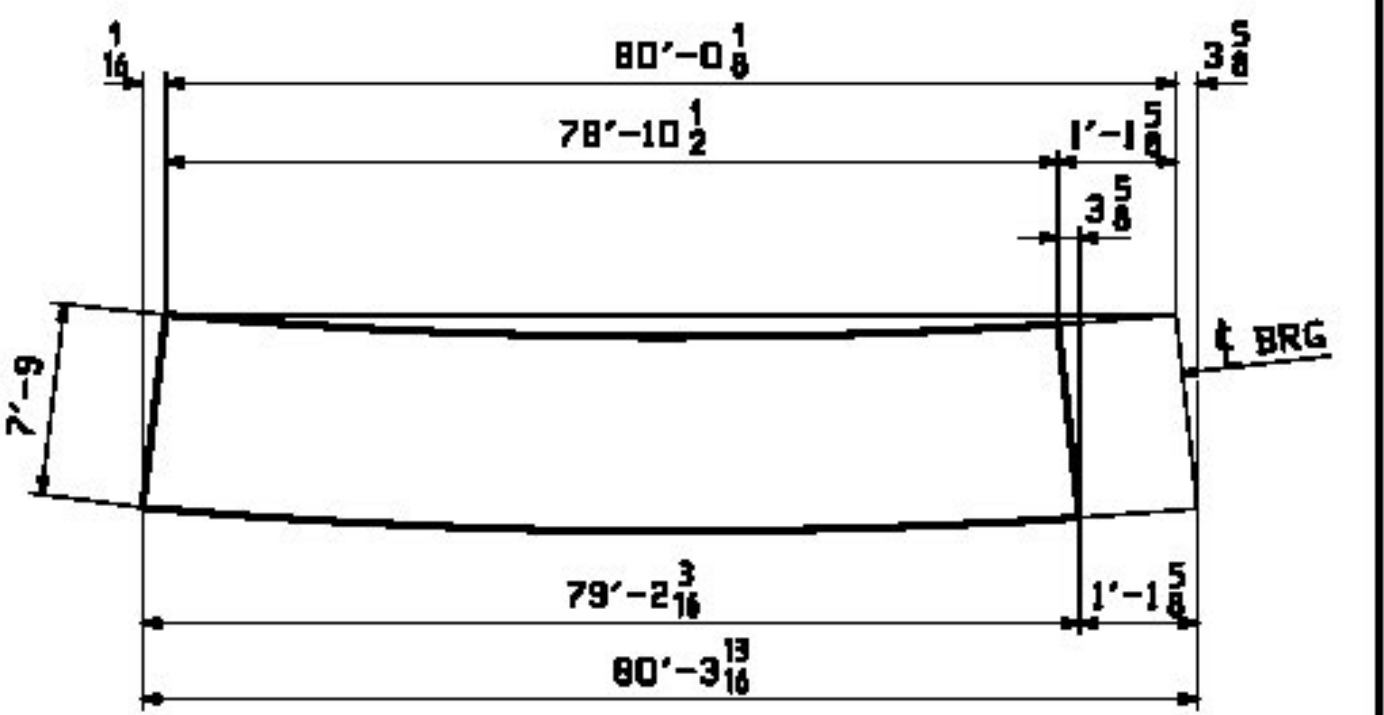

**ONE - GIRDER - 211G3C**  
 FOR FIELD SPLICE STANDARD DETAILS SEE DRAWINGS X202 & X206.  
 FOR GIRDER STANDARD DETAILS SEE DRAWING X205.  
 FOR CAMBER & FLANGE DIAGRAMS SEE DRAWING C203.  
 FOR GENERAL NOTES SEE DRAWING GNI.  
 T2 DENOTES MATERIAL SUBJECT TO CHARPY V-NOTCH TESTING.

NOTE "W"  
 SEE DETAIL "G4C" ON DRAWING C203 FOR  
 WEB TO FLANGE WELD SIZE TRANSITION LOCATIONS.

REV.	DATE	REMARKS	DMN	CHK	APVL	SHOP
5/10		REV. UTILITY STIFF'S SECTION B)	JTB	TJB		
5/12		(EXTRA TPC-303400)	JTB	TJB		
7/29		APPROVE CORRECT: ADD NOTE "W" AND 1/2" WEB TO FLG WELD	JTB	TJB		
0						

MATERIAL: M270-SOW (UN) SURFACE PREP. & PAINT: HOLES: 15/16" φ SHOP BOLTS: NONE  
 DESCRIPTION: GIRDER - 211G3C

**CASCO BAY STEEL STRUCTURES, INC.**  
 1 WALLACE AVE. PHONE (207) 780-6722  
 SOUTH PORTLAND, ME 04106 FAX. (207) 780-6726

STRUCTURE: I-91 BRIDGE 6S OVER WHITESTONE BROOK & WILLIAMS STREET COUNTY OF MINDHAM  
 DRAWN: JTB DATE: 07/11  
 CHECKED: TJB DATE: 07/23

LOCATION: Town of Brattleboro, VT. JOB NO. 479 DWG NO. 211  
 PROJ NO. IM 091-1(SD) CUSTOMER: BECK & BELLUCCI REV. △