


JOB NO.		DRAWING NO.		REV.
479		215		▲
ITEM NO.	QTY	UNIT	DESCRIPTION	REMARKS
215G3D	1		GIRDER	
202	1	lb	PL 1/2 x 93	
203	1	lb	PL 5/8 x 93	
201	1	lb	PL 2 x 25 1/2	
202	1	lb	PL 1 1/2 x 25 1/2	
201	1	lb	PL 2 x 25 1/2	
202	1	lb	PL 1 1/2 x 25 1/2	
208	5		x205a PL 1/2 x 7 1/2	
208	2		x205af PL 1/2 x 7 1/2	
208	5		x205n PL 1/2 x 7 1/2	

**T-Y-UNINTERNATIONAL**

No Exception Taken  
 Make Correction as Noted  
 Submit Specified Item  
 Revise and Resubmit as Noted  
 Rejected

Checking is for general compliance with the design concept of the project and general compliance with the information given in the contract documents only. Any action shown is not an approval and is subject to the requirements of the plans and specifications. Any action shown on a specific item shall not indicate the checking of an assembly which the item is a component. Contractor is solely responsible for dimensions which shall be confirmed and corrected at the job site, fabrication processes, techniques of construction, safety precautions, and coordination of its work with that of all other trades and the satisfactory performance of its work.

Reviewed By: *[Signature]* Date: May 29, 2012

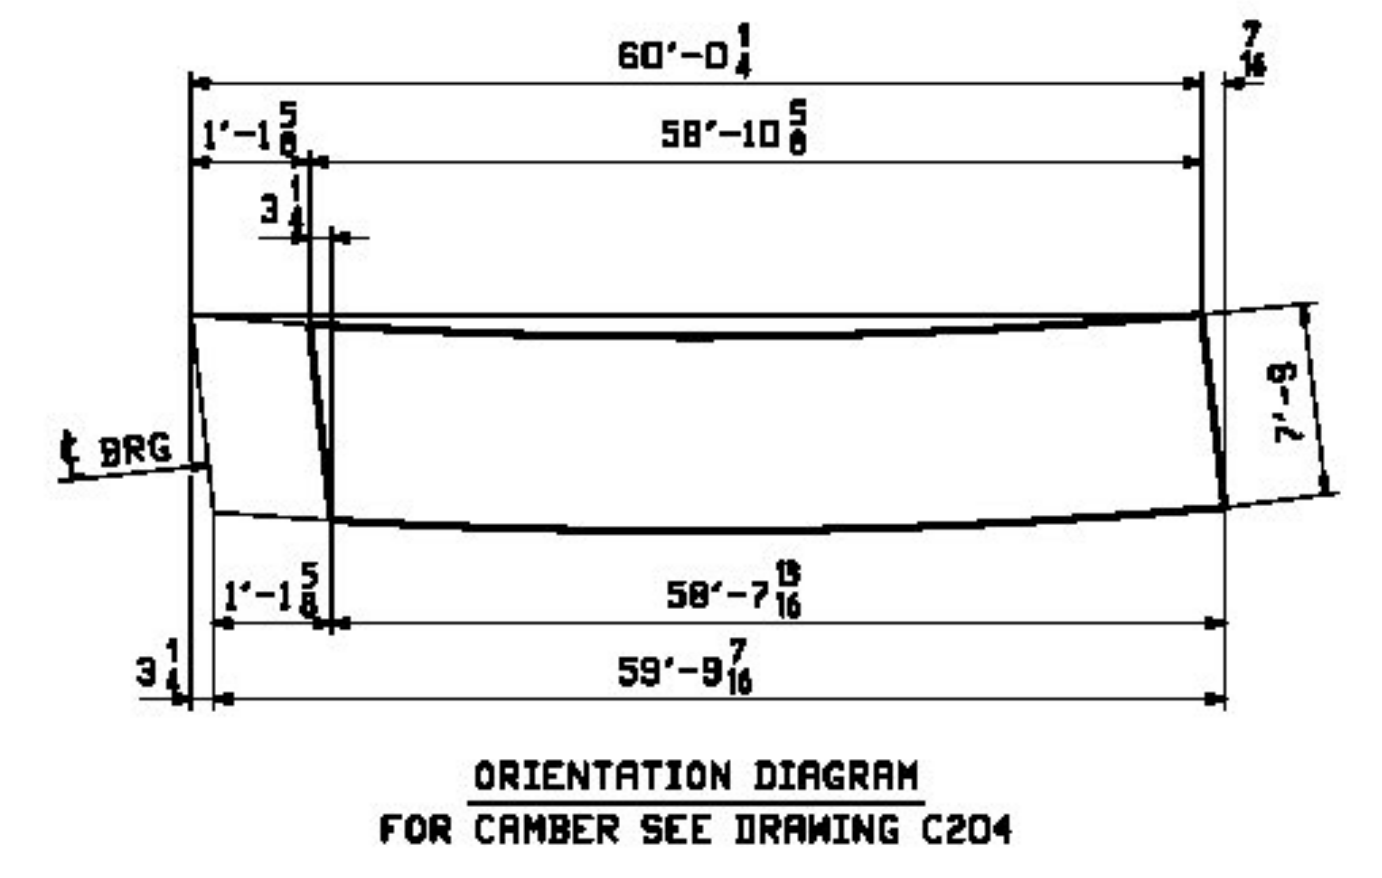

REV. DATE	REMARKS	DMN	CHK	APVL	SHOP
7/29	APPROVE CORRECTION: ADD NOTE "M" AND 1/2" WEB TO FLG WELD	JTB	TJB		
MATERIAL: M270-S0W (UN)		SURFACE PREP. & PAINT:		HOLES: 15/16" φ	
DESCRIPTION: GIRDER - 215G3D		SHOP BOLTS: NONE			
CASCO BAY STEEL STRUCTURES, INC.					
1 WALLACE AVE. SOUTH PORTLAND, ME 04106		PHONE (207) 780-6722 FAX. (207) 780-6726			
STRUCTURE: I-91 BRIDGE 6S OVER WHITESTONE BROOK & WILLIAMS STREET COUNTY OF MINDHAM		DRAWN: JTB		DATE: 07/11	
		CHKD: TJB		DATE: 07/23	
LOCATION: Town of Brattleboro, VT.		JOB NO. 479		DWG NO. 215	
PROJ NO. IM 091-1(SD)		CUSTOMER: BECK & BELLUCCI		REV. ▲	