


INT. CROSSFRAMES - MARK "A"
LOOKING UP STATION

| MARK "A" | QTY | DROP | (A) | (B) | (C) | (D) | (E) | (F) | (G) | (H) | (I) |
|----------|-----|-----------------------------------|--------------------------------------|--------------------------------------|----------------------------------|--------------------------------------|-------------------------------------|----------------------------------|-----------------------------------|-------|------|
| 224CF1 | 14 | 10' ¹¹ / ₁₆ | 11'-3" | 10'-9" | 2 | 11'-0' ¹¹ / ₁₆ | 10'-9' ⁷ / ₁₆ | 1 | N.A. | a224 | a224 |
| 224CF1U | 7 | 10' ¹¹ / ₁₆ | 11'-3" | 10'-9" | 2 | 11'-0' ¹¹ / ₁₆ | 10'-9' ⁷ / ₁₆ | 1 | 5'-4' ¹ / ₂ | aa224 | a224 |
| 224CF2 | 14 | 10' ¹ / ₂ | 11'-3" | 10'-9" | 2 | 11'-0' ¹¹ / ₁₆ | 10'-9' ⁷ / ₁₆ | 1 | N.A. | a224 | a224 |
| 224CF2U | 7 | 10' ¹ / ₂ | 11'-3" | 10'-9" | 2 | 11'-0' ¹¹ / ₁₆ | 10'-9' ⁷ / ₁₆ | 1 | 5'-4' ¹ / ₂ | aa224 | a224 |
| 224CF3 | 10 | 10' ³ / ₈ | 11'-2' ¹¹ / ₁₆ | 10'-8' ¹¹ / ₁₆ | 1' ¹¹ / ₁₆ | 11'-0' ³ / ₈ | 10'-9' ¹ / ₈ | 1' ¹¹ / ₁₆ | N.A. | b224 | b224 |
| 224CF3U | 5 | 10' ³ / ₈ | 11'-2' ¹¹ / ₁₆ | 10'-8' ¹¹ / ₁₆ | 1' ¹¹ / ₁₆ | 11'-0' ³ / ₈ | 10'-9' ¹ / ₈ | 1' ¹¹ / ₁₆ | 5'-4' ³ / ₈ | bb224 | b224 |

| JOB NO. | | DRAWING NO. | | REV. | | | | |
|----------|---------|-------------|-------|------------------------------------|-------------------------------------|----------|------|----------------------|
| 478 | | 224 | | A | | | | |
| ROW INFO | MARK | QTY | MARK | MATERIAL | LENGTH FT INCHES | REMARKS | WT | PROCUREMENT NOTES |
| 209 R | 224CF1U | 7 | a224 | INT. CROSSFRAMES | | | 5296 | |
| 209 R | | 7 | a224 | WT 5x22.5 | 11 0' ¹¹ / ₁₆ | 1270-SOM | 1742 | |
| 209 R | | 7 | a224 | WT 5x22.5 | 11 0' ¹¹ / ₁₆ | 1270-SOM | 1742 | |
| 209 S | | 7 | a224 | L 5x5x ¹ / ₂ | 7 8' ¹ / ₂ | 1270-SOM | 872 | |
| 209 S | | 7 | a224 | L 5x5x ¹ / ₂ | 8 3' ³ / ₄ | 1270-SOM | 941 | |
| 209 R | 224CF2U | 7 | a224 | INT. CROSSFRAMES | | | 5296 | |
| 209 R | | 7 | a224 | WT 5x22.5 | 11 0' ¹¹ / ₁₆ | 1270-SOM | 1742 | |
| 209 R | | 7 | a224 | WT 5x22.5 | 11 0' ¹¹ / ₁₆ | 1270-SOM | 1742 | |
| 209 S | | 7 | a224 | L 5x5x ¹ / ₂ | 7 8' ¹ / ₂ | 1270-SOM | 872 | |
| 209 S | | 7 | a224 | L 5x5x ¹ / ₂ | 8 3' ³ / ₄ | 1270-SOM | 941 | |
| 209 R | 224CF3U | 5 | bb224 | INT. CROSSFRAMES | | | 3777 | |
| 209 R | | 5 | bb224 | WT 5x22.5 | 11 0' ³ / ₈ | 1270-SOM | 1241 | |
| 209 R | | 5 | b224 | WT 5x22.5 | 11 0' ³ / ₈ | 1270-SOM | 1241 | |
| 209 S | | 5 | b224 | L 5x5x ¹ / ₂ | 7 8' ¹ / ₂ | 1270-SOM | 823 | |
| 209 S | | 5 | a224 | L 5x5x ¹ / ₂ | 8 3' ³ / ₄ | 1270-SOM | 872 | |

| JOB NO. | | DRAWING NO. | | REV. | | | | |
|----------|--------|-------------|-------|------------------------------------|-------------------------------------|----------|-------|----------------------|
| 478 | | 224 | | A | | | | |
| ROW INFO | MARK | QTY | MARK | MATERIAL | LENGTH FT INCHES | REMARKS | WT | PROCUREMENT NOTES |
| 209 R | 224CF1 | 14 | a224 | INT. CROSSFRAMES | | | 10591 | |
| 209 R | | 14 | a224 | WT 5x22.5 | 11 0' ¹¹ / ₁₆ | 1270-SOM | 8568 | |
| 209 S | | 14 | a224 | L 5x5x ¹ / ₂ | 7 8' ¹ / ₂ | 1270-SOM | 1744 | |
| 209 S | | 14 | a224 | L 5x5x ¹ / ₂ | 8 3' ³ / ₄ | 1270-SOM | 1861 | |
| 209 R | 224CF2 | 14 | a224 | INT. CROSSFRAMES | | | 10591 | |
| 209 R | | 14 | a224 | WT 5x22.5 | 11 0' ¹¹ / ₁₆ | 1270-SOM | 8568 | |
| 209 S | | 14 | a224 | L 5x5x ¹ / ₂ | 7 8' ¹ / ₂ | 1270-SOM | 1744 | |
| 209 S | | 14 | a224 | L 5x5x ¹ / ₂ | 8 3' ³ / ₄ | 1270-SOM | 1861 | |
| 209 R | 224CF3 | 10 | bb224 | INT. CROSSFRAMES | | | 7554 | |
| 209 R | | 10 | bb224 | WT 5x22.5 | 11 0' ³ / ₈ | 1270-SOM | 4964 | |
| 209 S | | 10 | b224 | L 5x5x ¹ / ₂ | 7 8' ¹ / ₂ | 1270-SOM | 1245 | |
| 209 S | | 10 | a224 | L 5x5x ¹ / ₂ | 8 3' ³ / ₄ | 1270-SOM | 1344 | |

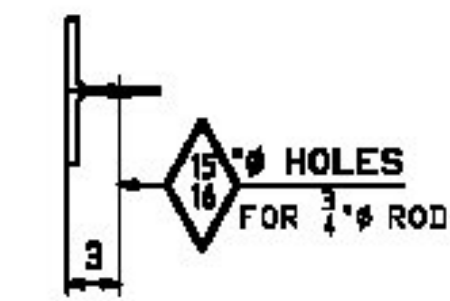

SECTION A
DIAGONALS NOT SHOWN
AT 224CF1U, 224CF2U & 2243U ONLY

T-Y-LININTERNATIONAL

- No Sweepstakes Taken
- Make Correction as Noted
- Submit Specified Item
- Revise and Resubmit as Noted
- Rejected

Checking is for general compliance with the design concept of the project and general compliance with the information given in the contract documents only. Any notices shown is not an approval and is subject to the requirements of the plans and specifications. Any action shown on a specific item shall not indicate the checking of an assembly of which the item is a component. Contractor is solely responsible for dimensions which shall be confirmed and correlated at the job site, fabrication processes, techniques of construction, safety precautions, and coordination of its work with that of all other trades and the satisfactory performance of its work.

Reviewed By: *[Signature]* Date: May 29, 2012

NOTE:
FOR GENERAL NOTES SEE DRAWING G01.

| | | | | | |
|---|--|----------------------|------------------------------------|------------------------|------|
| 8/19 | ADD HANGER HOLES / REVISE MARKS (EXTRA-TEC-308400) | JTB | TJB | | |
| 8/19 | REVISE VERTICAL HOLE TO HOLE DIM. | JTB | TJB | | |
| REV. DATE | REMARKS | DMN | CHK | APVL | SHOP |
| MATERIAL: | SURFACE PREP. & PAINT: | HOLES: | SHOP BOLTS: | | |
| M270-SOM | SEE DWG G01 | 15/16" φ | NONE | | |
| DESCRIPTION: INT. CROSSFRAMES | | | | | |
| CASCO BAY STEEL STRUCTURES, INC. | | | | | |
| 1 WALLACE AVE. | | PHONE (207) 780-6722 | | DRAWN: JTB DATE: 07/11 | |
| SOUTH PORTLAND, ME 04106 | | FAX: (207) 780-6726 | | CHKD: TJB DATE: 07/23 | |
| STRUCTURE: I-91 BRIDGE 6S OVER WHITESTONE BROOK & WILLIAMS STREET COUNTY OF MINDHAM | | | LOCATION: Town of Brattleboro, VT. | | |
| PROJ NO. IM 091-1(SD) | | | JOB NO. 479 | | |
| CUSTOMER: BECK & BELLUCCI | | | DWG NO. 224 | | |
| | | | REV. A | | |