




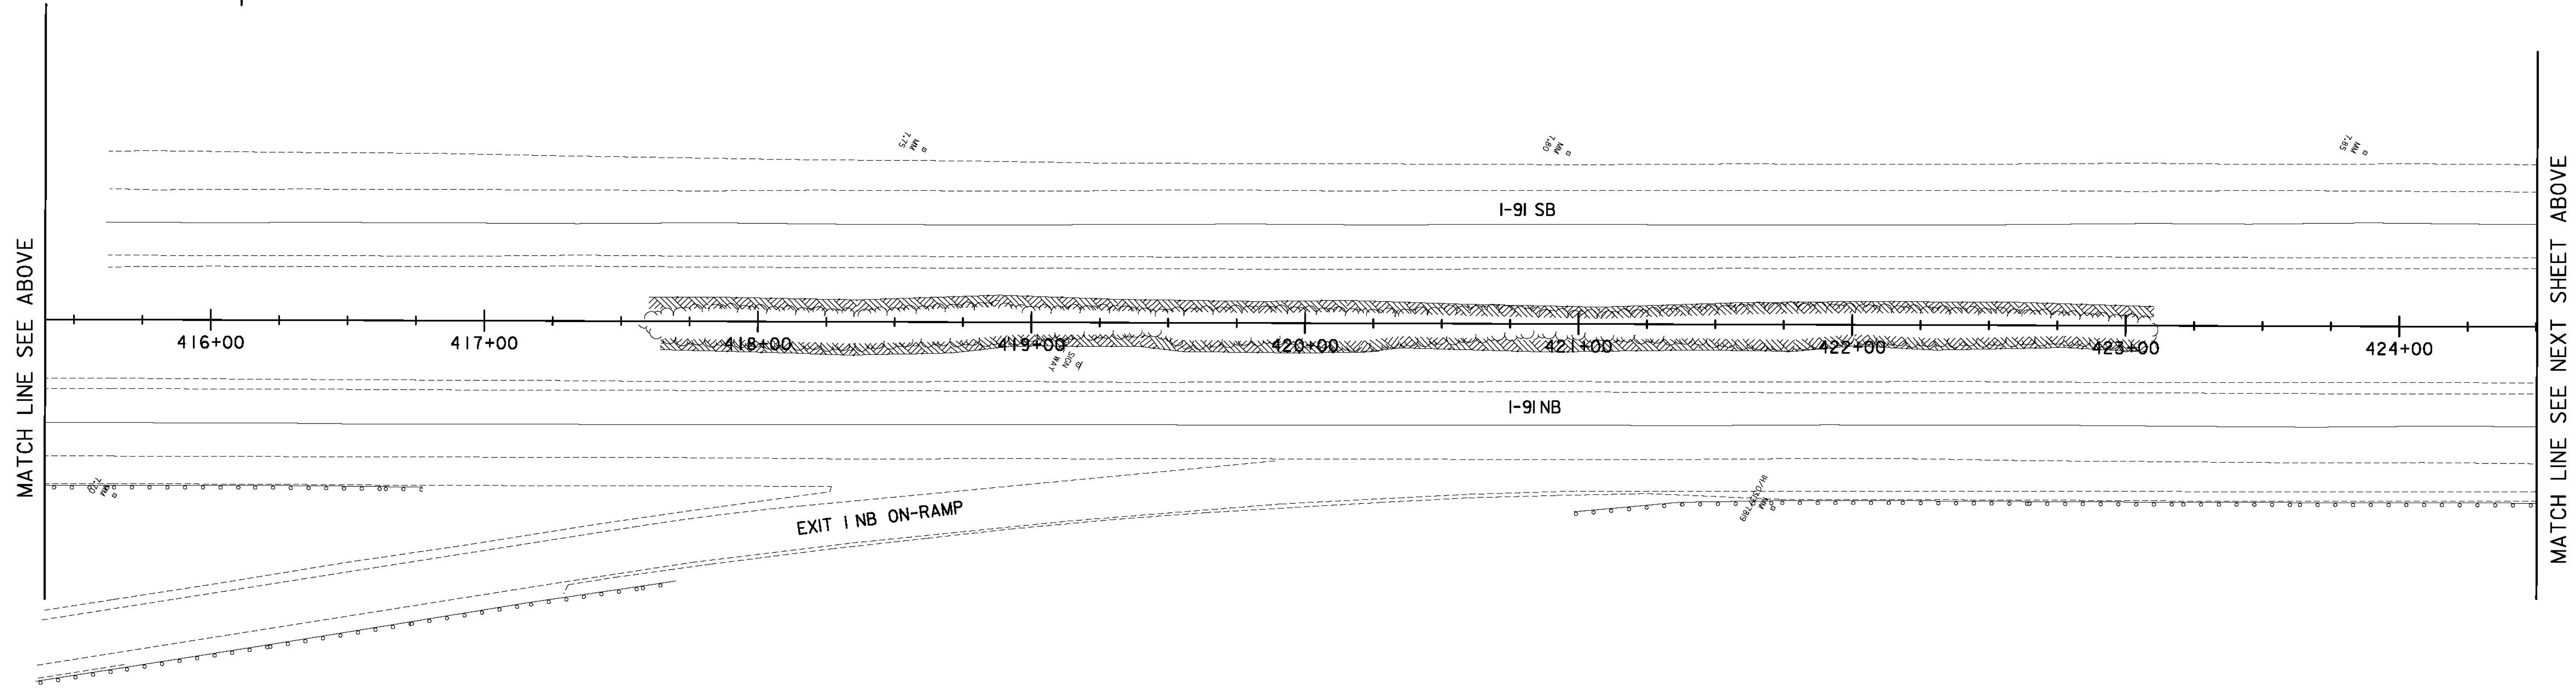

SERIES 30000  
 CURVE 1- BRIDGE 5  
 PI STA. 342+67.86  
 $\Delta = 9^\circ 24' 41.2''$   
 $D = 1^\circ 58' 28''$   
 $R = 2901.79'$   
 $T = 238.86'$   
 $L = 476.65'$   
 $E = 9.81'$

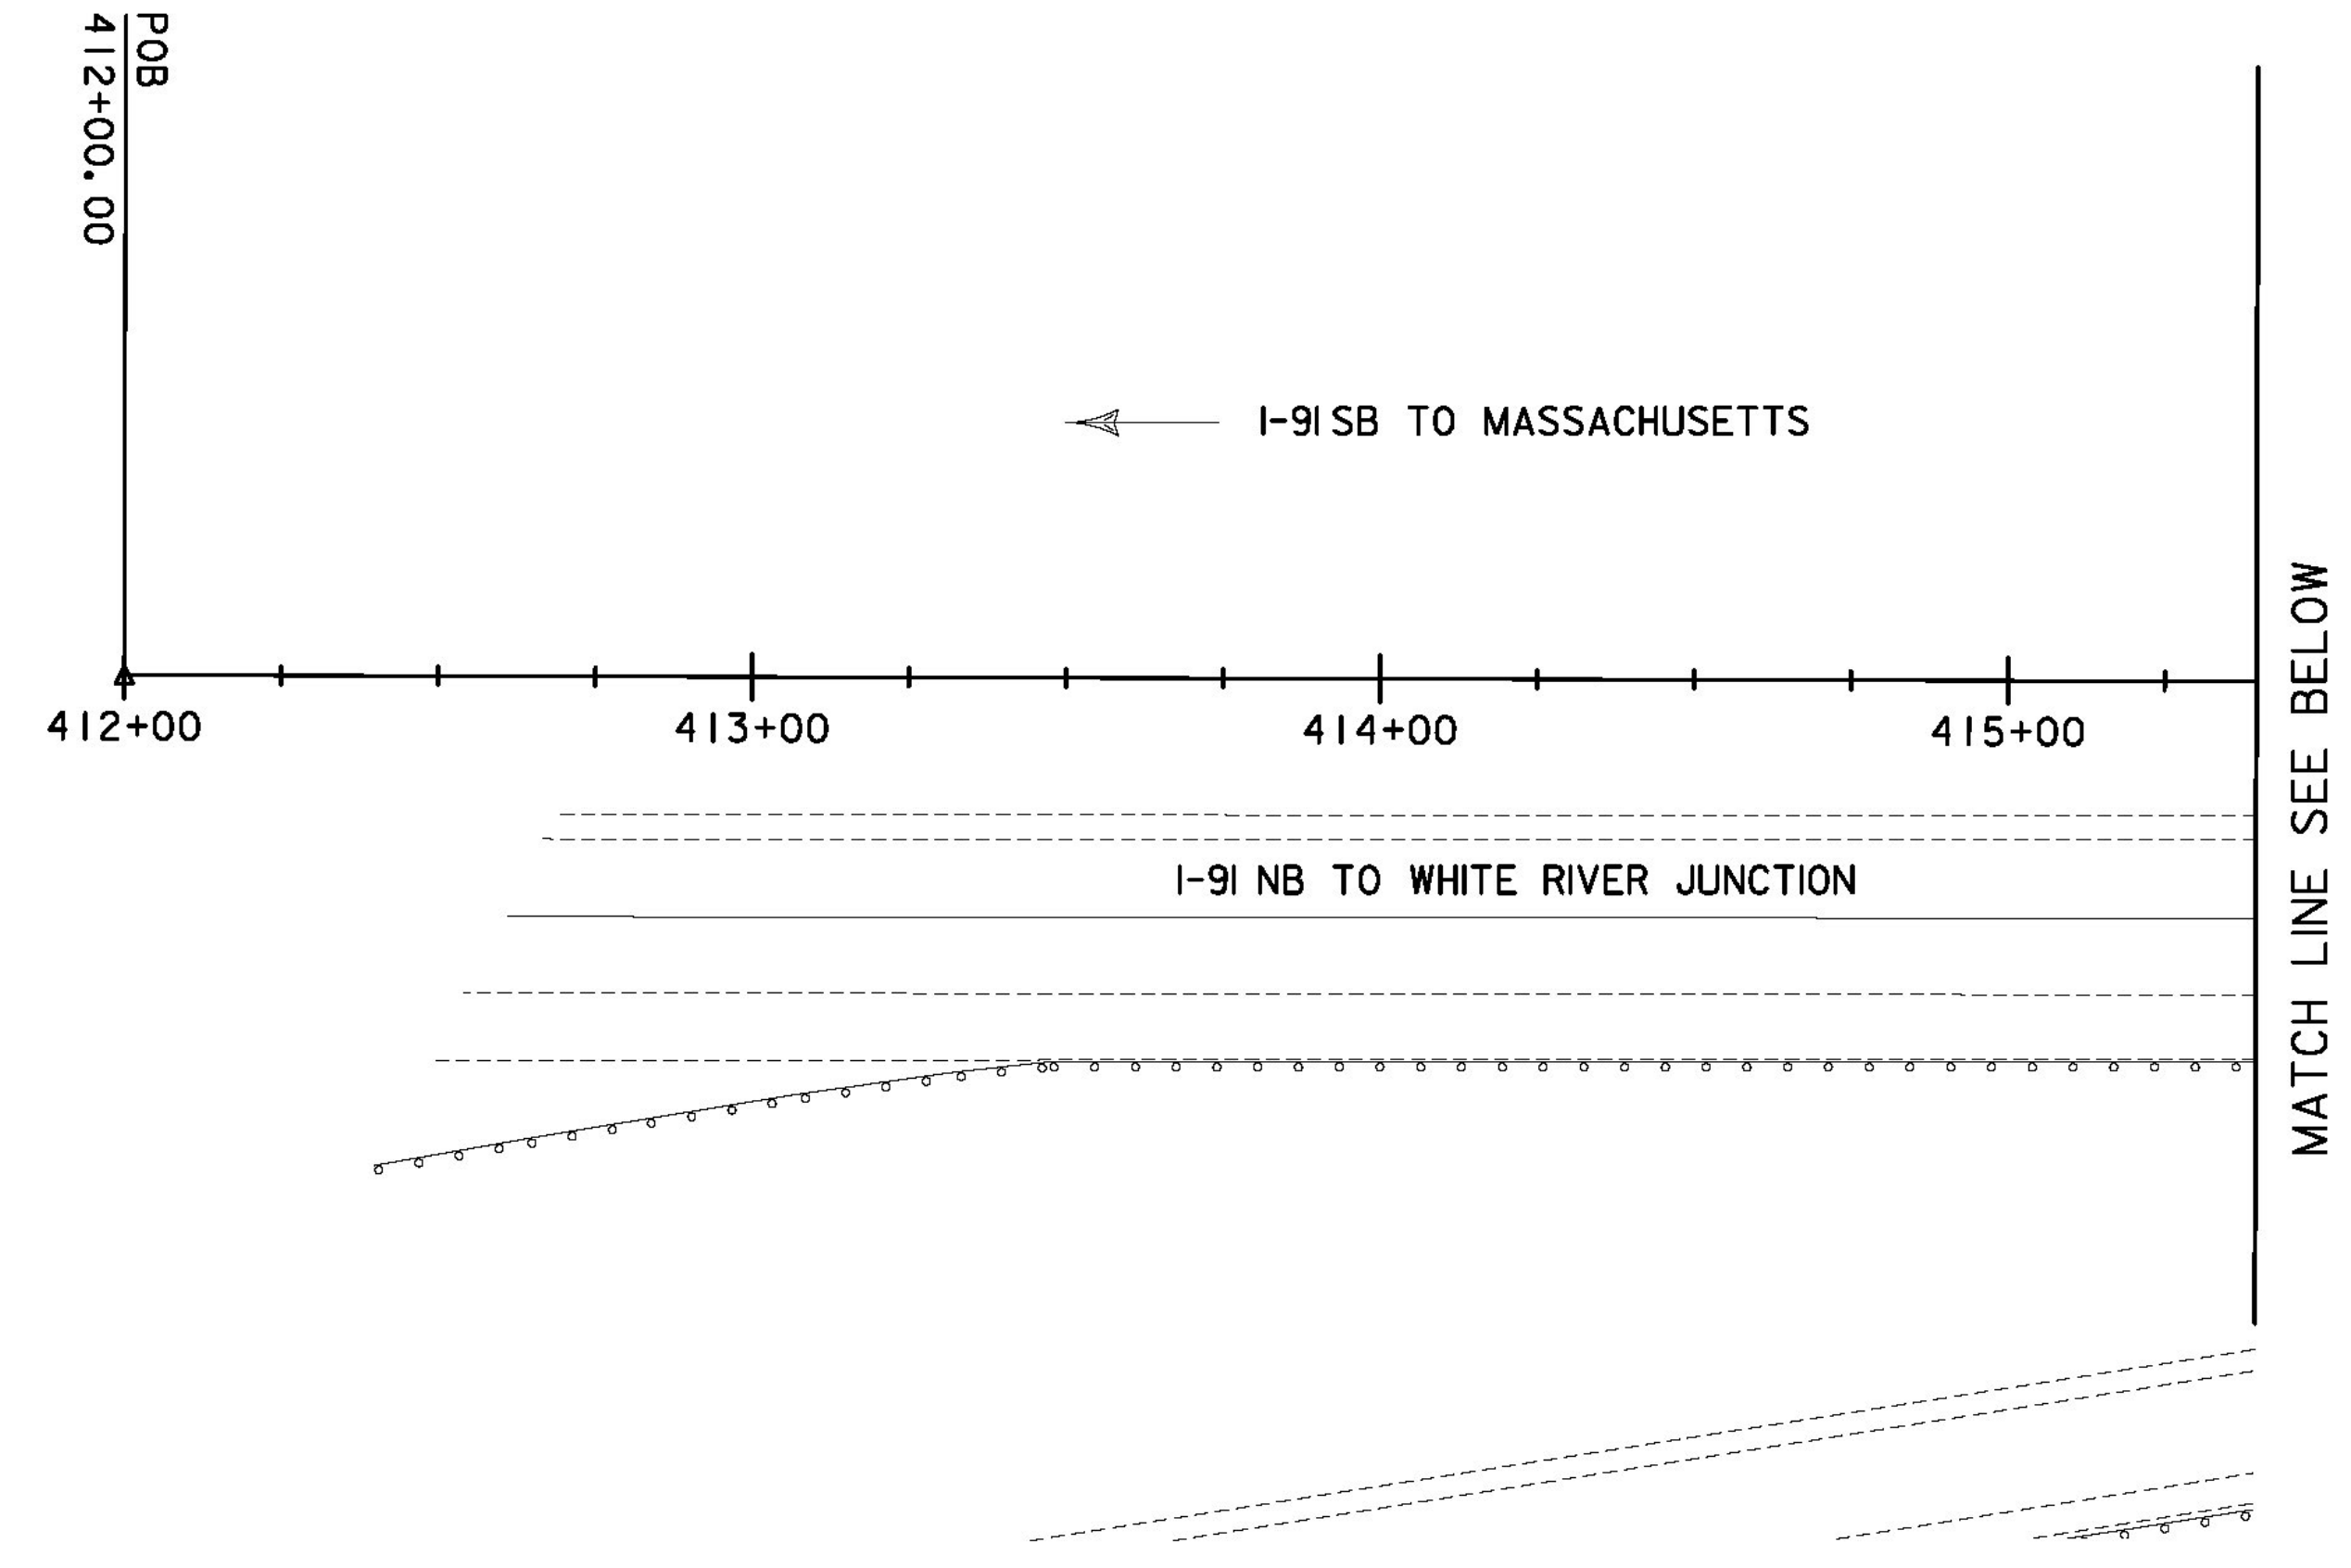

**AS BUILT  
 RECORD PLANS**

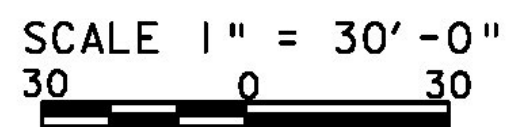

RFC PLANS - WORK PACKAGE #6  
 NB ROADWAY APPROACH  
 NOVEMBER 28, 2011

BECK & BELLUCCI, INC.	TYLIN INTERNATIONAL	PROJECT NAME: BRATTLEBORO	PLOT DATE: 11/30/2011
		PROJECT NUMBER: 1M 091-I(50)	DRAWN BY: A. R. GREENLAW
		FILE NAME: HW-RA-DGN-503.dgn	CHECKED BY: D. Bryant P.E.
		PROJECT LEADER: Phillip E. Kendall II, P.E.	SHEET HW-RA-DGN-503
		DESIGNED BY: Phillip E. Kendall P.E.	
		NORTHBOUND APPROACH PLANS 1 of 5	