


**AS BUILT RECORD PLANS**

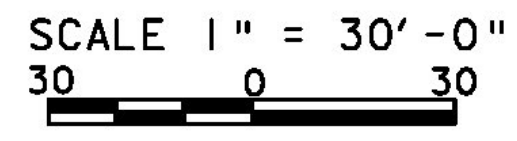

- NOTES:
- SEE SHEET HW-RA-DGN-503 FOR CURVE DATA FOR CURVE 1 - BRIDGE 5
  - SEE SHEET HW-RA-DGN-507 FOR CURVE DATA FOR CURVE 1 - BRIDGE 6 AND CURVE 2 - BRIDGE 6

RFC PLANS - WORK PACKAGE #6  
NB ROADWAY APPROACH  
NOVEMBER 28, 2011

BECK & BELLUCCI, INC. TYLIN INTERNATIONAL

PROJECT NAME: BRATTLEBORO	FILE NAME: HW-RA-DGN-505.dgn	PLOT DATE: 11/30/2011
PROJECT NUMBER: 1M 091-(K)50	PROJECT LEADER: Phillip E. Kendall II, P.E.	DRAWN BY: A.R. GREENLAW
	DESIGNED BY: Phillip E. Kendall P.E.	CHECKED BY: D. Bryant P.E.
	NORTHBOUND APPROACH PLAN 3 of 5	SHEET HW-RA-DGN-505