


**AS BUILT
RECORD PLANS**

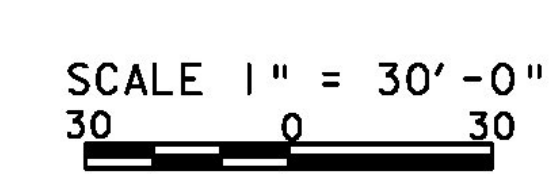

RFC PLANS - WORK PACKAGE #6
NB ROADWAY APPROACH
NOVEMBER 28, 2011

BECK & BELLUCCI, INC. TYLIN INTERNATIONAL

PROJECT NAME: BRATTLEBORO	PLOT DATE: 11/30/2011
PROJECT NUMBER: 1M 091-(150)	DRAWN BY: A. R. GREENLAW
FILE NAME: HW-RA-DGN-507.dgn	CHECKED BY: D. Bryant P.E.
PROJECT LEADER: Phillip E. Kendall II, P.E.	SHEET HW-RA-DGN-507
DESIGNED BY: Phillip E. Kendall P.E.	
NORTHBOUND APPROACH PLANS 5 of 5	