



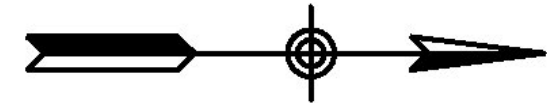


CURVE 1 - BRIDGE 5
 PI STA. = 541+44.56
 DELTA = 4°41'02"
 D = 2°01'39"
 R = 2825.79'
 T = 115.56'
 L = 231.00'
 E = 2.36'

CURVE 2 - BRIDGE 5
 PI STA. = 543+92.38
 DELTA = 4°49'05"
 D = 2°23'14"
 R = 2400.00'
 T = 100.97'
 L = 201.82'
 E = 2.12'

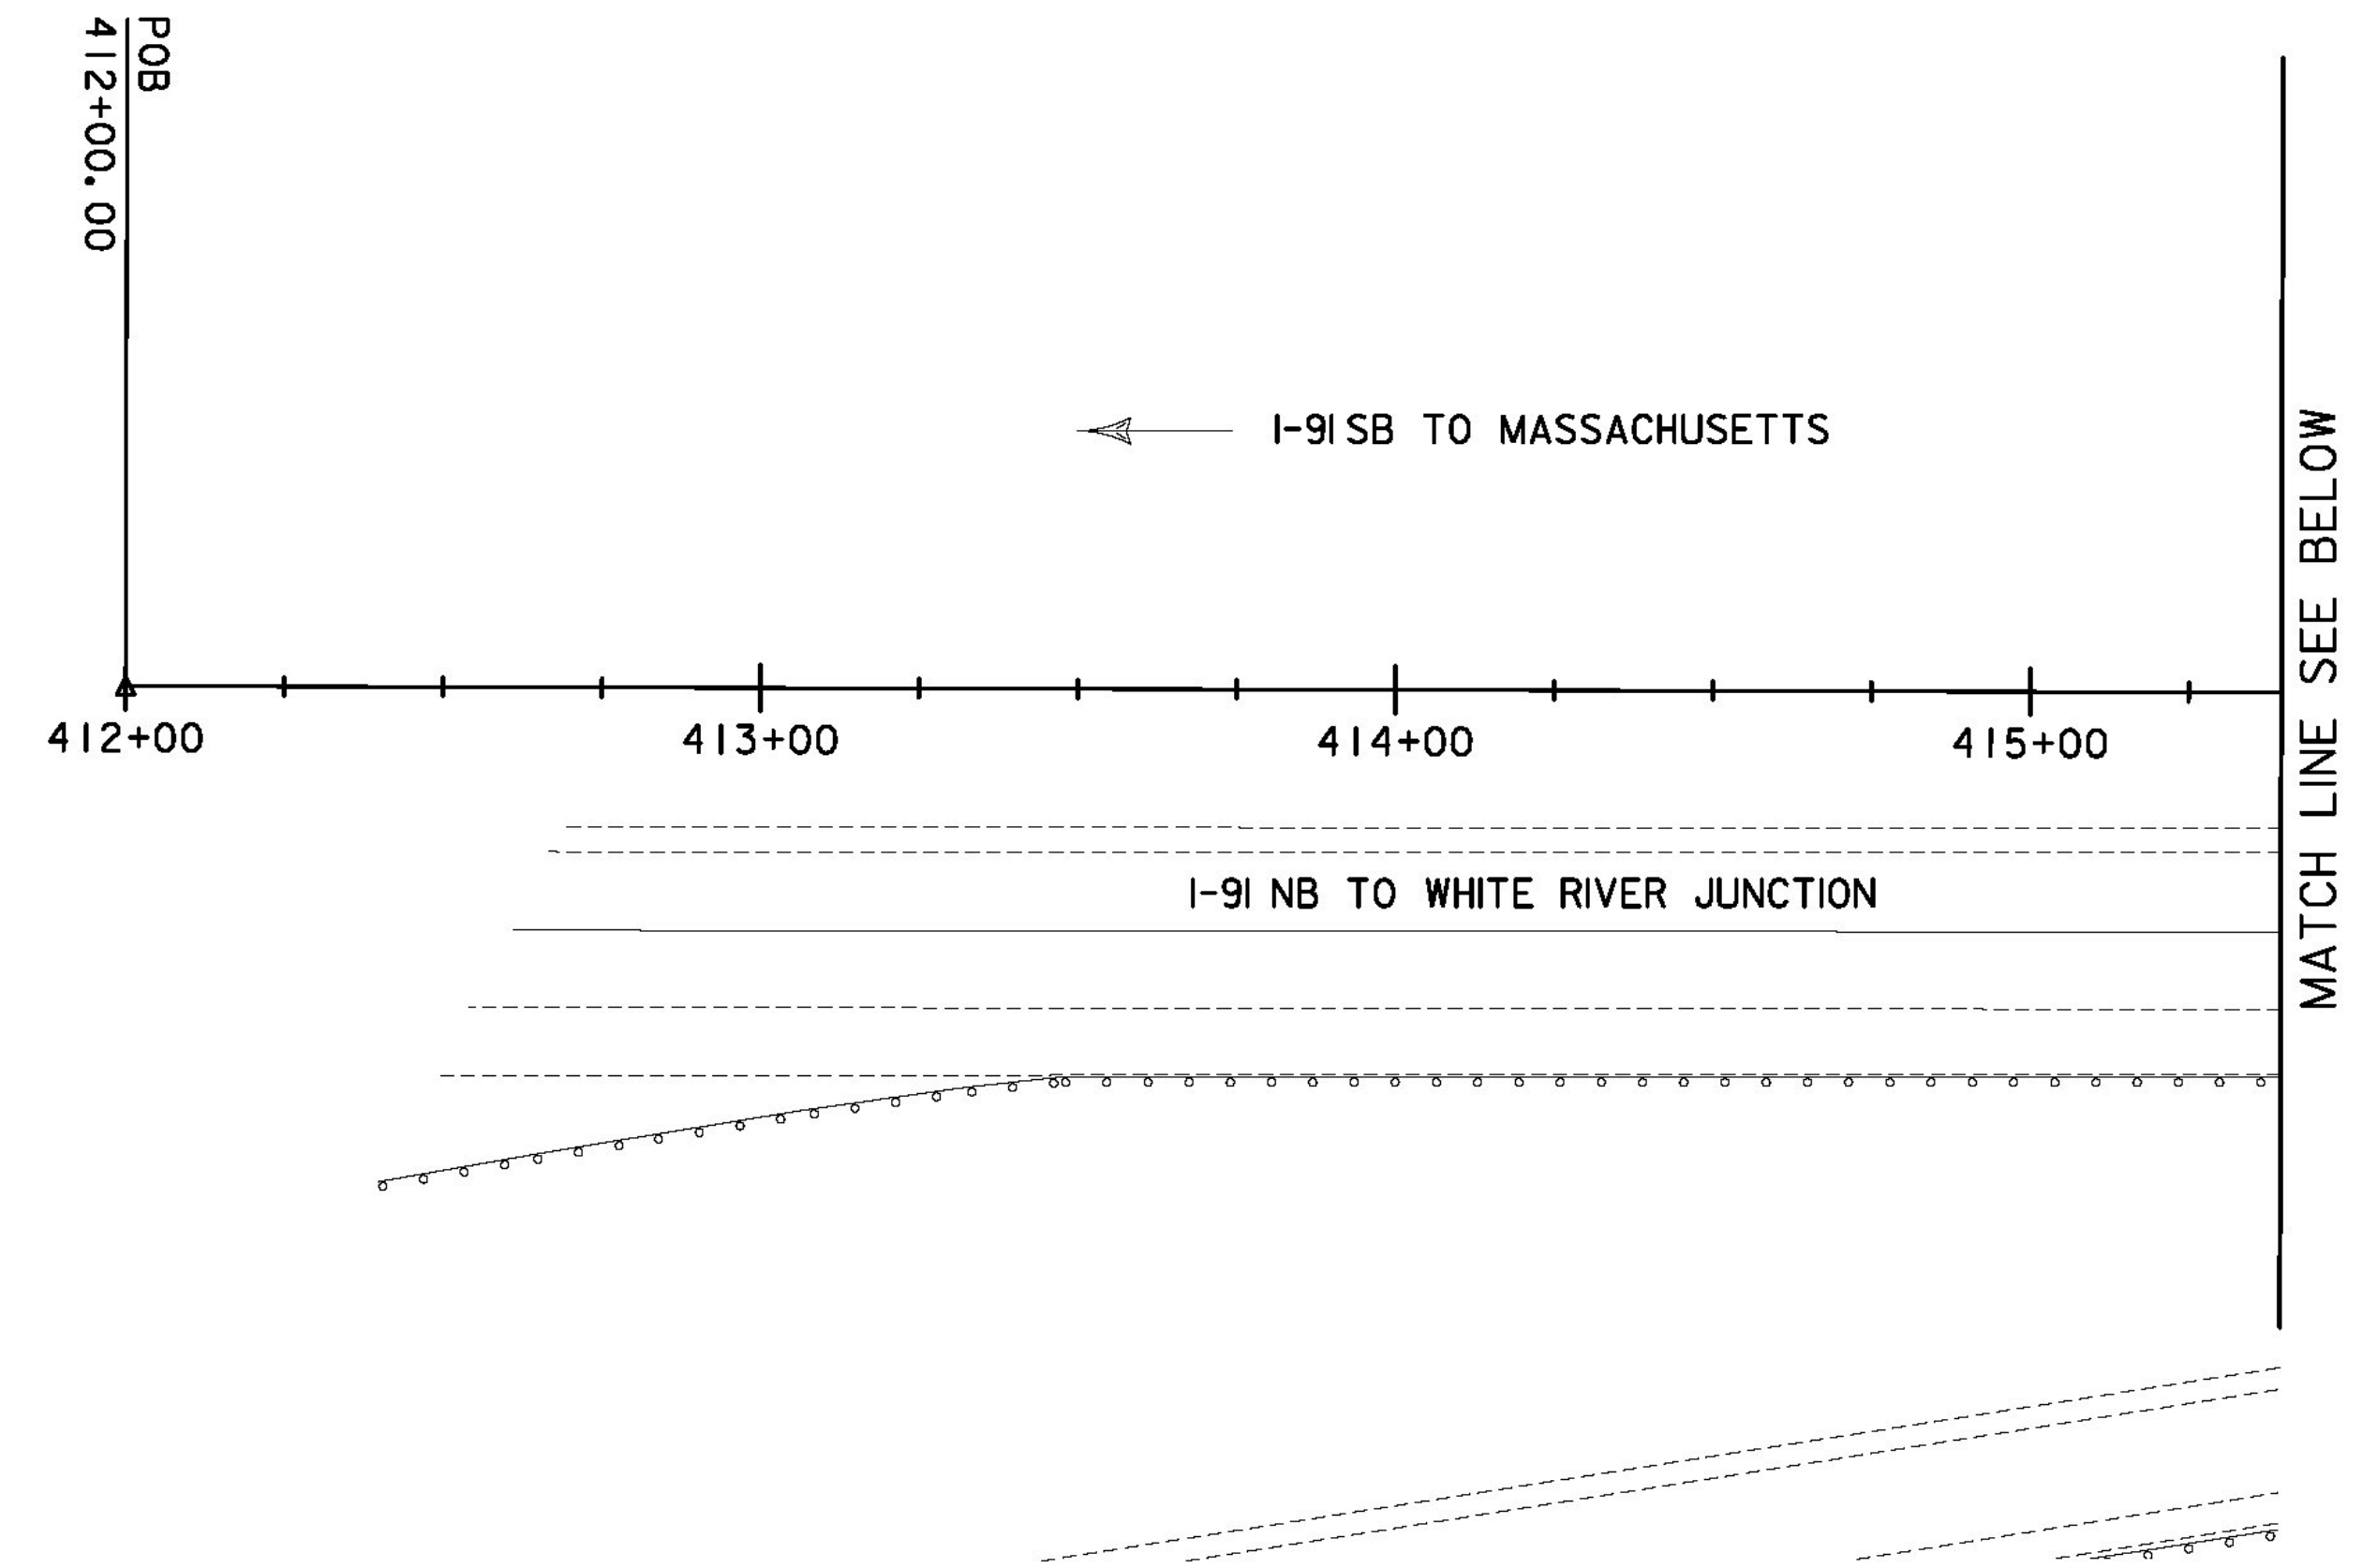

MATCH LINE SEE ABOVE

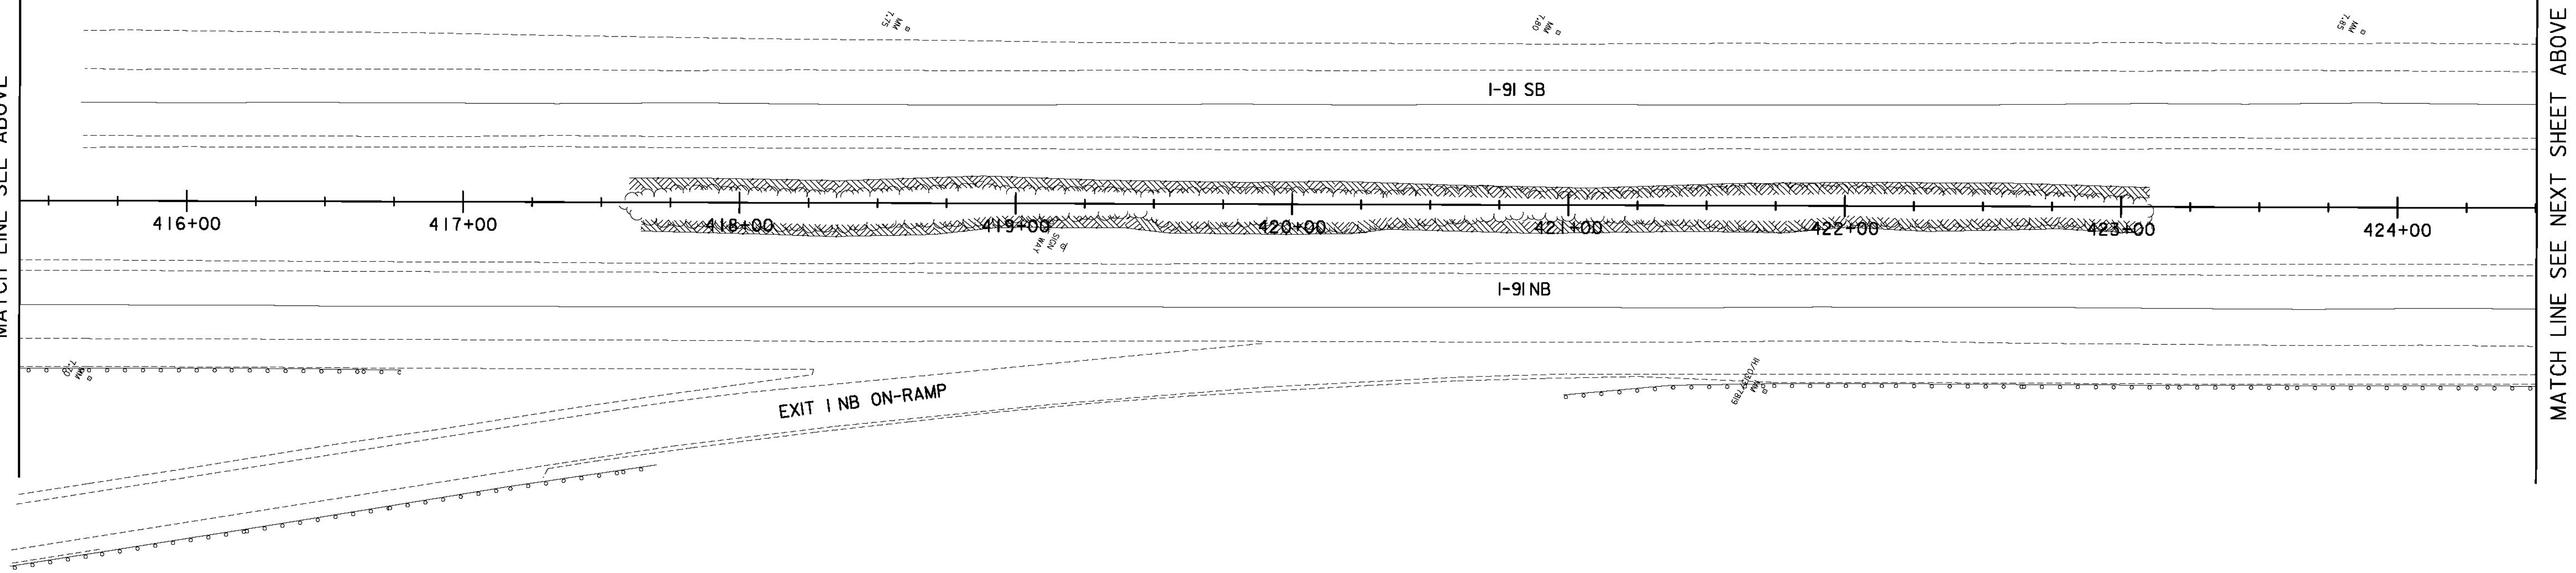

**AS BUILT
 RECORD PLANS**

SCALE 1" = 30'-0"
 30 0 30

RFC PLANS - WORK PACKAGE #10
 SOUTHBOUND APPROACH
 MARCH 1, 2012

BECK & BELLUCCI, INC.

TYLIN INTERNATIONAL

PROJECT NAME: BRATTLEBORO

PROJECT NUMBER: IM 091-(150)

FILE NAME: HW-SRA-DGN-503.dgn

PROJECT LEADER: Phillip E. Kendall P.E.

DESIGNED BY: Phillip E. Kendall P.E.

SOUTHBOUND APPROACH PLANS 1 of 5

PLOT DATE: 3/1/2012

DRAWN BY: J. DAVIS

CHECKED BY: D. Bryant P.E.

SHEET HW-SRA-DGN-503