


NORTHBOUND APPROACH AT BRIDGE 5

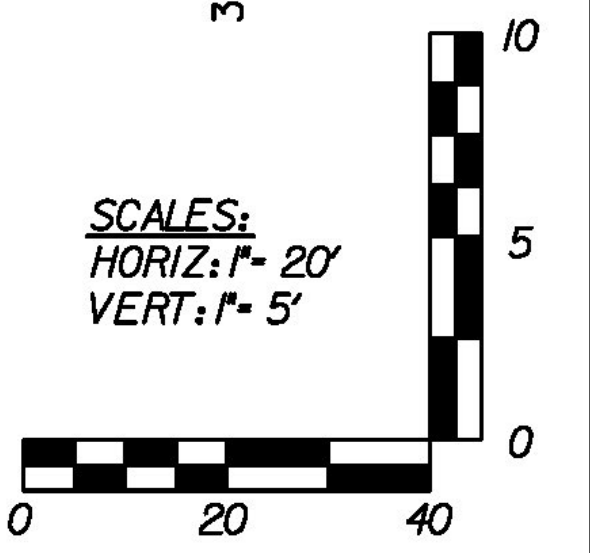

RFC PLANS - WORK PACKAGE #6
 NB ROADWAY APPROACH
 NOVEMBER 28, 2011

PROJECT NAME: BRATTLEBORO
 PROJECT NUMBER: IM 091-(50)

**AS BUILT
 RECORD PLANS**

BECK & BELLUCCI, INC. **TYLIN INTERNATIONAL**

FILE NAME: HW-RA-DGN-601.dgn
 PROJECT LEADER: Phillip E. Kendall II, P.E.
 DESIGNED BY: Phillip E. Kendall P.E.
 NORTHBOUND APPROACH PROFILE 1 OF 3

PLOT DATE: 11/30/2011
 DRAWN BY: A. R. GREENLAW
 CHECKED BY: D. Bryant P.E.
 SHEET HW-RA-DGN-601