


**SOUTHBOUND APPROACH AT BRIDGE 5**

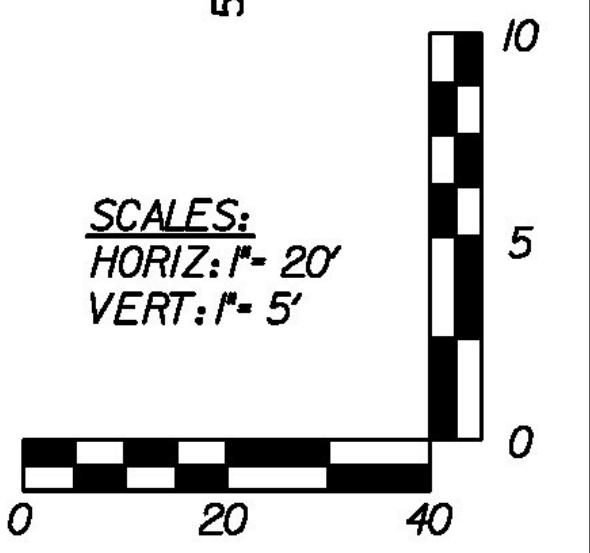

**AS BUILT  
 RECORD PLANS**

<b>BECK &amp; BELLUCCI, INC.</b>	<b>TYLININTERNATIONAL</b>	PROJECT NAME: BRATTLEBORO	PLOT DATE: 5/15/2013
		PROJECT NUMBER: IM 091-K(50)	DRAWN BY: J. DAVIS
		FILE NAME: HW-SRA-DGN-60I.dgn	CHECKED BY: D. Bryant P.E.
		PROJECT LEADER: Phillip E. Kendall P.E.	SHEET HW-SRA-DGN-60I
		DESIGNED BY: Phillip E. Kendall P.E.	
		SOUTHBOUND APPROACH PROFILE 1 OF 3	