


SOUTHBOUND APPROACH AT BRIDGE 6

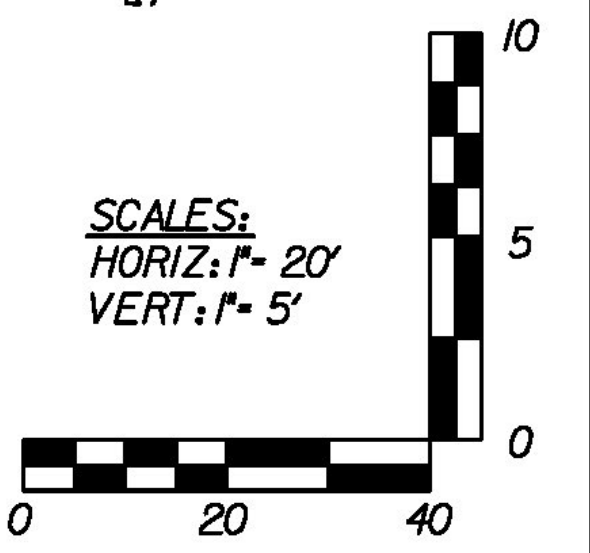

AS BUILT  
 RECORD PLANS

BECK & BELLUCCI, INC. TYLIN INTERNATIONAL

PROJECT NAME: BRATTLEBORO  
 PROJECT NUMBER: IM 09I-(K50)  
 FILE NAME: HW-SRA-DGN-602.dgn  
 PROJECT LEADER: Phillip E. Kendall P.E.  
 DESIGNED BY: Phillip E. Kendall P.E.  
 SOUTHBOUND APPROACH PROFILE 2 OF 3  
 PLOT DATE: 5/15/2013  
 DRAWN BY: J. DAVIS  
 CHECKED BY: D. Bryant P.E.  
 SHEET HW-SRA-DGN-602