


SOUTHBOUND APPROACH AT BRIDGE 6

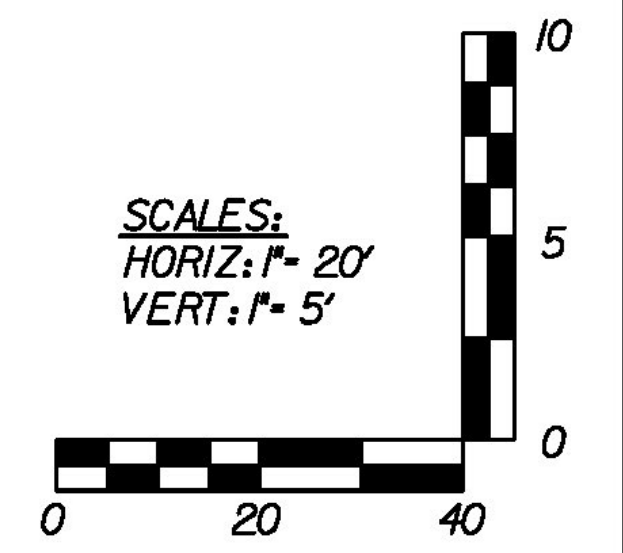

AS BUILT
 RECORD PLANS

BECK & BELLUCCI, INC. TYLIN INTERNATIONAL

PROJECT NAME: BRATTLEBORO	PLOT DATE: 5/15/2013
PROJECT NUMBER: IM 091-(K50)	DRAWN BY: J. DAVIS
FILE NAME: HW-SRA-DGN-603.dgn	CHECKED BY: D. Bryant P.E.
PROJECT LEADER: Phillip E. Kendall P.E.	SHEET HW-SRA-DGN-603
DESIGNED BY: Phillip E. Kendall P.E.	