


NOTE:
1. SEE "PIER #1 PLAN & ELEVATION" SHEET FOR NOTES.

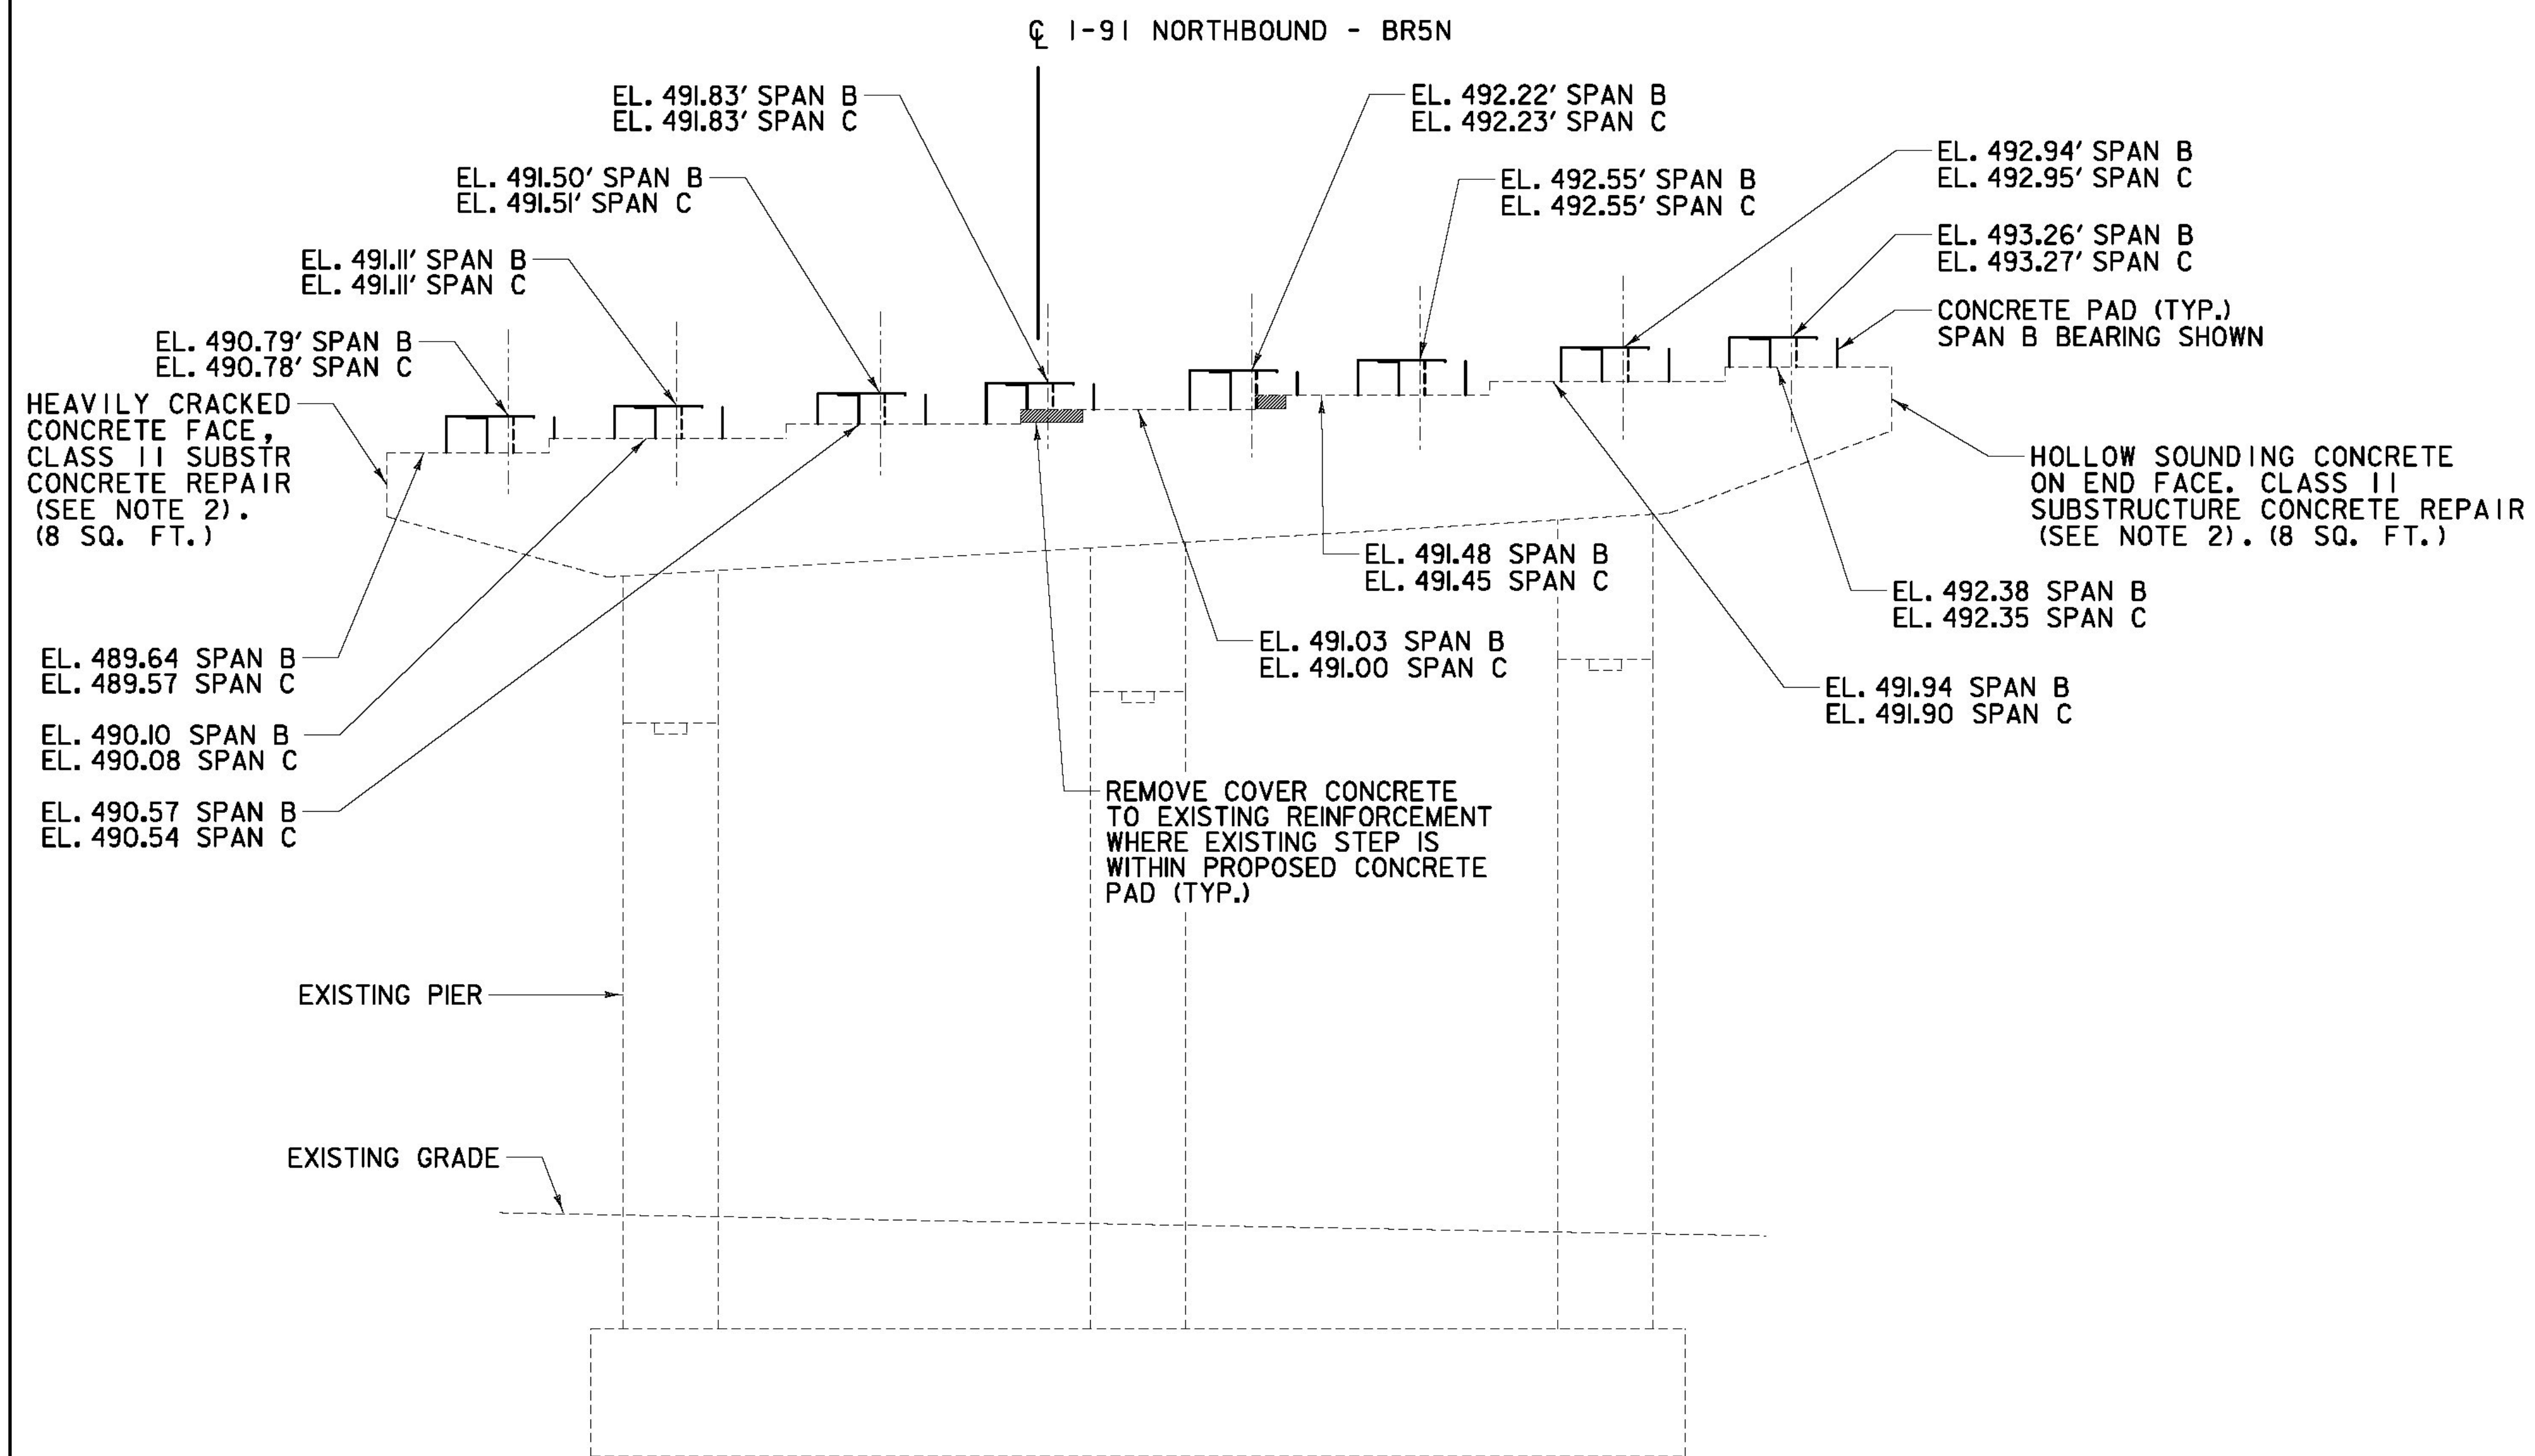

**AS BUILT
RECORD PLANS**

**RFC PLANS - WORK PACKAGE #7
BRIDGE 5N
SEPTEMBER 21, 2011**

PROJECT NAME: BRATTLEBORO

PROJECT NUMBER: IM 091-(150)

BECK & BELLUCCI, INC.

TYLIN INTERNATIONAL

FILE NAME: ZB-100-BR5-306.dgn

PROJECT LEADER: Brian W. Clogston P.E.

DESIGNED BY: Richard Bollinger P.E.

PIER #2 PLAN & ELEVATION

PLOT DATE: 9/21/2011

DRAWN BY: S. A. Morgan

CHECKED BY: J. E. Krajewski

SHEET ZB-100-BR5-306