


PLAN
 SCALE 1" = 20'-0"
 20 0 20

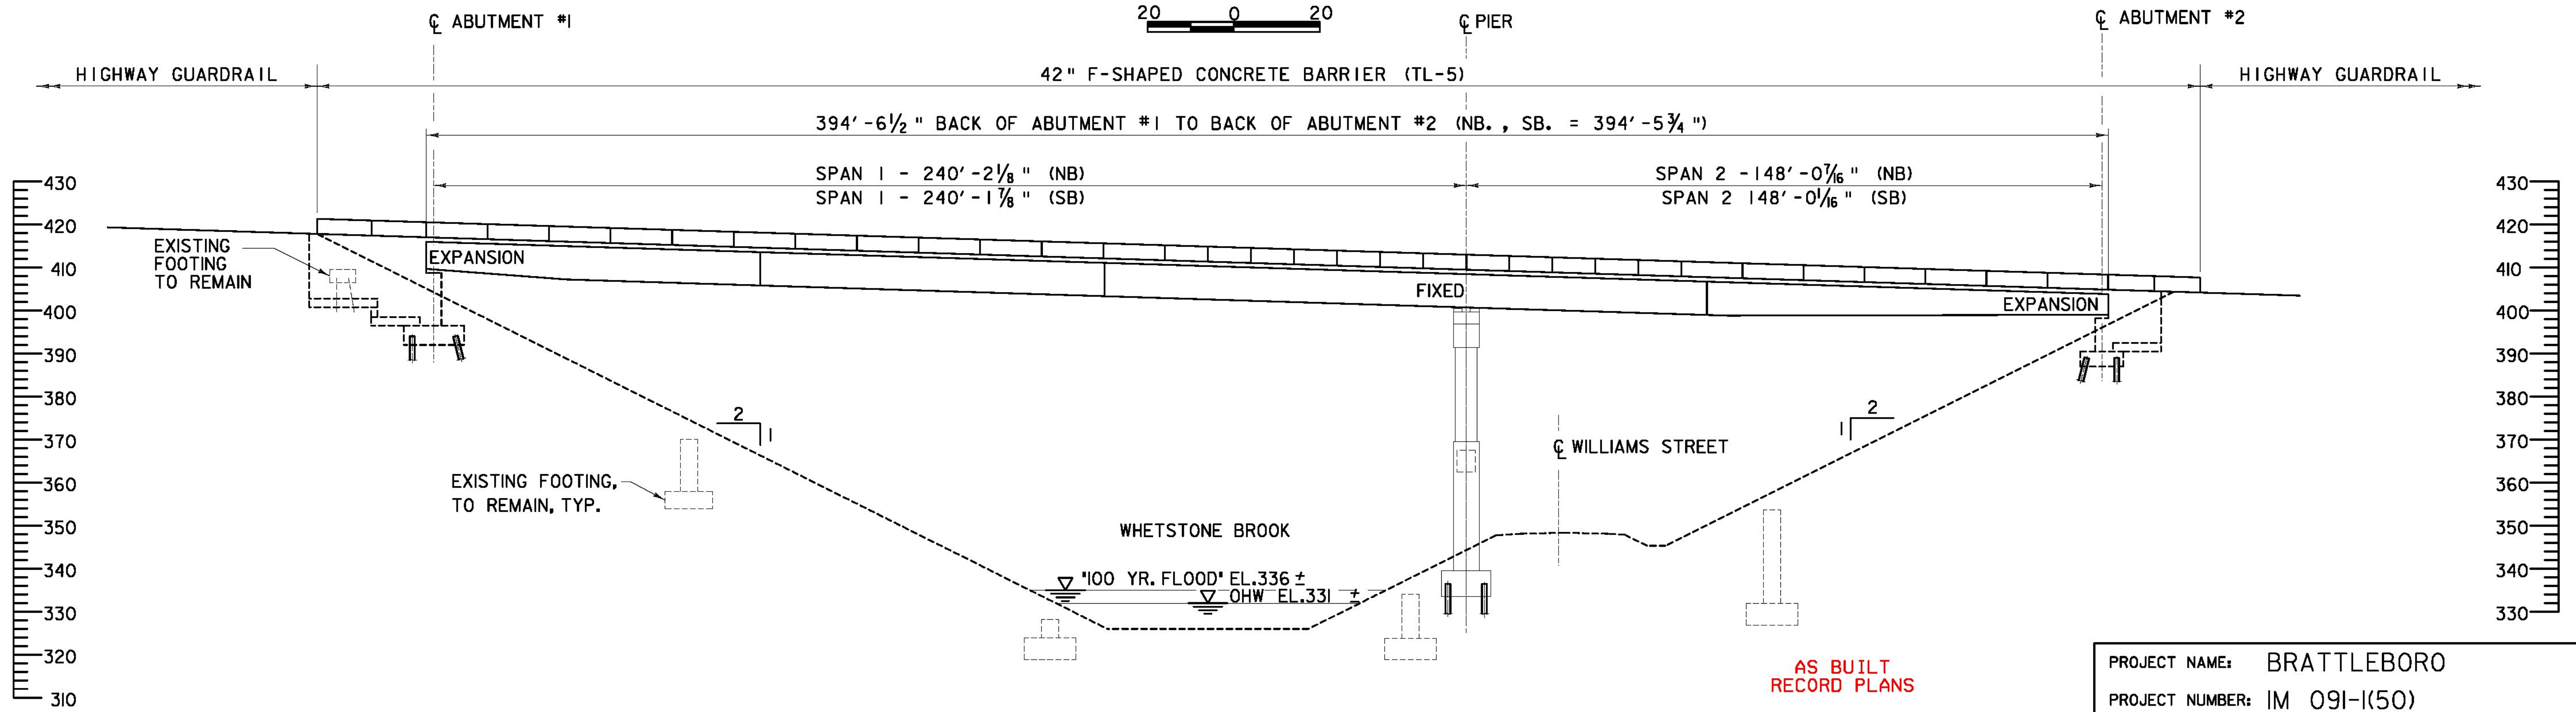

AS BUILT
 RECORD PLANS

PROJECT NAME:	BRATTLEBORO
PROJECT NUMBER:	IM 091-(K50)
FILE NAME:	ZB-100-BR6-101.dgn
PROJECT LEADER:	Phillip E. Kendall P.E.
DESIGNED BY:	Phillip E. Kendall P.E.
BR 6N - PLAN AND ELEVATION	
PLOT DATE:	5/15/2013
DRAWN BY:	J. R. Howe P.E.
CHECKED BY:	J. R. Howe P.E.
SHEET	ZB-100-BR6-101

BECK & BELLUCCI, INC. **TYLININTERNATIONAL**