



NOTES:
SEE PIER GEOMETRY SHEET FOR BEAM SEAT AND SHEAR LUG REINFORCEMENT NOT SHOWN

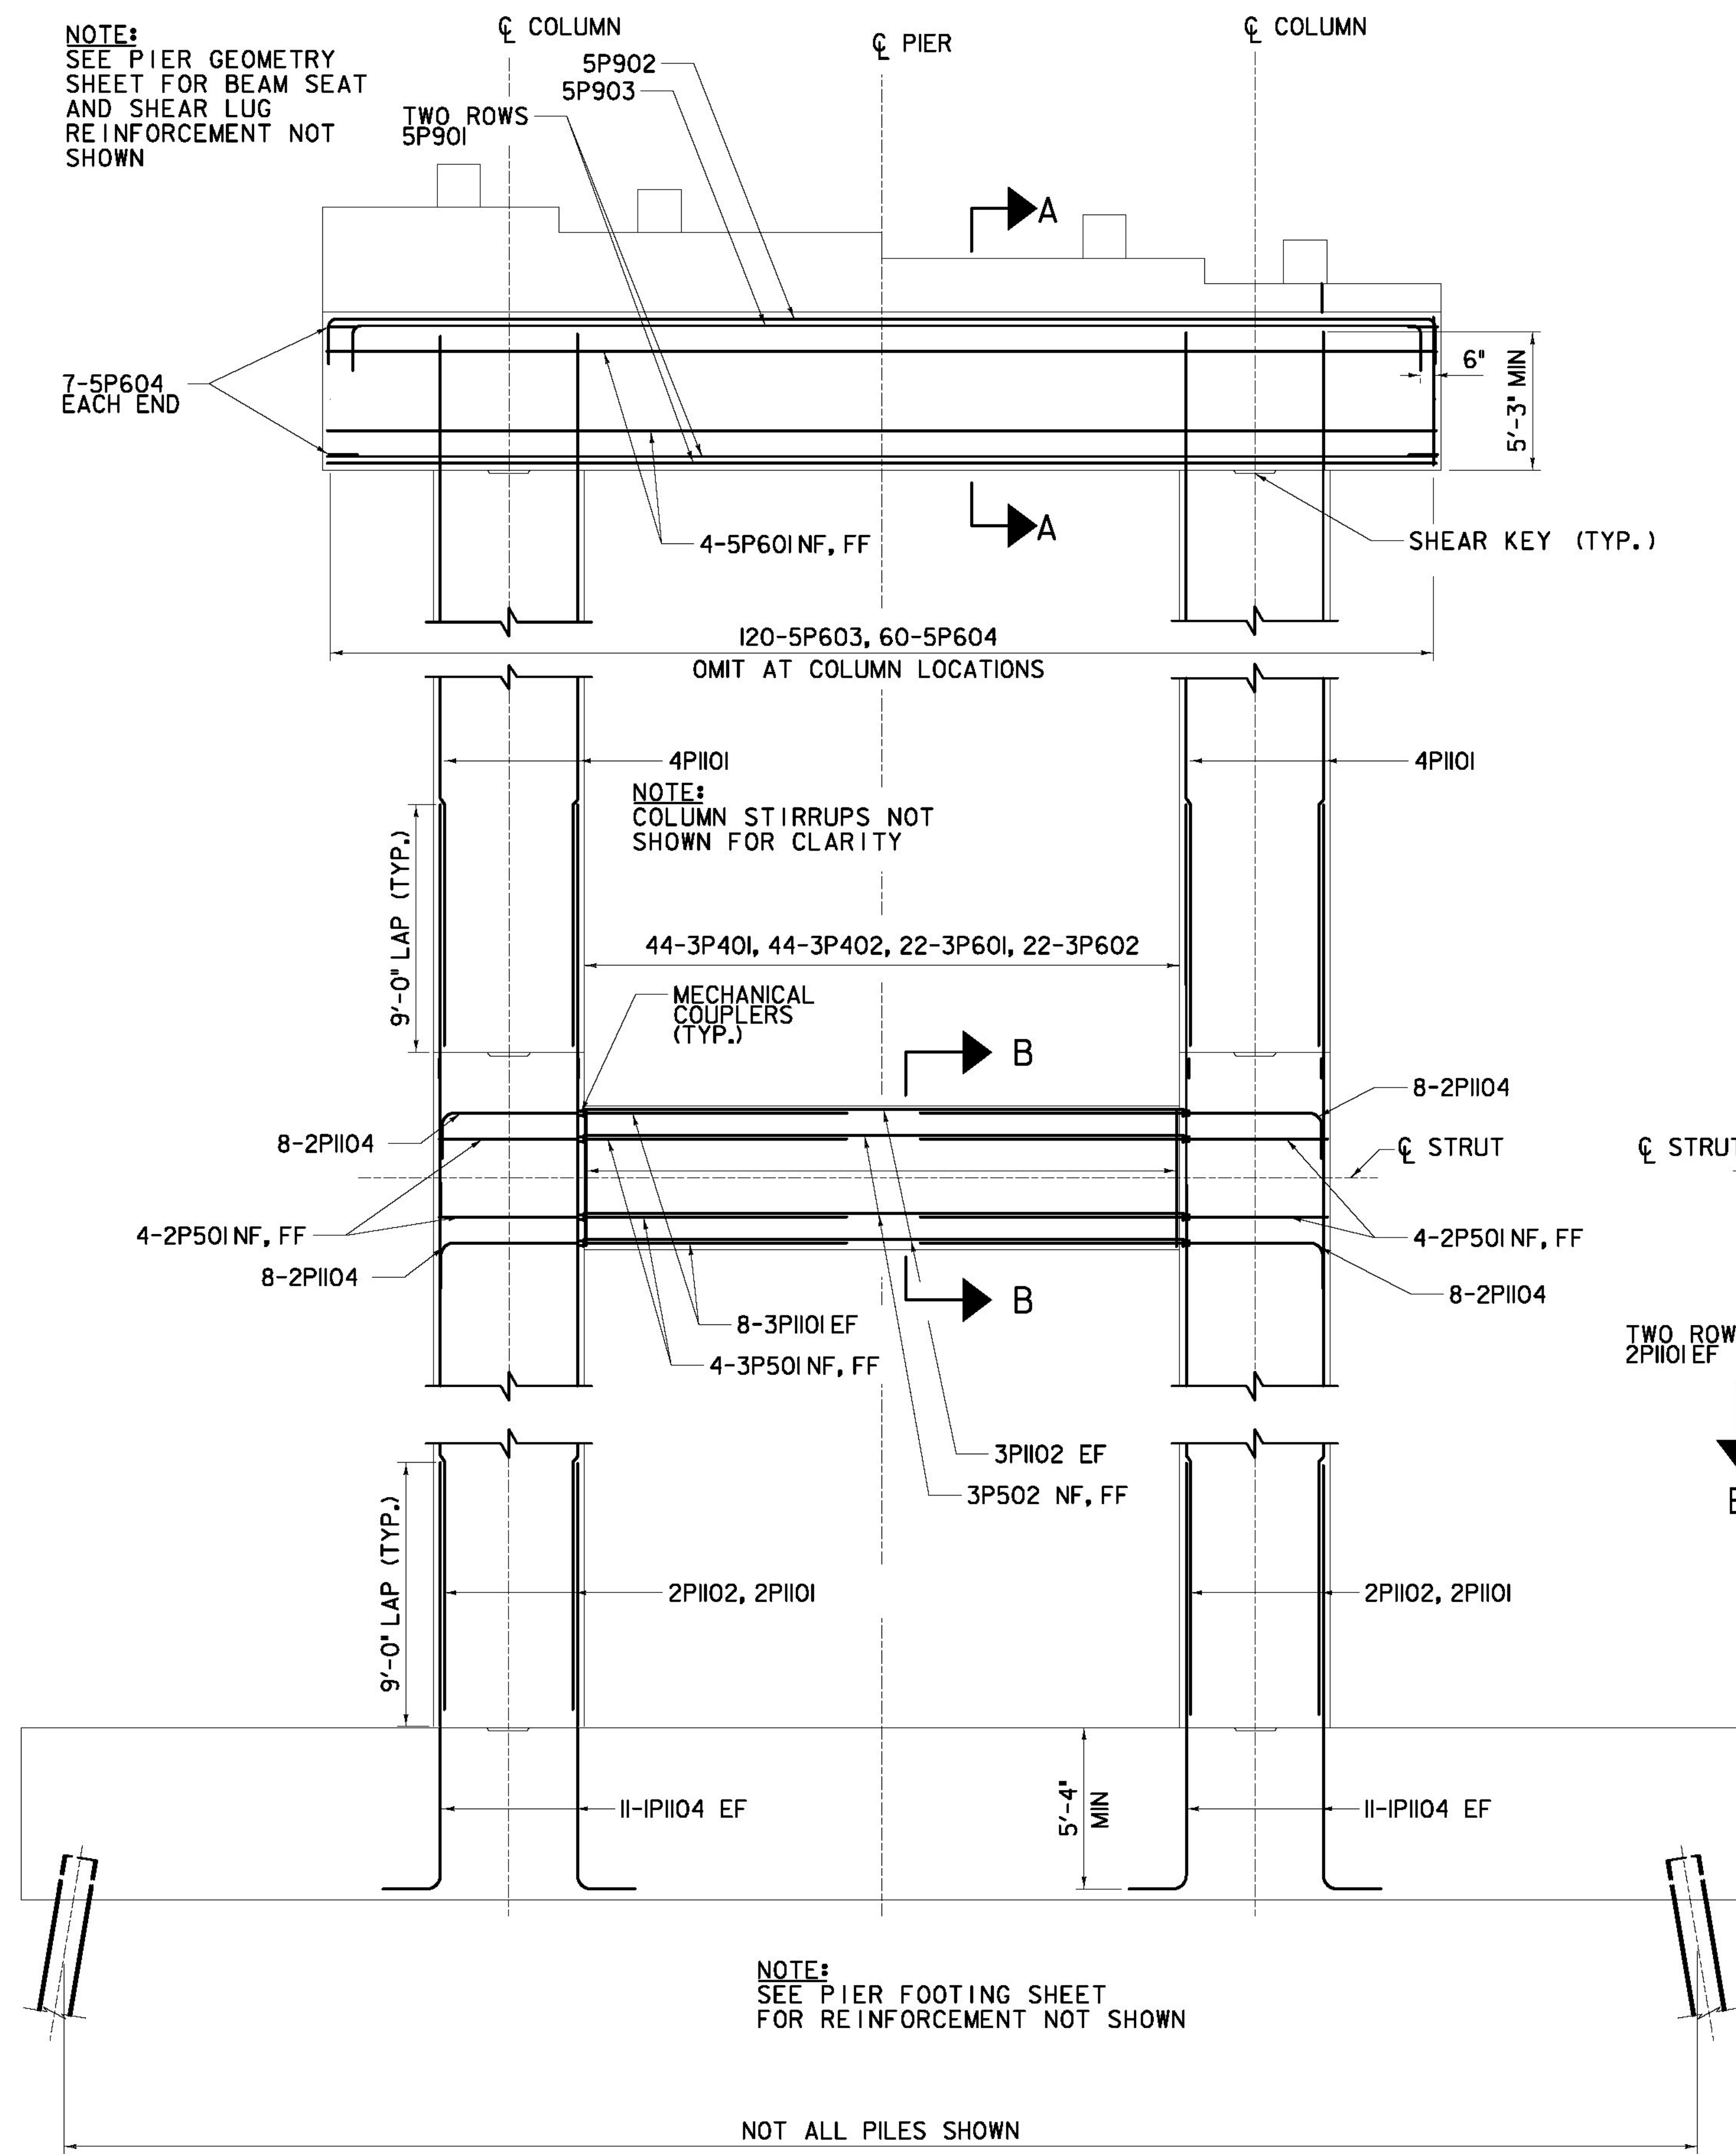

PIER ELEVATION
SCALE: 1/4" = 1'-0"

AS BUILT RECORD PLANS

LEGEND:
NF = NEAR FACE
FF = FAR FACE
EF = EACH FACE

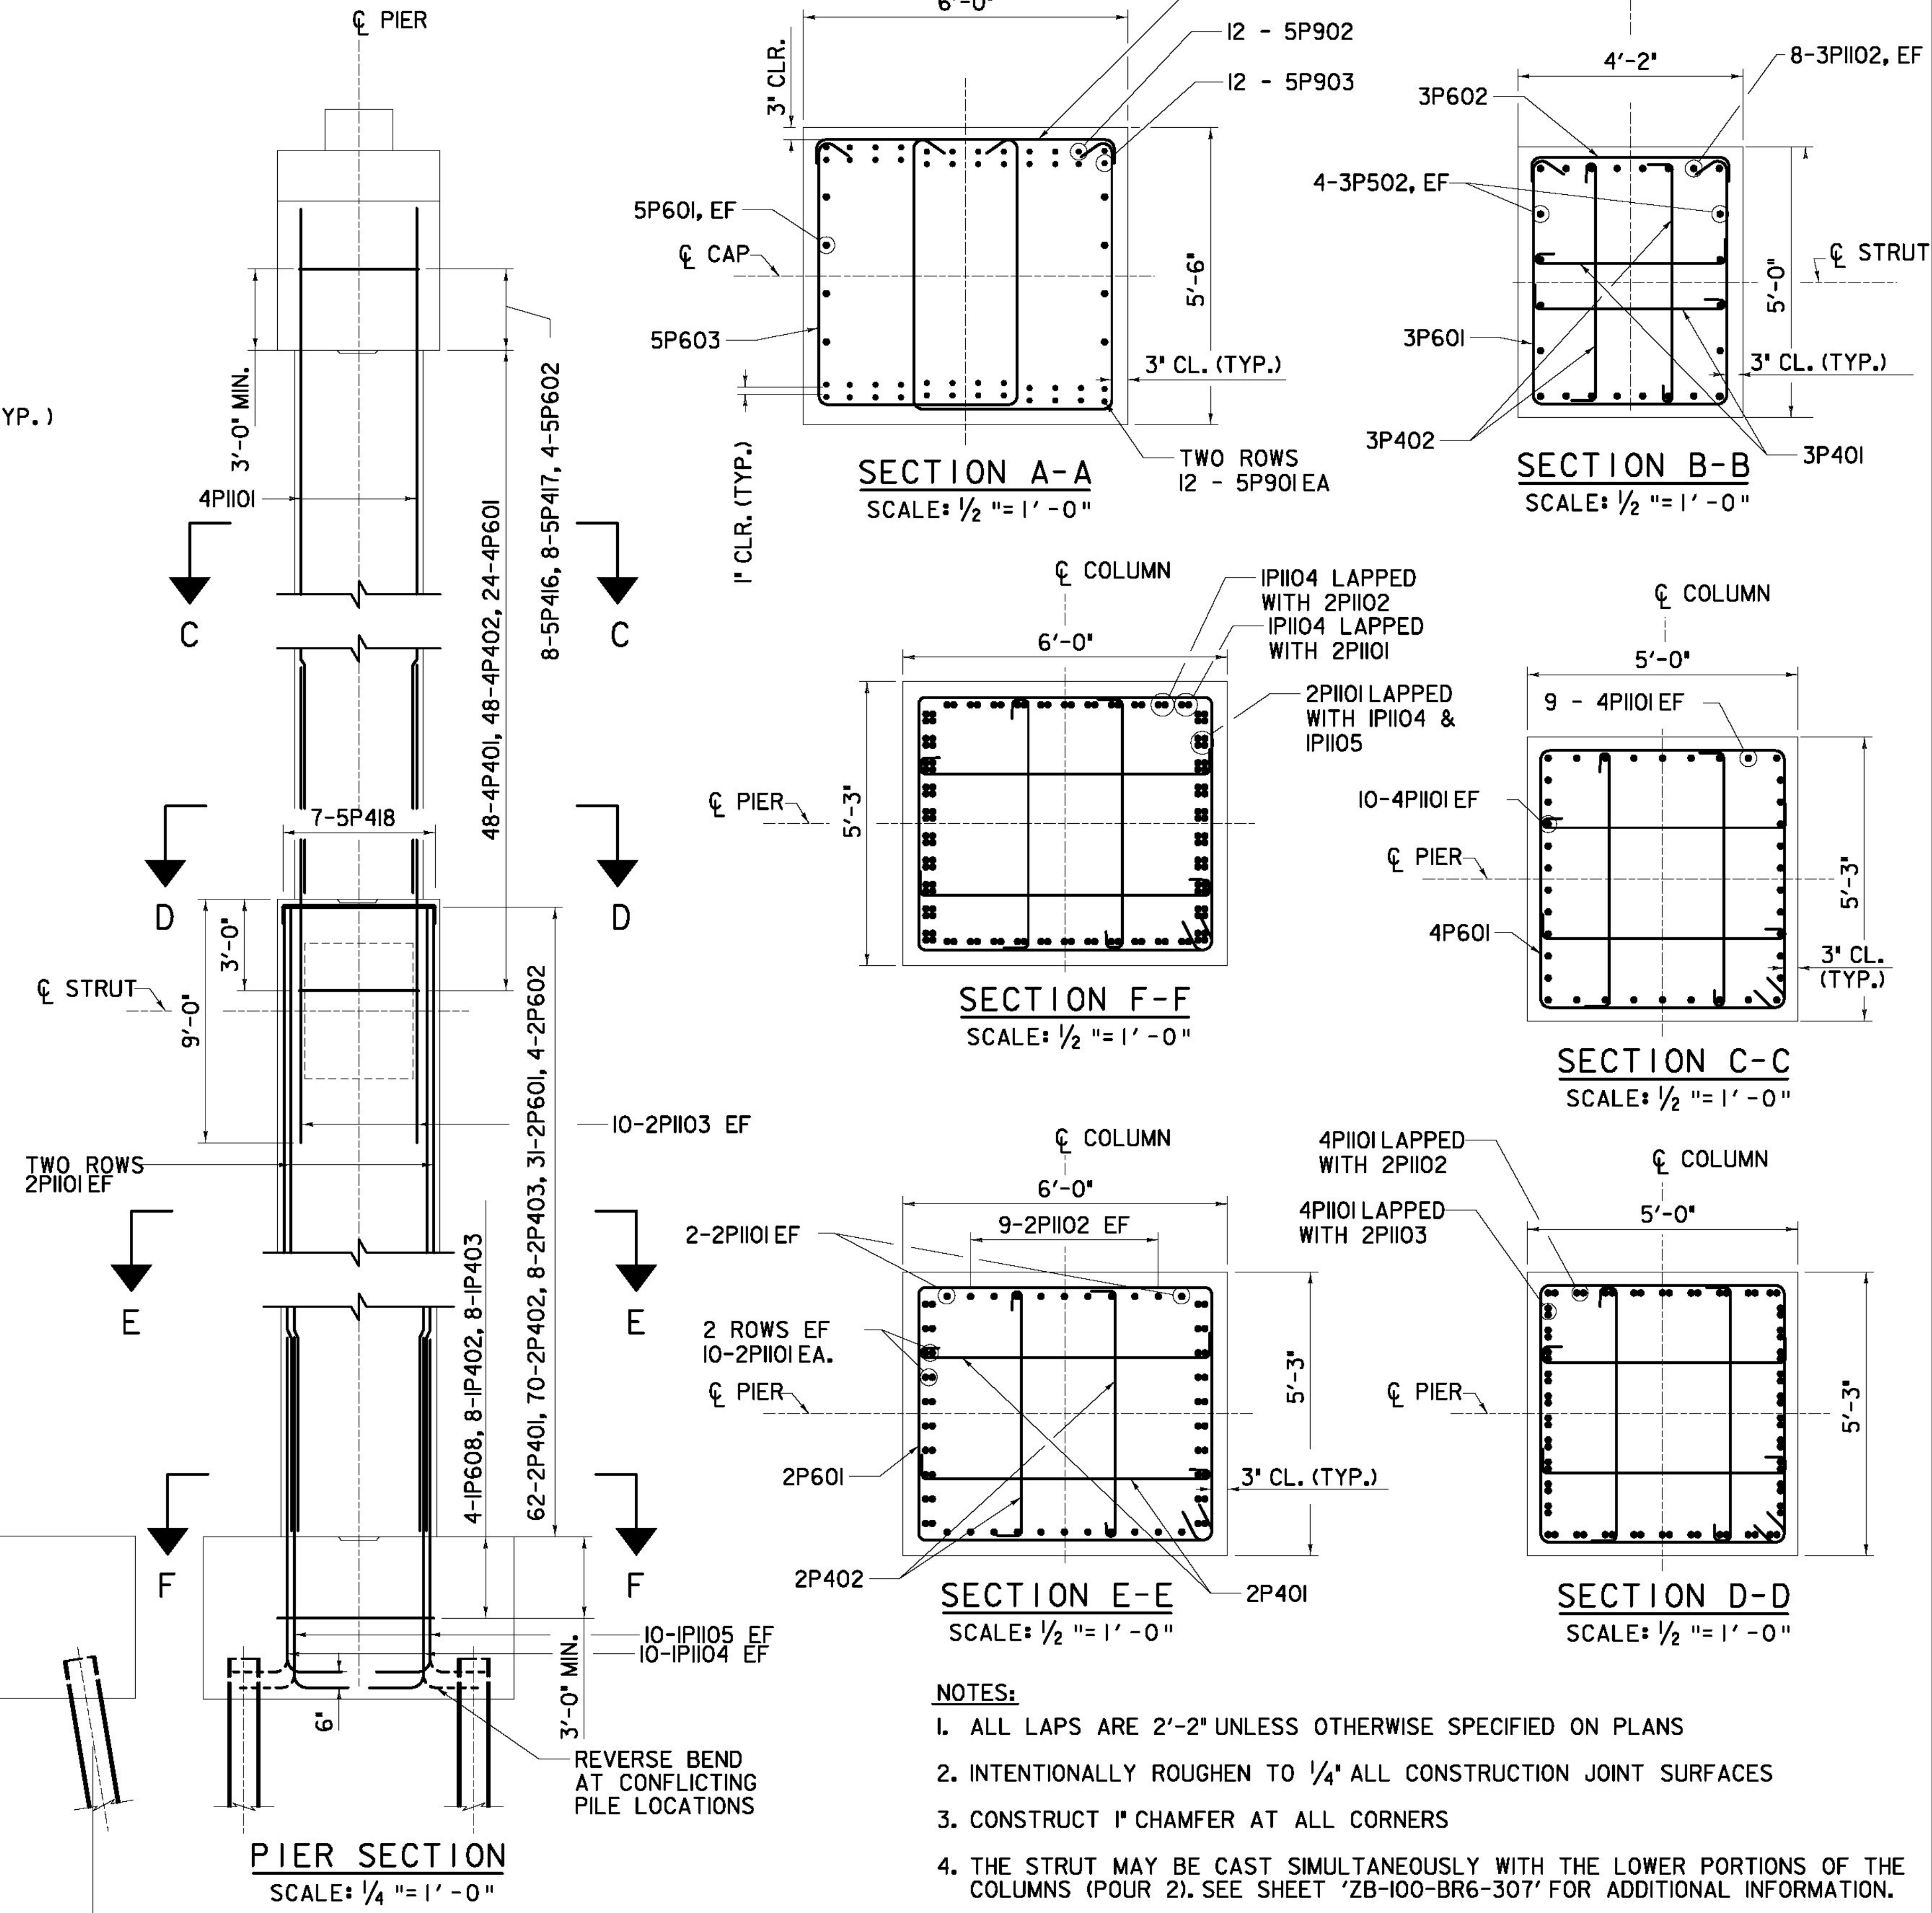

PIER SECTION
SCALE: 1/4" = 1'-0"

NOTES:
1. ALL LAPS ARE 2'-2" UNLESS OTHERWISE SPECIFIED ON PLANS
2. INTENTIONALLY ROUGHEN TO 1/4" ALL CONSTRUCTION JOINT SURFACES
3. CONSTRUCT 1" CHAMFER AT ALL CORNERS
4. THE STRUT MAY BE CAST SIMULTANEOUSLY WITH THE LOWER PORTIONS OF THE COLUMNS (POUR 2). SEE SHEET 'ZB-100-BR6-307' FOR ADDITIONAL INFORMATION.

RFC PLANS - WORK PACKAGE #4
BRIDGE 6N SUBSTRUCTURE
JULY 6, 2011

BECK & BELLUCCI, INC.	TYLIN INTERNATIONAL	PROJECT NAME: BRATTLEBORO	PLOT DATE: 7/20/2011
		PROJECT NUMBER: IM 091-(K50)	DRAWN BY: S. A. Morgan
		FILE NAME: ZB-100-BR6-308.dgn	CHECKED BY: J. England, P.E.
		PROJECT LEADER: Brian W. Clogston P.E.	SHEET ZB-100-BR6-308
		DESIGNED BY: Megan Neill, P.E.	