


FRAMING PLAN - BRIDGE 6N

SCALE: 1/2" = 1'-0"

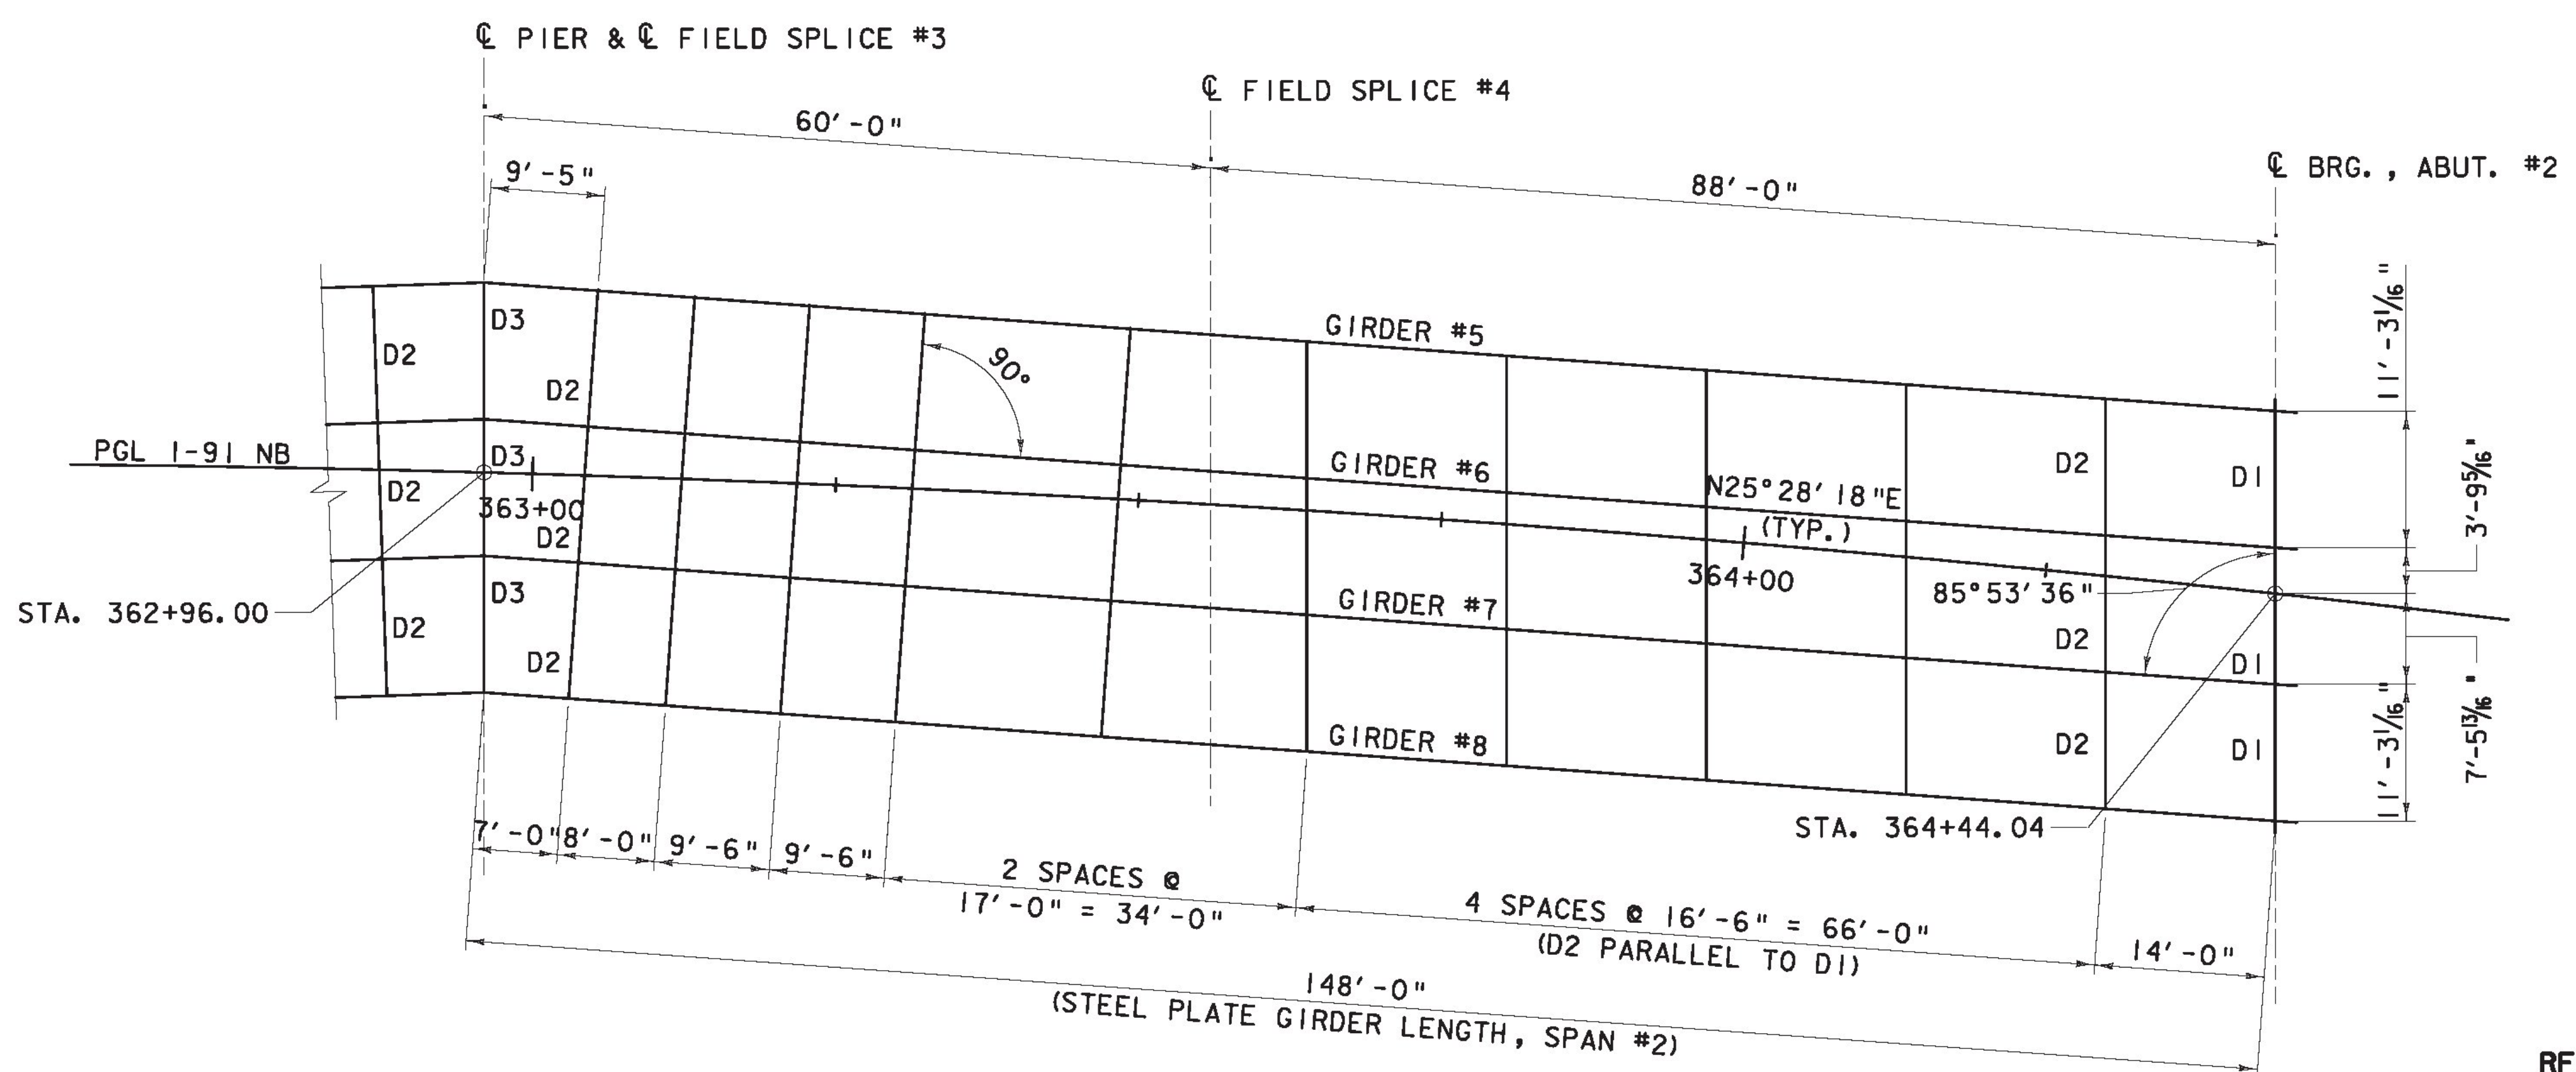

FRAMING PLAN - BRIDGE 6N

SCALE: 1/2" = 1'-0"

AS BUILT  
RECORD PLANS

RFC PLANS - WORK PACKAGE #1A  
BRIDGE 6N & S STRUCTURAL STEEL & BEARINGS  
JULY 29, 2011

BECK & BELLUCCI, INC.

TYLIN INTERNATIONAL

PROJECT NAME: BRATTLEBORO

PROJECT NUMBER: IM 091-(150)

FILE NAME: ZB-100-BR6-401.dgn  
PROJECT LEADER: Brian W. Clogston P.E.  
DESIGNED BY: Joseph Krajewski P.E.  
FRAMING PLAN - BR6N

PLOT DATE: 7/26/2011  
DRAWN BY: S. A. Morgan  
CHECKED BY: Mike Lopez  
SHEET ZB-100-BR6-401