

DECK POUR SEQUENCE NOTES:

THE DECK SHALL BE CAST USING ONE OF THE FOLLOWING ALTERNATES.

ALTERNATE 1: SEQUENTIAL POUR


- A. POURS LABELED WITH A (1) SHALL BE PLACED SIMULTANEOUSLY.
- B. A 72 HOUR DELAY BETWEEN THE COMPLETION OF POUR 1 AND THE BEGINNING OF POUR 2 SHALL BE OBSERVED.
- C. THE POURING SEQUENCE AND ANTICIPATED DURATION SHALL BE SUBMITTED TO THE ENGINEER WITH THE PROPOSED MIX DESIGN FOR APPROVAL.

ALTERNATE 2: SINGLE POUR

- A. CASTING SHALL BEGIN AT ABUTMENT 2 AND PROGRESS TOWARD ABUTMENT 1.
- B. WEATHER AND TEMPERATURE LIMITATIONS NOTED IN STANDARD SPECIFICATION SECTION 501.07 APPLY.
- C. THE POURING SEQUENCE AND ANTICIPATED DURATION SHALL BE SUBMITTED TO THE ENGINEER WITH THE PROPOSED MIX DESIGN FOR APPROVAL.

BRIDGE 6N SUPERSTRUCTURE PLAN 1 OF 3

SCALE: 1/8" = 1'-0"

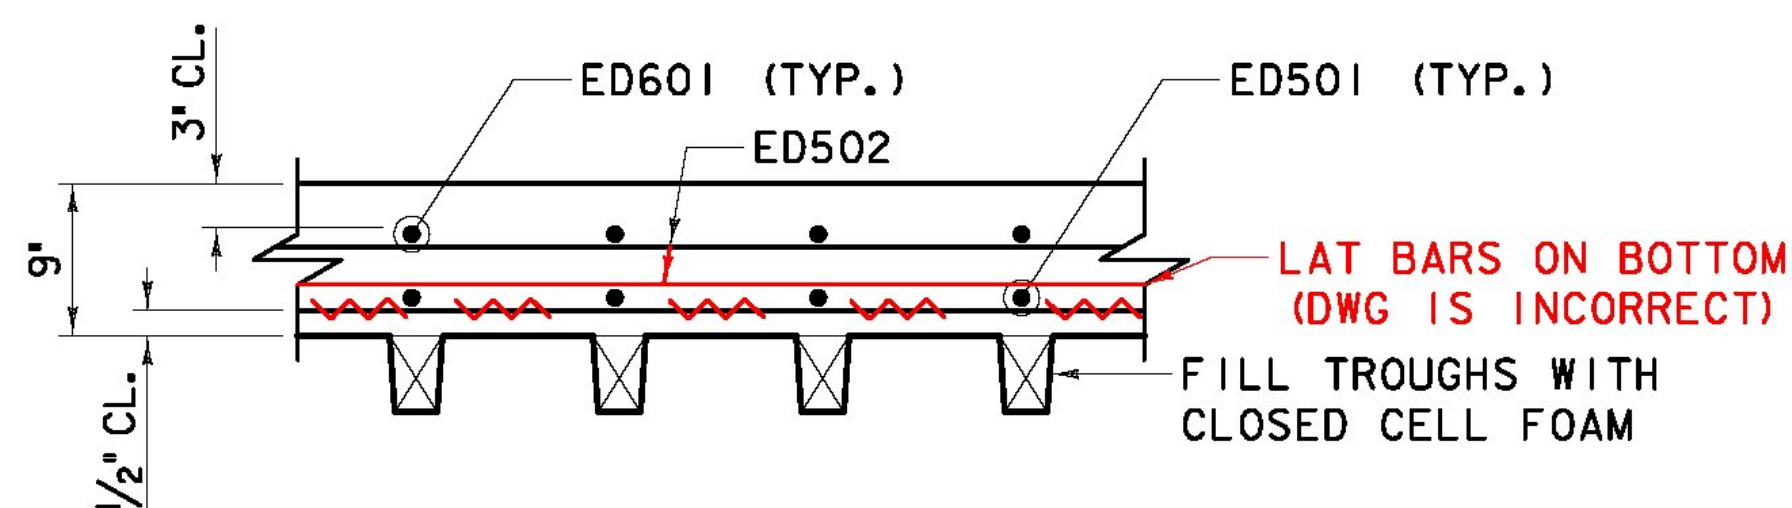

STAY-IN-PLACE FORM DETAIL

SCALE: 1/2" = 1'-0"

NOTES:

- 1. SEE "ZB-100-BR6-417" FOR BARRIER REINFORCEMENT.
- 2. SEE "ZB-100-BR6-418" FOR END DIAPHRAGM (BACKWALL) REINFORCEMENT.
- 3. BARRIER LENGTHS AND ASSOCIATED REINFORCEMENT FOR BARRIERS ATTACHED TO THE APPROACH SLAB ARE BASED ON A 2 1/8" JOINT. SEE "ZB-100-BR6-419" FOR EXPANSION JOINT DETAILS.
- 4. TRANSVERSE DECK BARS LOCATED AT THE ENDS OF DECK AND ADJACENT TO CONSTRUCTION JOINTS SHALL BE SKEWED TO MATCH THE ORIENTATION OF THE ADJACENT JOINT.
- 5. SEE THE GENERAL NOTES SHEET, 'ZB-100-BR6-102', FOR ADDITIONAL NOTES.

AS BUILT RECORD PLANS

BECK & BELLUCCI, INC.

TYLIN INTERNATIONAL

PROJECT NAME: BRATTLEBORO

PROJECT NUMBER: IM 091-(K50)

FILE NAME: ZB-100-BR6-414.dgn
 PROJECT LEADER: Phillip E. Kendall P.E.
 DESIGNED BY: Josh Olund P.E.
 SUPERSTRUCTURE PLAN 1 OF 3

PLOT DATE: 5/15/2013
 DRAWN BY: S. A. Morgan
 CHECKED BY: J. E. Krajewski
 SHEET ZB-100-BR6-414