


FRAMING PLAN - BRIDGE 6S

SCALE: 1/32" = 1'-0"

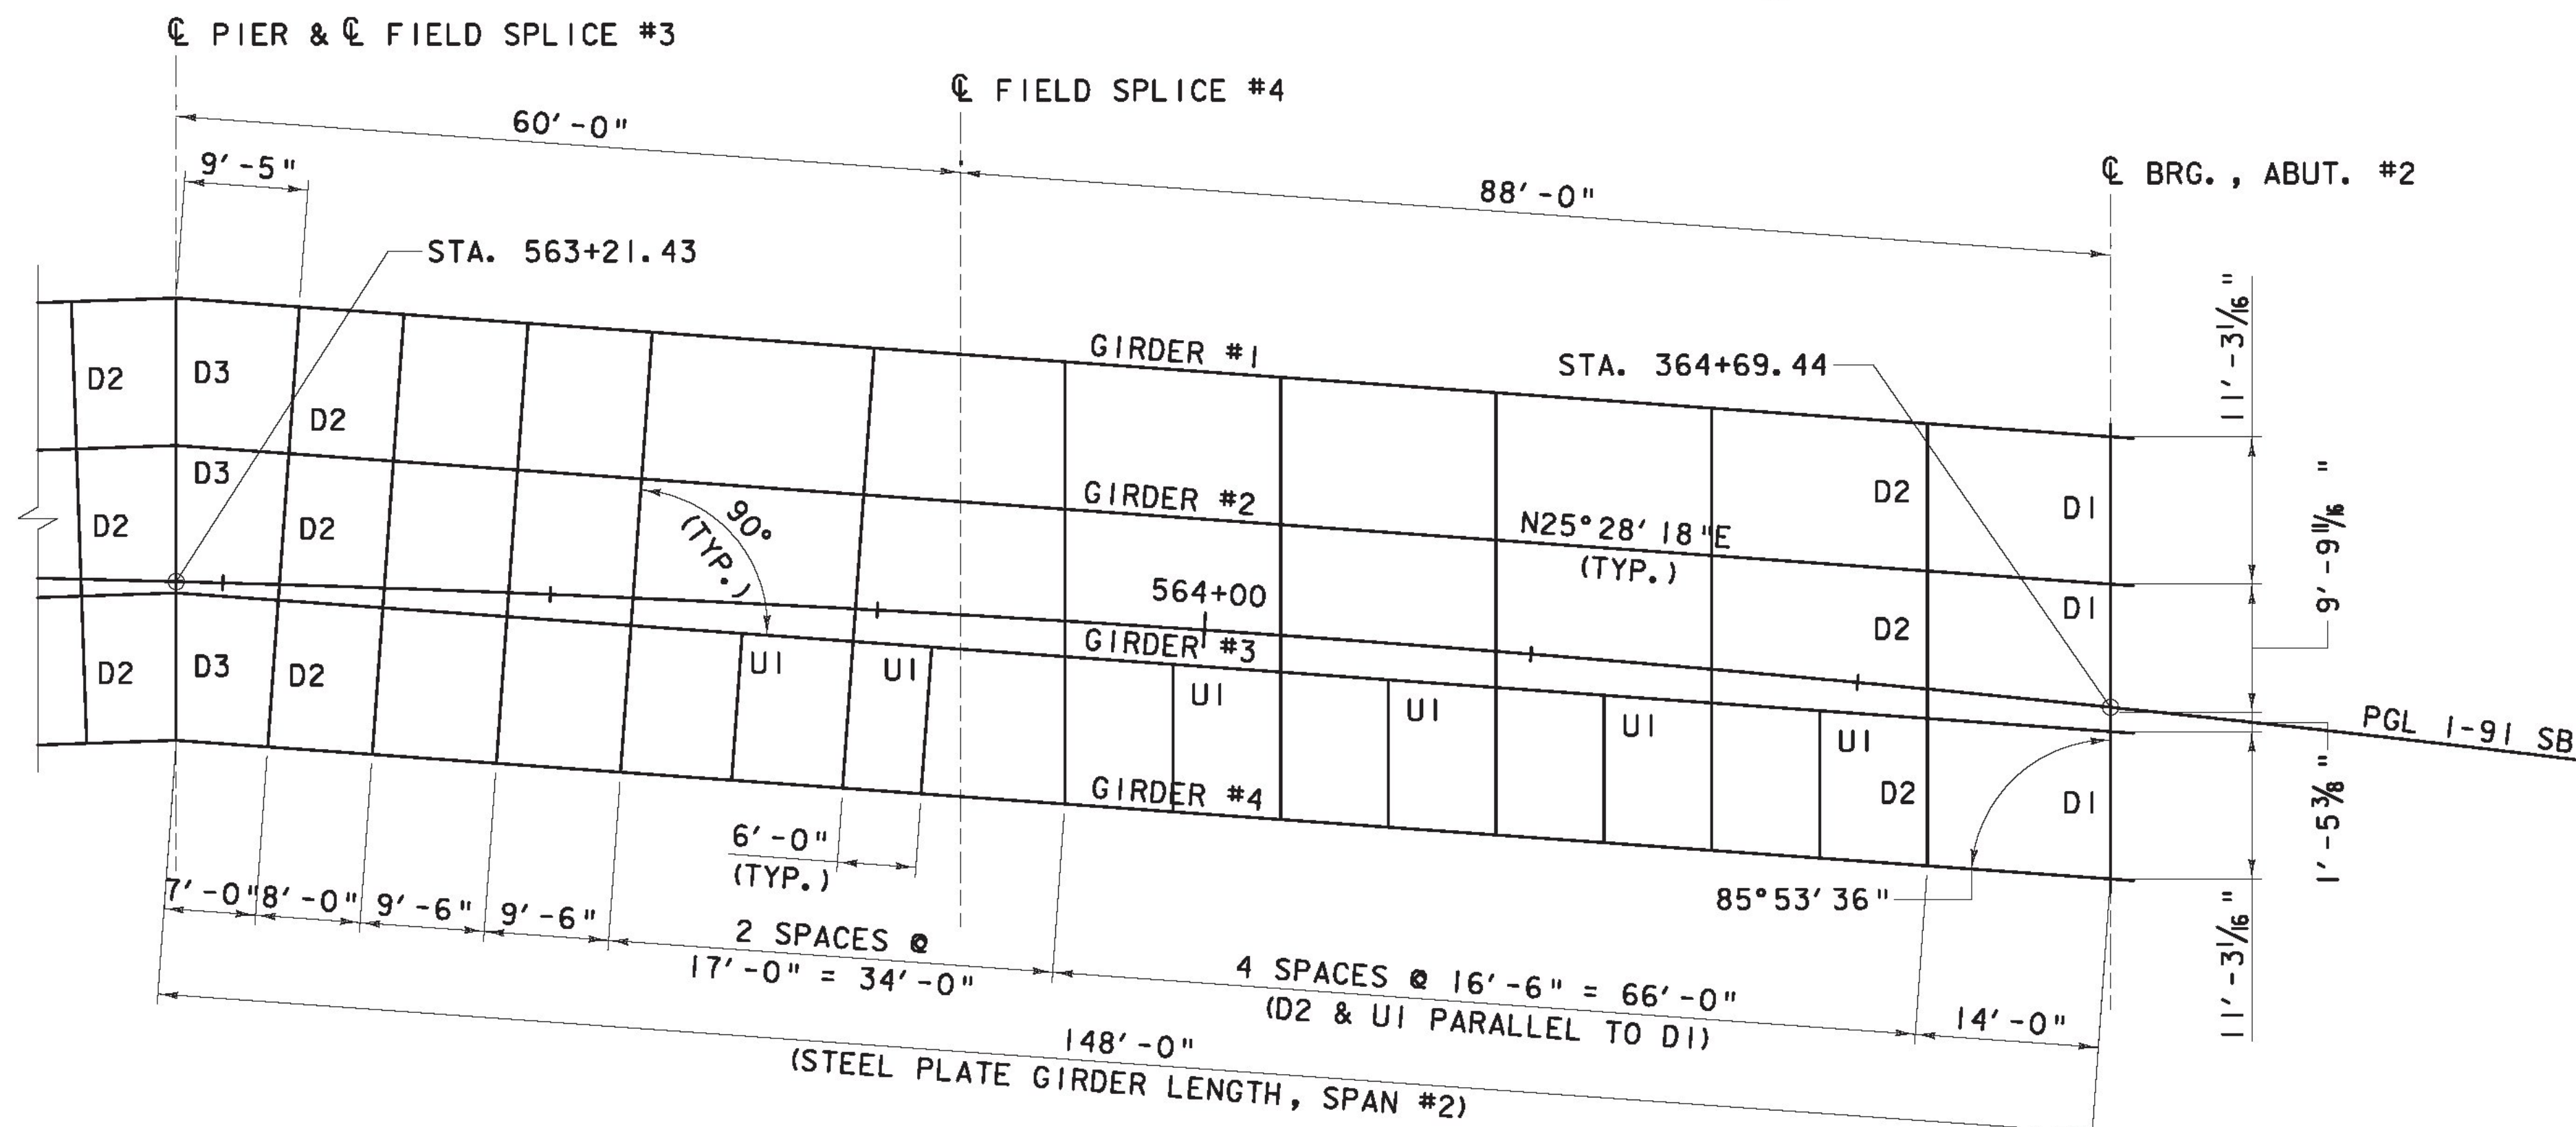

FRAMING PLAN - BRIDGE 6S

SCALE: 1/32" = 1'-0"

AS BUILT
RECORD PLANS

RFC PLANS - WORK PACKAGE #1A
BRIDGE 6N & S STRUCTURAL STEEL & BEARINGS
JULY 29, 2011

BECK & BELLUCCI, INC.

TYLIN INTERNATIONAL

PROJECT NAME: BRATTLEBORO

PROJECT NUMBER: IM 09I-(K5)

FILE NAME: ZB-100-BR6-45I.dgn
PROJECT LEADER: Brian W. Clogston P.E.
DESIGNED BY: Joseph Krajewski P.E.
FRAMING PLAN - BR6S

PLOT DATE: 7/26/2011
DRAWN BY: S. A. Morgan
CHECKED BY: J. E. Krajewski
SHEET ZB-100-BR6-45I