




338+25 STA. 338+25
BEGIN MILL AND OVERLAY (RT)
MATCH EXISTING

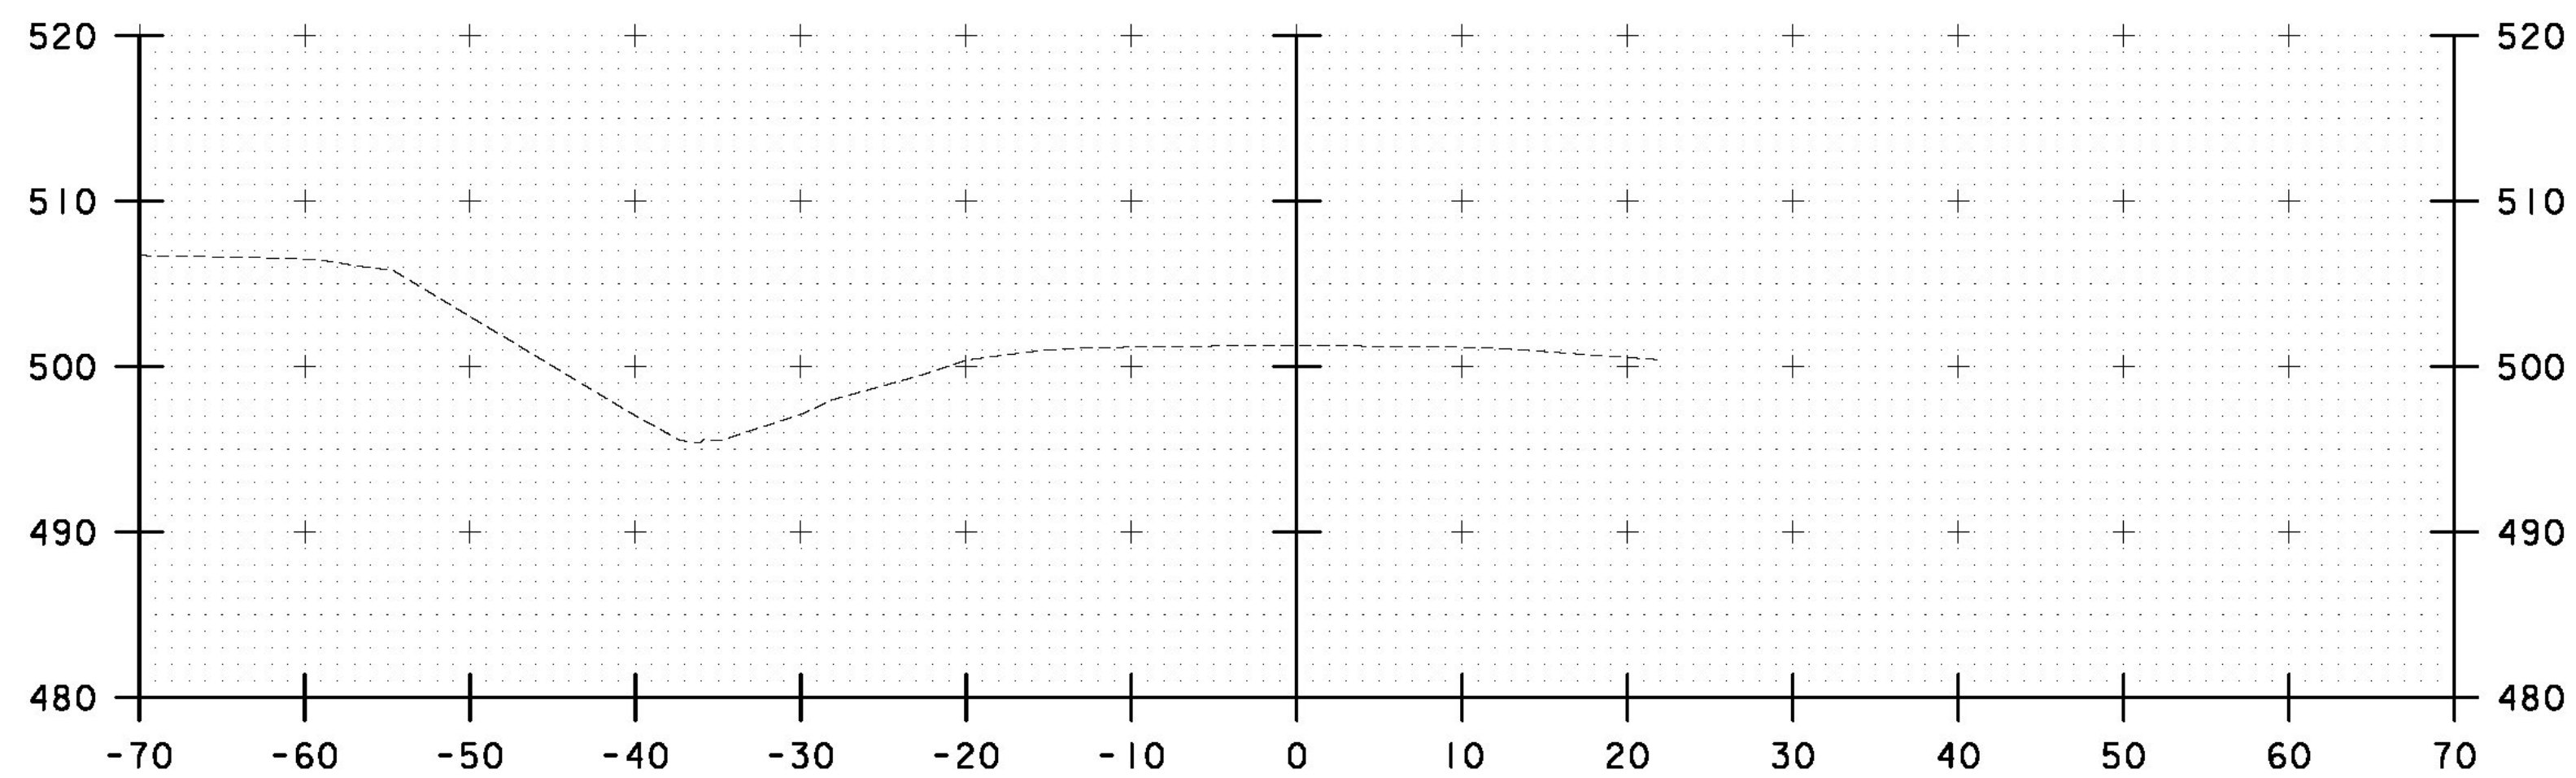

338+00


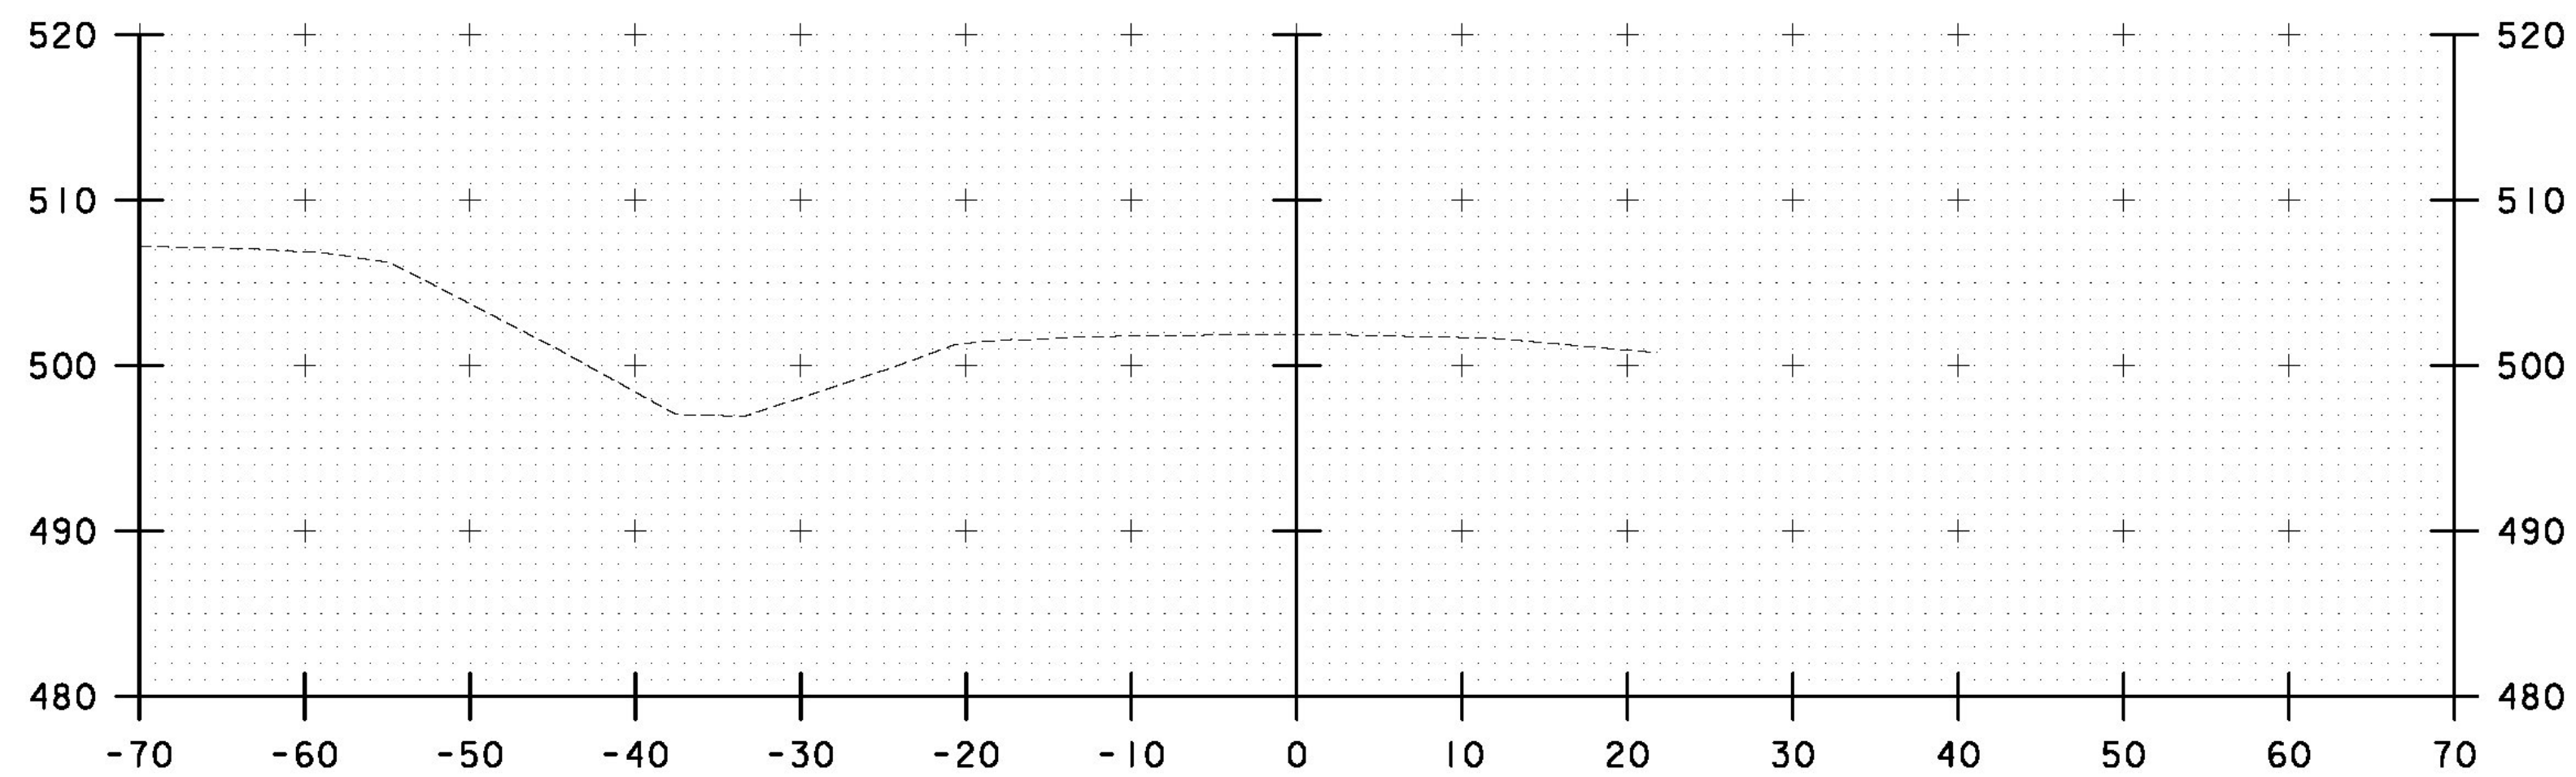


337+50

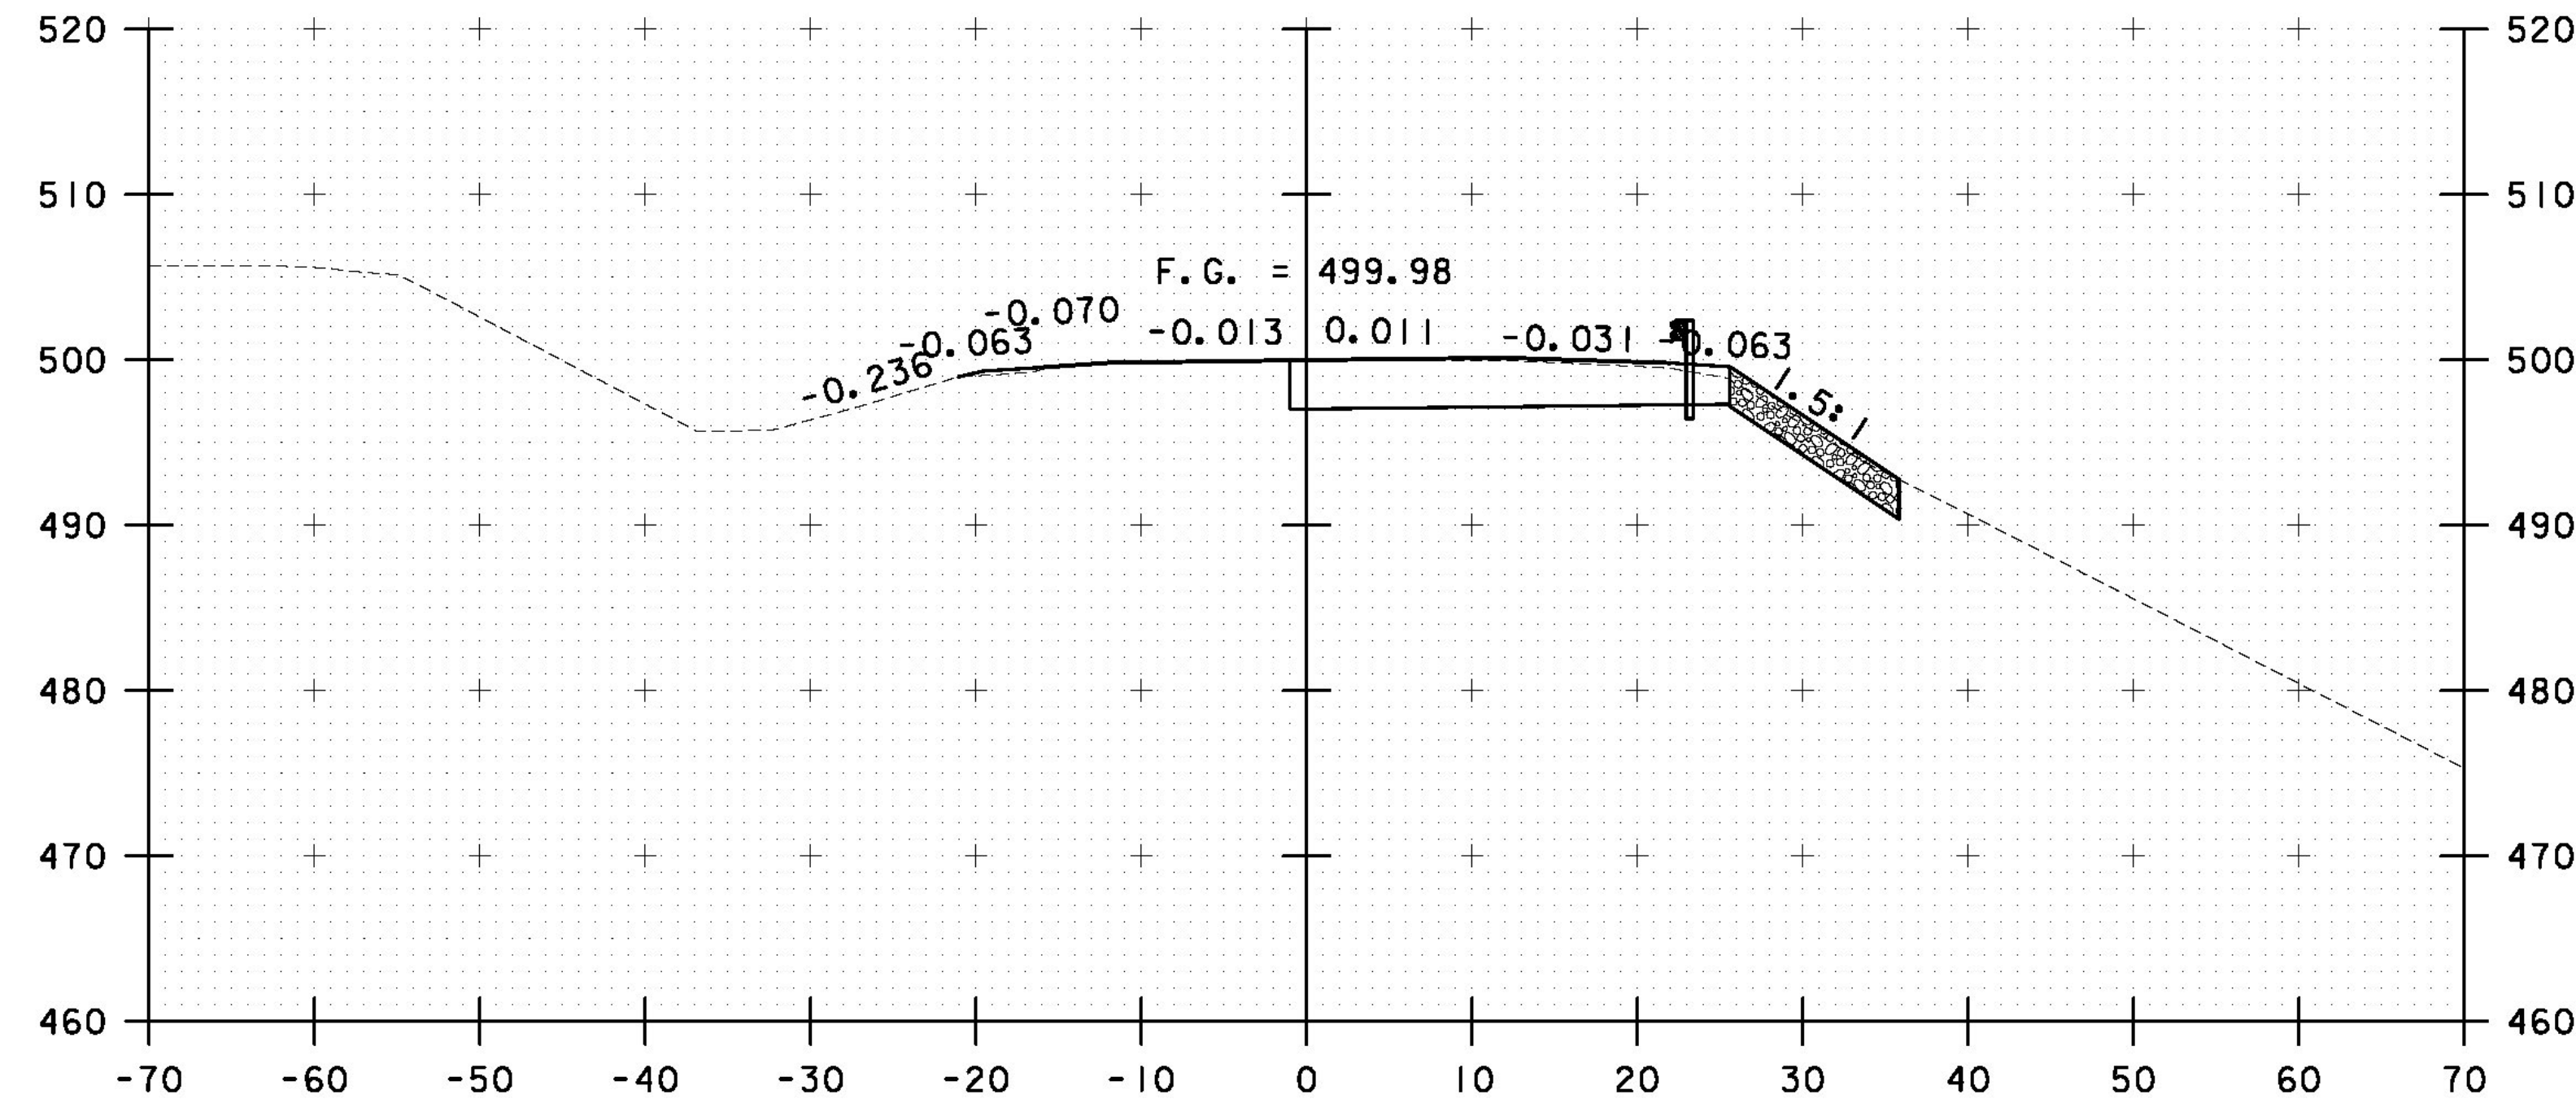

338+75 STA. 338+75
BEGIN MILL AND
OVERLAY (LT)

339+00 STA. 338+75
END MILL AND OVERLAY (RT)
BEGIN FULL DEPTH CONSTRUCTION (RT)

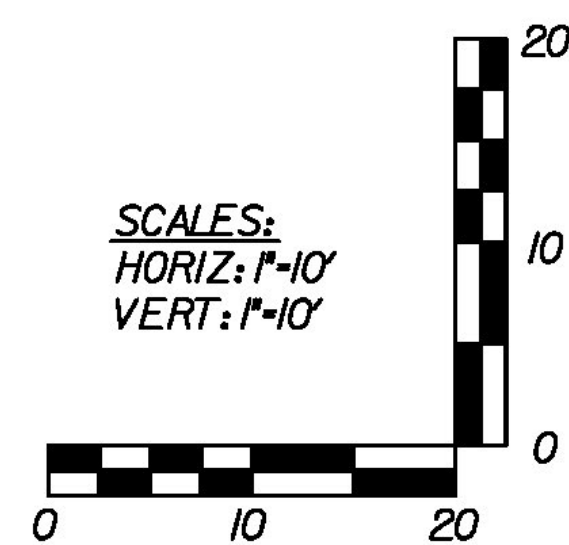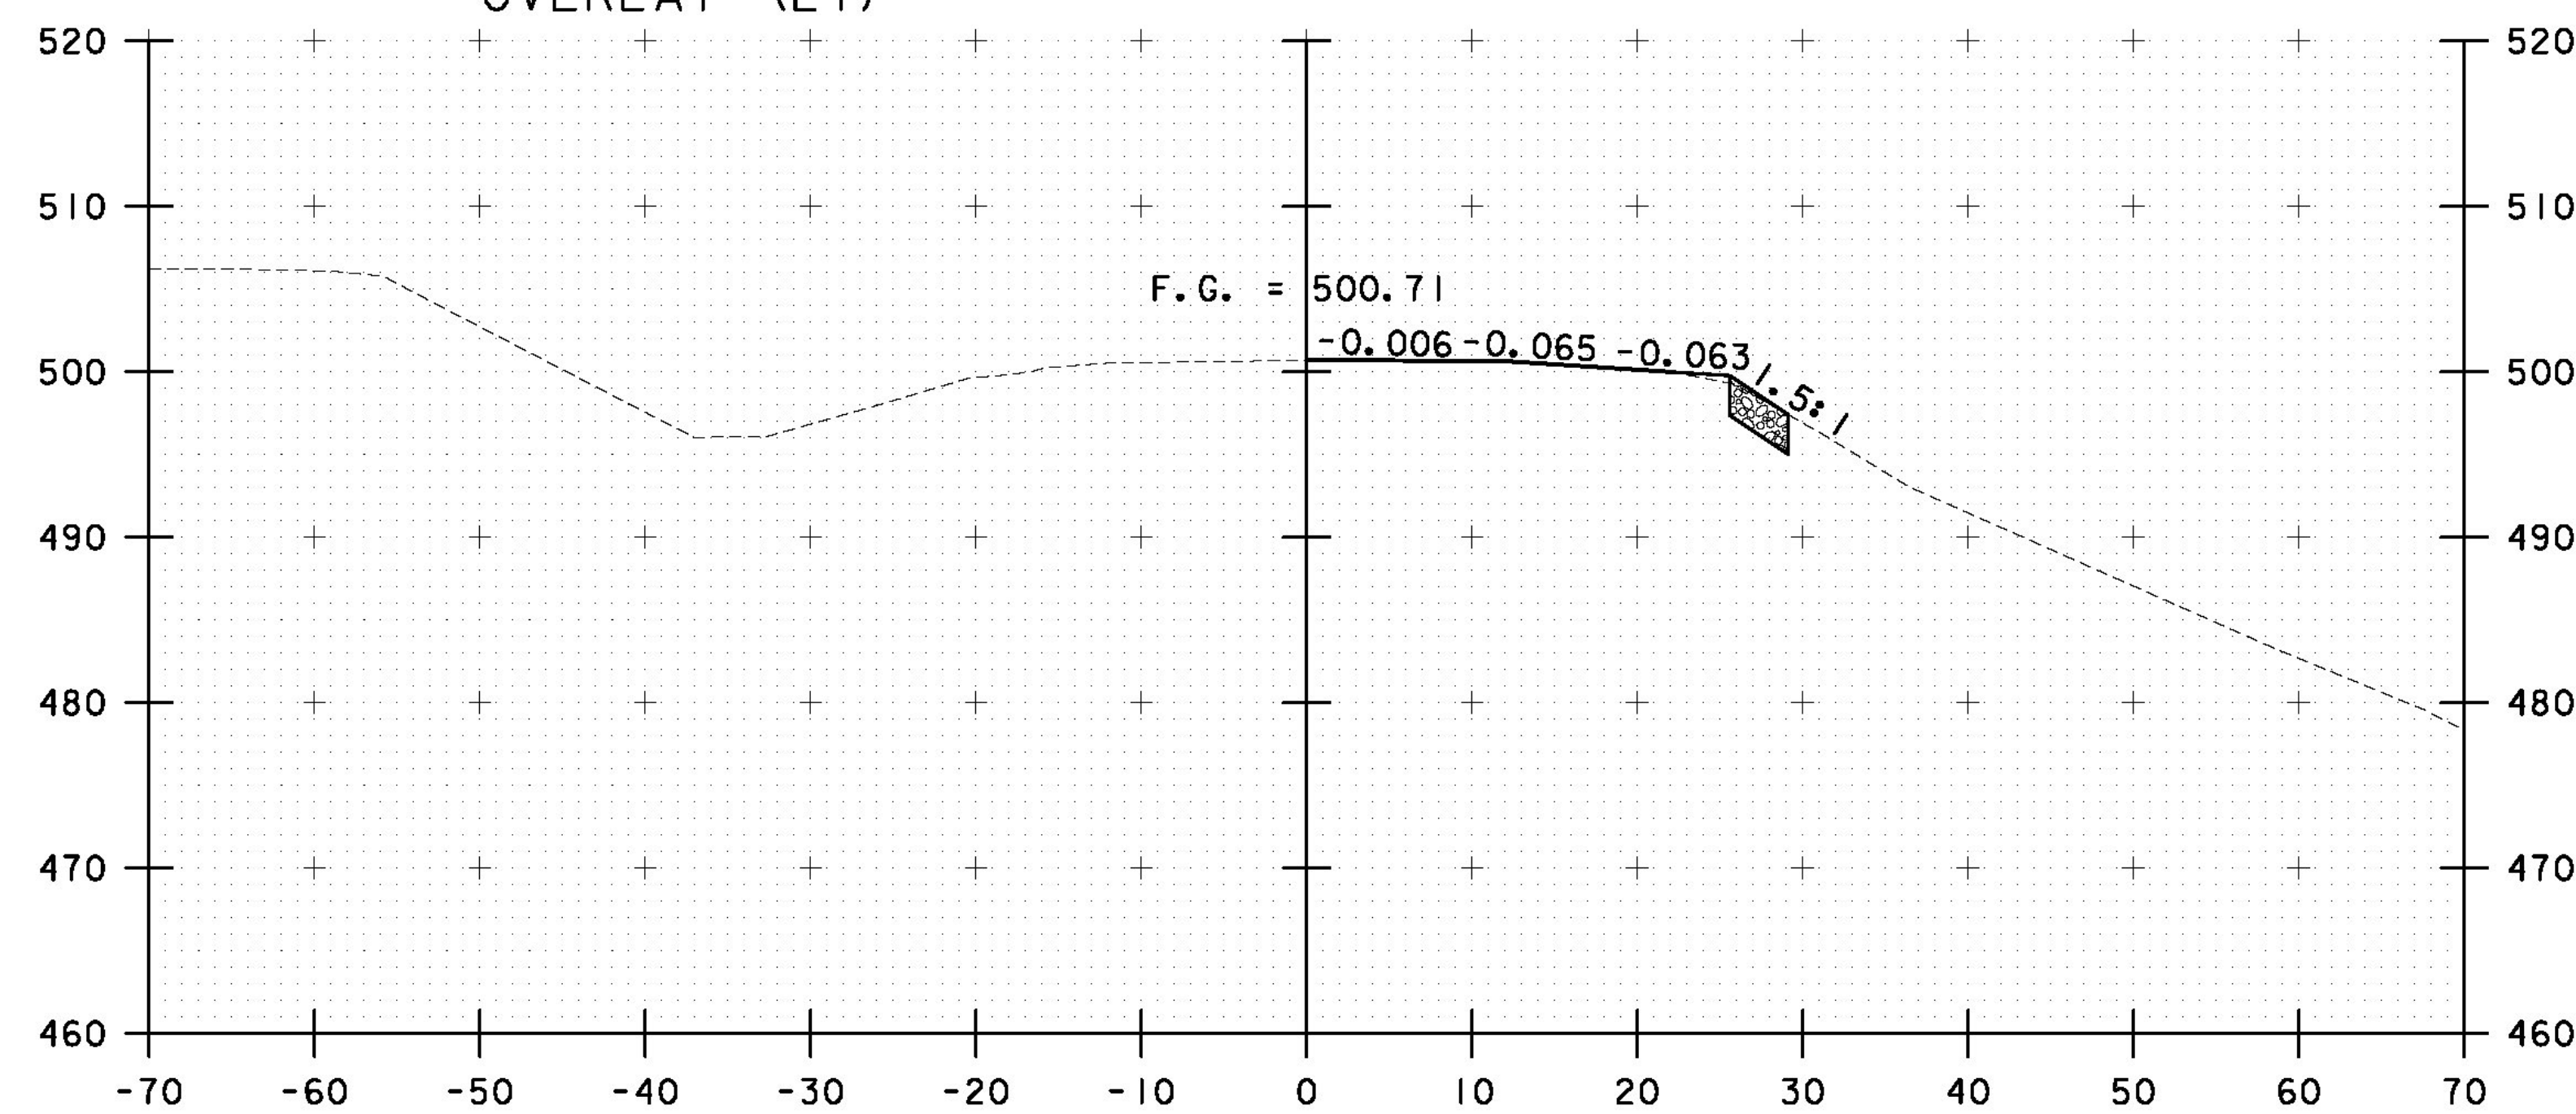

**AS BUILT
RECORD PLANS**

338+50

RFC PLANS - WORK PACKAGE #6
NB ROADWAY APPROACH
NOVEMBER 28, 2011

BECK & BELLUCCI, INC.

TYLIN INTERNATIONAL

STA. 337+50 TO STA. 339+00

PROJECT NAME: BRATTLEBORO

PROJECT NUMBER: 1M 091-(150)

FILE NAME: HW-RA-DGN-900.dgn

PROJECT LEADER: Phillip E. Kendall II, P.E.

DESIGNED BY: Phillip E. Kendall P.E.

CROSS SECTIONS 1 OF 8

PLOT DATE: 11/30/2011

DRAWN BY: A. R. Greenlaw

CHECKED BY: D. Bryant, P.E.

SHEET HW-RA-DGN-901