
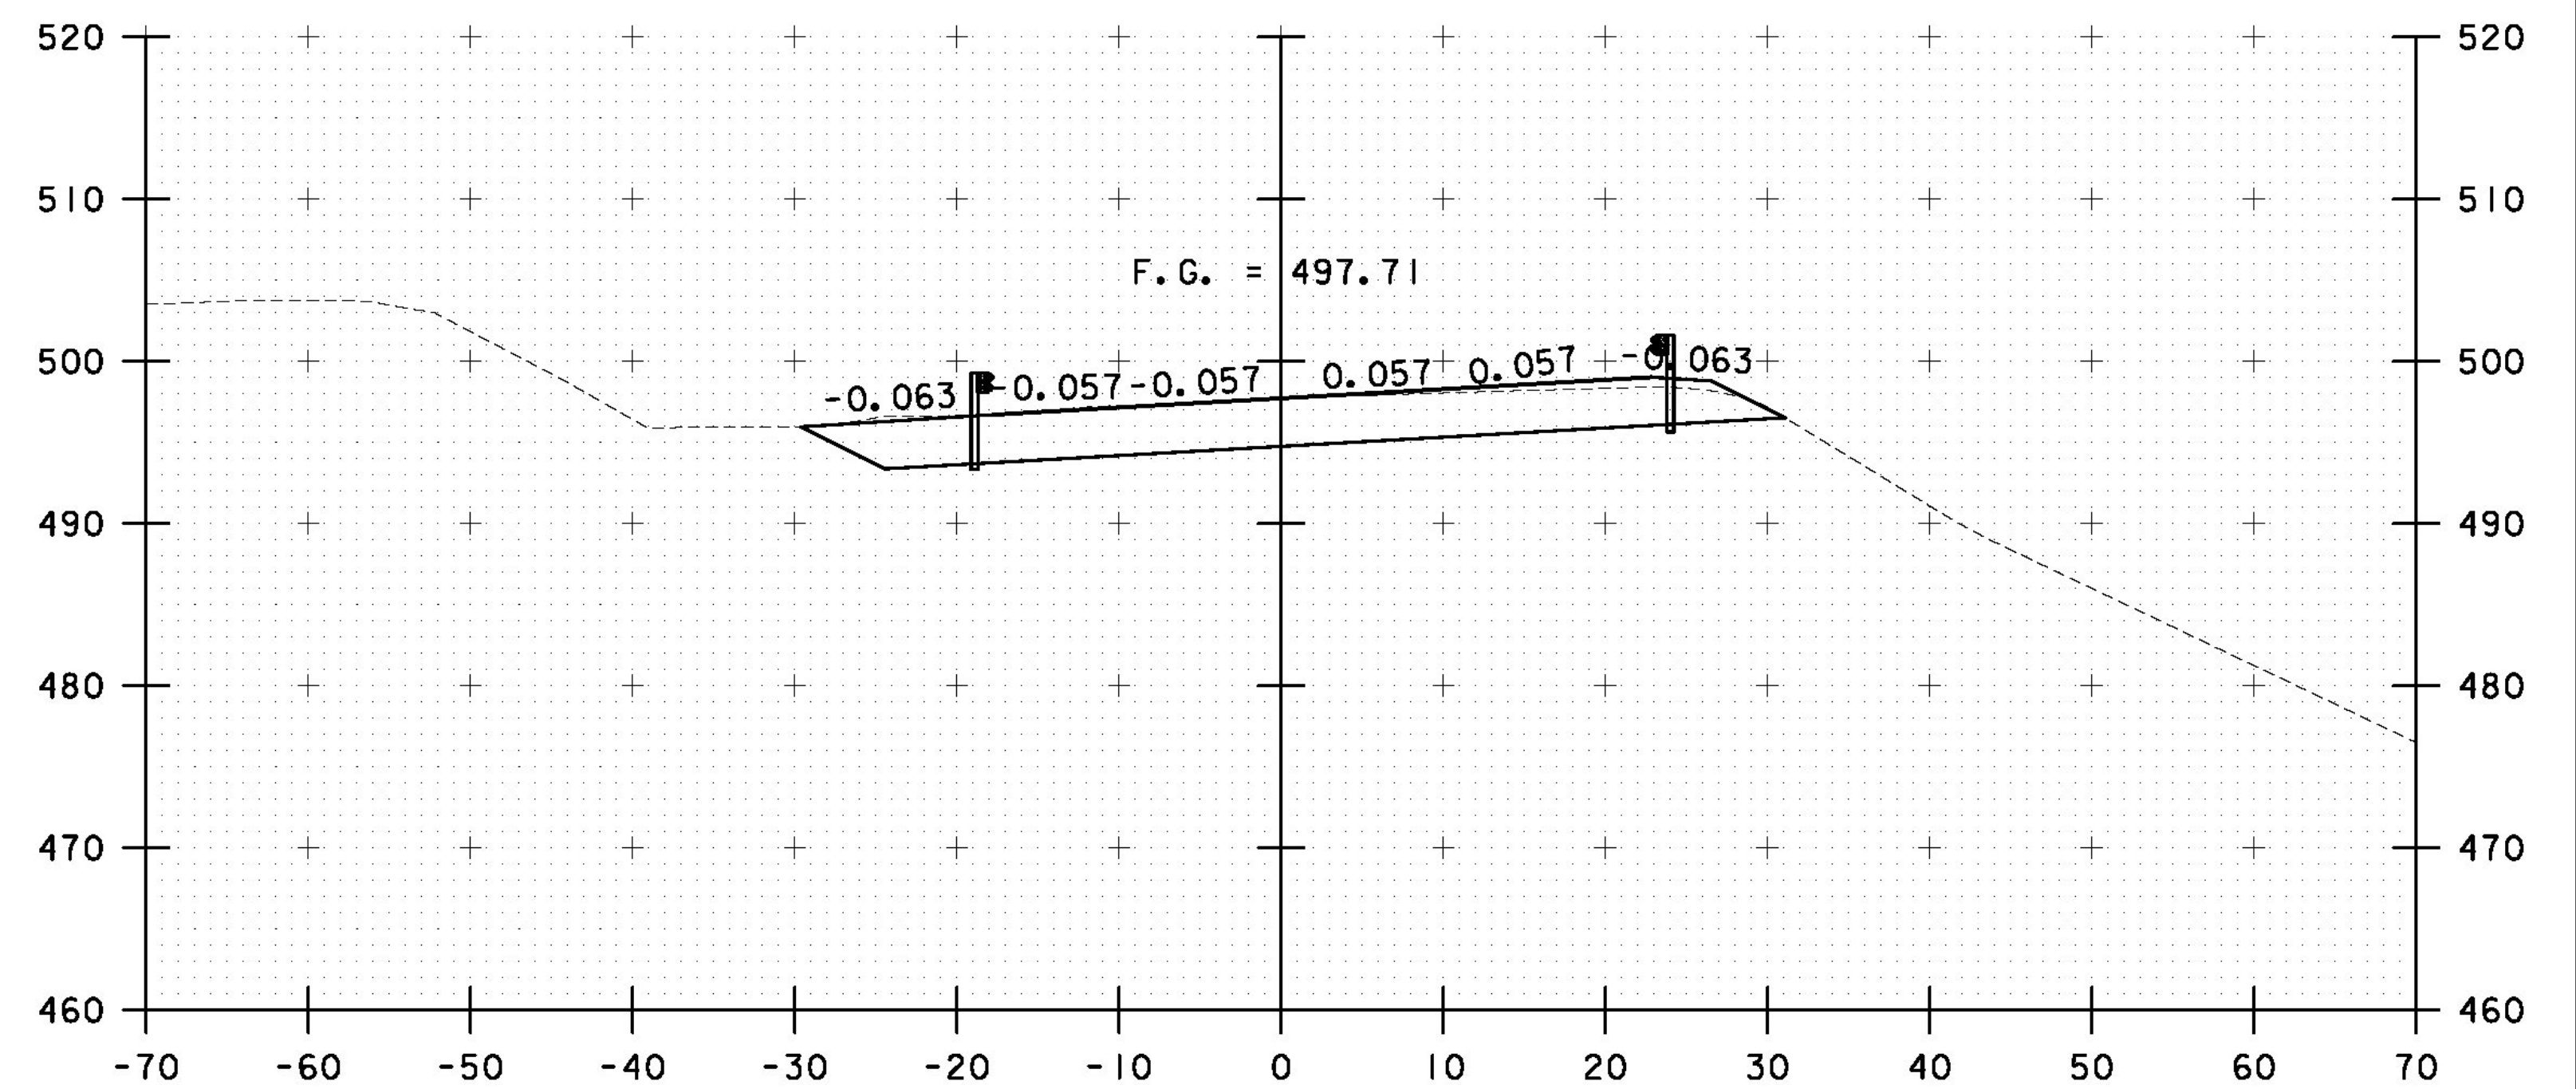


340+00


340+50

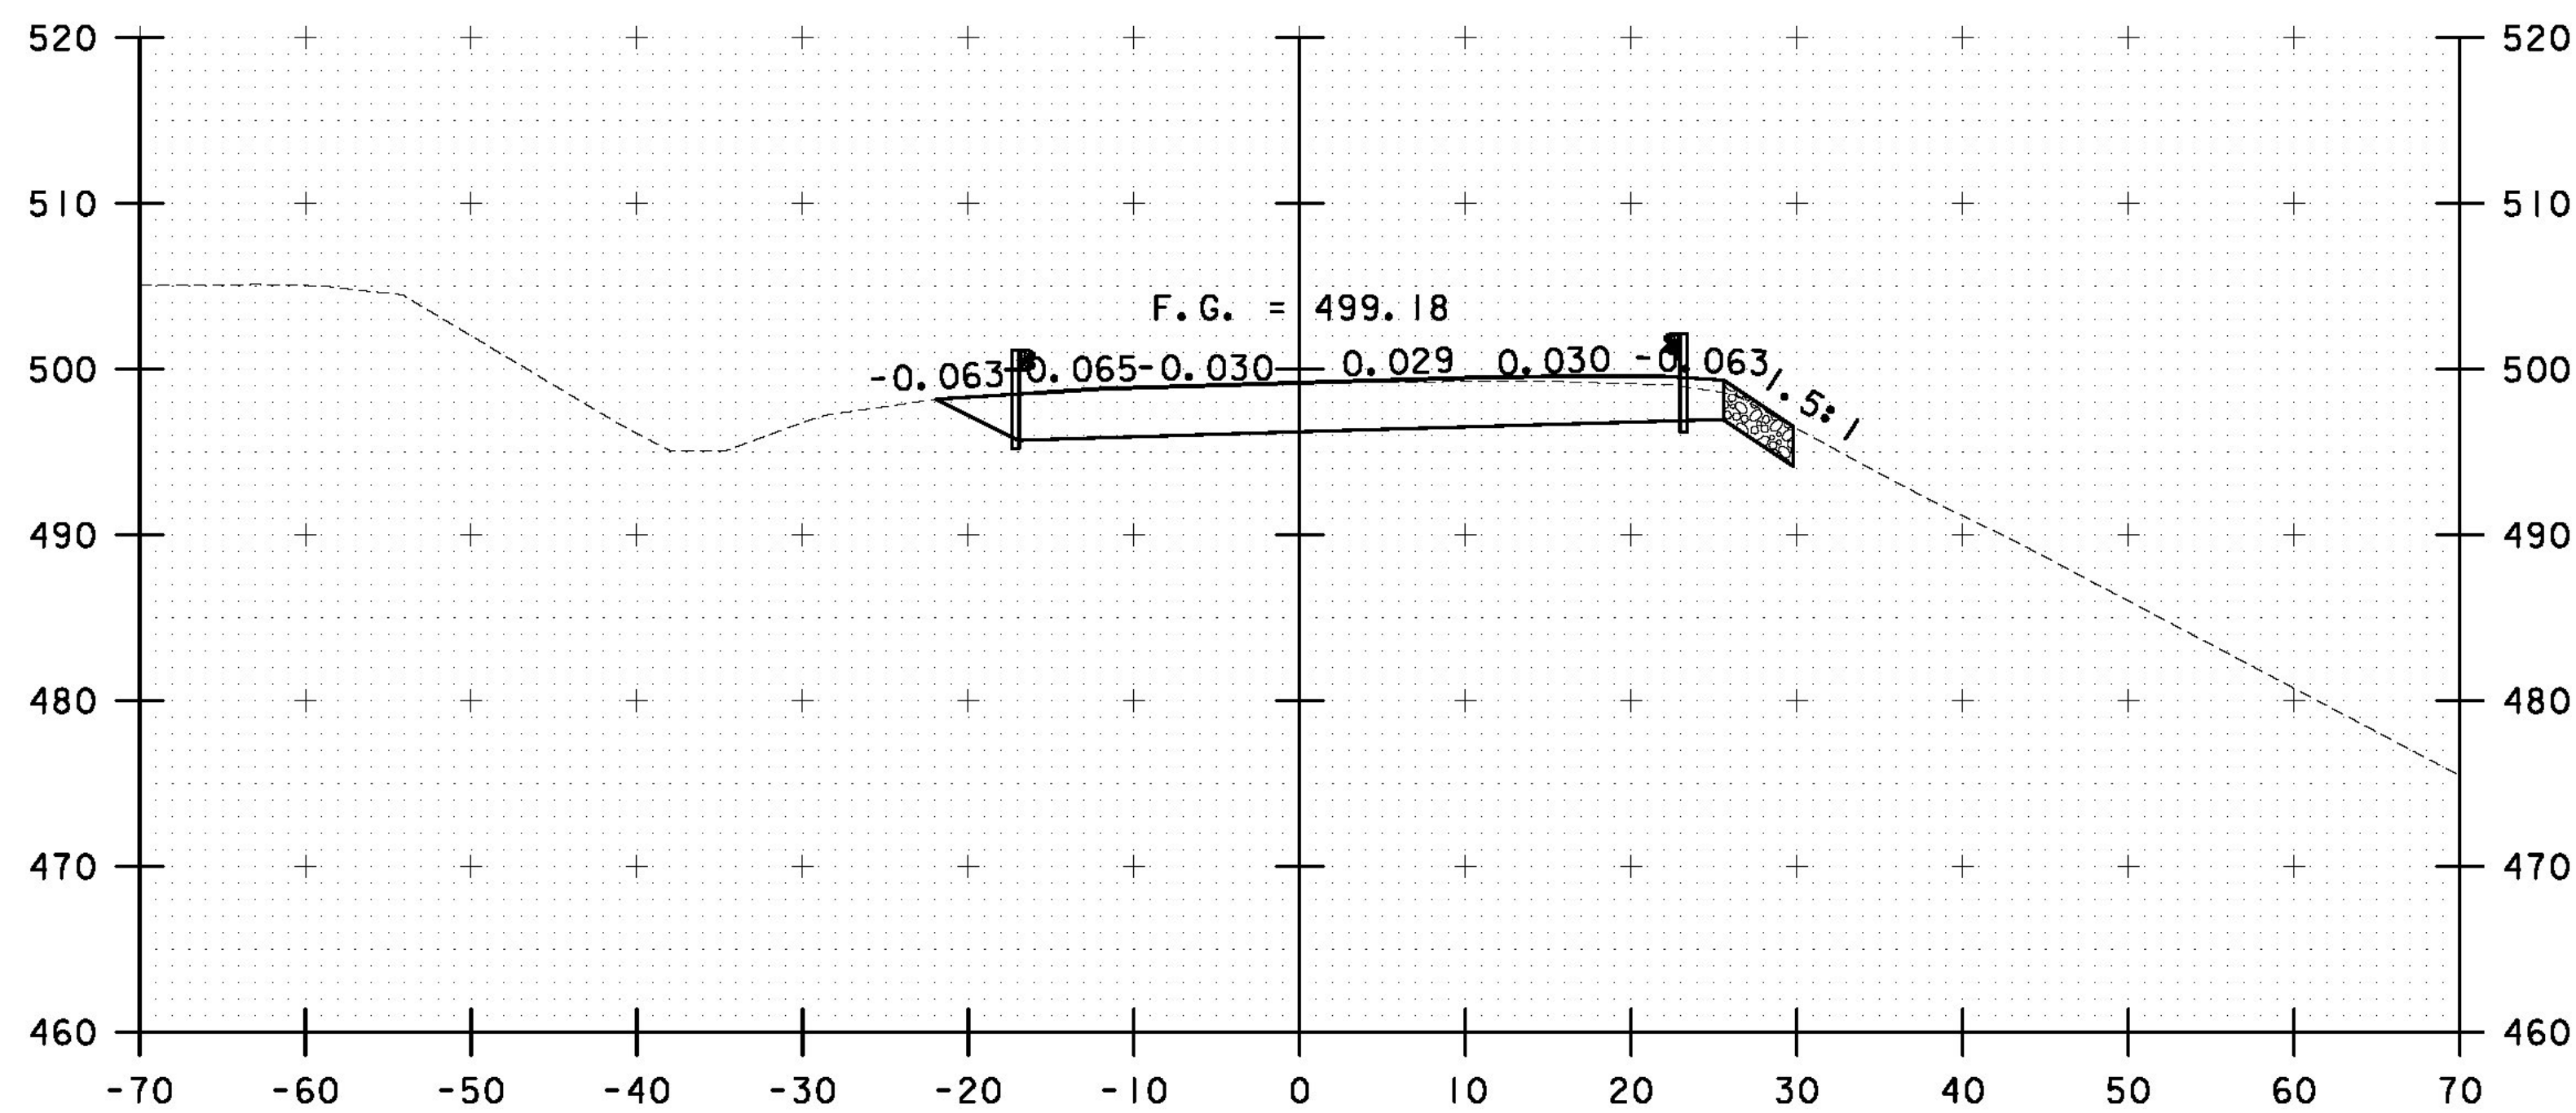

STA. 339+25
END MILL AND OVERLAY (LT)
BEGIN FULL DEPTH CONSTRUCTION (LT)

339+50

340+30
STA. 340+25 END MILL AND OVERLAY
BEGIN FULL DEPTH CONSTRUCTION

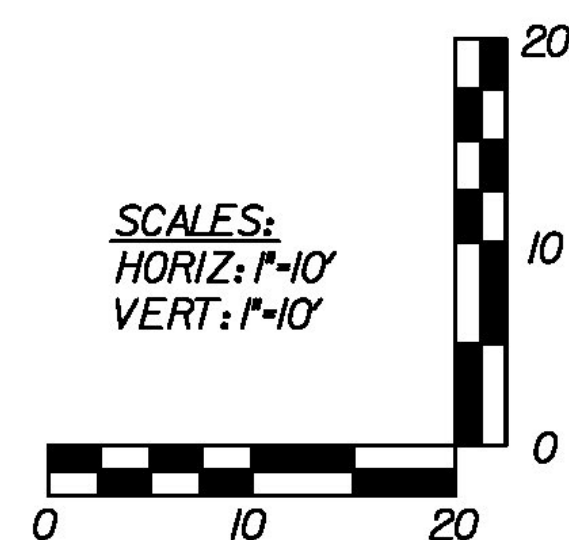

**AS BUILT
RECORD PLANS**

RFC PLANS - WORK PACKAGE #6
NB ROADWAY APPROACH
NOVEMBER 28, 2011

BECK & BELLUCCI, INC.

TYLIN INTERNATIONAL

STA. 339+50 TO STA. 340+50

PROJECT NAME: BRATTLEBORO

PROJECT NUMBER: 1M 091-(150)

FILE NAME: HW-RA-DGN-900.dgn
PROJECT LEADER: Phillip E. Kendall II, P.E.
DESIGNED BY: Phillip E. Kendall P.E.
CROSS SECTIONS 2 OF 8

PLOT DATE: 11/30/2011
DRAWN BY: A. R. Greenlaw
CHECKED BY: D. Bryant, P.E.
SHEET HW-RA-DGN-902