




341+50

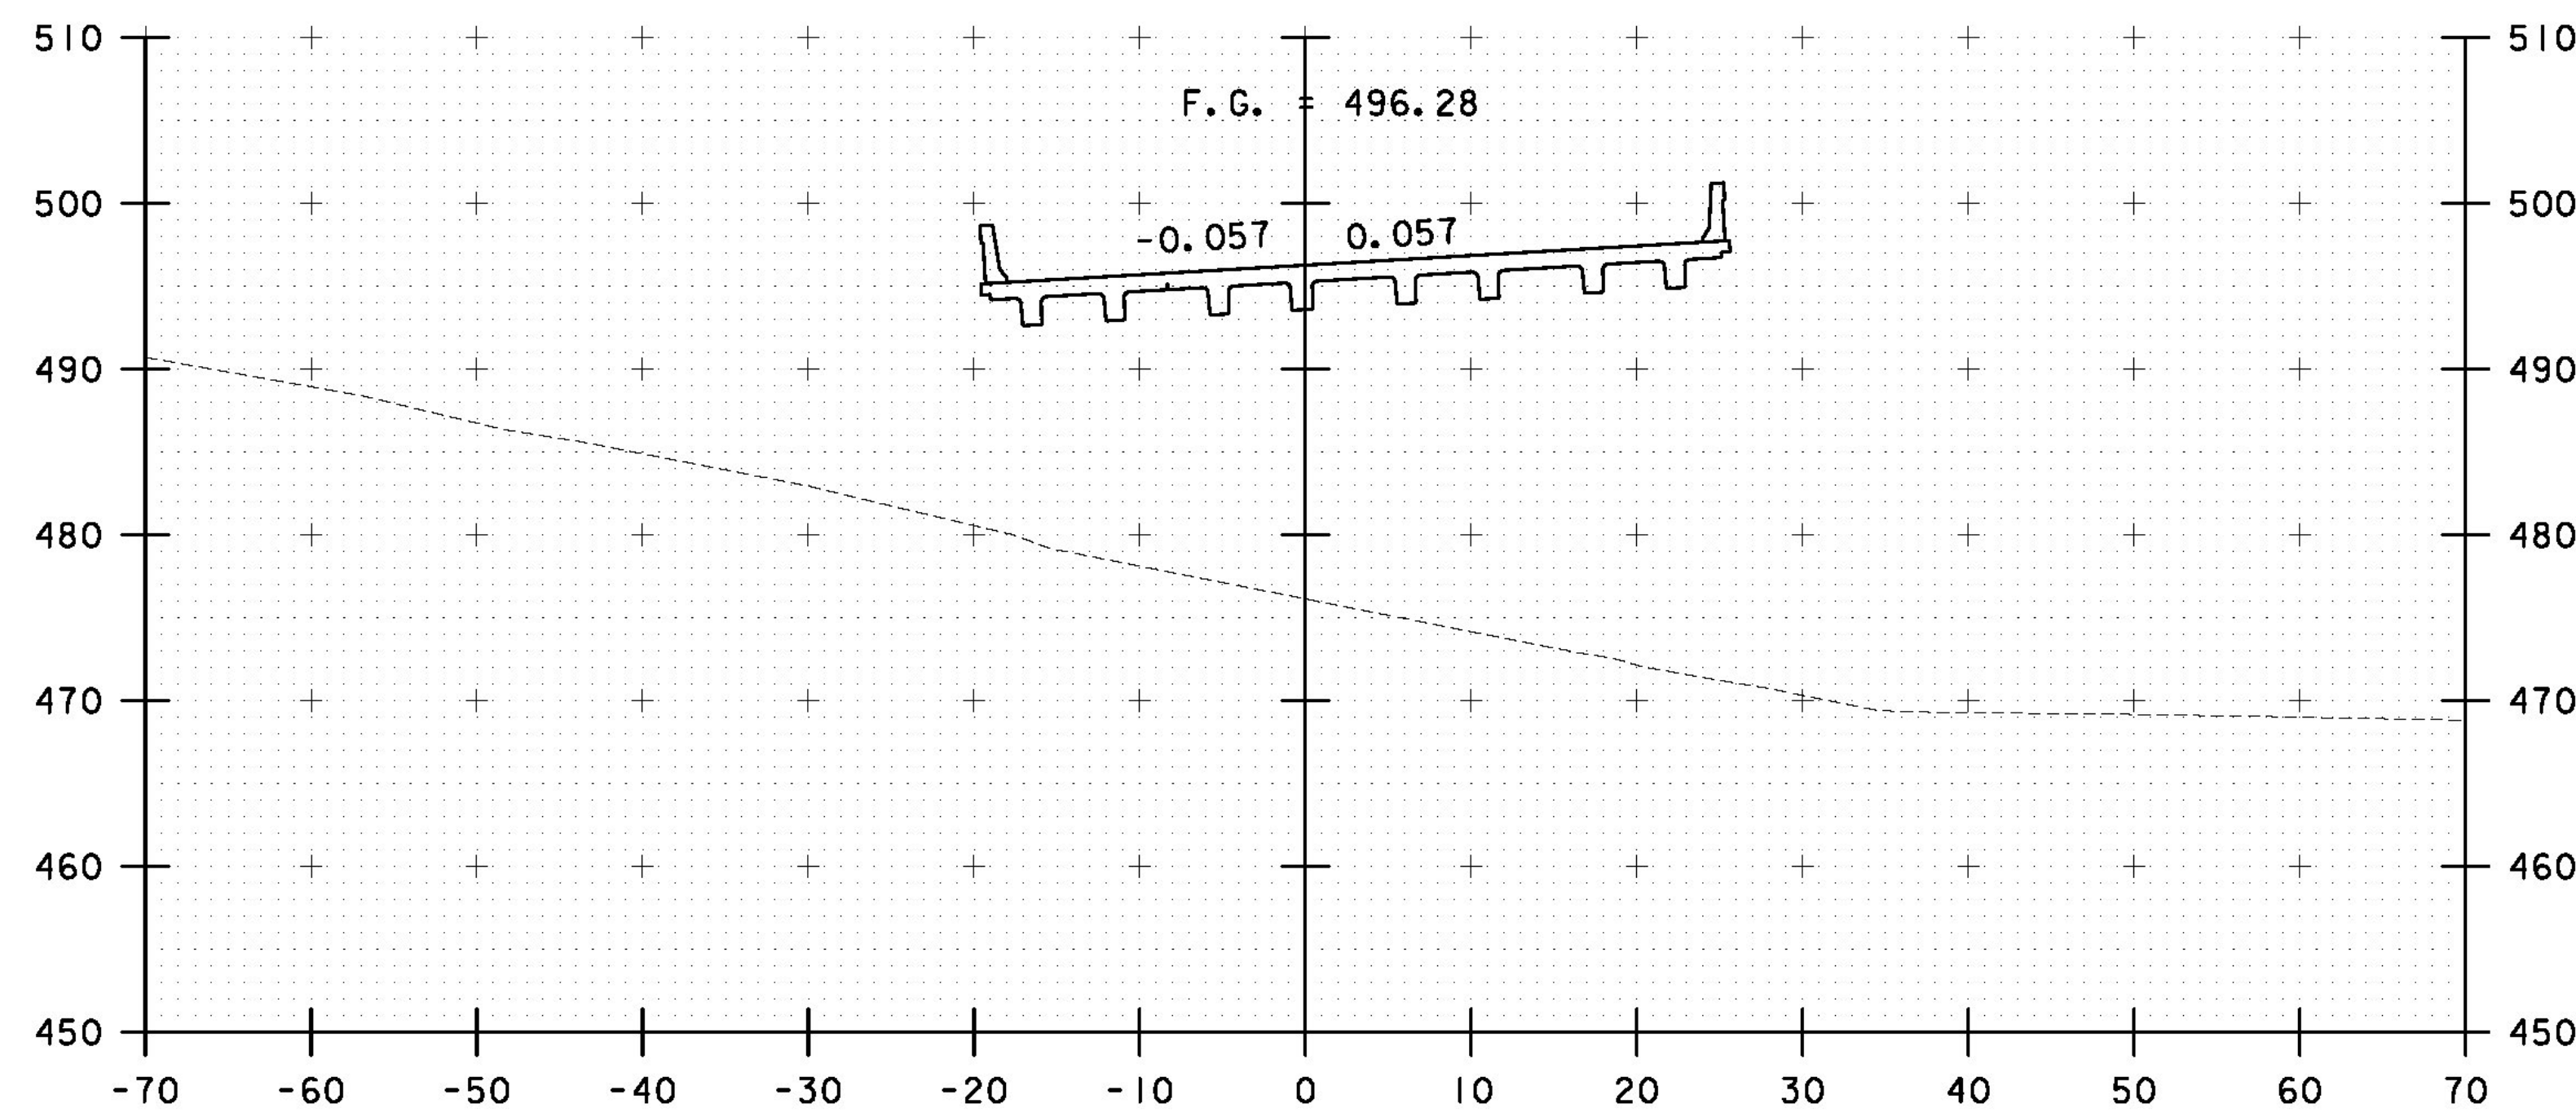


341+00

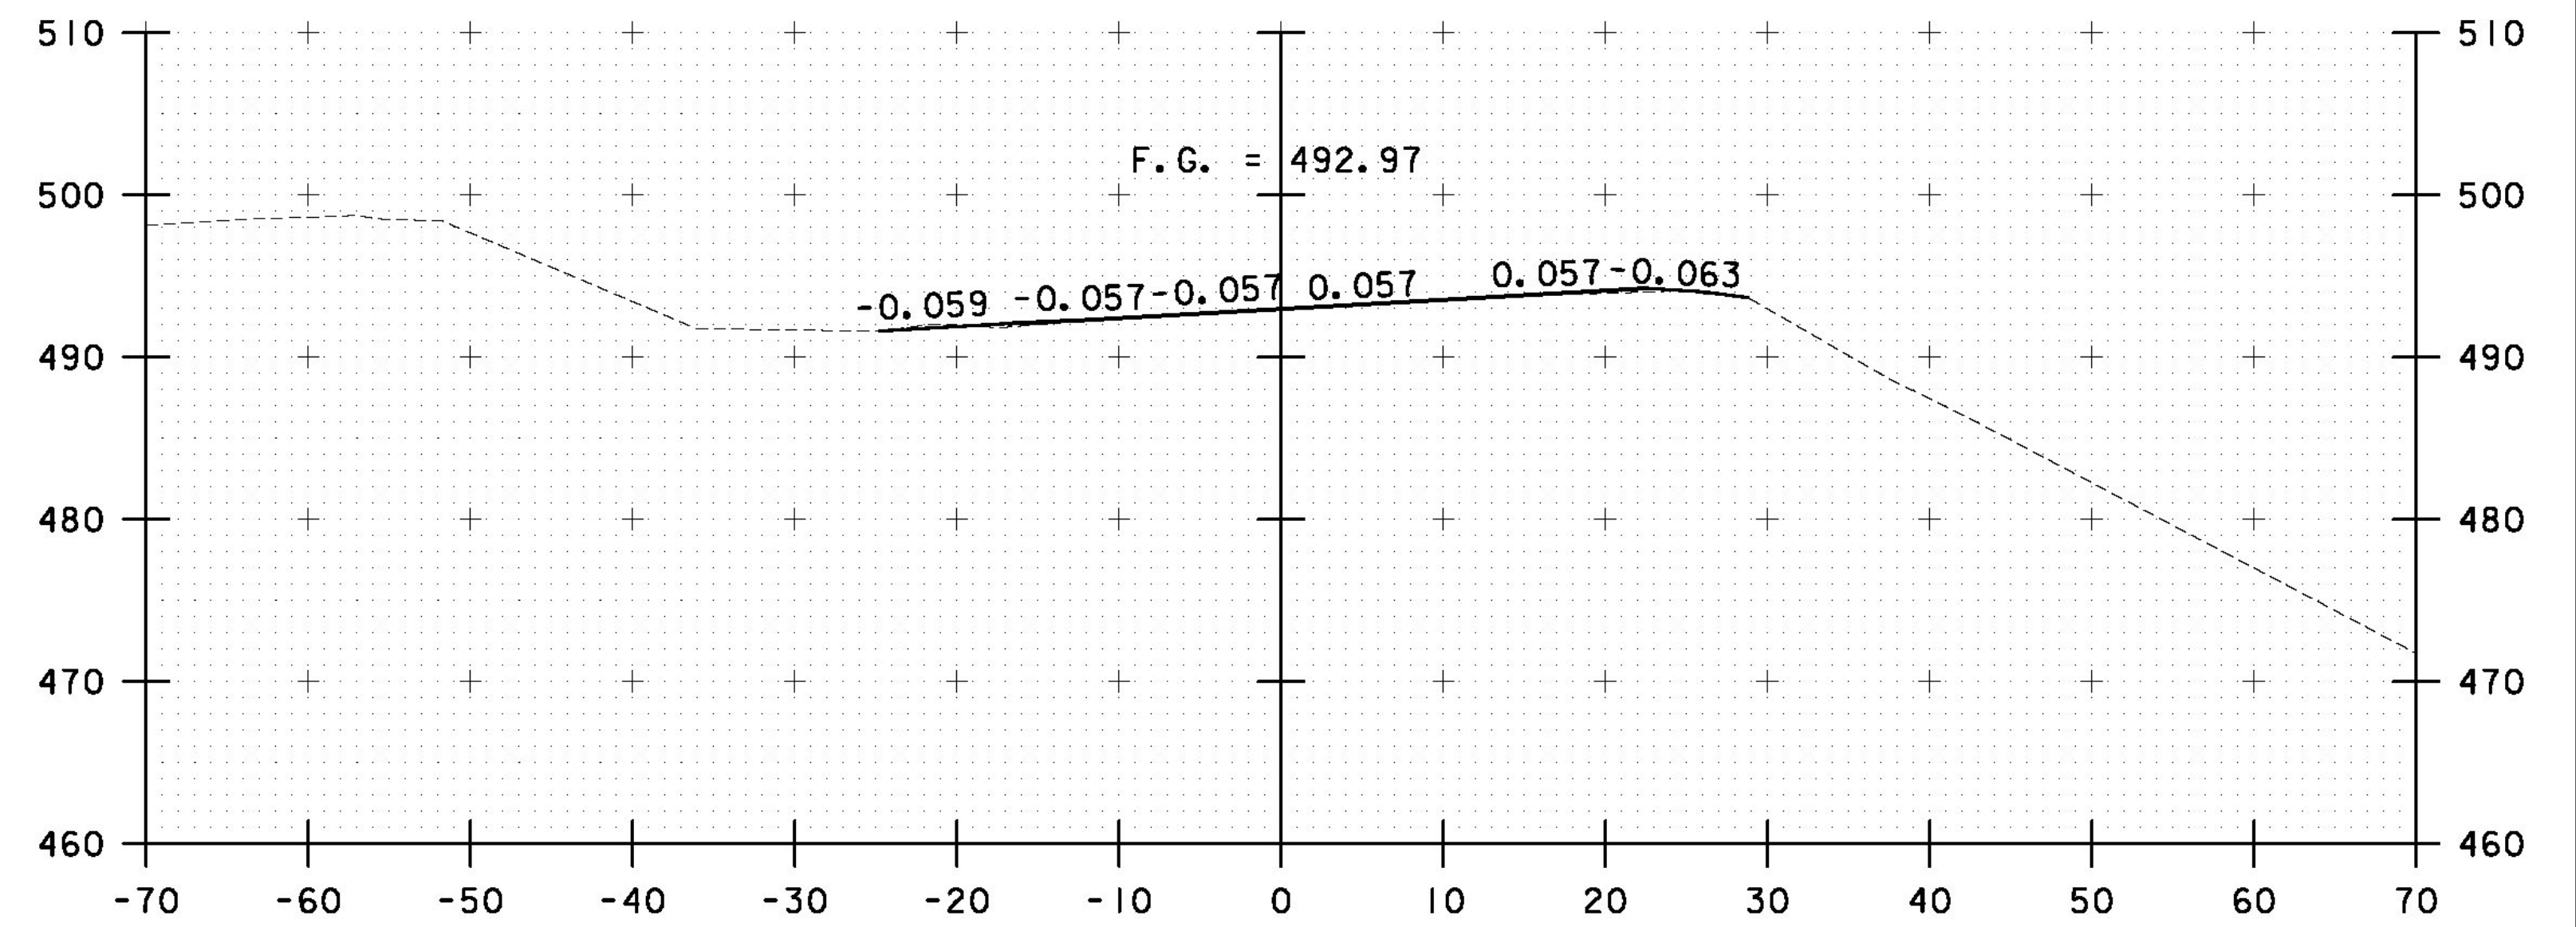

342+40

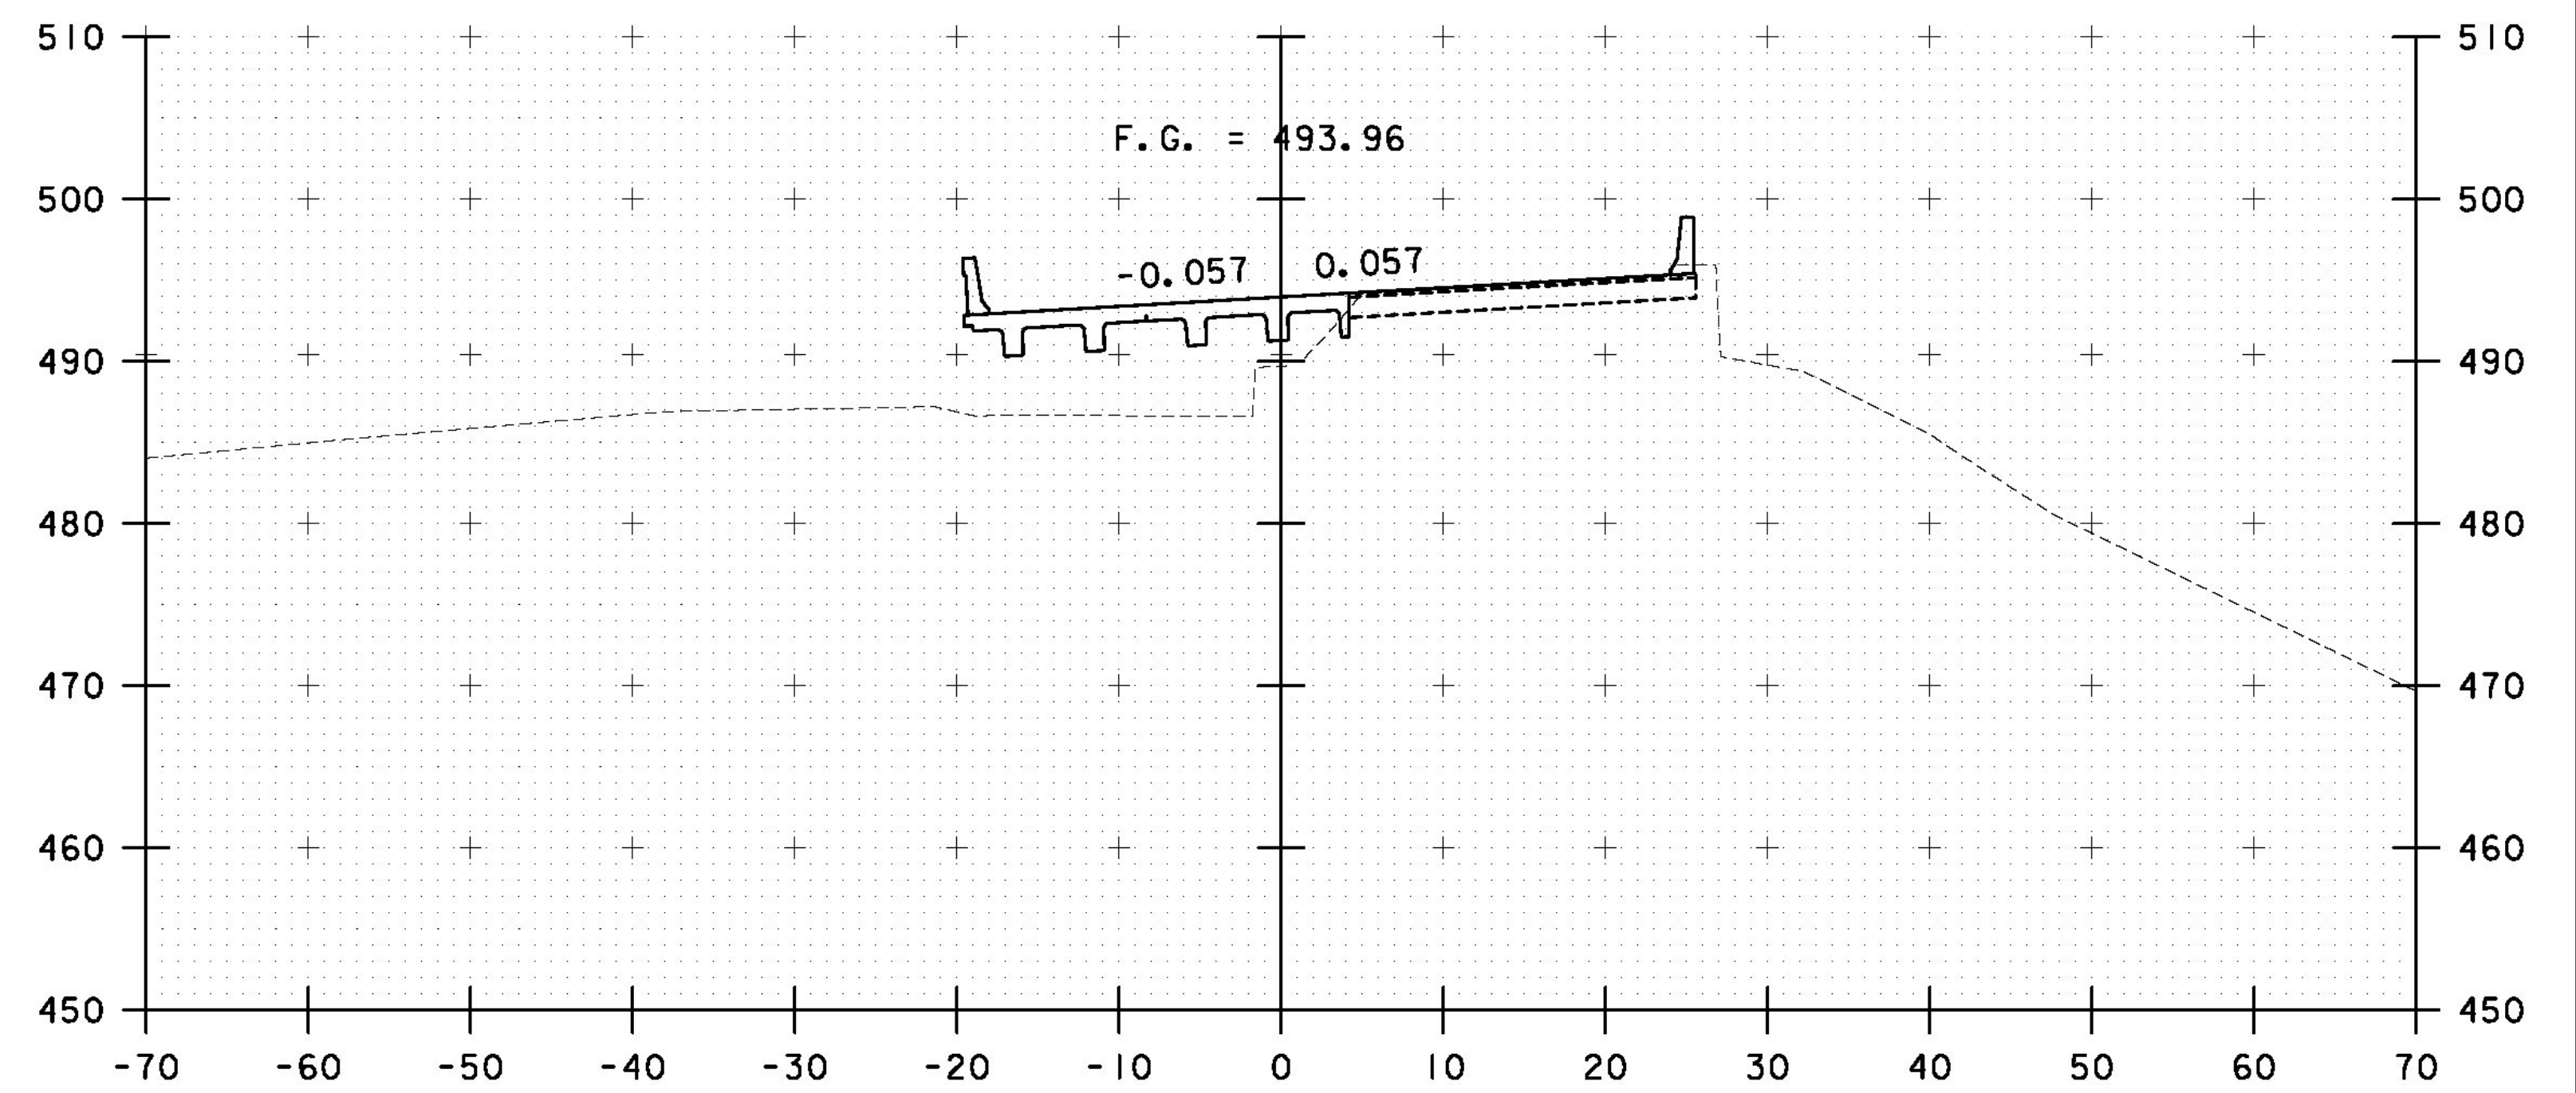

342+00

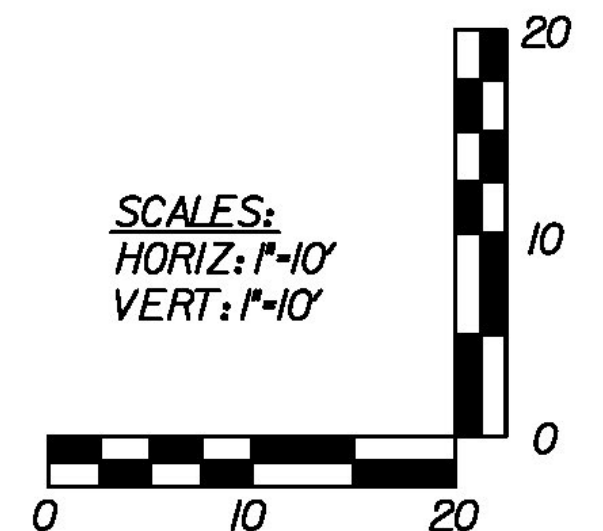

**AS BUILT
RECORD PLANS**

RFC PLANS - WORK PACKAGE #6
NB ROADWAY APPROACH
NOVEMBER 28, 2011

BECK & BELLUCCI, INC. **TYLIN INTERNATIONAL**

STA. 341+00 TO STA. 342+40	
PROJECT NAME:	BRATTLEBORO
PROJECT NUMBER:	IM 091-(150)
FILE NAME:	HW-RA-DGN-900.dgn
PROJECT LEADER:	Phillip E. Kendall II, P.E.
DESIGNED BY:	Phillip E. Kendall P.E.
CROSS SECTIONS	3 OF 8
PLOT DATE:	11/30/2011
DRAWN BY:	A. R. Greenlaw
CHECKED BY:	D. Bryant, P.E.
SHEET	HW-RA-DGN-903