




343+00
 STA. 343+00
 LIMIT OF WORK
 END MILL AND OVERLAY

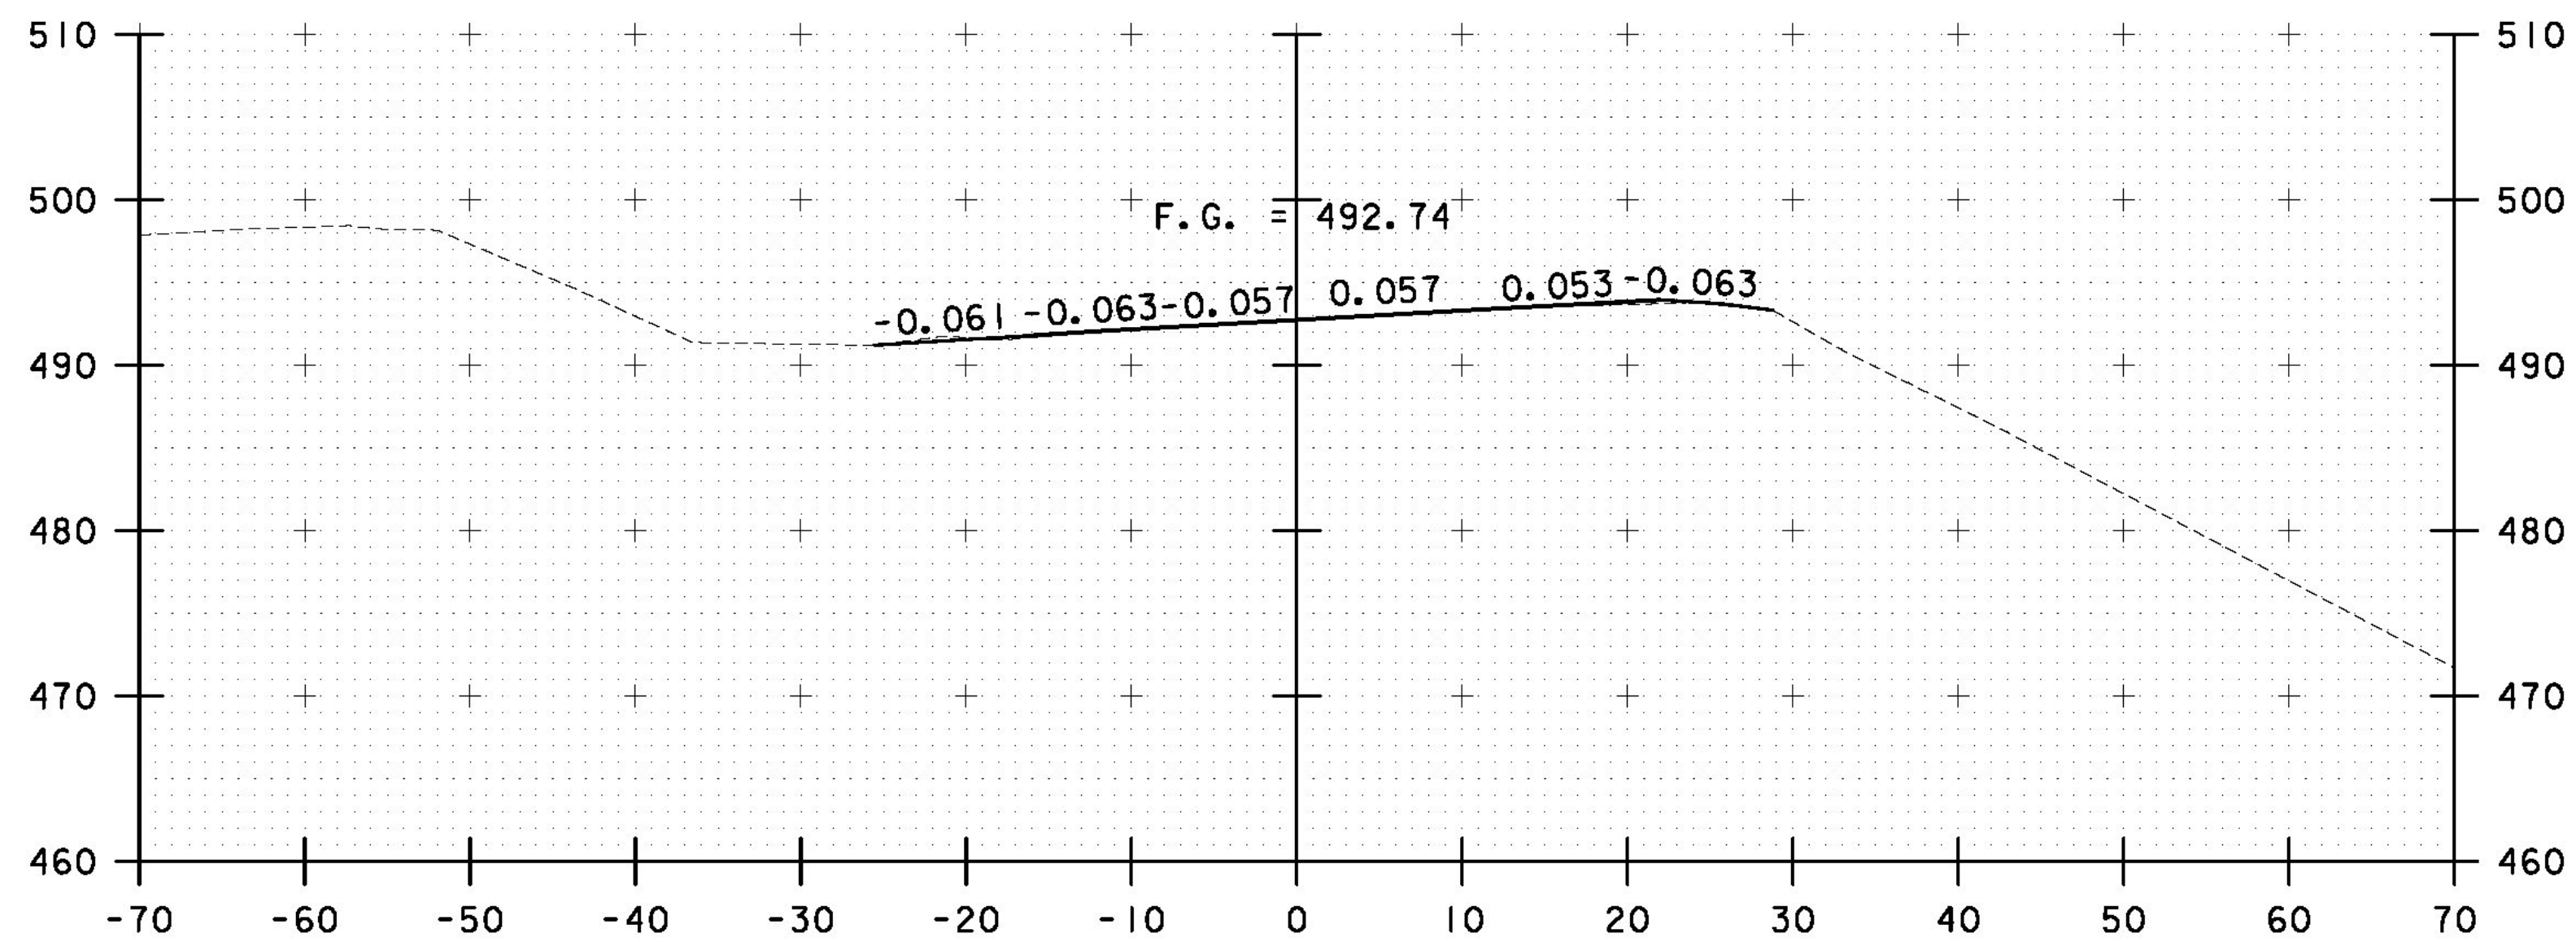


342+50
 STA. 342+50
 END FULL DEPTH CONSTRUCTION
 BEGIN MILL AND OVERLAY

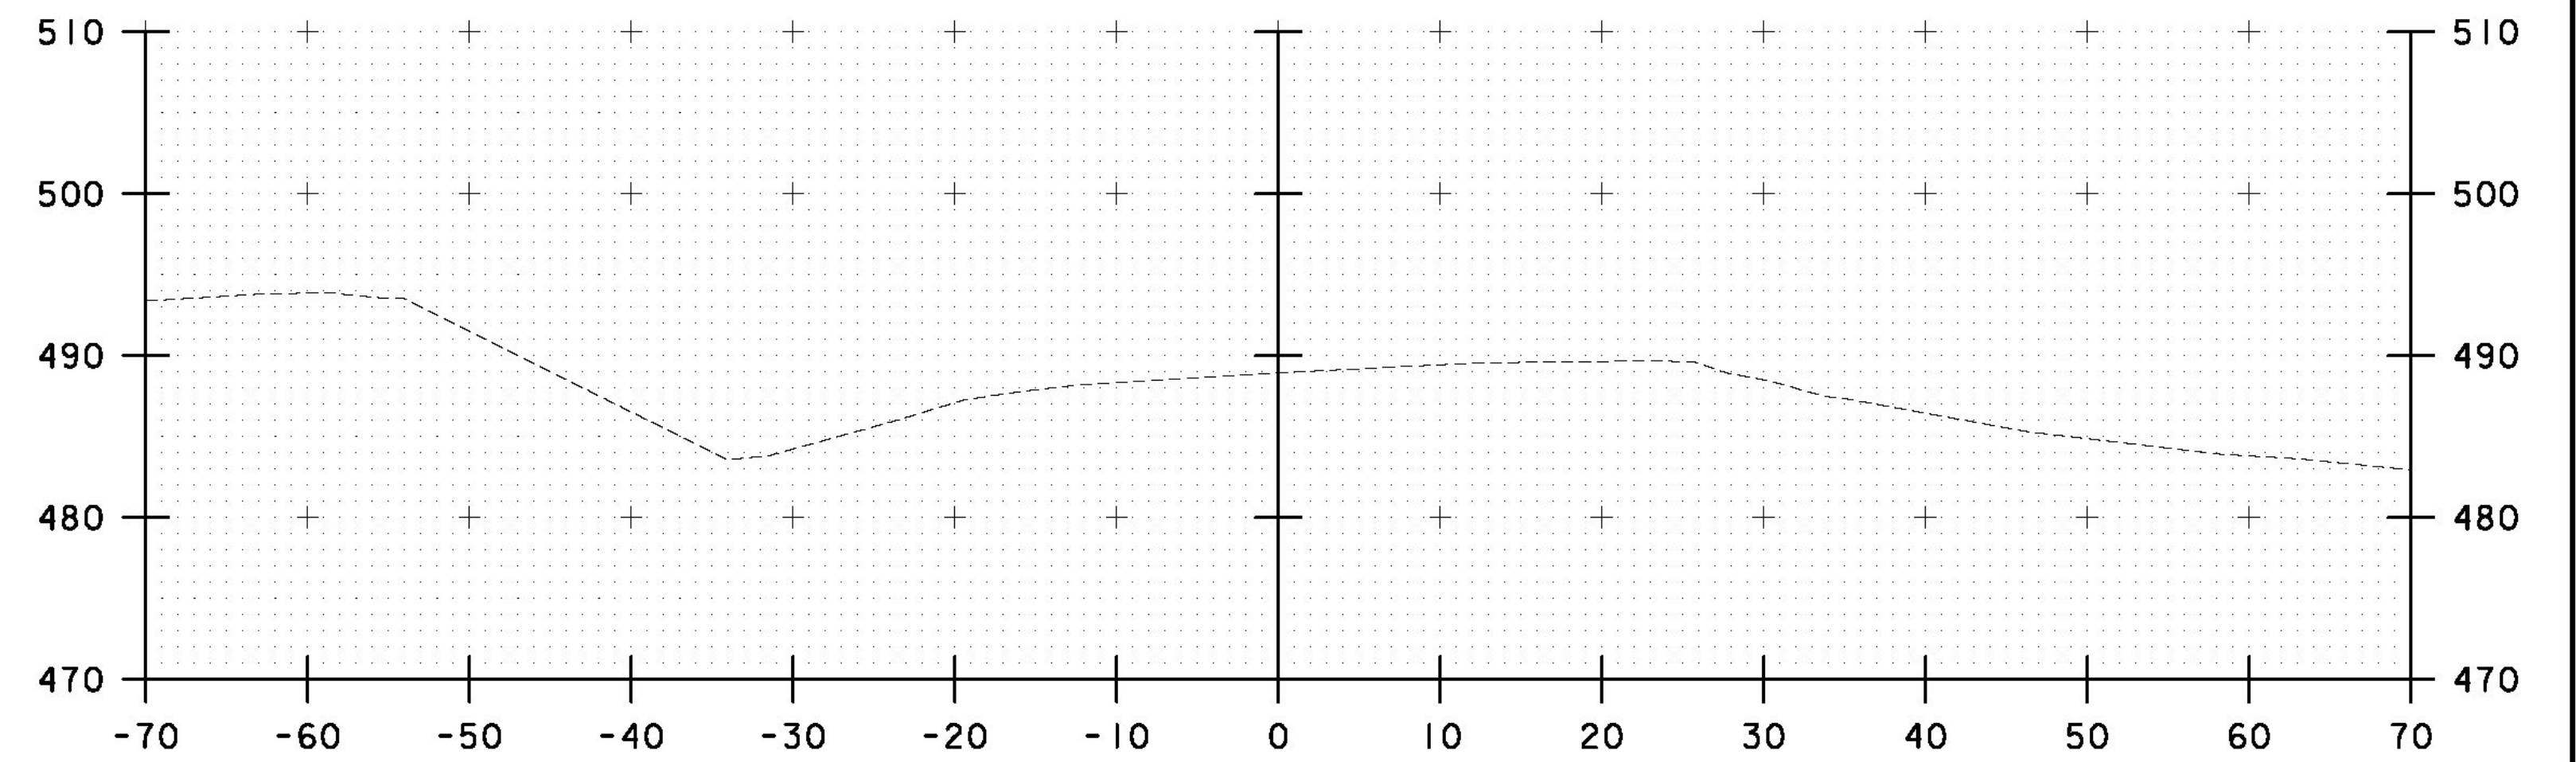

344+00

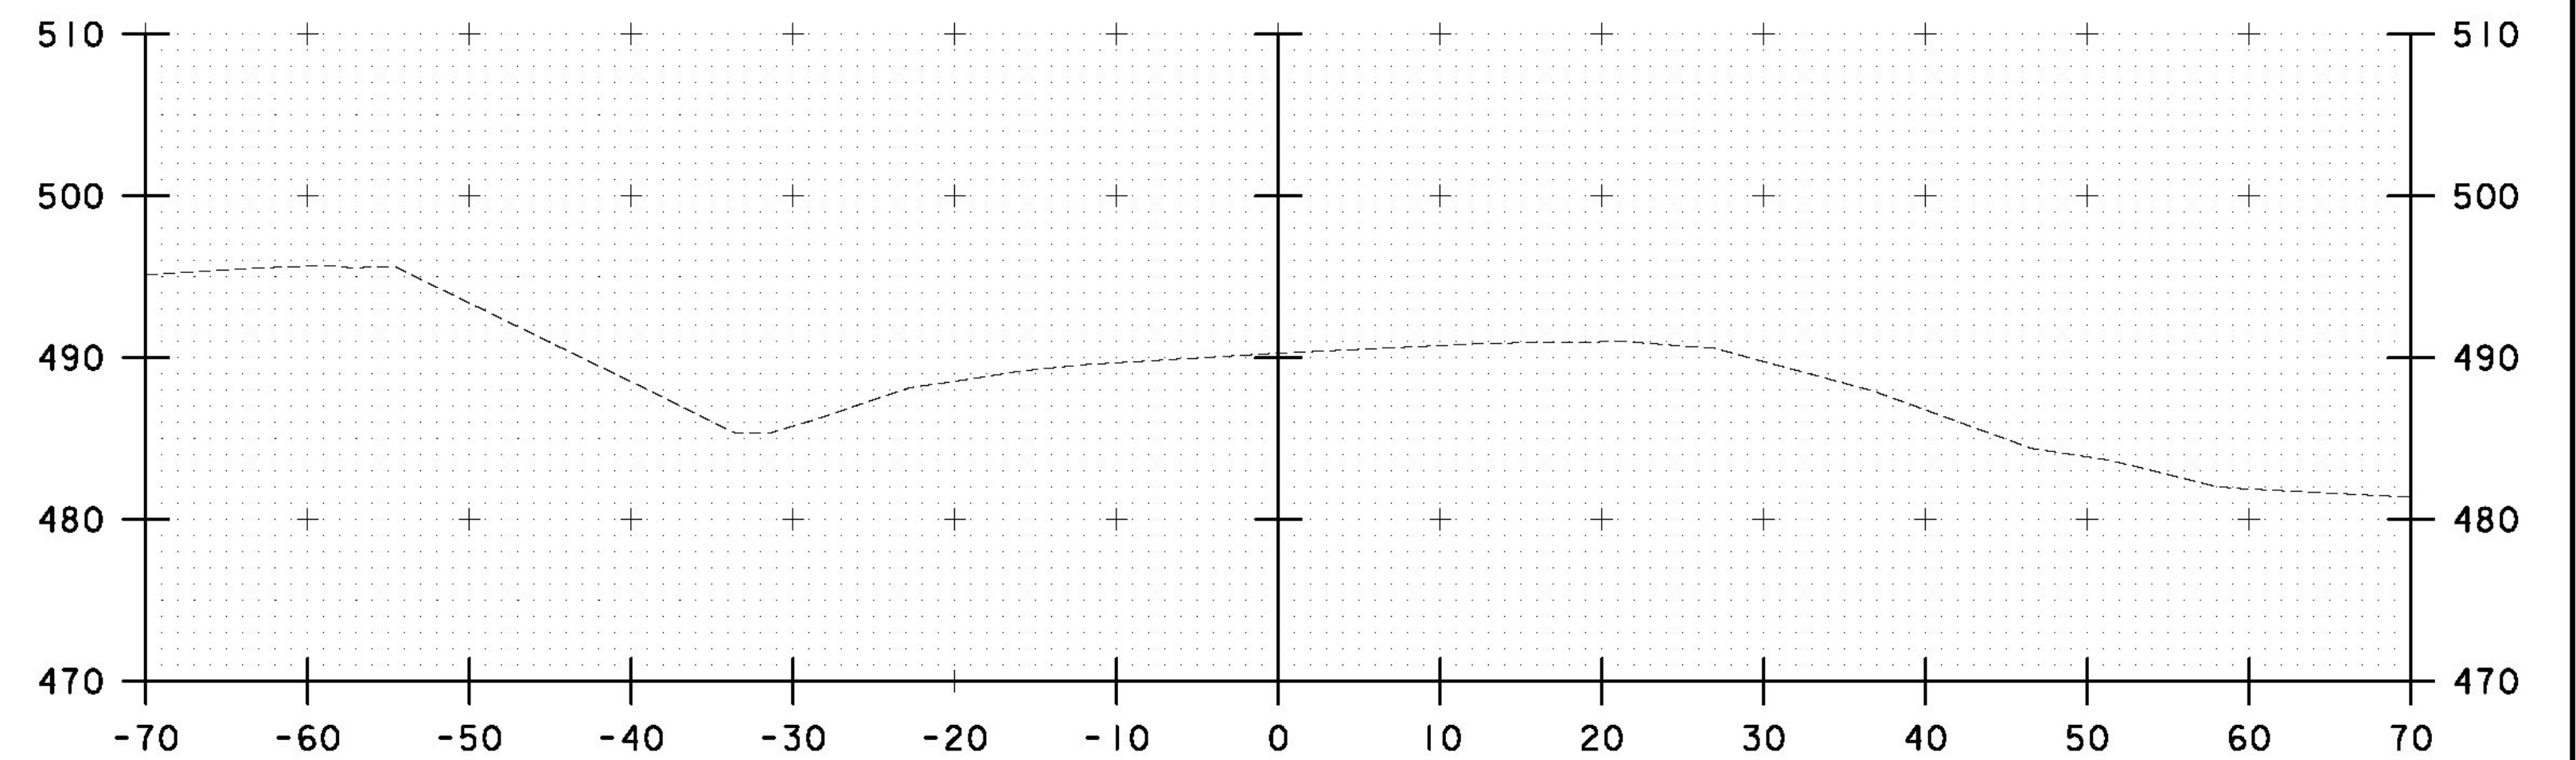

343+50

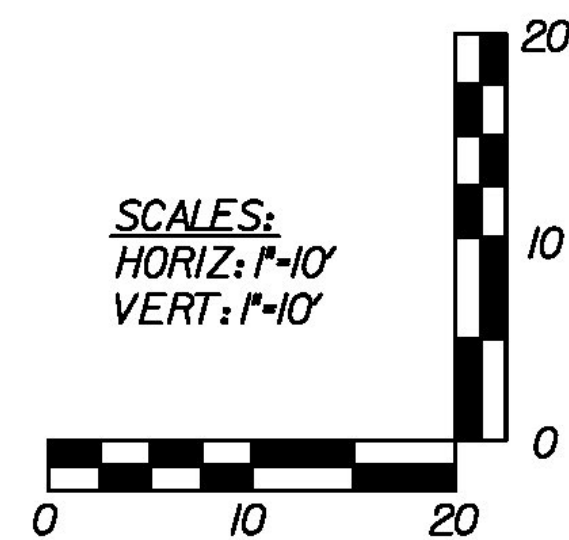

**AS BUILT
 RECORD PLANS**

RFC PLANS - WORK PACKAGE #6
 NB ROADWAY APPROACH
 NOVEMBER 28, 2011

BECK & BELLUCCI, INC.

TYLIN INTERNATIONAL

STA. 342+50 TO STA. 344+00

PROJECT NAME: BRATTLEBORO

PROJECT NUMBER: IM 091-(150)

FILE NAME: HW-RA-DGN-900.dgn

PROJECT LEADER: Phillip E. Kendall II, P.E.

DESIGNED BY: Phillip E. Kendall P.E.

CROSS SECTIONS 4 OF 8

PLOT DATE: 11/30/2011

DRAWN BY: A. R. Greenlaw

CHECKED BY: D. Bryant, P.E.

SHEET HW-RA-DGN-903A