




356+50

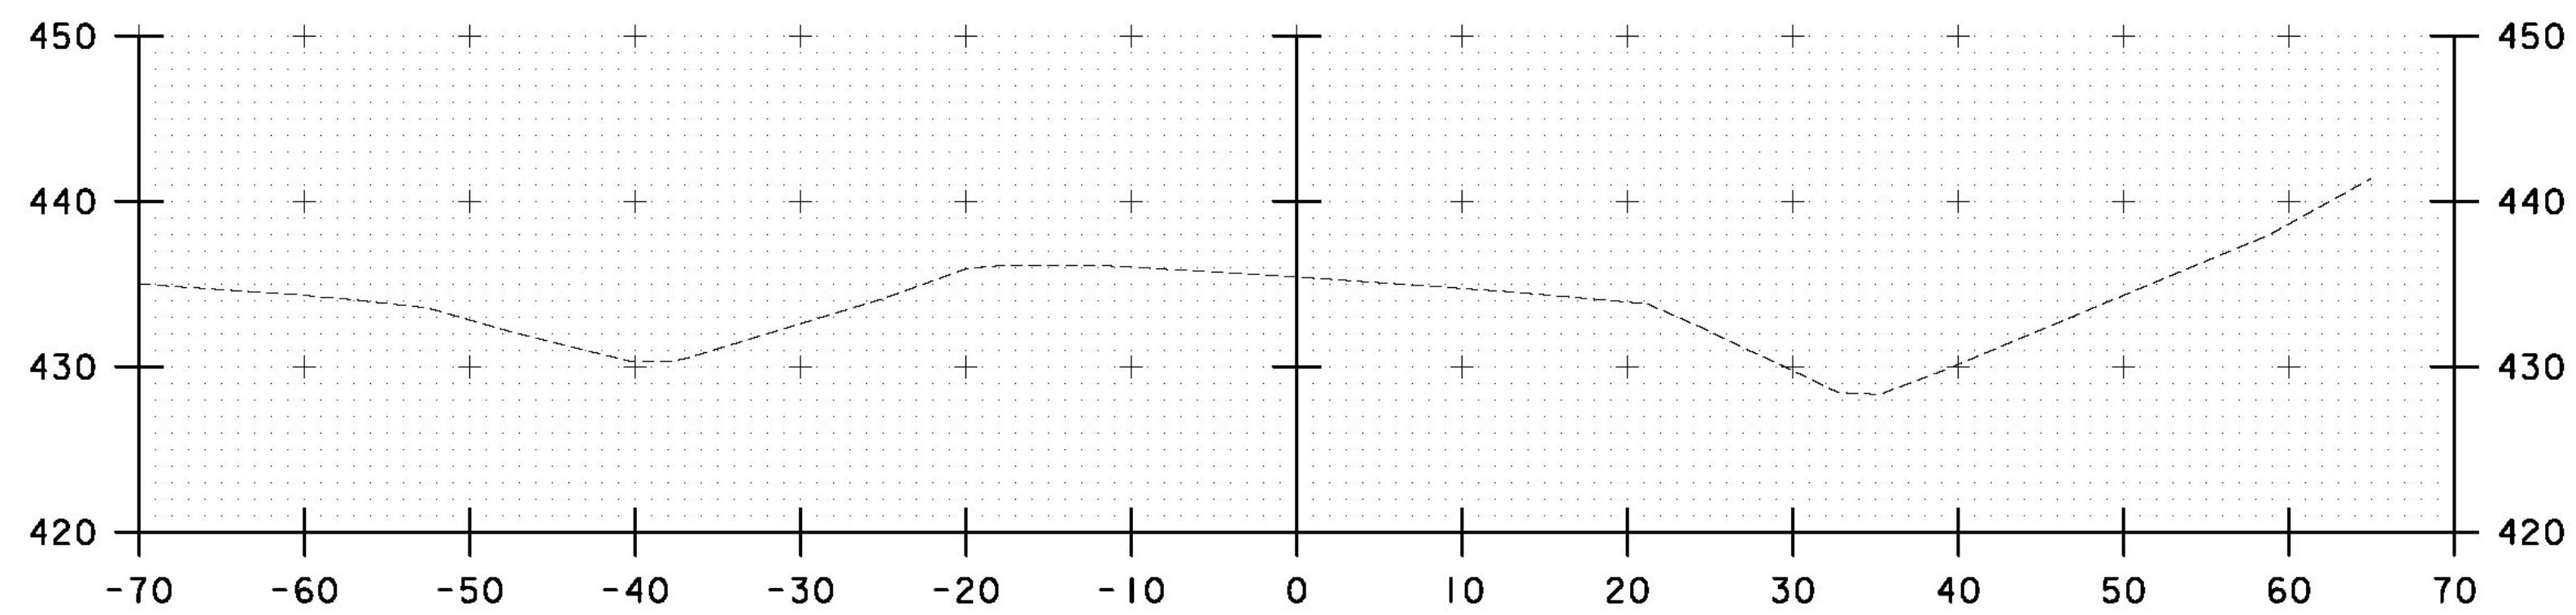


356+00

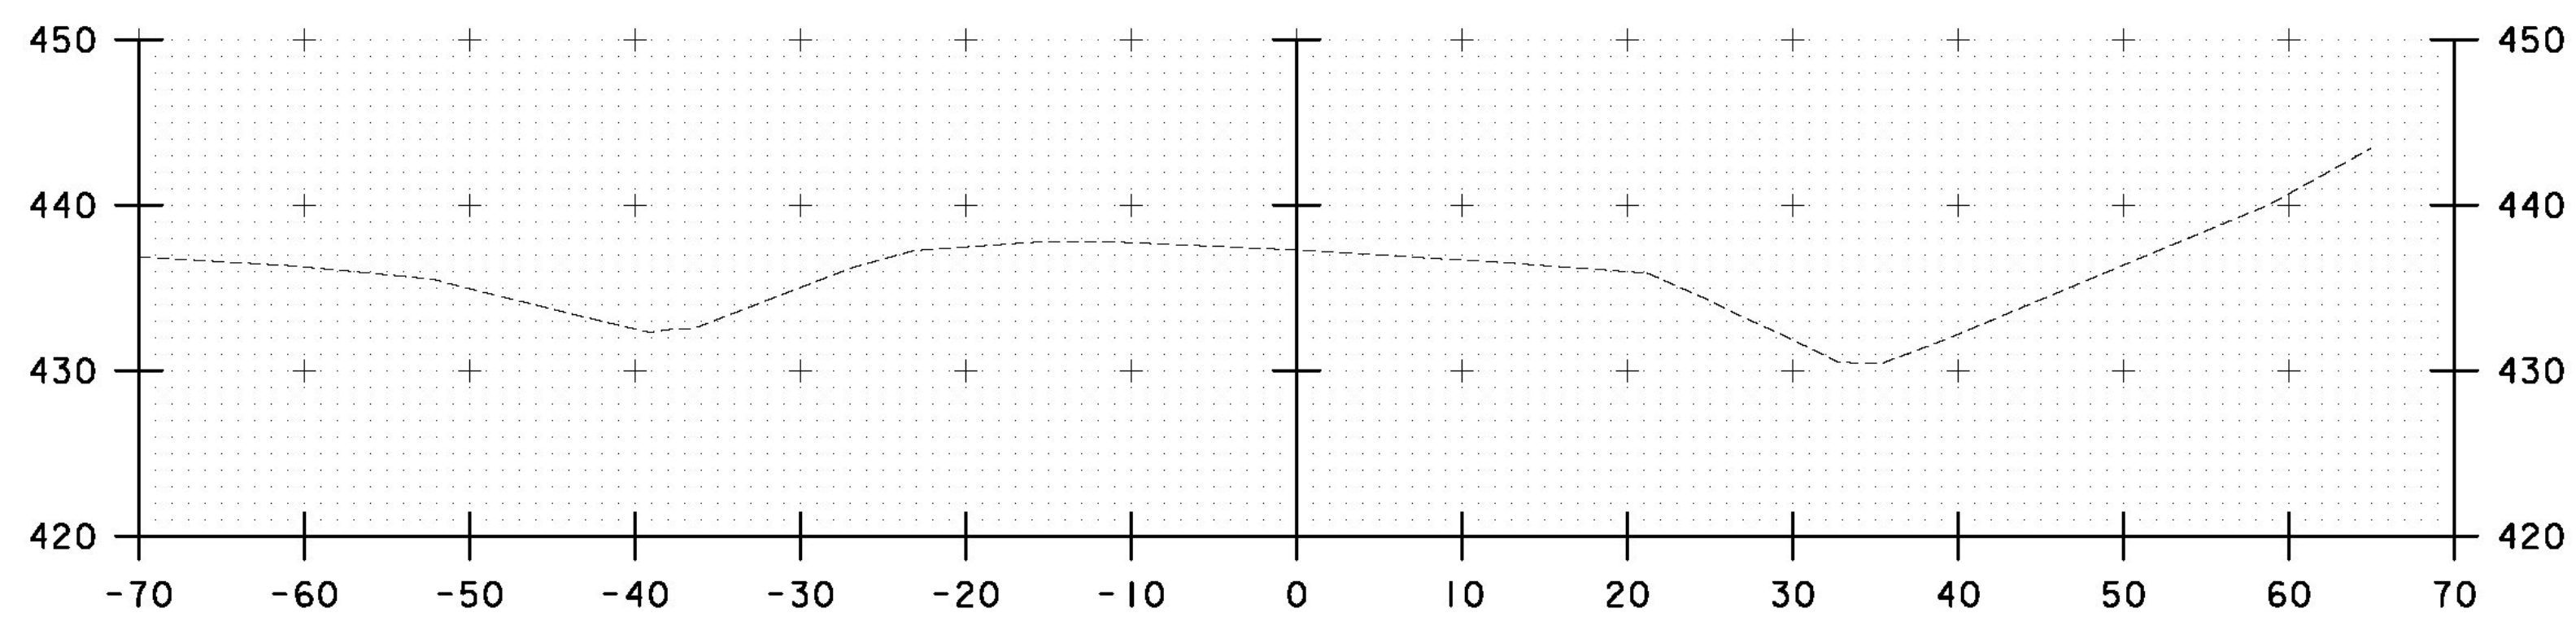


355+63

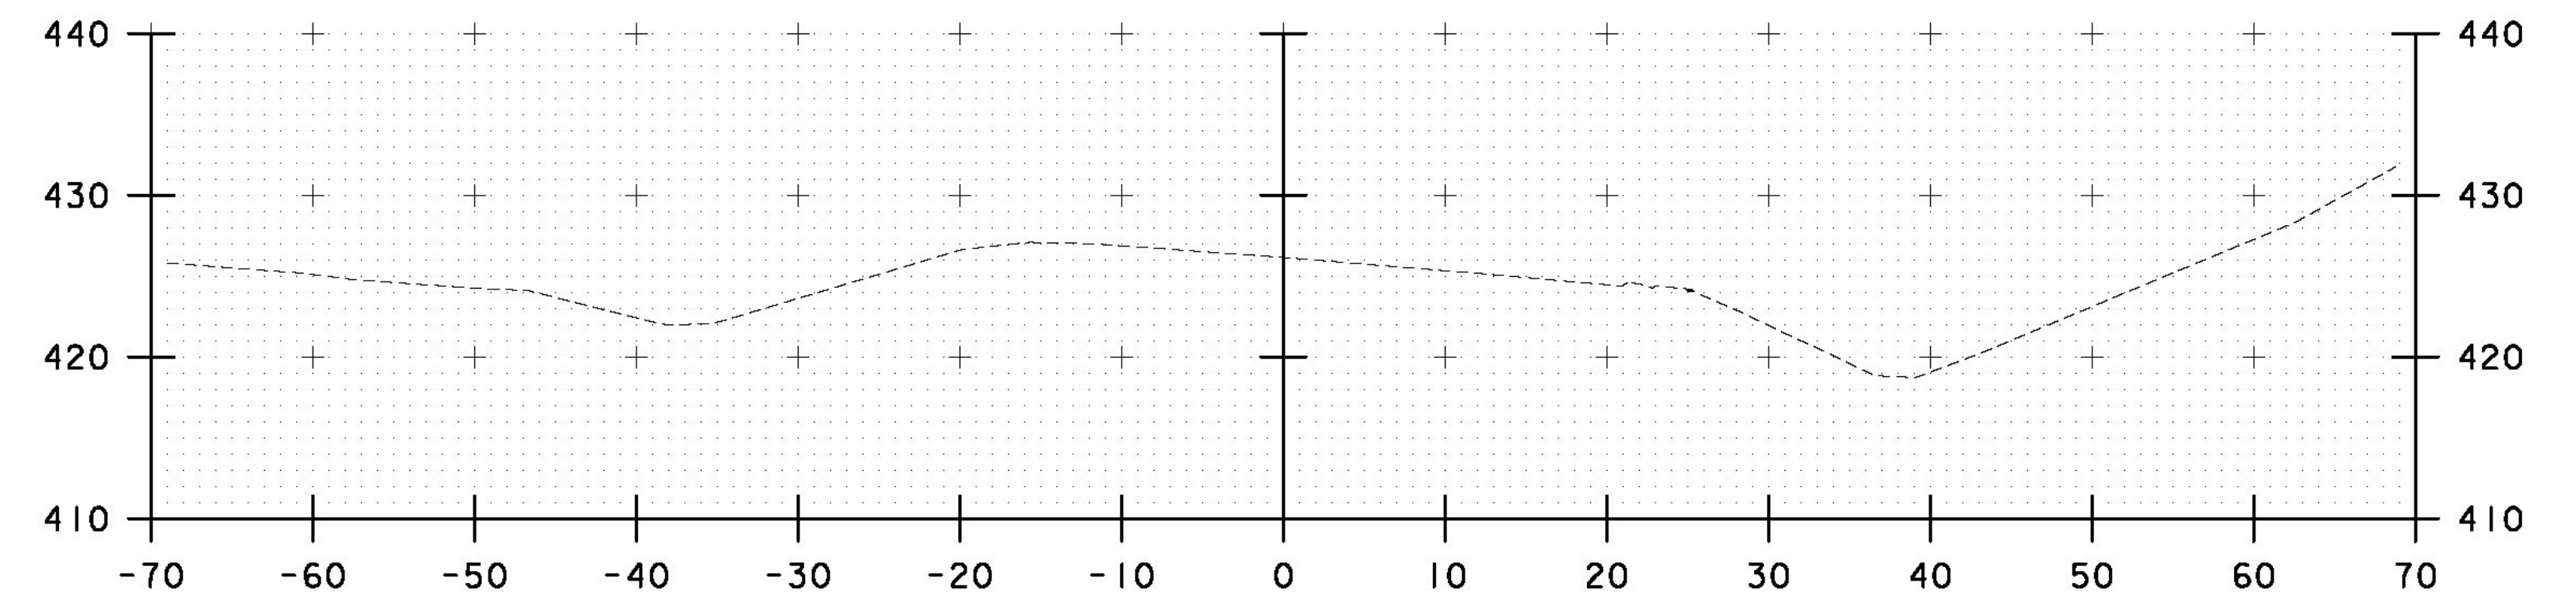


358+00

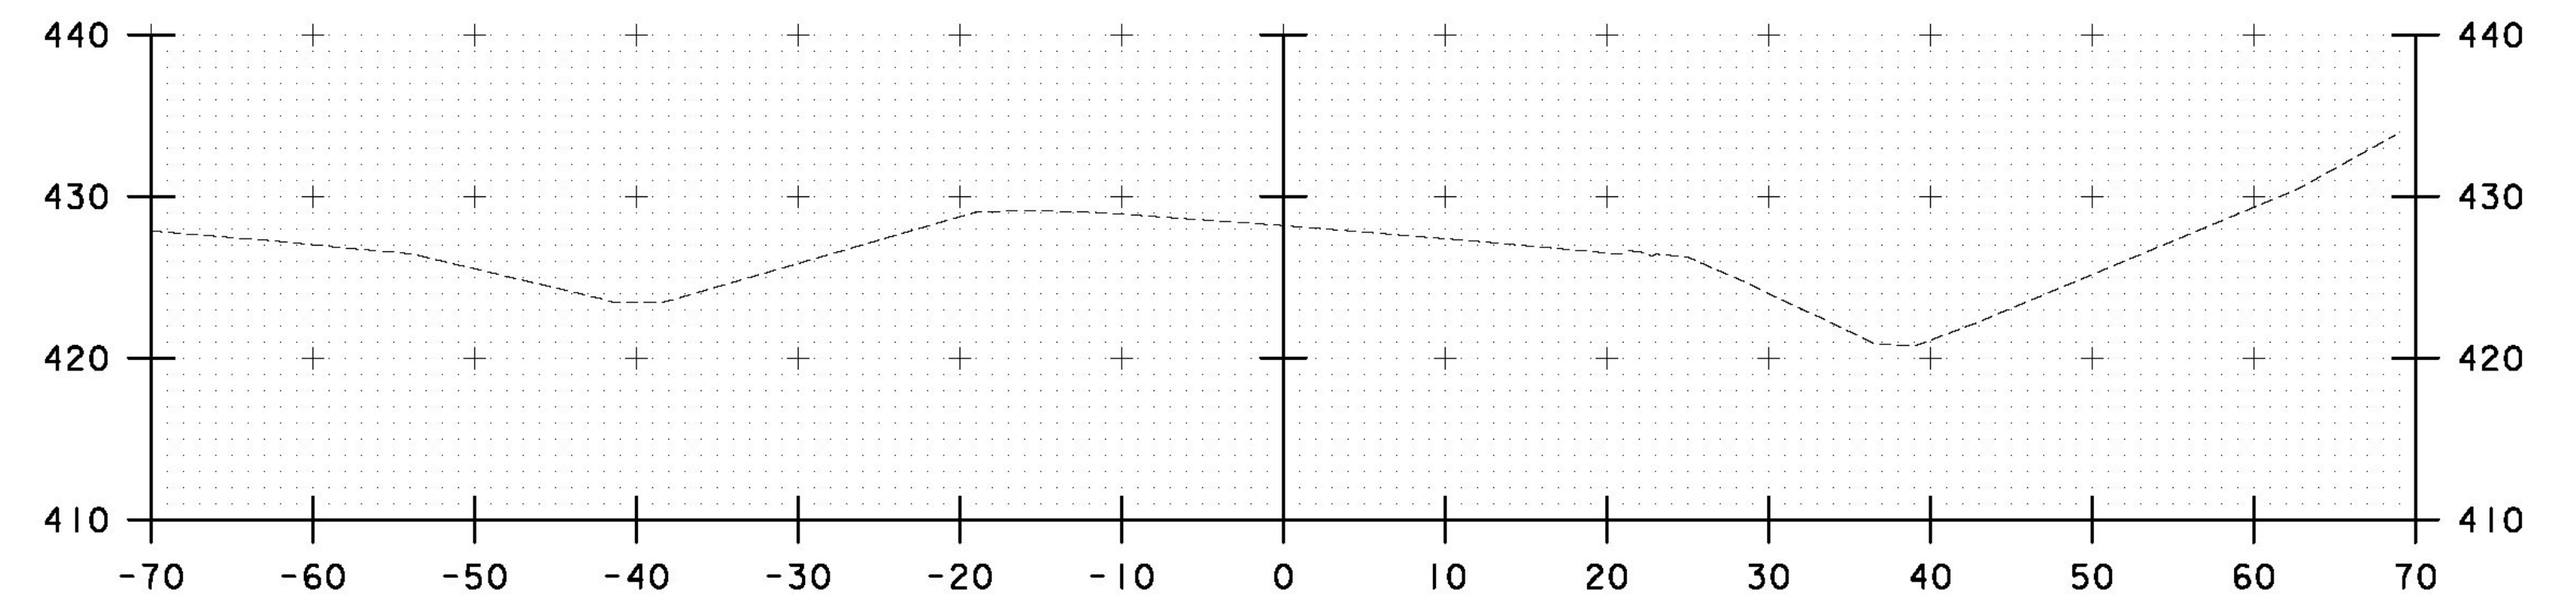

357+50

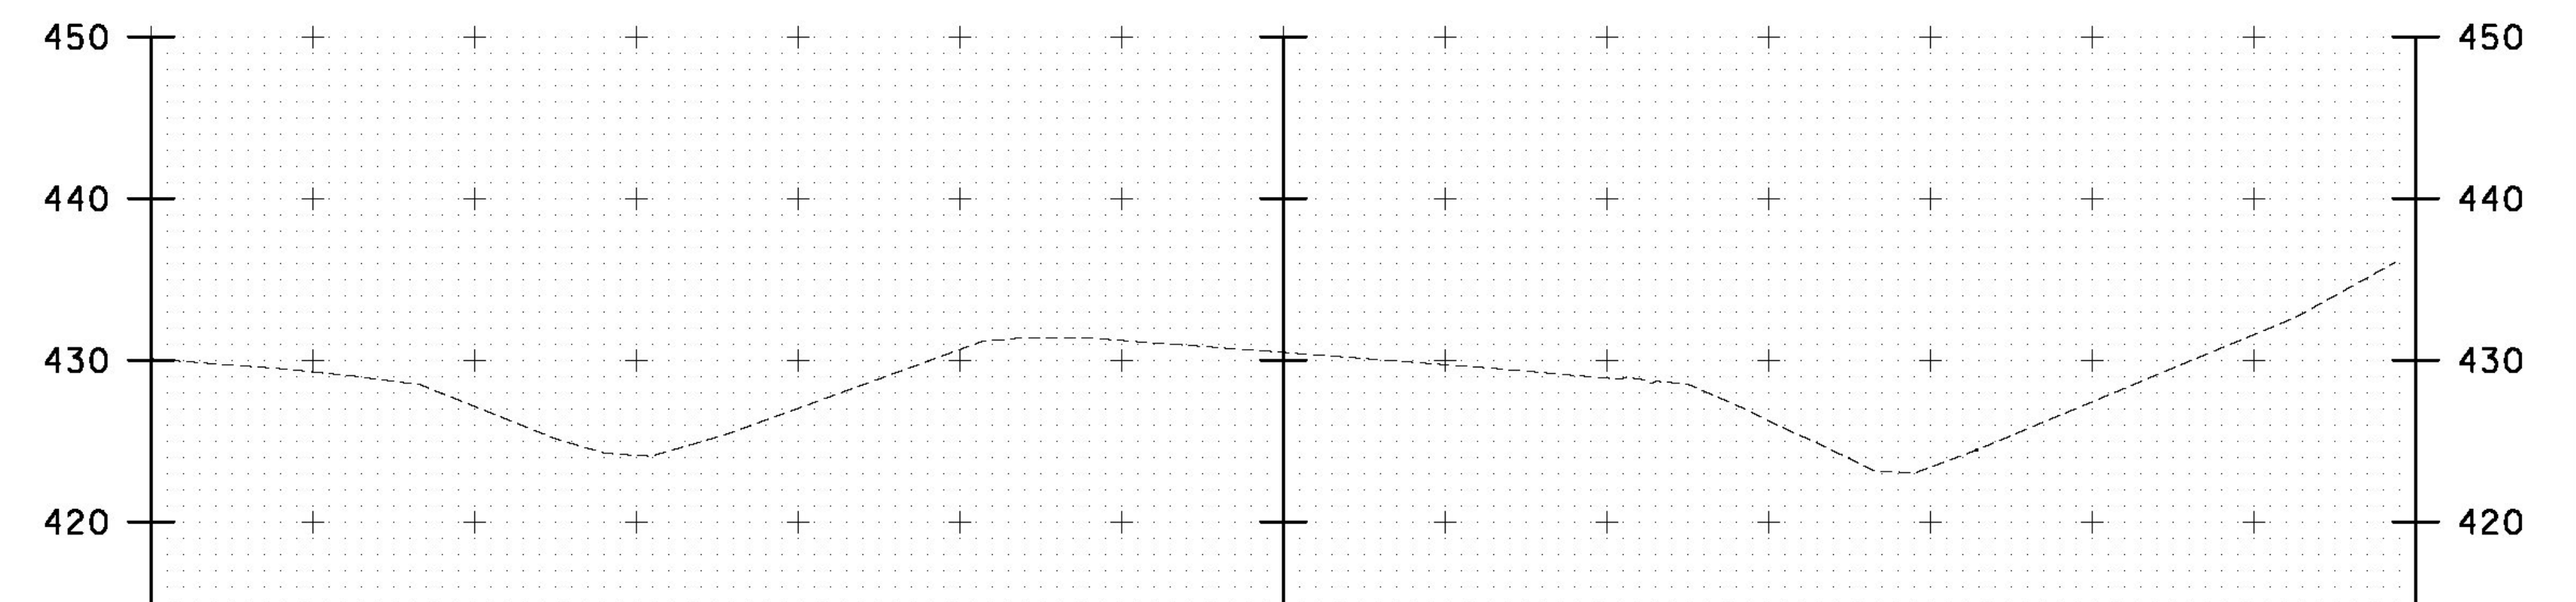

357+00

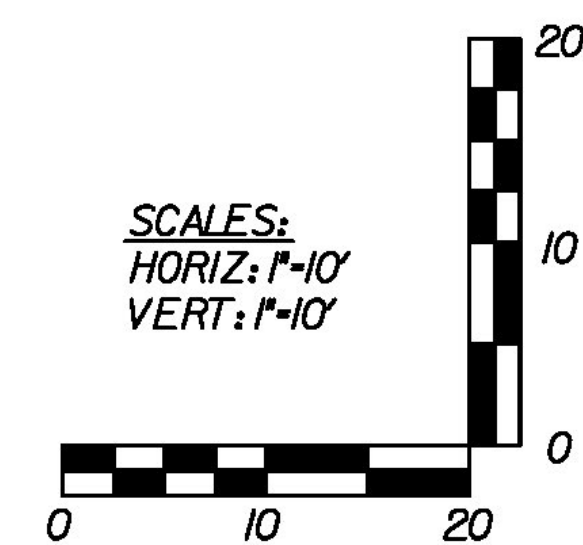

**AS BUILT
RECORD PLANS**

RFC PLANS - WORK PACKAGE #6
NB ROADWAY APPROACH
NOVEMBER 28, 2011

BECK & BELLUCCI, INC.

TYLIN INTERNATIONAL

STA. 355+63 TO STA. 358+00

PROJECT NAME: BRATTLEBORO

PROJECT NUMBER: IM 091-(150)

FILE NAME: HW-RA-DGN-900.dgn

PROJECT LEADER: Phillip E. Kendall II, P.E.

DESIGNED BY: Phillip E. Kendall P.E.

CROSS SECTIONS 5 OF 8

PLOT DATE: 11/30/2011

DRAWN BY: A. R. Greenlaw

CHECKED BY: D. Bryant, P.E.

SHEET HW-RA-DGN-904