



359+50

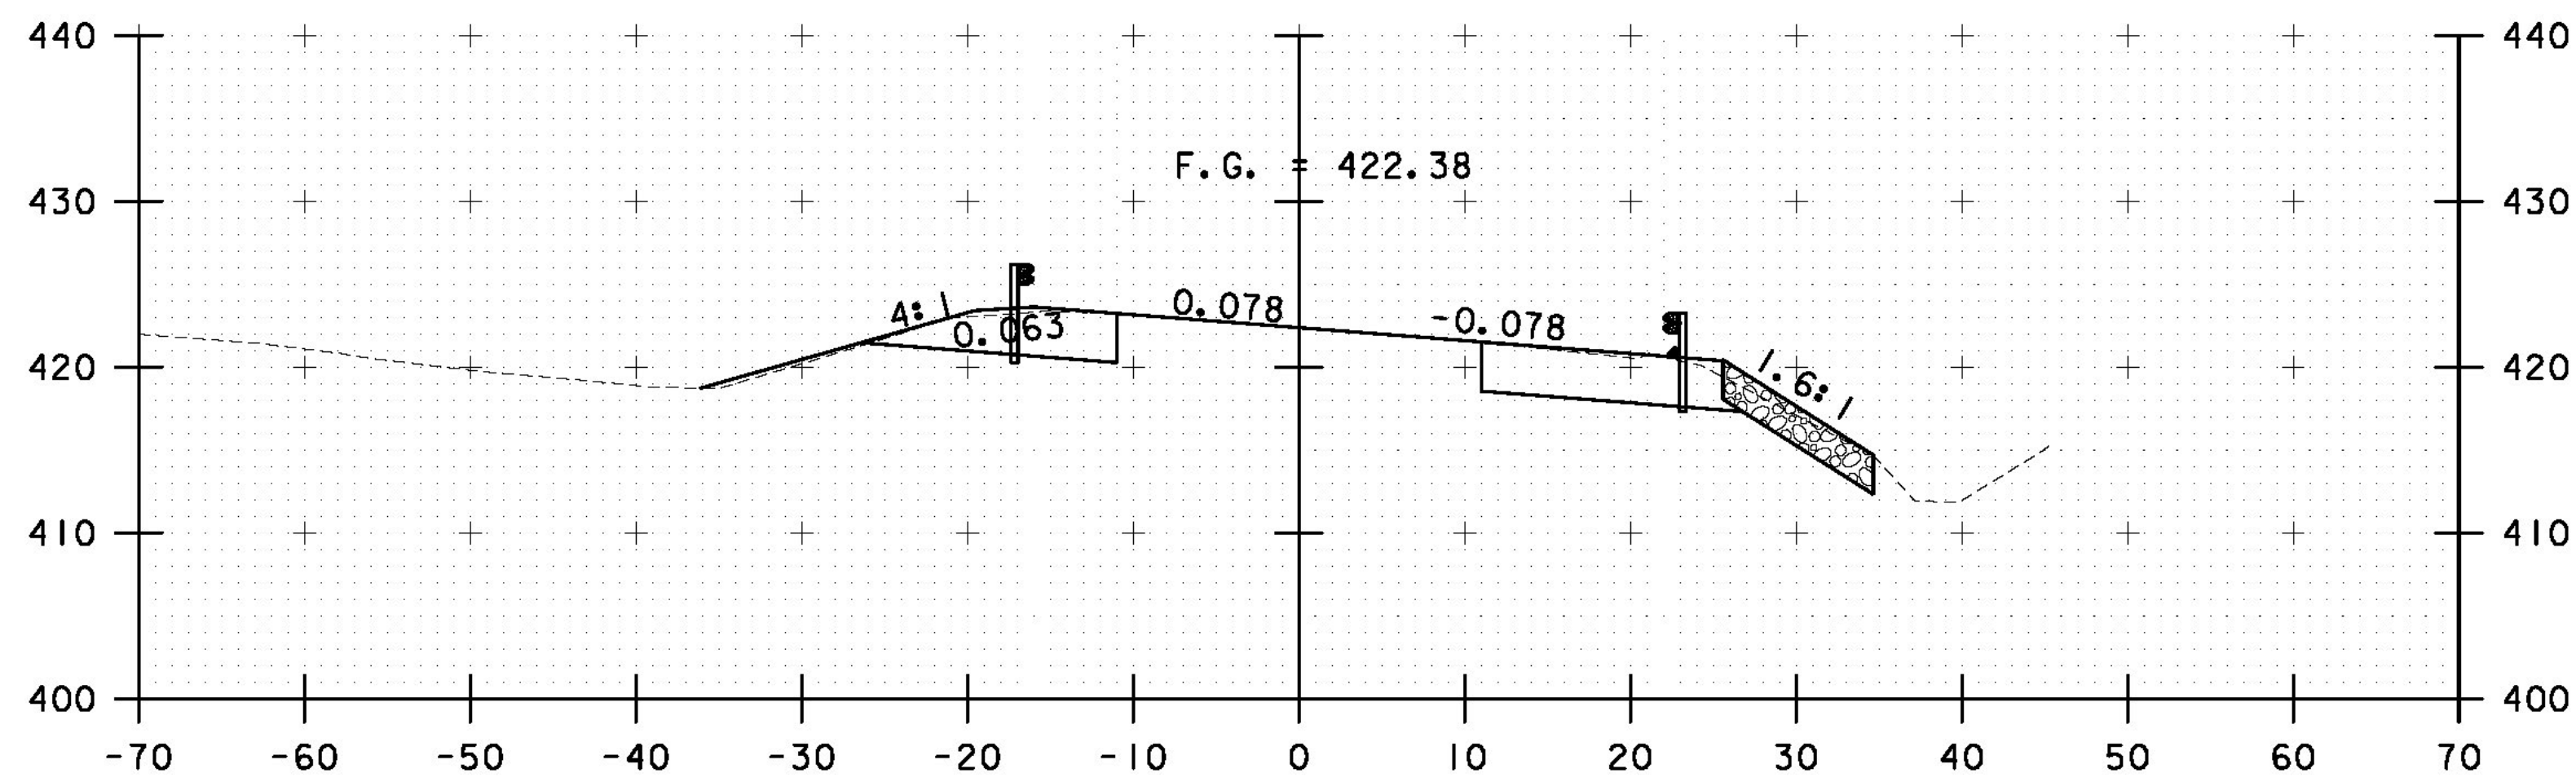


359+00

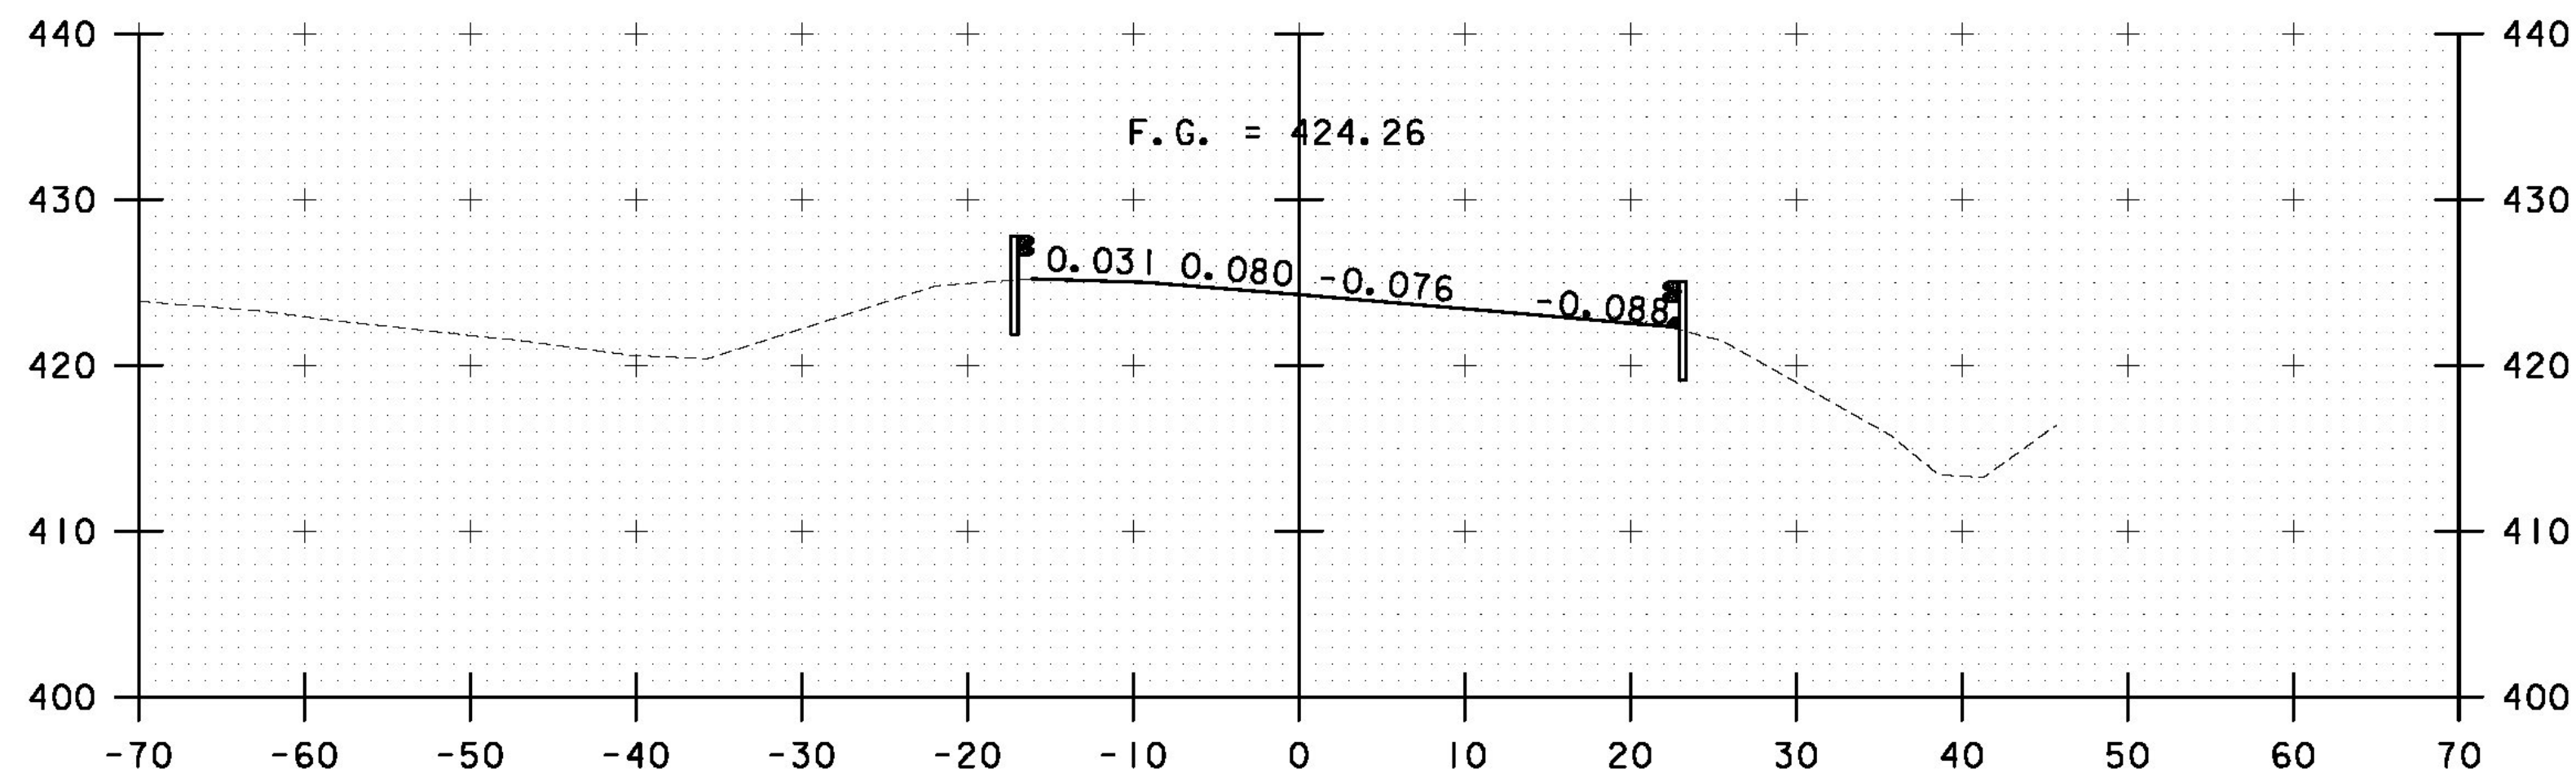


358+50

STA. 358+50 BEGIN MILL AND OVERLAY
MATCH EXISTING

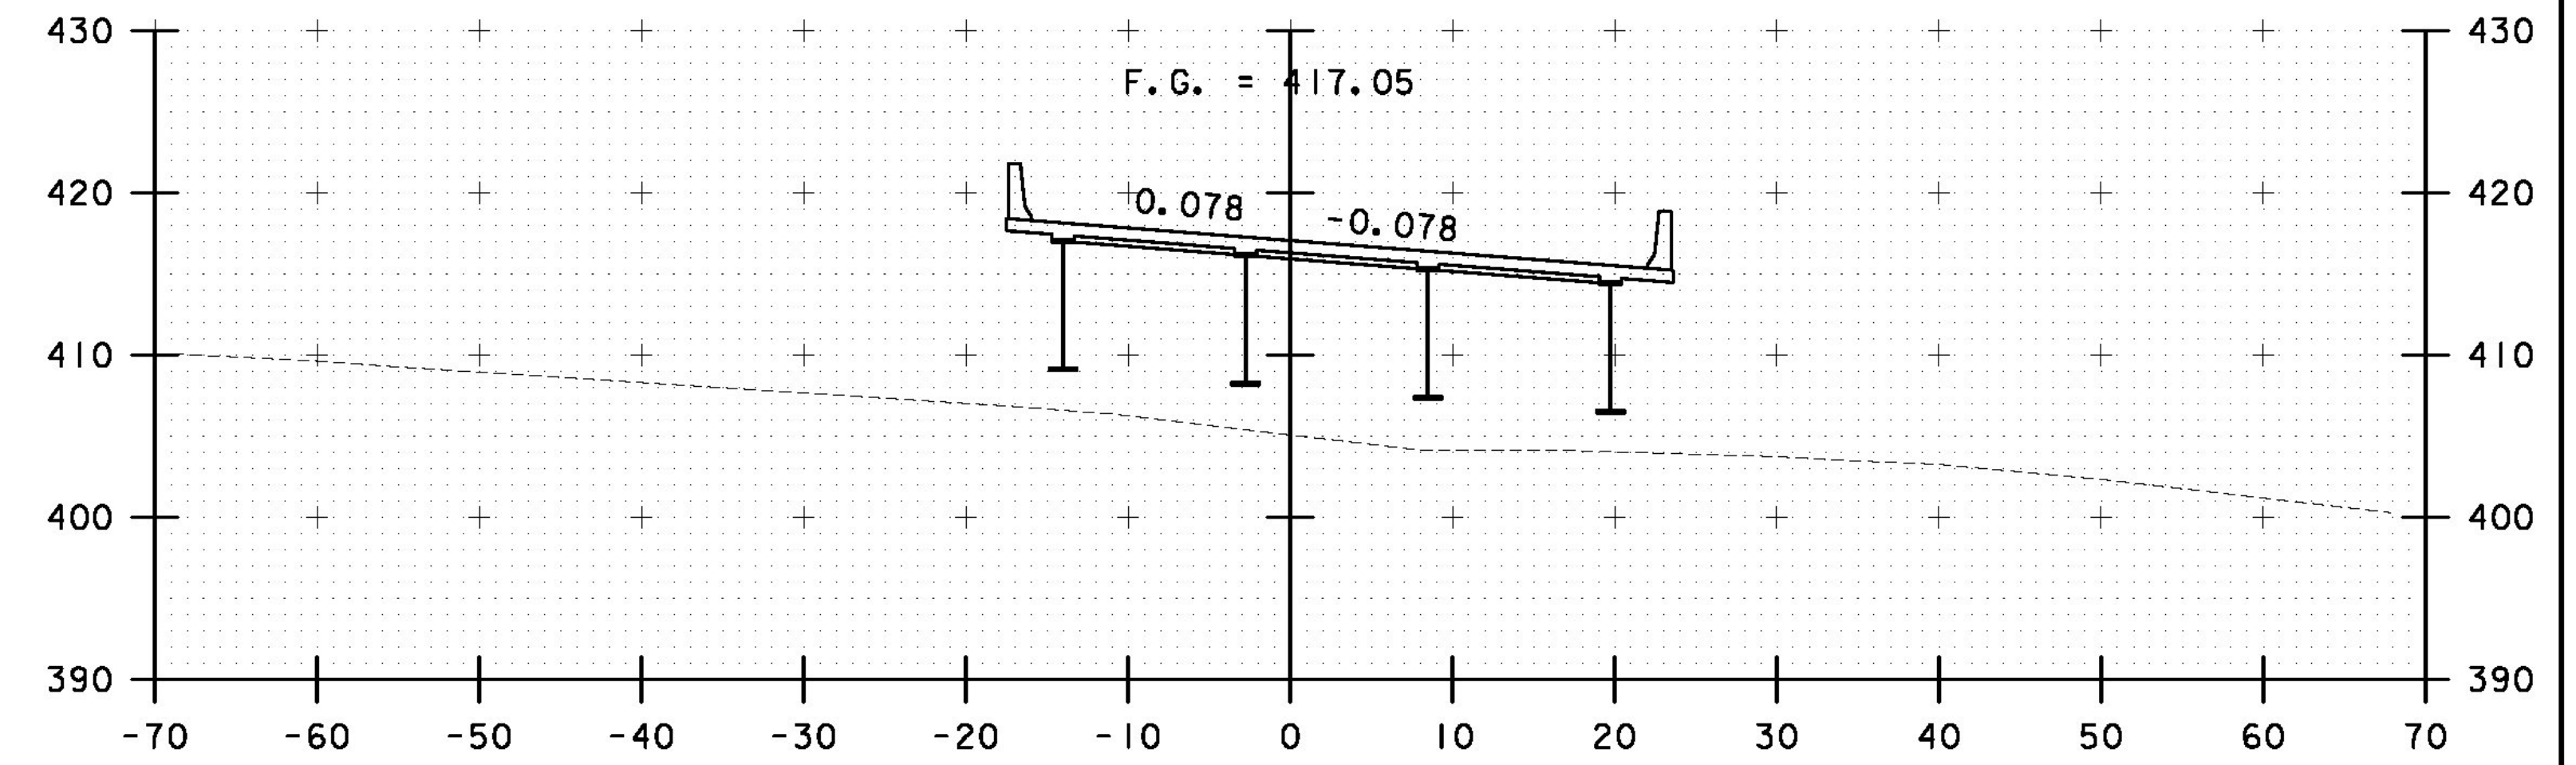


360+50

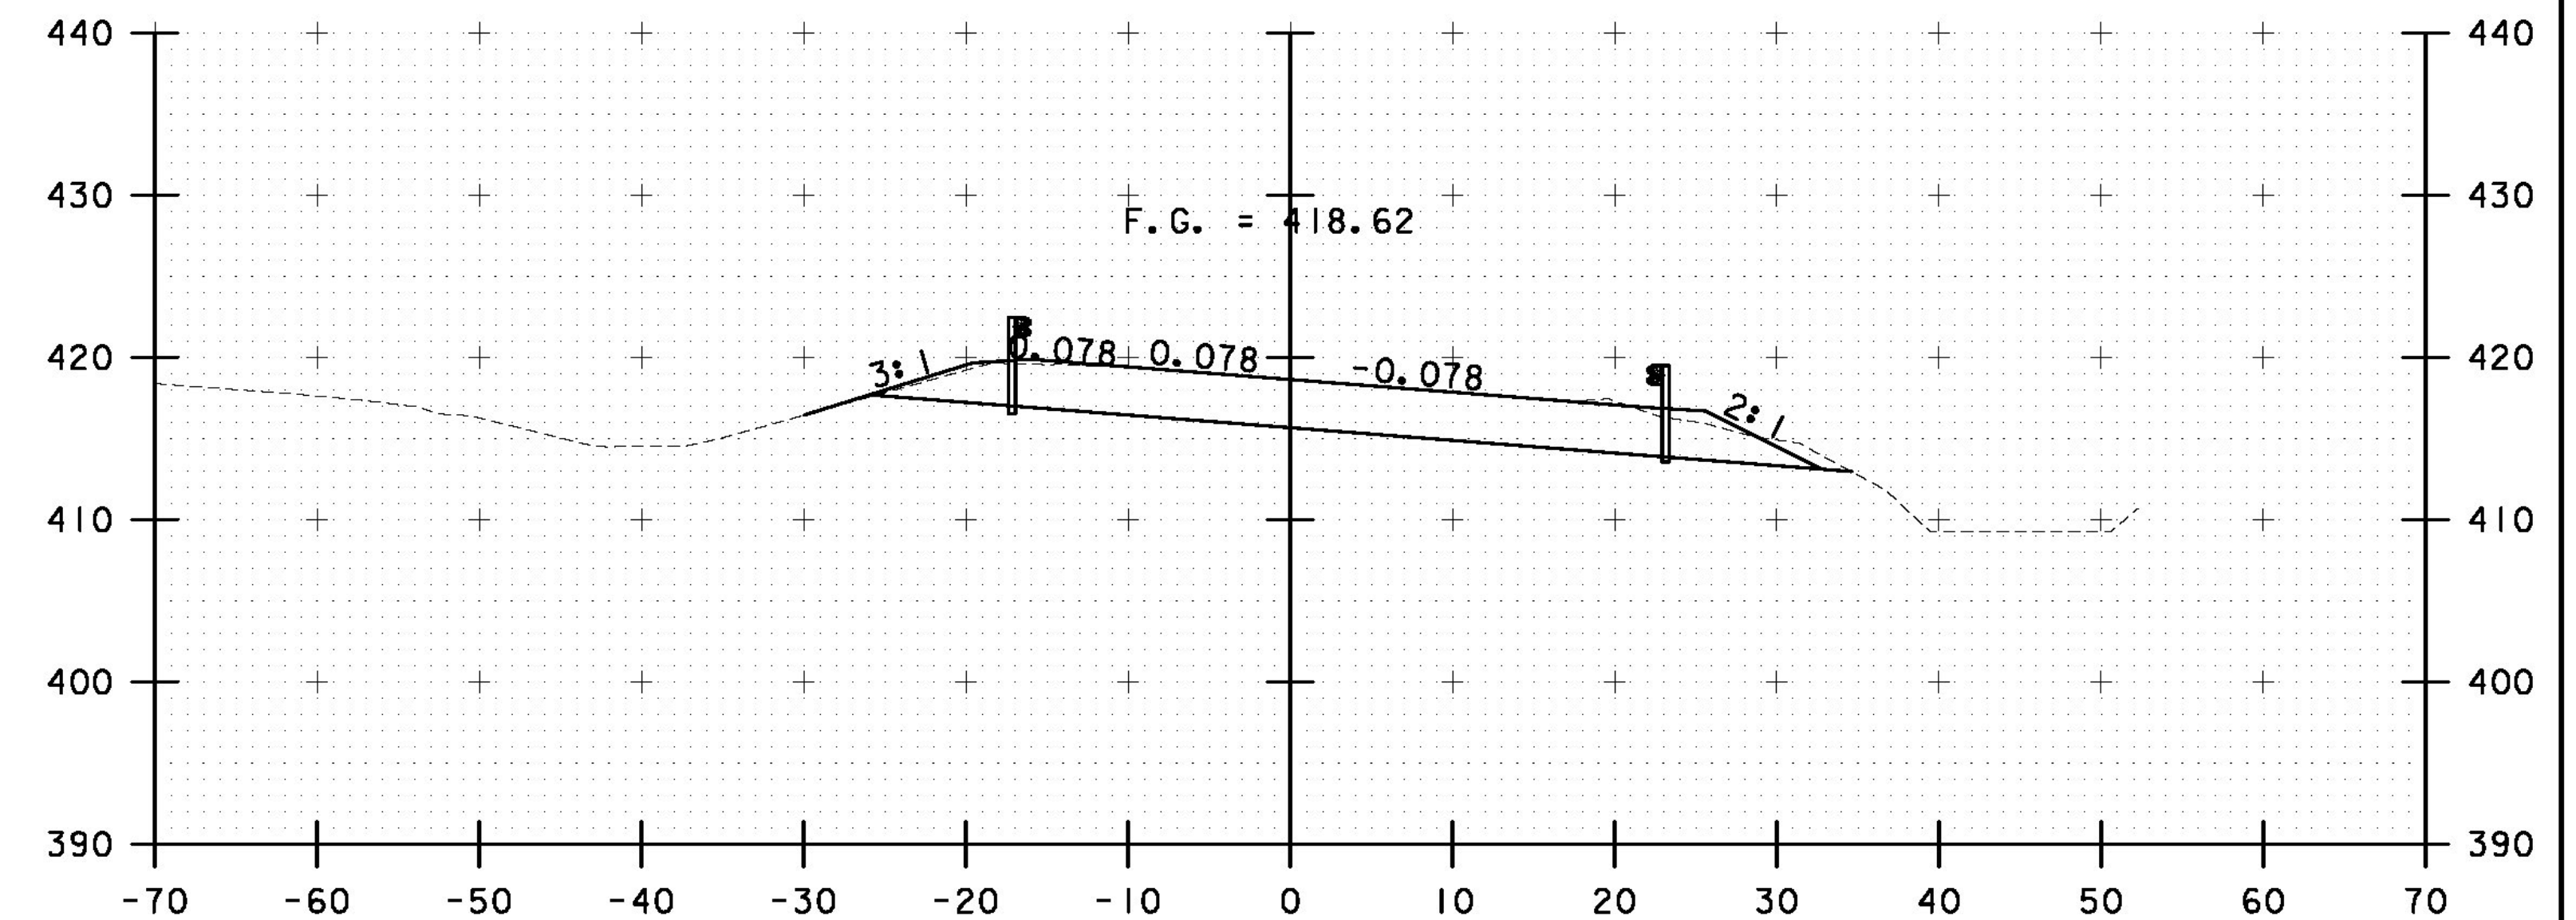

360+00

STA. 359+95 END MILL AND OVERLAY
BEGIN FULL DEPTH CONSTRUCTION

**AS BUILT
RECORD PLANS**

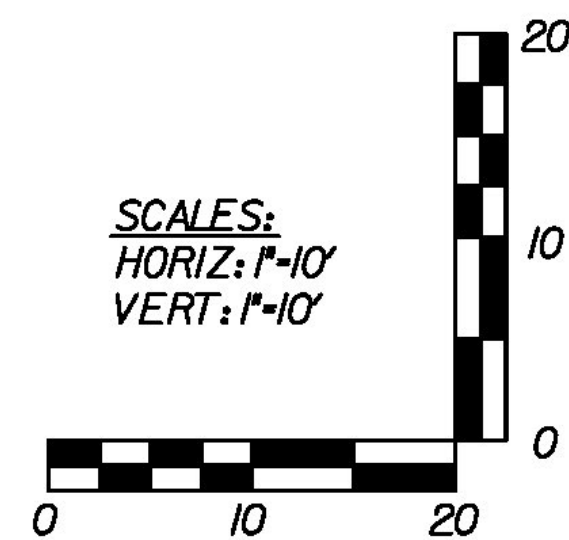

SCALES:
HORIZ: 1"=10'
VERT: 1"=10'

RFC PLANS - WORK PACKAGE #6
NB ROADWAY APPROACH
NOVEMBER 28, 2011

BECK & BELLUCCI, INC.

TYLIN INTERNATIONAL

STA. 358+50 TO STA. 360+50

PROJECT NAME: BRATTLEBORO

PROJECT NUMBER: IM 091-(150)

FILE NAME: HW-RA-DGN-900.dgn

PROJECT LEADER: Phillip E. Kendall II, P.E.

DESIGNED BY: Phillip E. Kendall P.E.

CROSS SECTIONS 6 OF 8

PLOT DATE: 11/30/2011

DRAWN BY: A. R. Greenlaw

CHECKED BY: D. Bryant, P.E.

SHEET HW-RA-DGN-905