



364+00

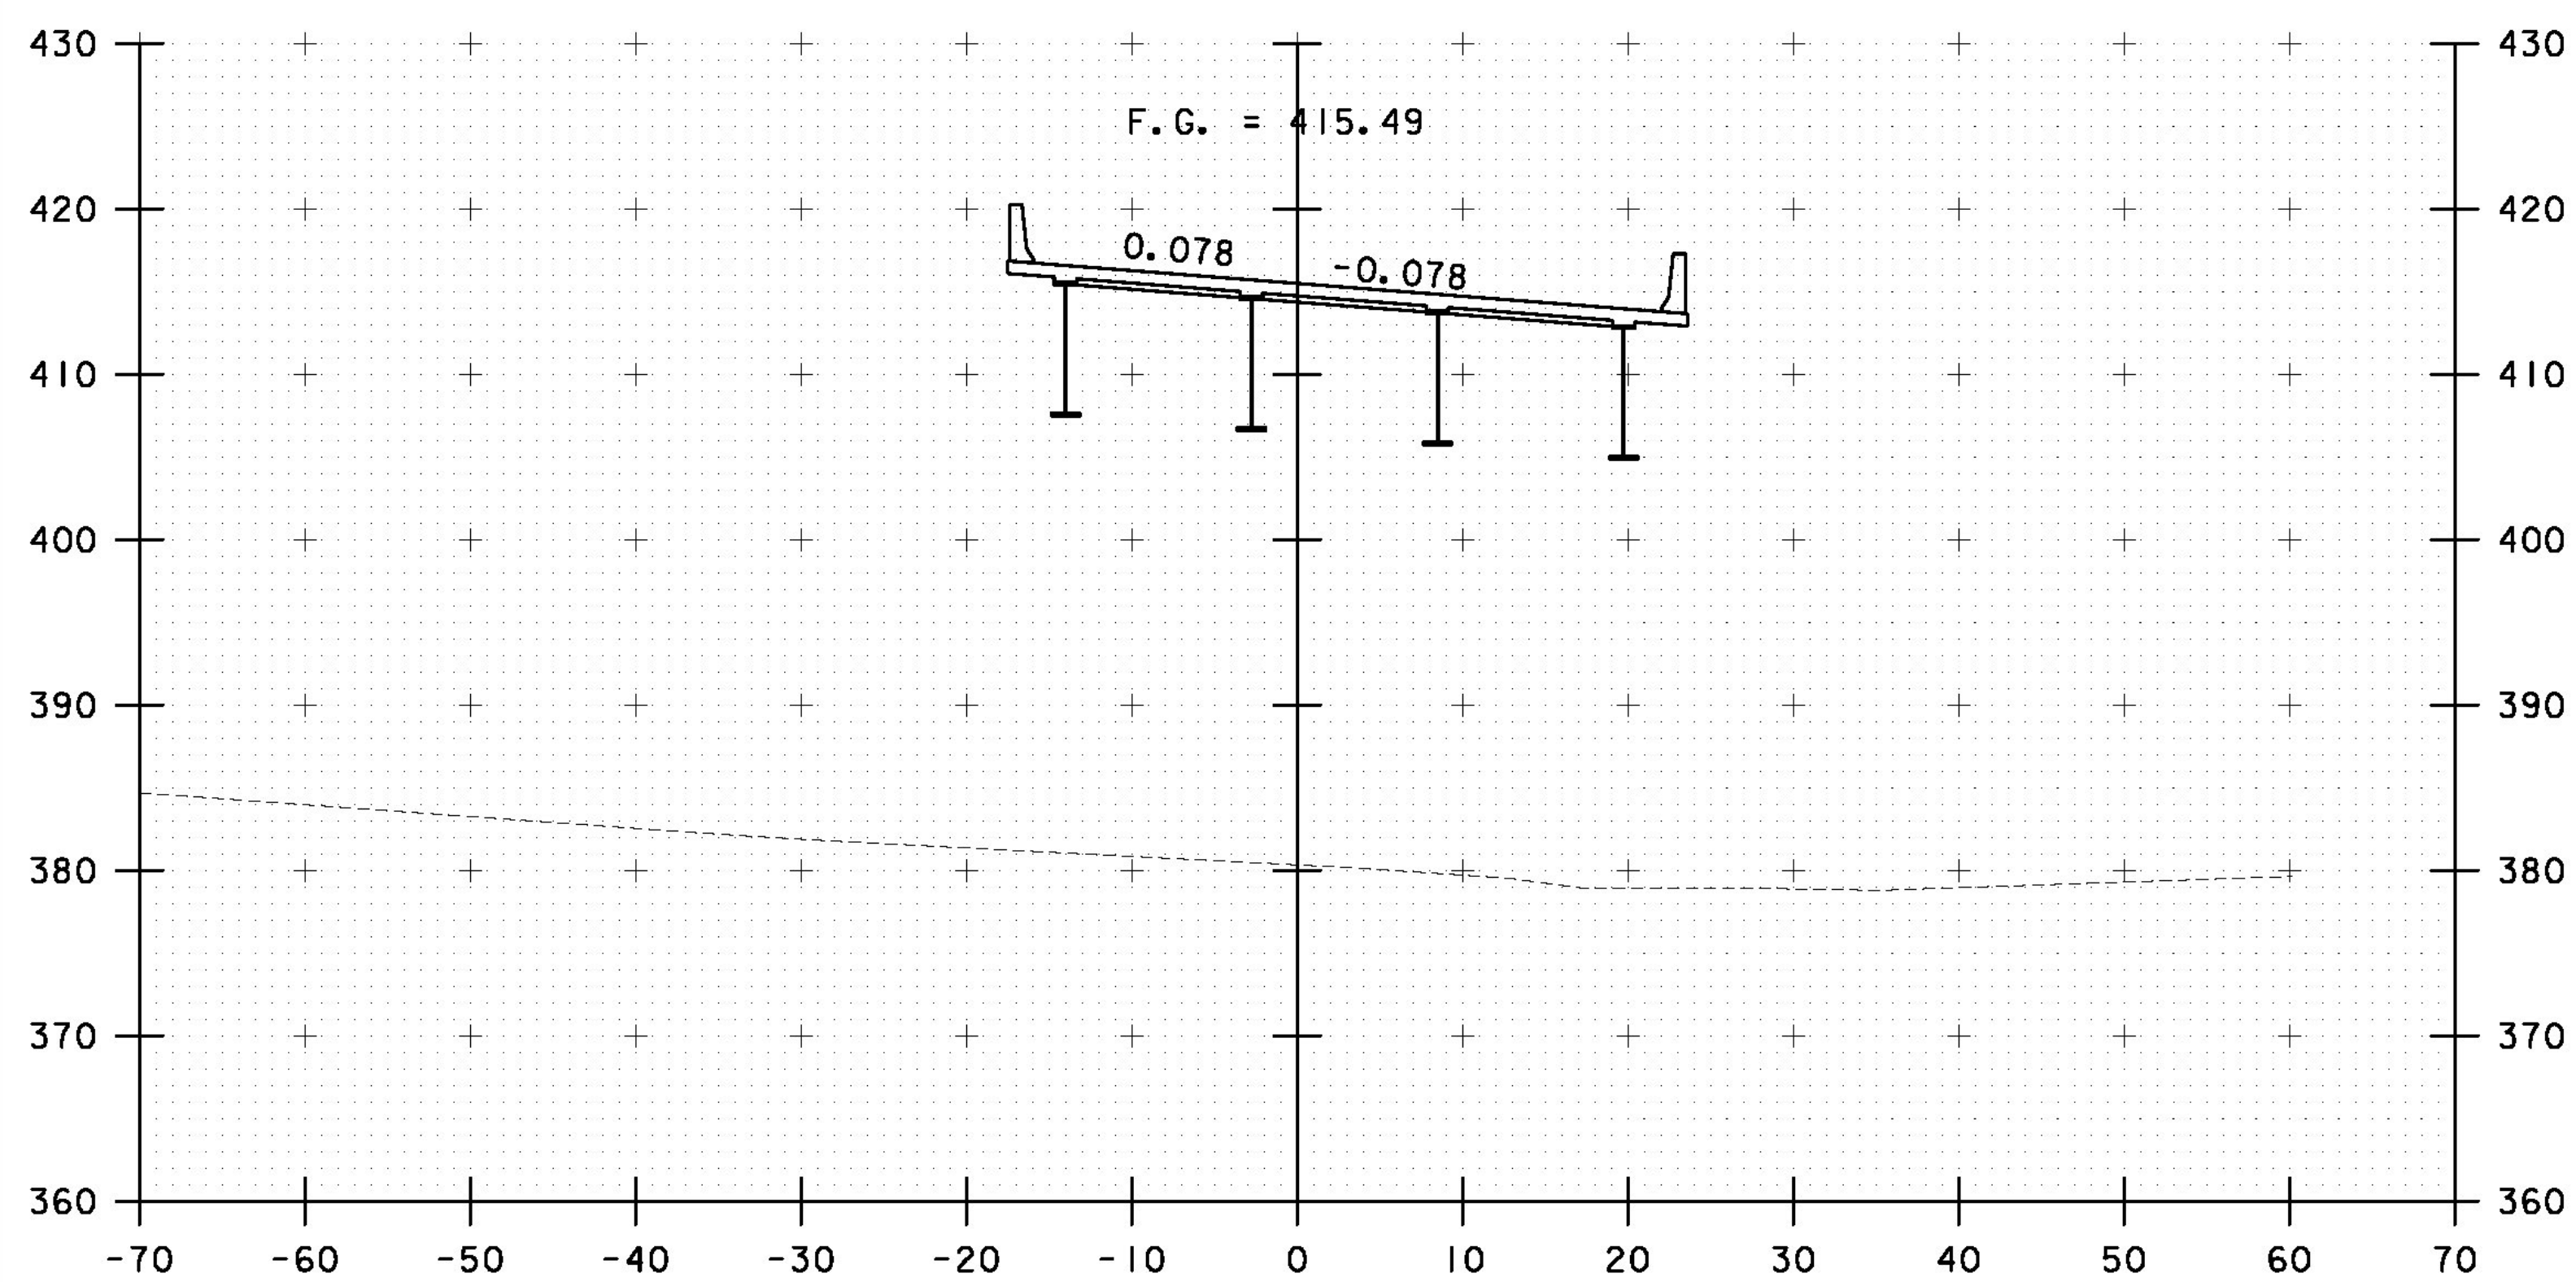


361+00

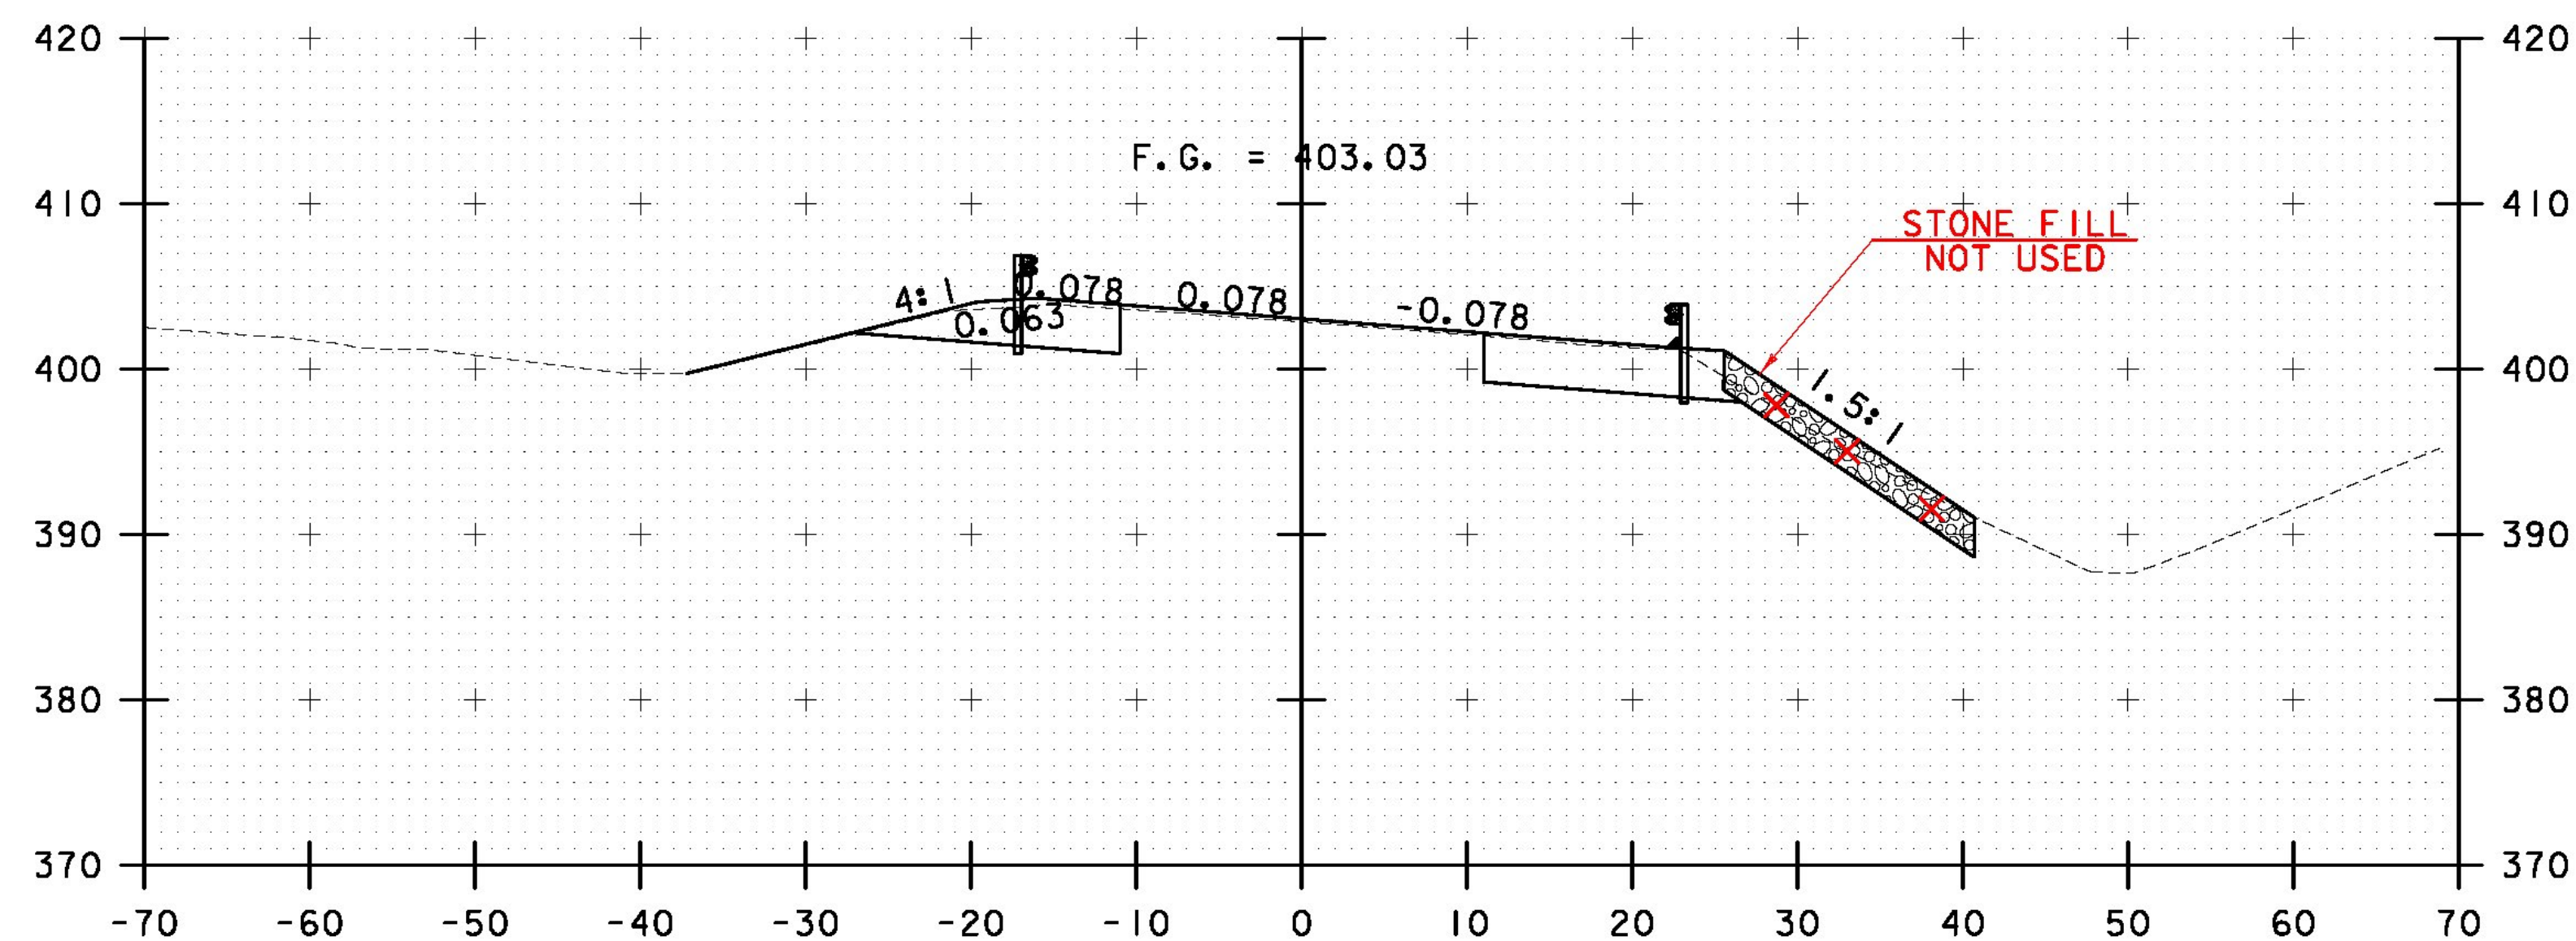


365+00

STA. 365+00 END FULL DEPTH CONSTRUCTION
BEGIN MILL AND OVERLAY

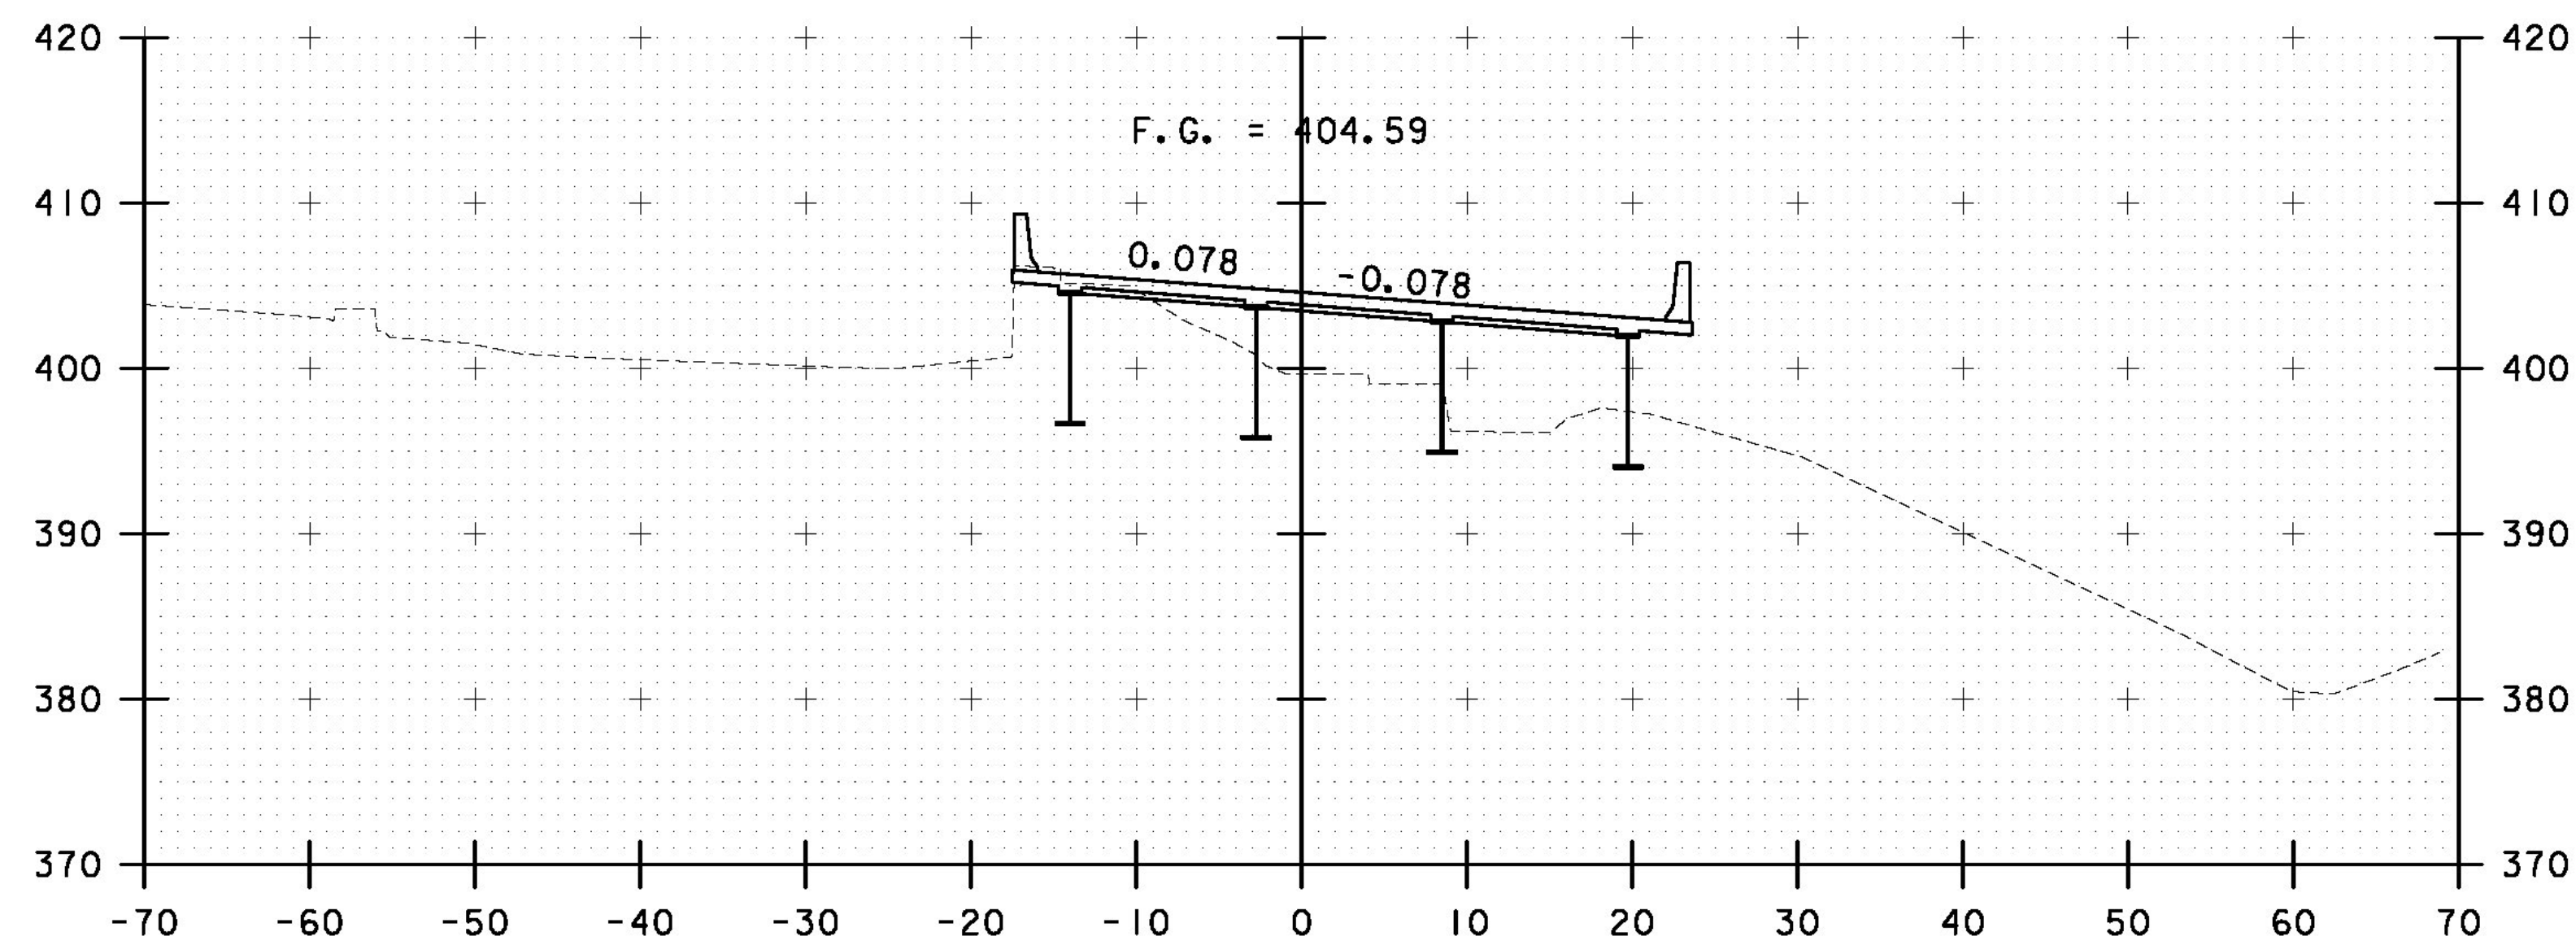

364+50

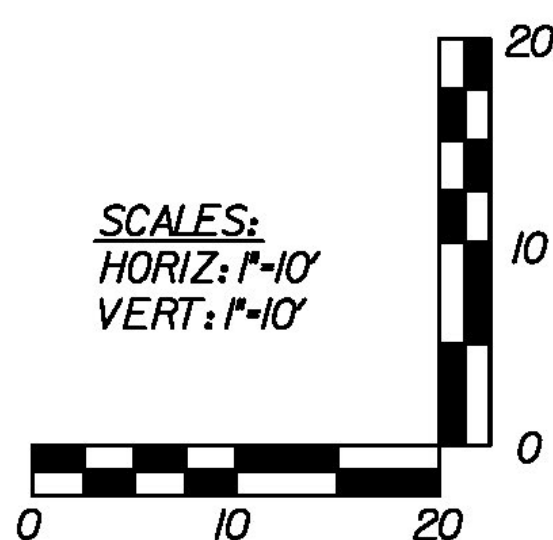

AS BUILT
RECORD PLANS

BECK & BELLUCCI, INC. TYLIN INTERNATIONAL

STA. 361+00 TO STA. 365+00

PROJECT NAME: BRATTLEBORO

PROJECT NUMBER: IM 091-(150)

FILE NAME: HW-NRA-DGN-900.dgn

PROJECT LEADER: Phillip E. Kendall P.E.

DESIGNED BY: Phillip E. Kendall P.E.

CROSS SECTIONS 7 OF 8

PLOT DATE: 5/15/2013

DRAWN BY: A. R. Greenlaw

CHECKED BY: D. Bryant, P.E.

SHEET HW-RA-DGN-906