




538+00

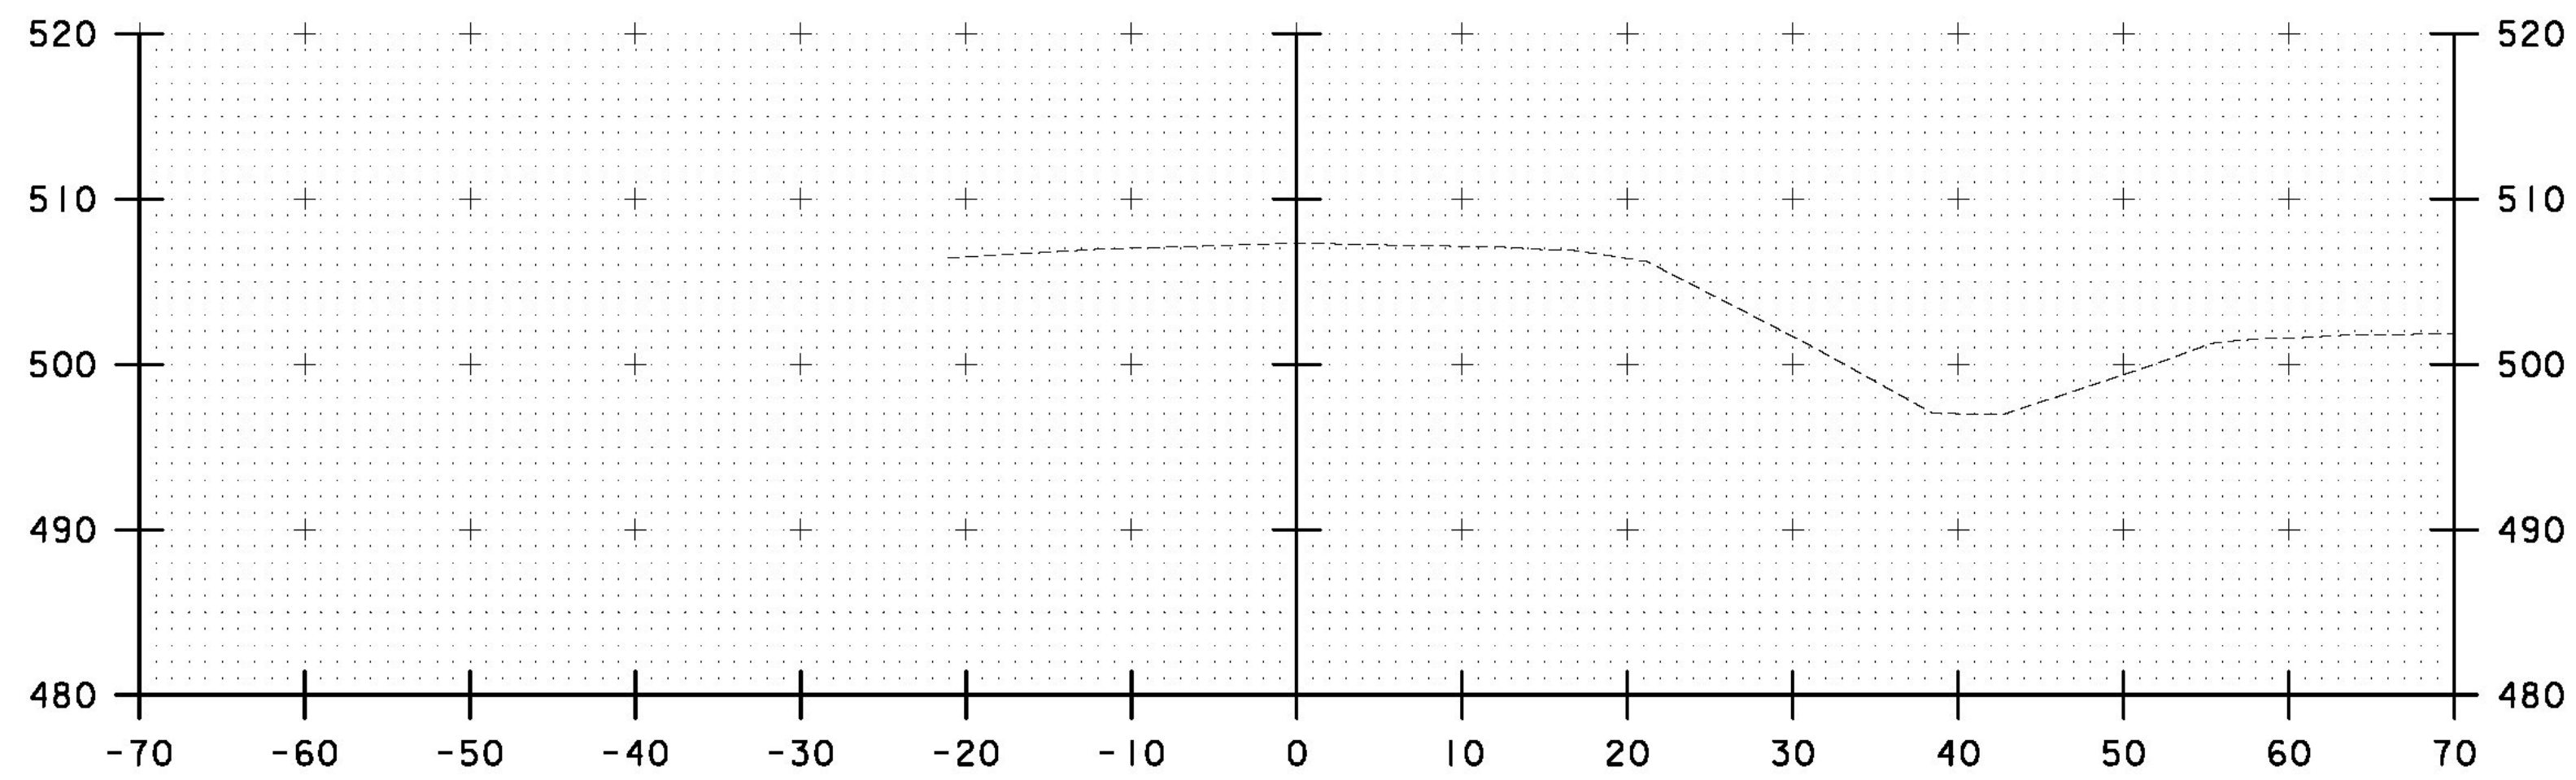

537+50

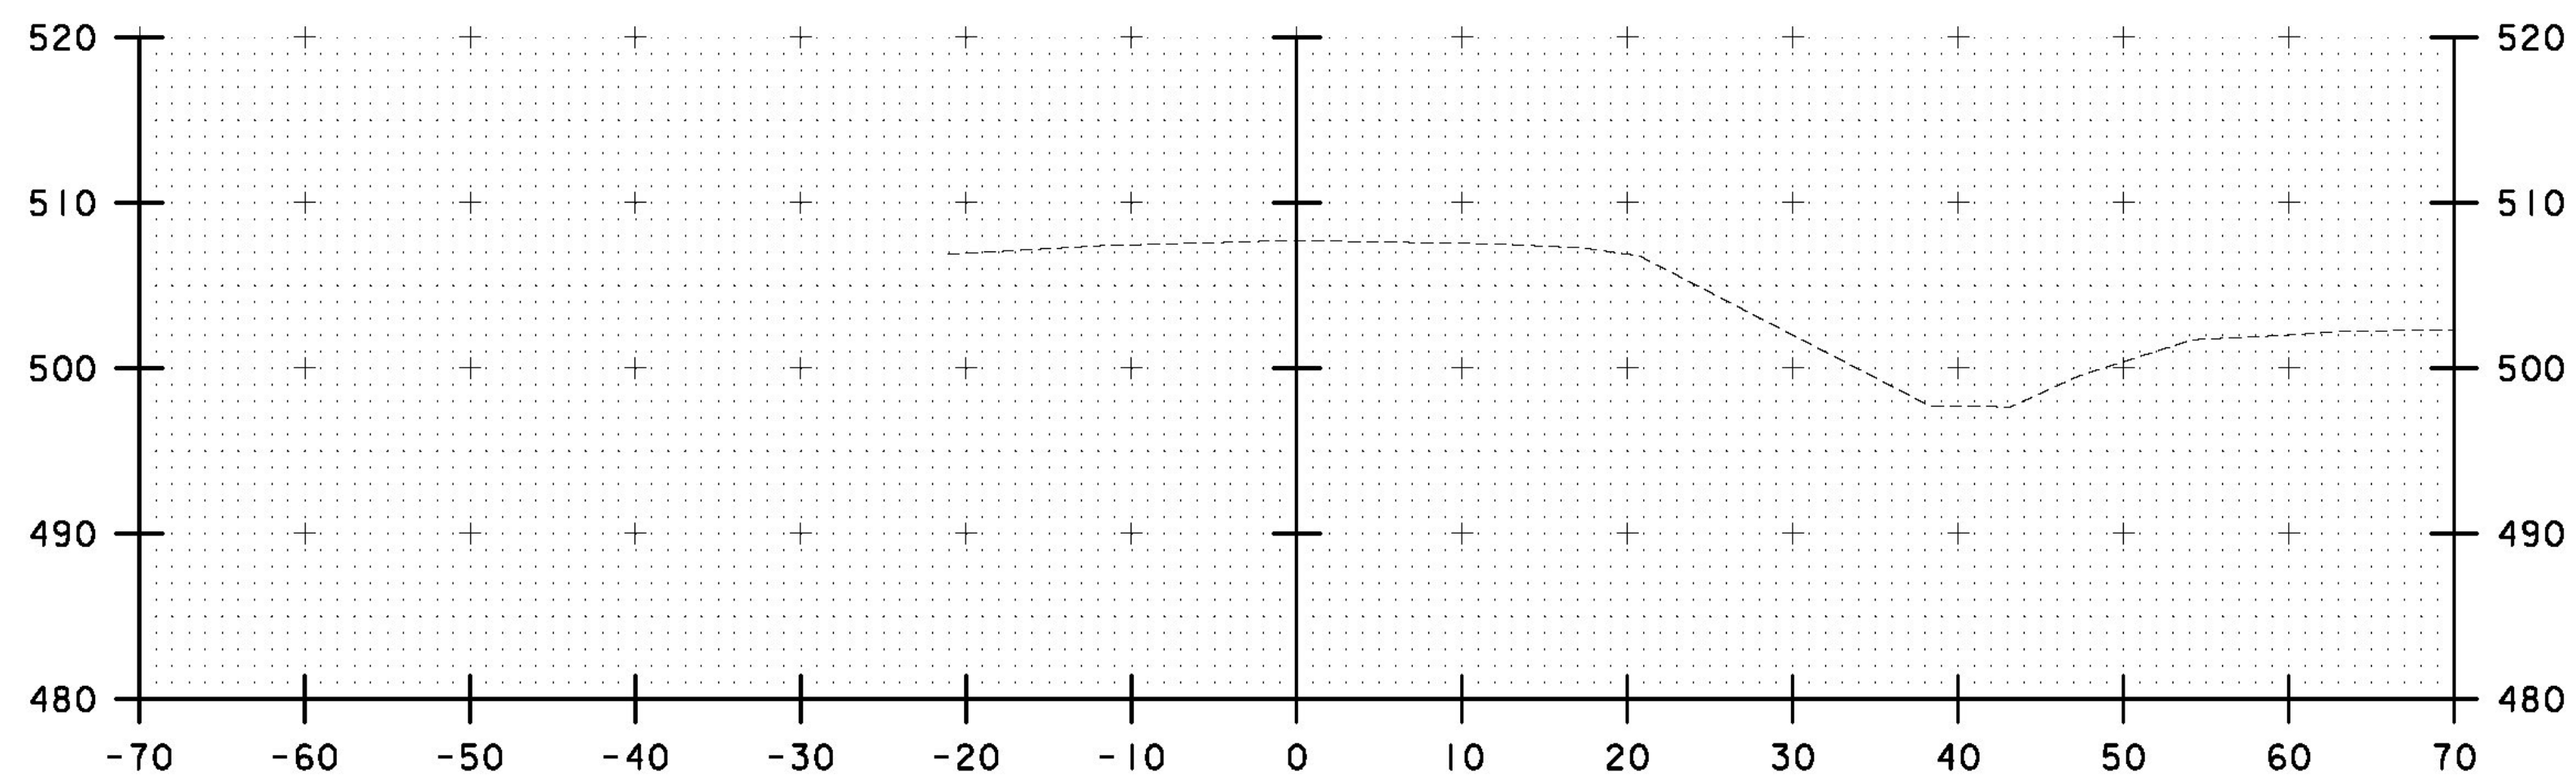


537+00

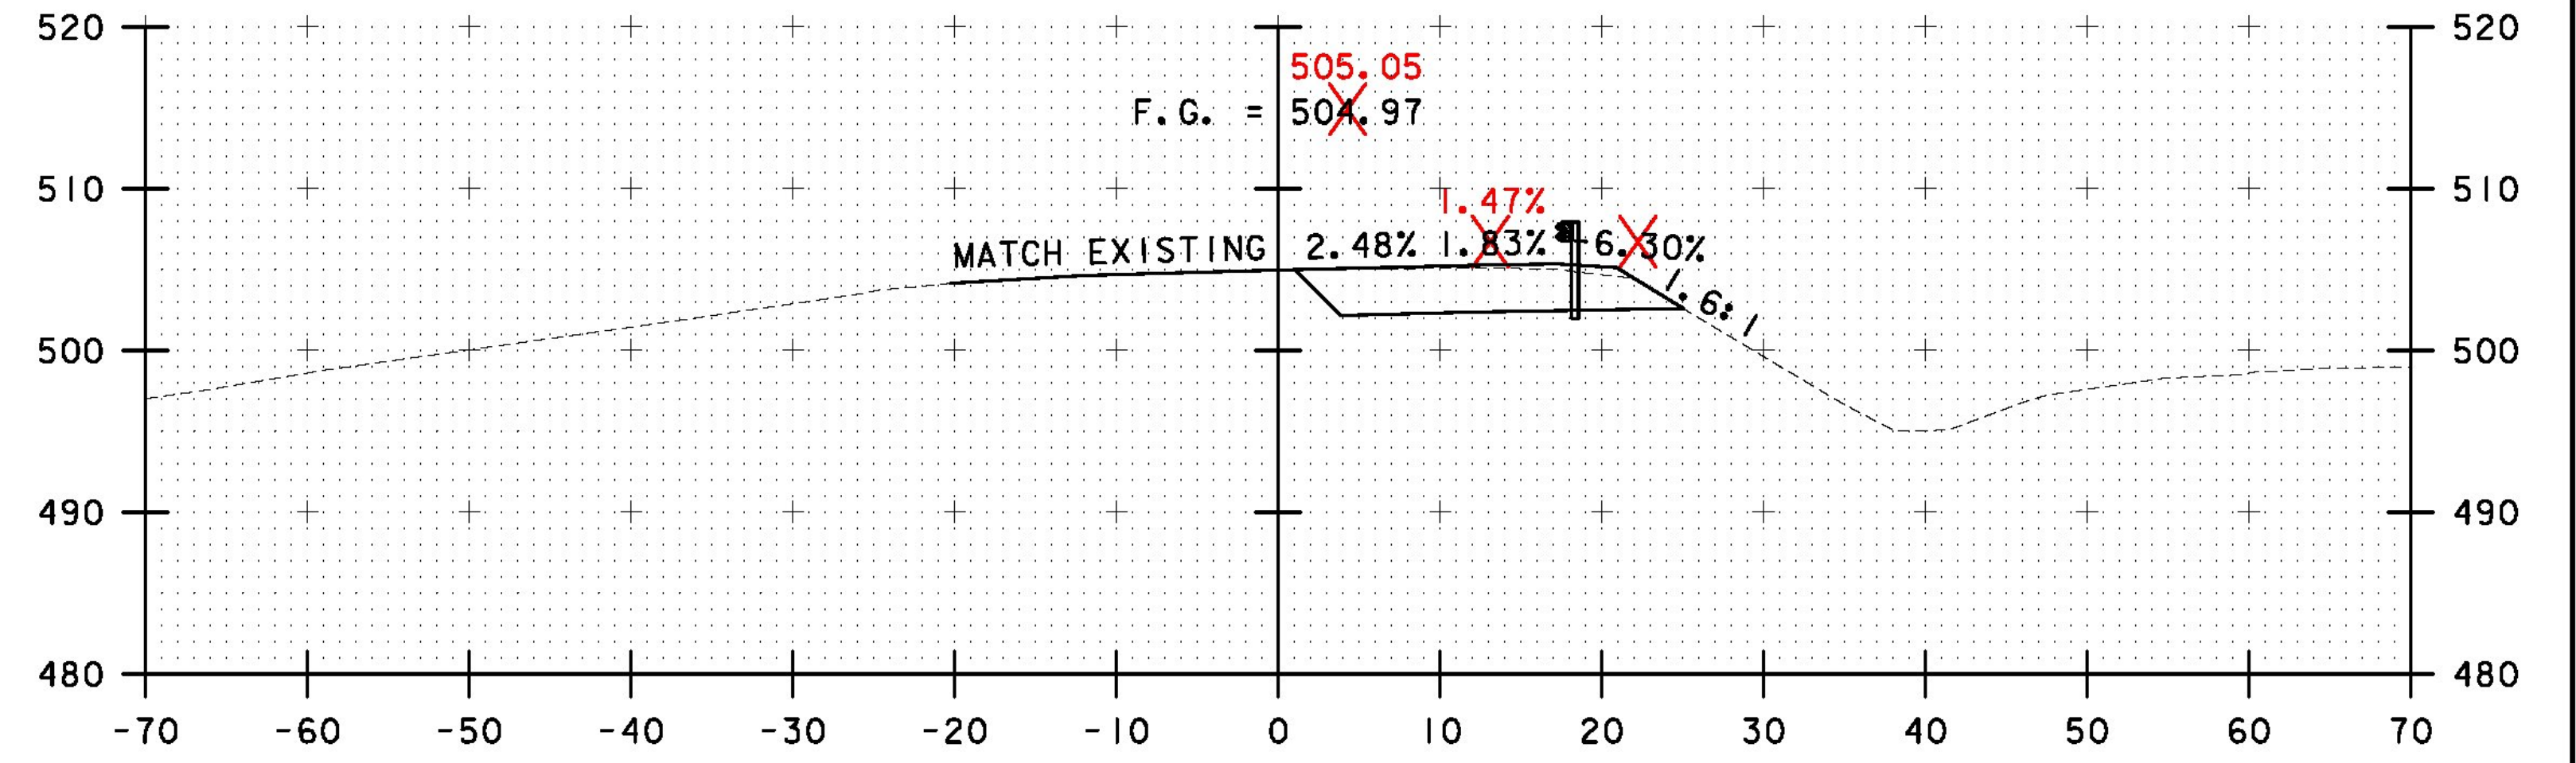


STA 539+50.00
LIMIT OF WORK (LT)
BEGIN MILL AND OVERLAY (LT)

539+50
STA. 539+25
END MILL AND OVERLAY (RT)
BEGIN FULL DEPTH CONSTRUCTION (RT)


~~LIMIT OF WORK (LT)~~
~~BEGIN MILL AND OVERLAY (LT)~~

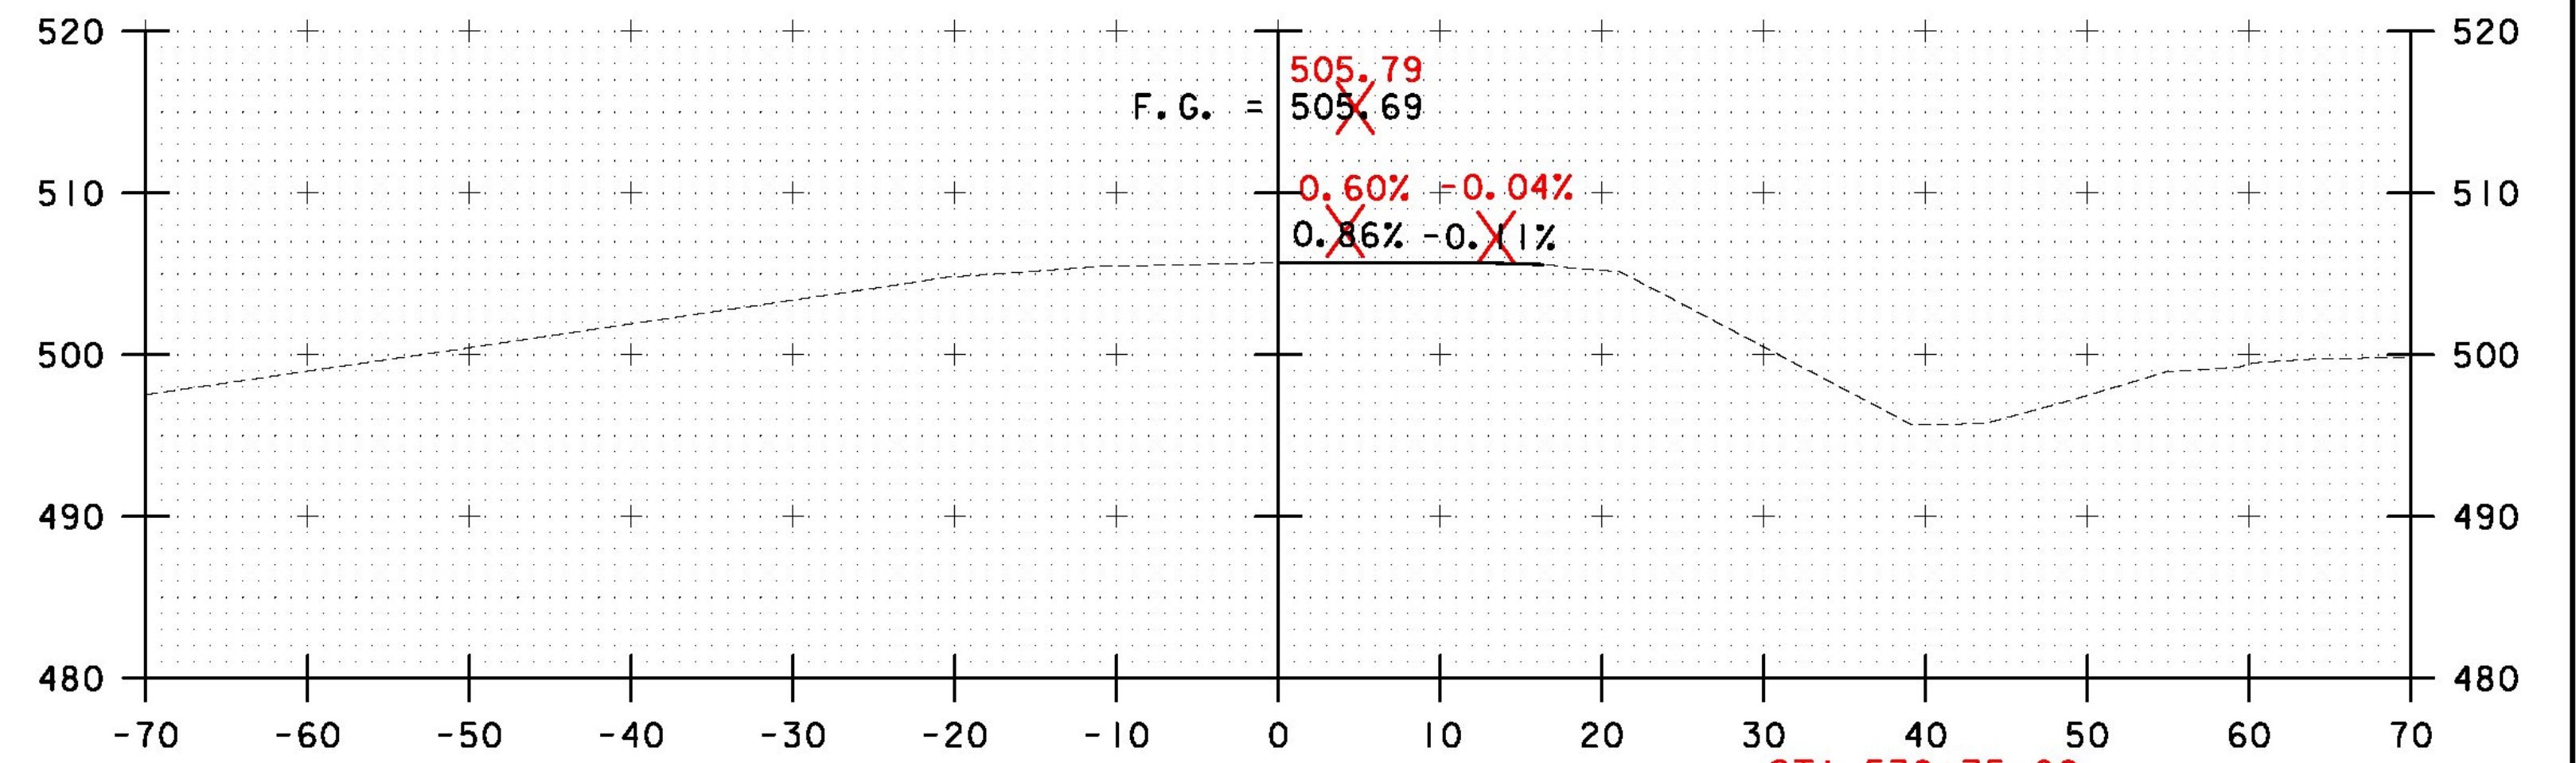

STA 538+75.00
LIMIT OF WORK (RT)
BEGIN MILL AND OVERLAY (RT)

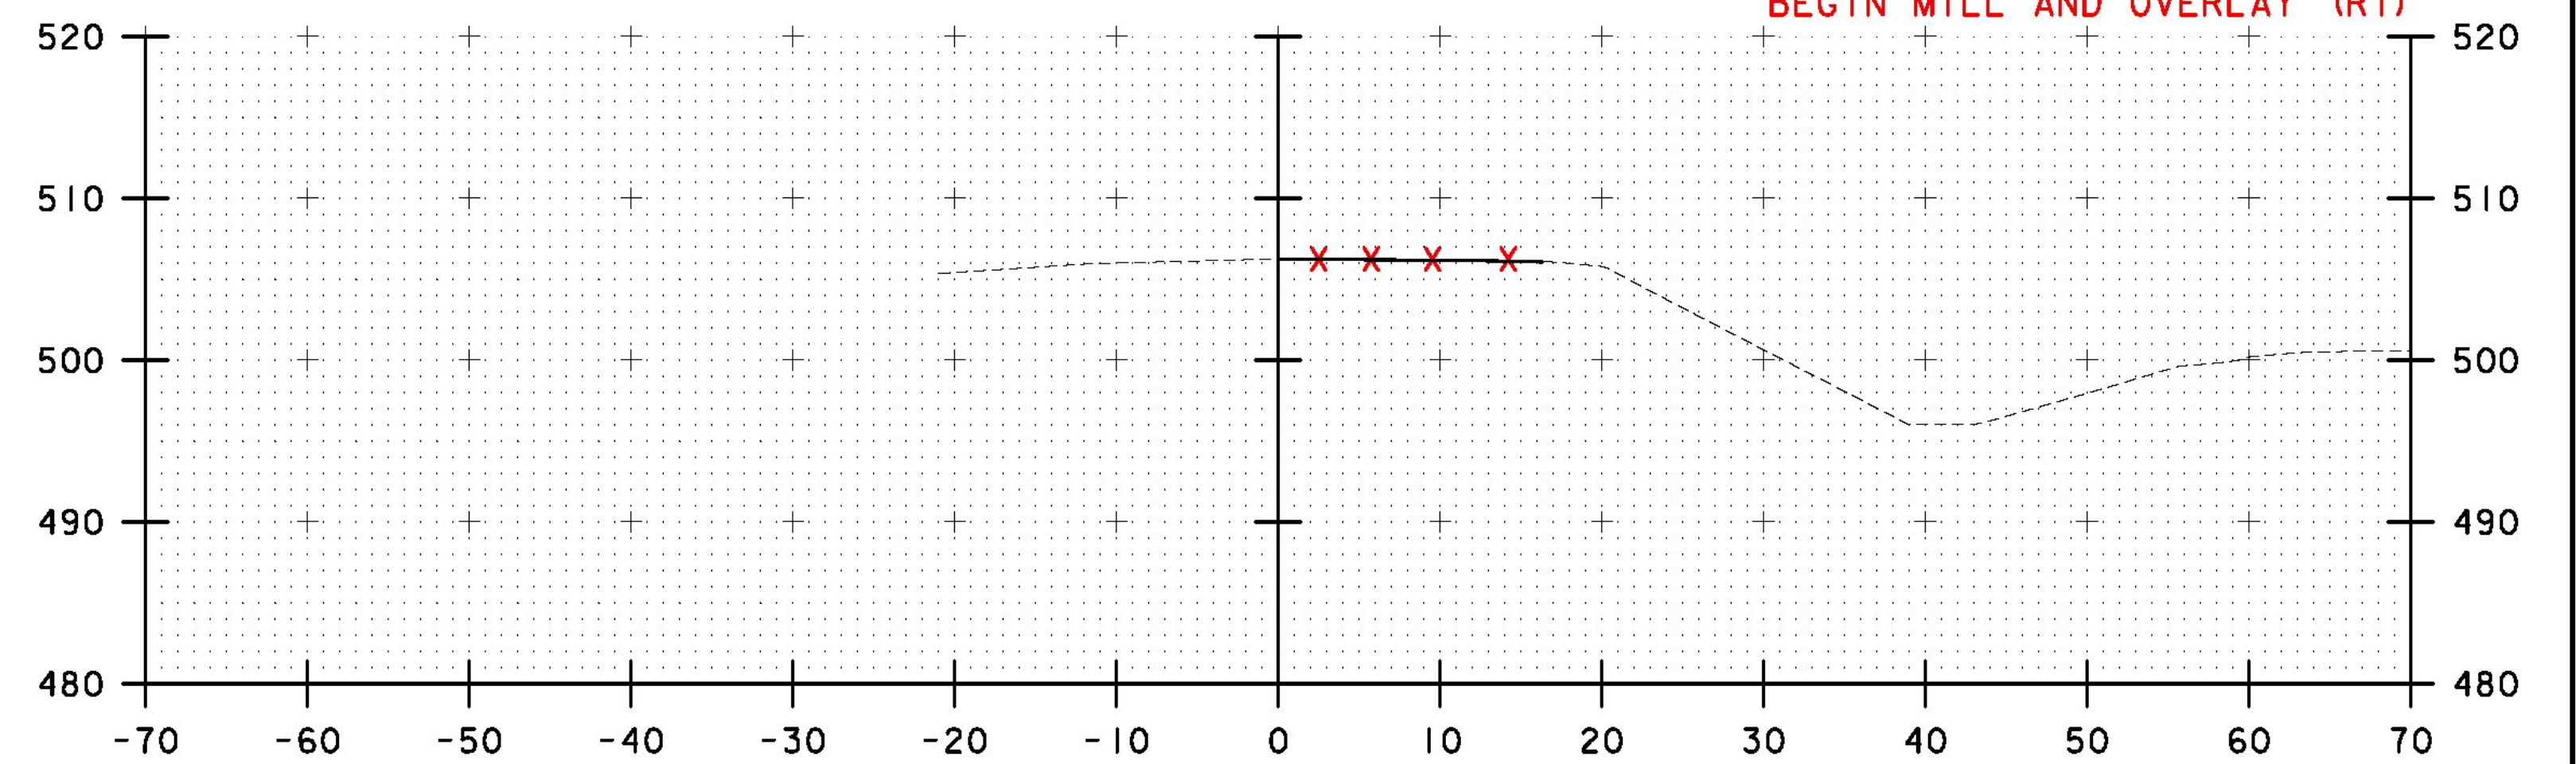

538+50
~~LIMIT OF WORK (RT)~~
~~BEGIN MILL AND OVERLAY (RT)~~

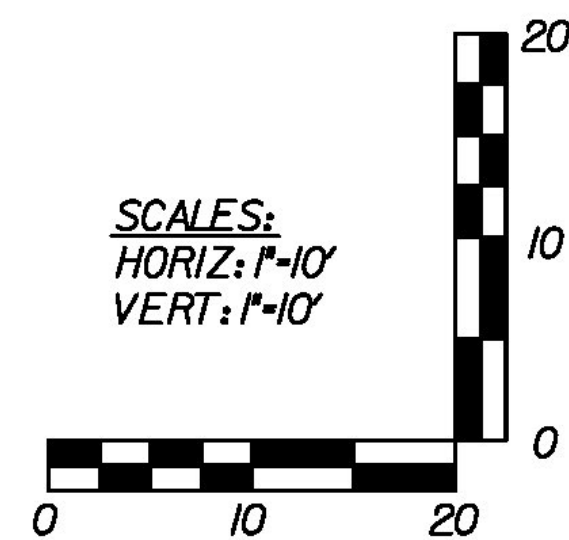

AS BUILT
RECORD PLANS

BECK & BELLUCCI, INC.

TYLIN INTERNATIONAL

STA. 537+00 TO STA. 539+50

PROJECT NAME: BRATTLEBORO

PROJECT NUMBER: IM 091-(50)

FILE NAME: HW-SRA-DGN-900.dgn

PROJECT LEADER: Phillip E. Kendall P.E.

DESIGNED BY: Phillip E. Kendall P.E.

CROSS SECTIONS 1 OF 7

PLOT DATE: 2/22/2013

DRAWN BY: J. Davis

CHECKED BY: D. Bryant, P.E.

SHEET HW-SRA-DGN-901