



540+50

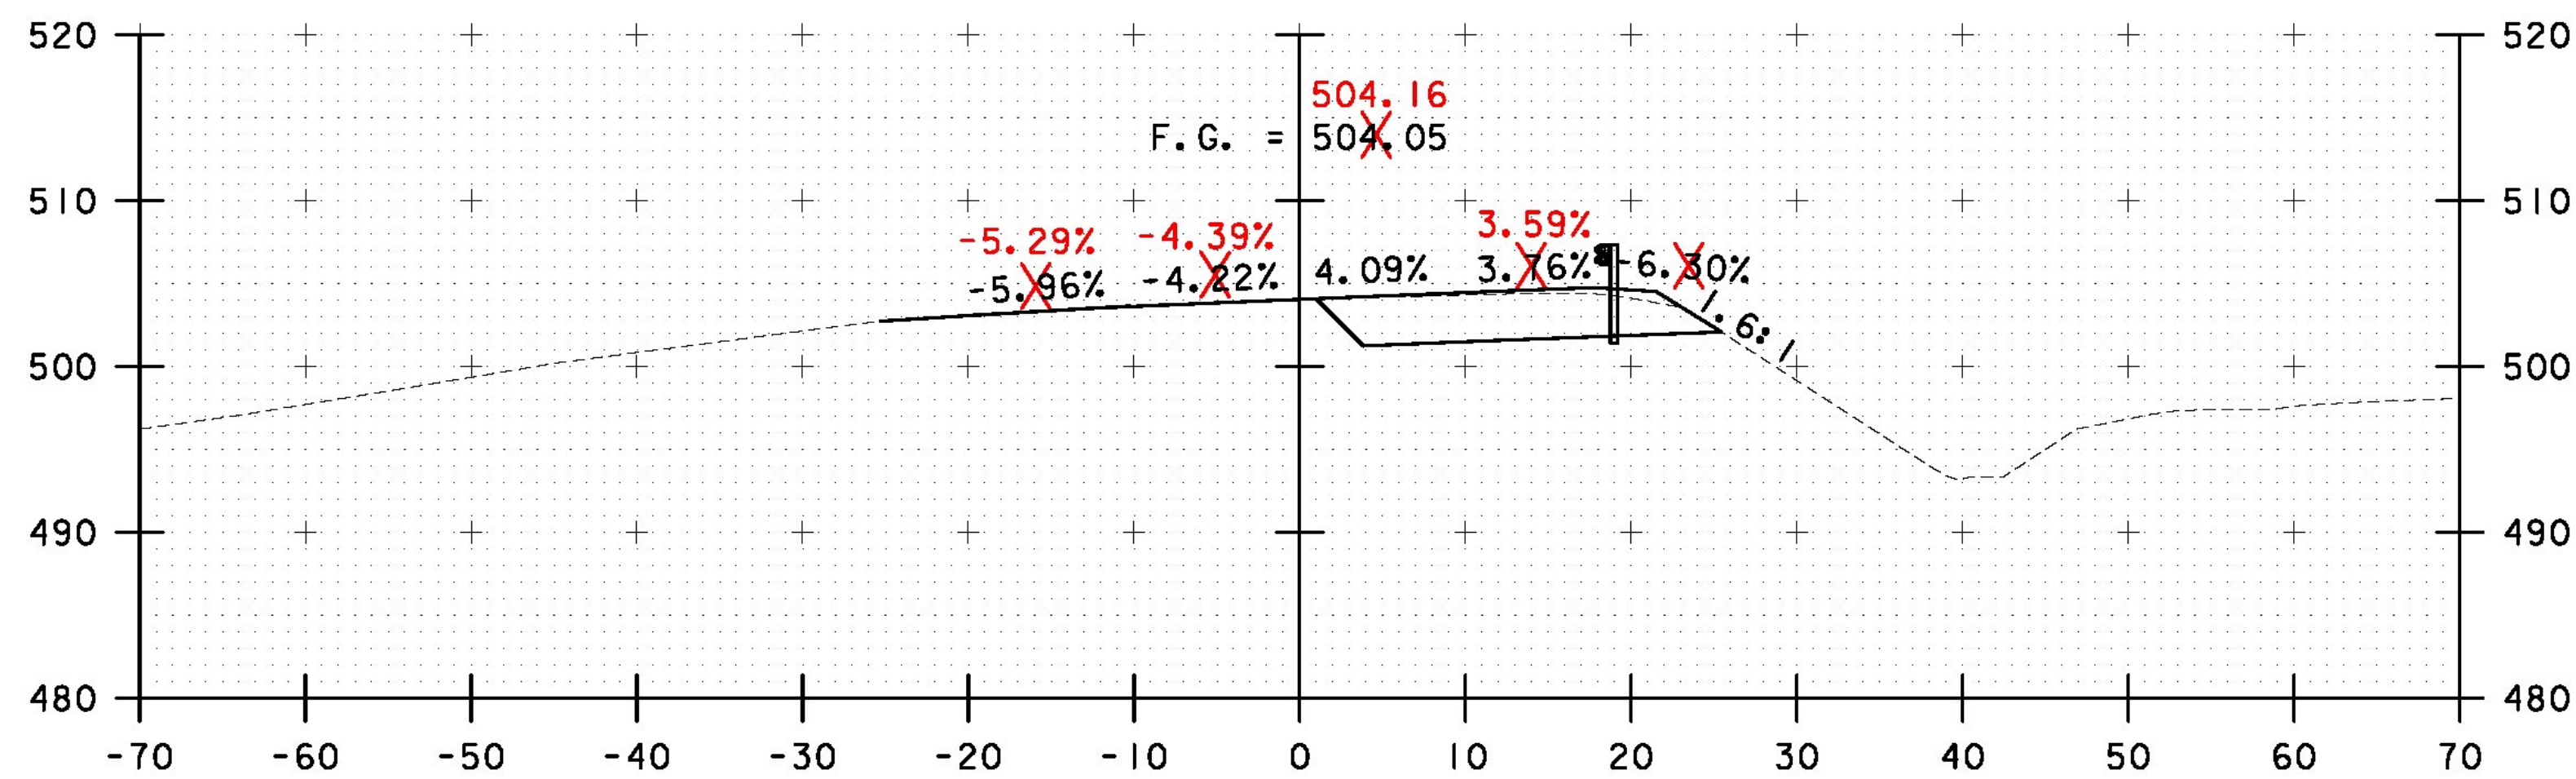


540+00


END MILL AND OVERLAY (LT)
BEGIN FULL DEPTH CONSTRUCTION (LT)

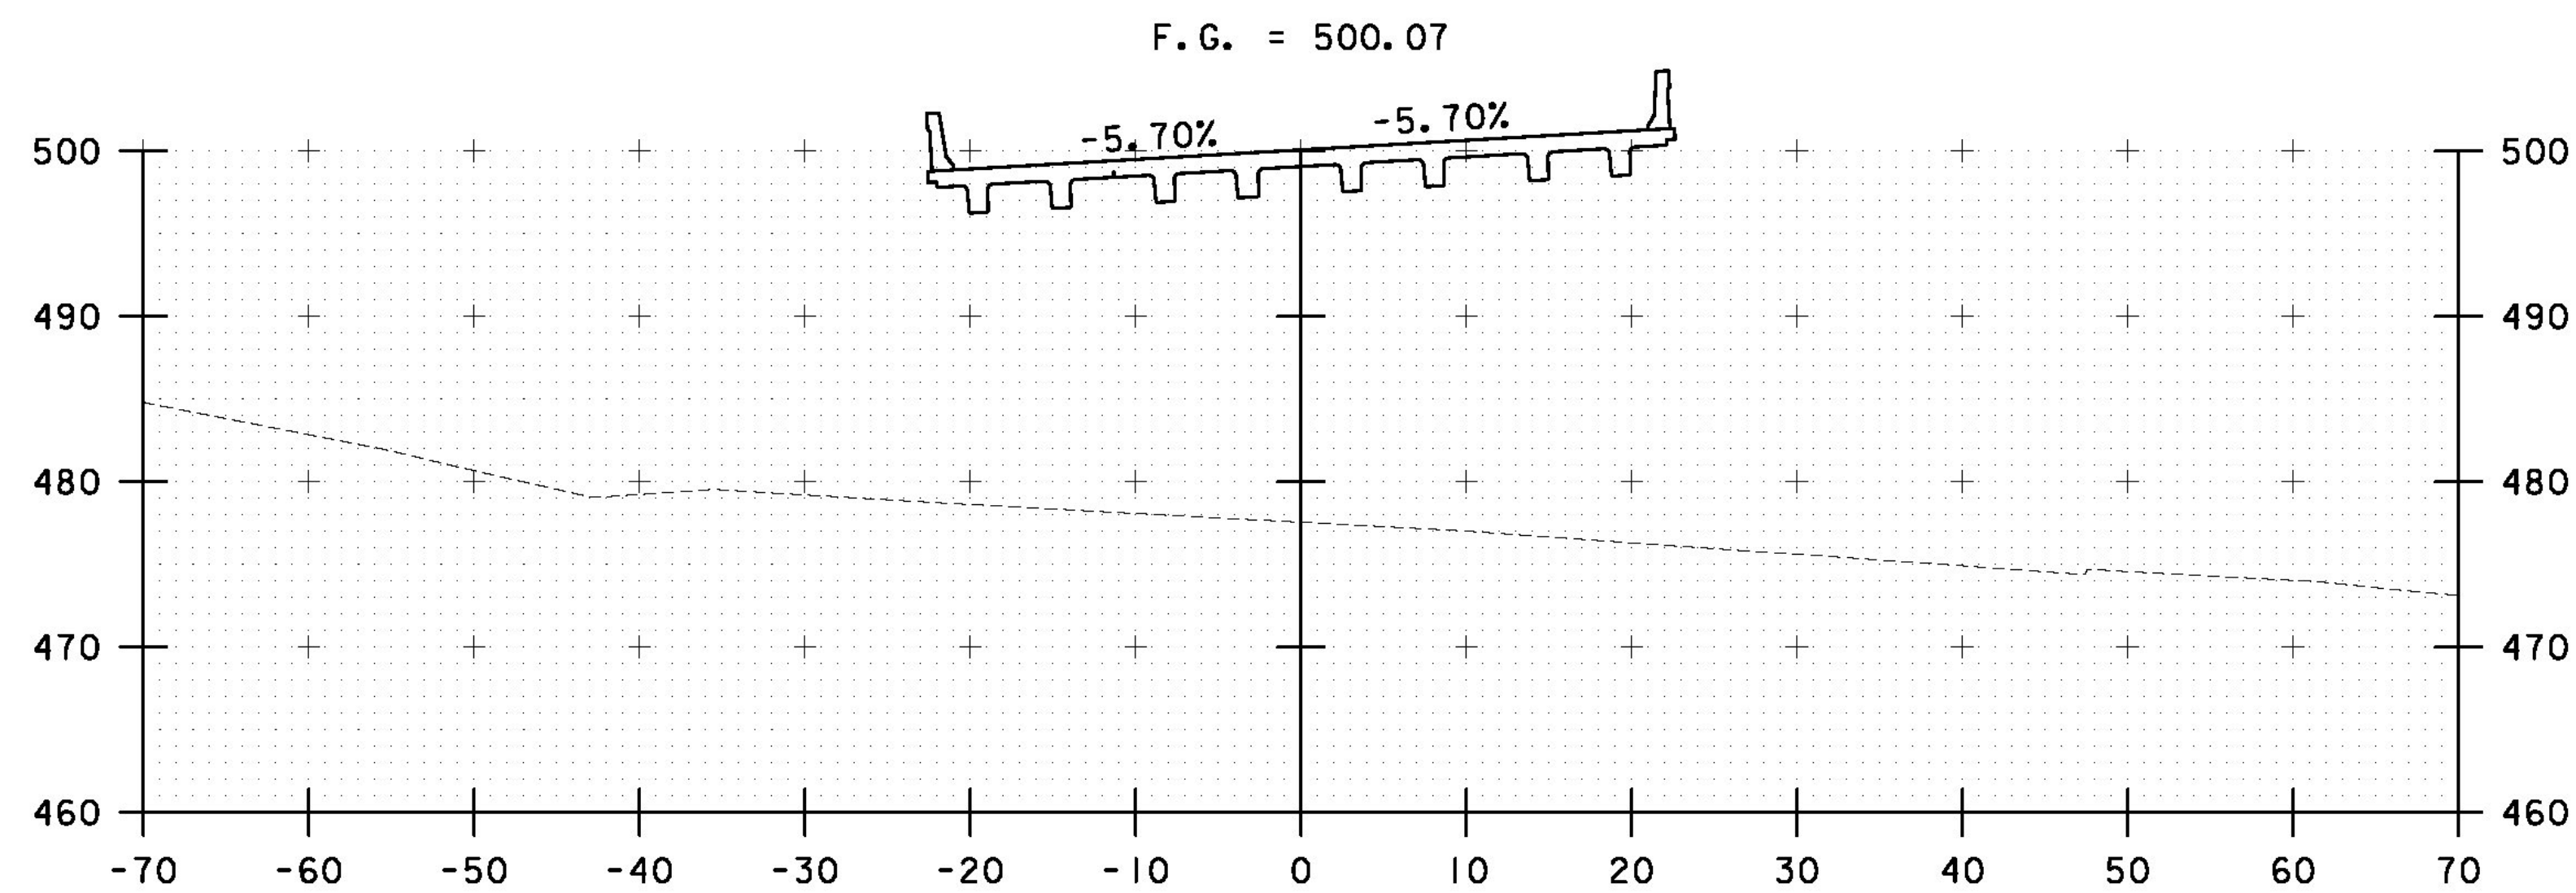

541+50

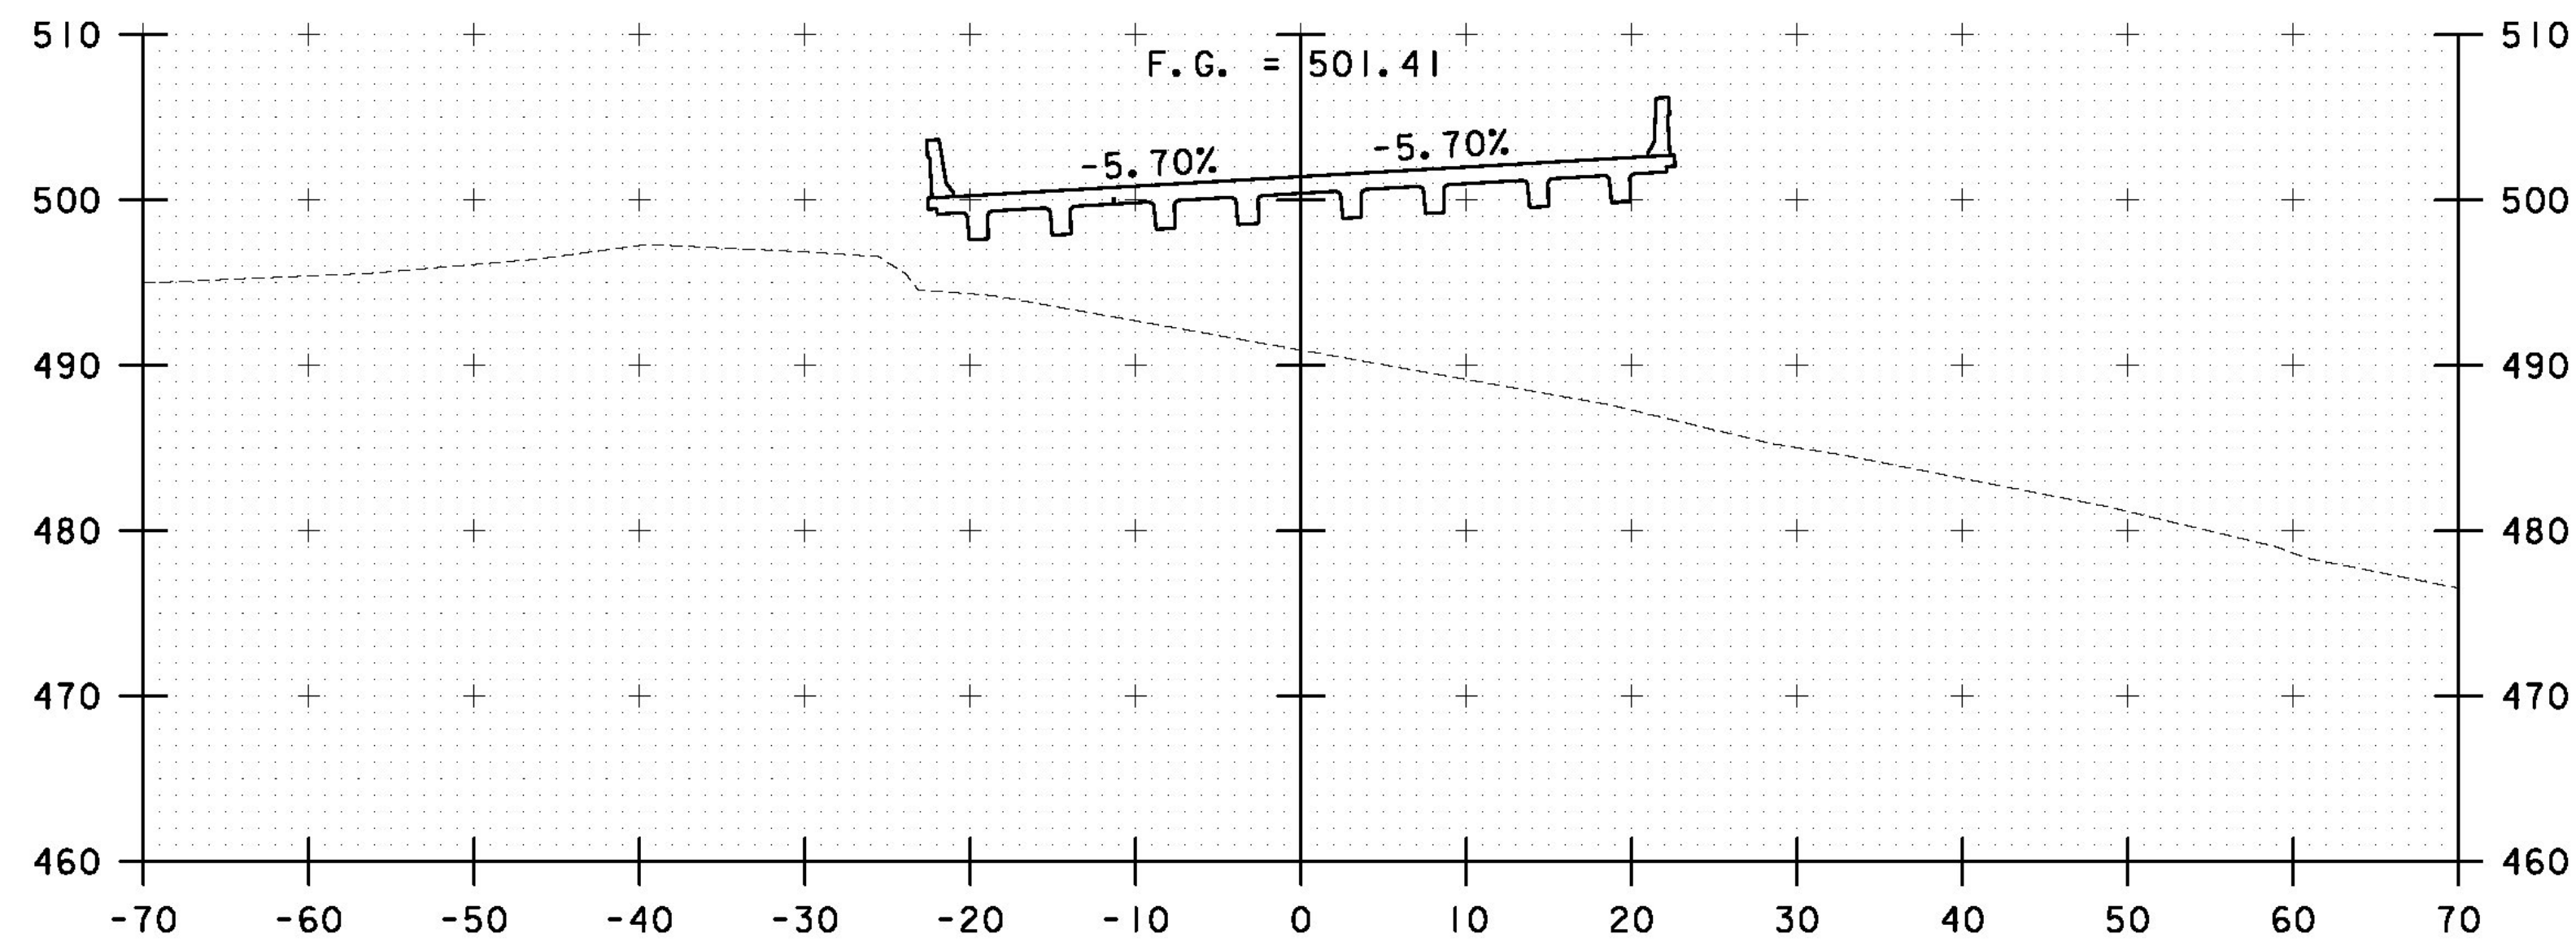

541+00

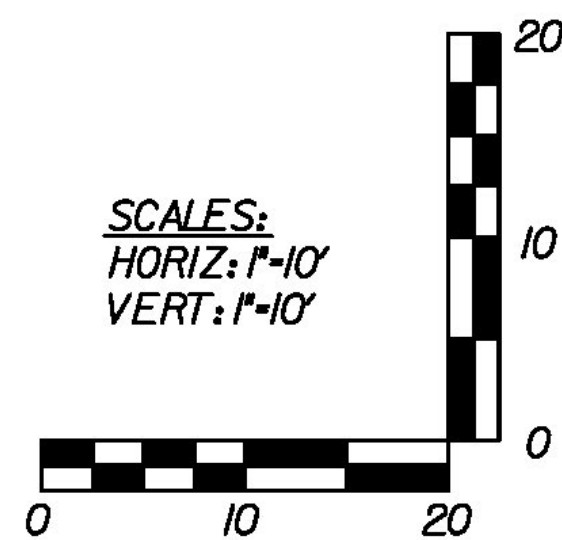

AS BUILT
RECORD PLANS

BECK & BELLUCCI, INC.

TYLIN INTERNATIONAL

STA. 540+00 TO STA. 541+50

PROJECT NAME: BRATTLEBORO

PROJECT NUMBER: IM 091-(150)

FILE NAME: HW-SRA-DGN-900.dgn

PROJECT LEADER: Phillip E. Kendall P.E.

DESIGNED BY: Phillip E. Kendall P.E.

CROSS SECTIONS 2 OF 7

PLOT DATE: 2/22/2013

DRAWN BY: J. Davis

CHECKED BY: D. Bryant, P.E.

SHEET HW-SRA-DGN-902