




543+00  
 END FULL DEPTH CONSTRUCTION  
 BEGIN MILL AND OVERLAY

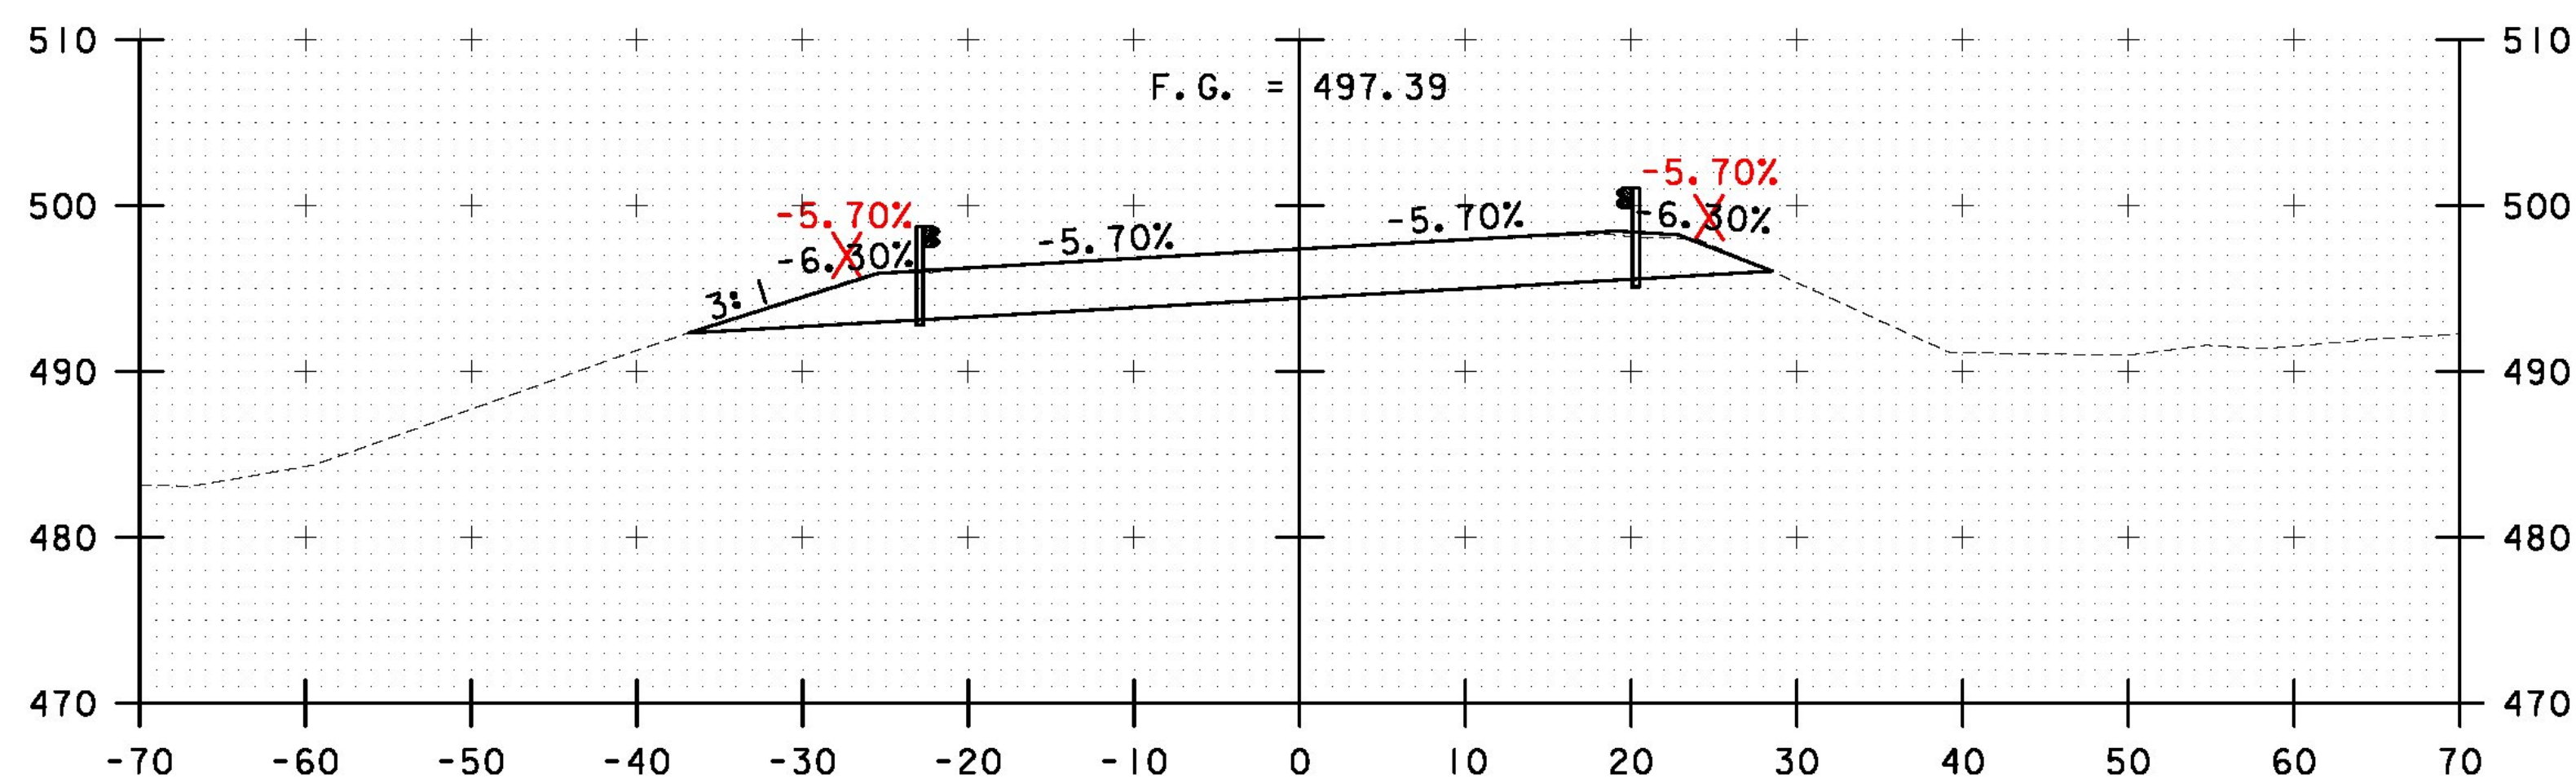


542+50

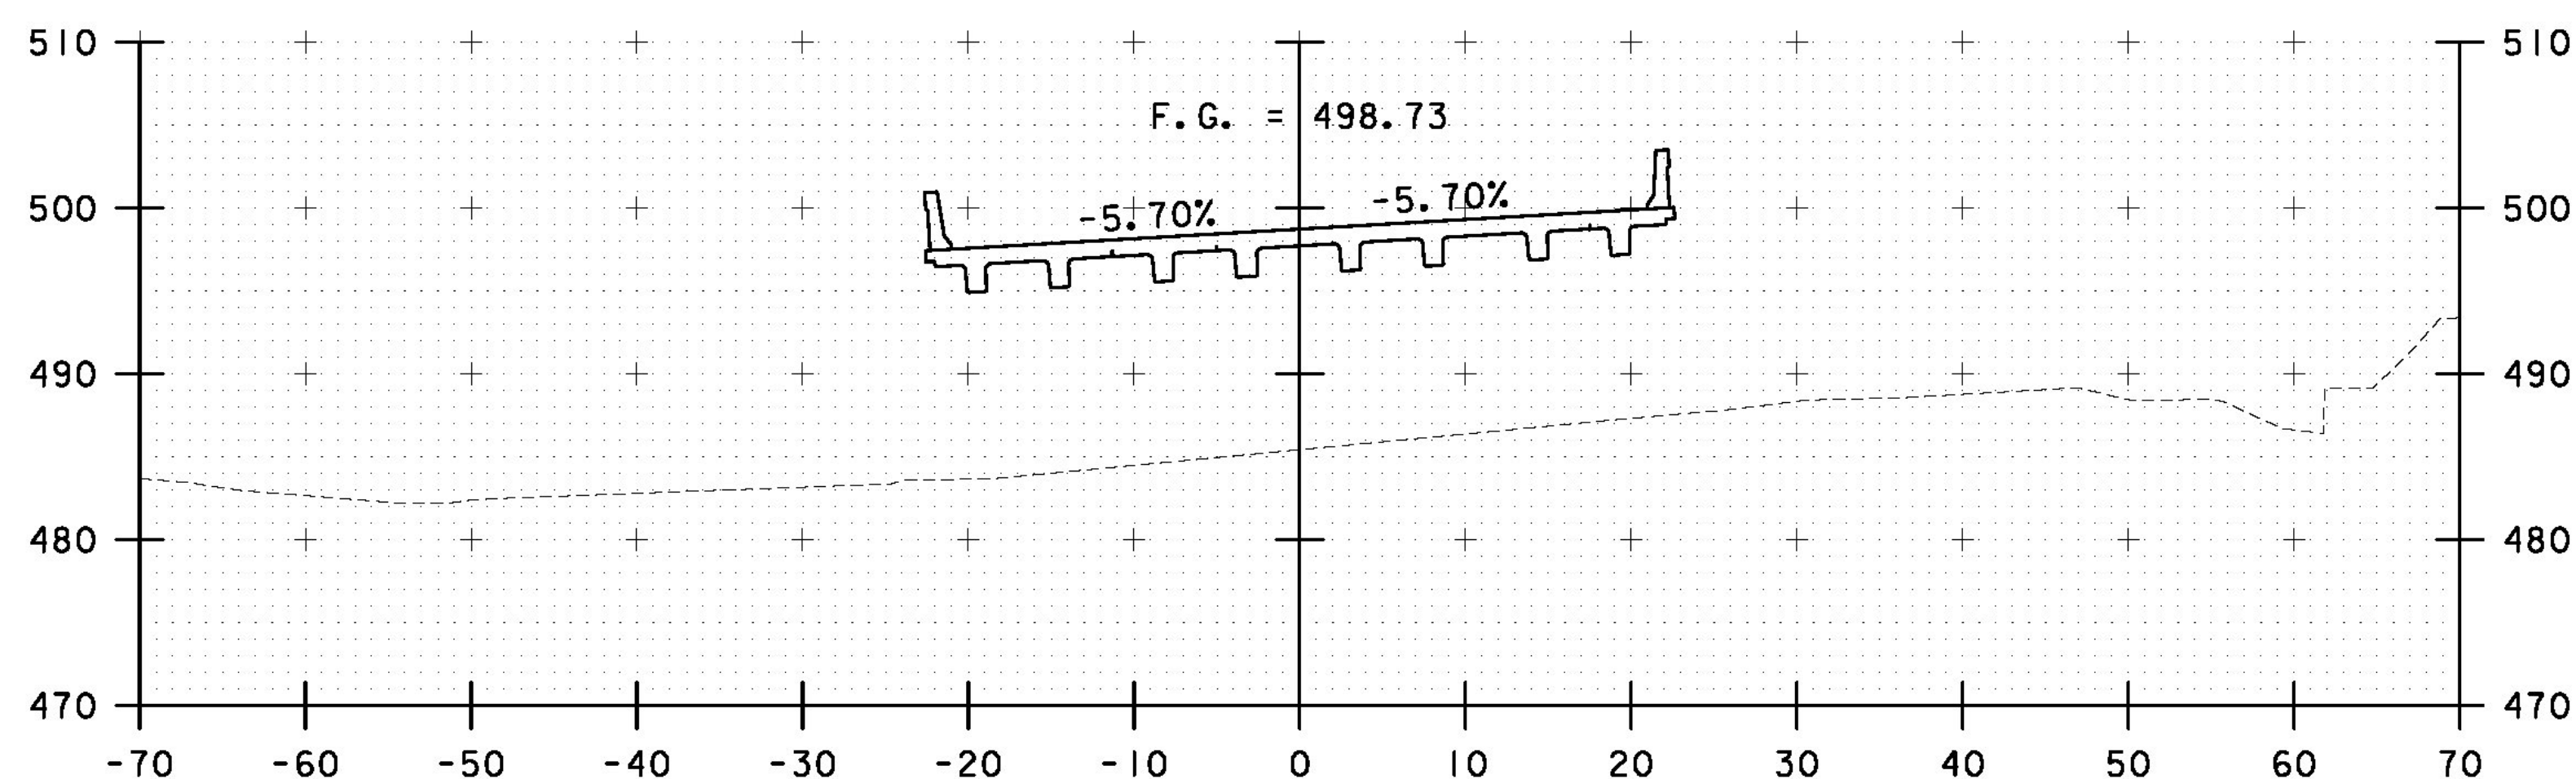


542+00

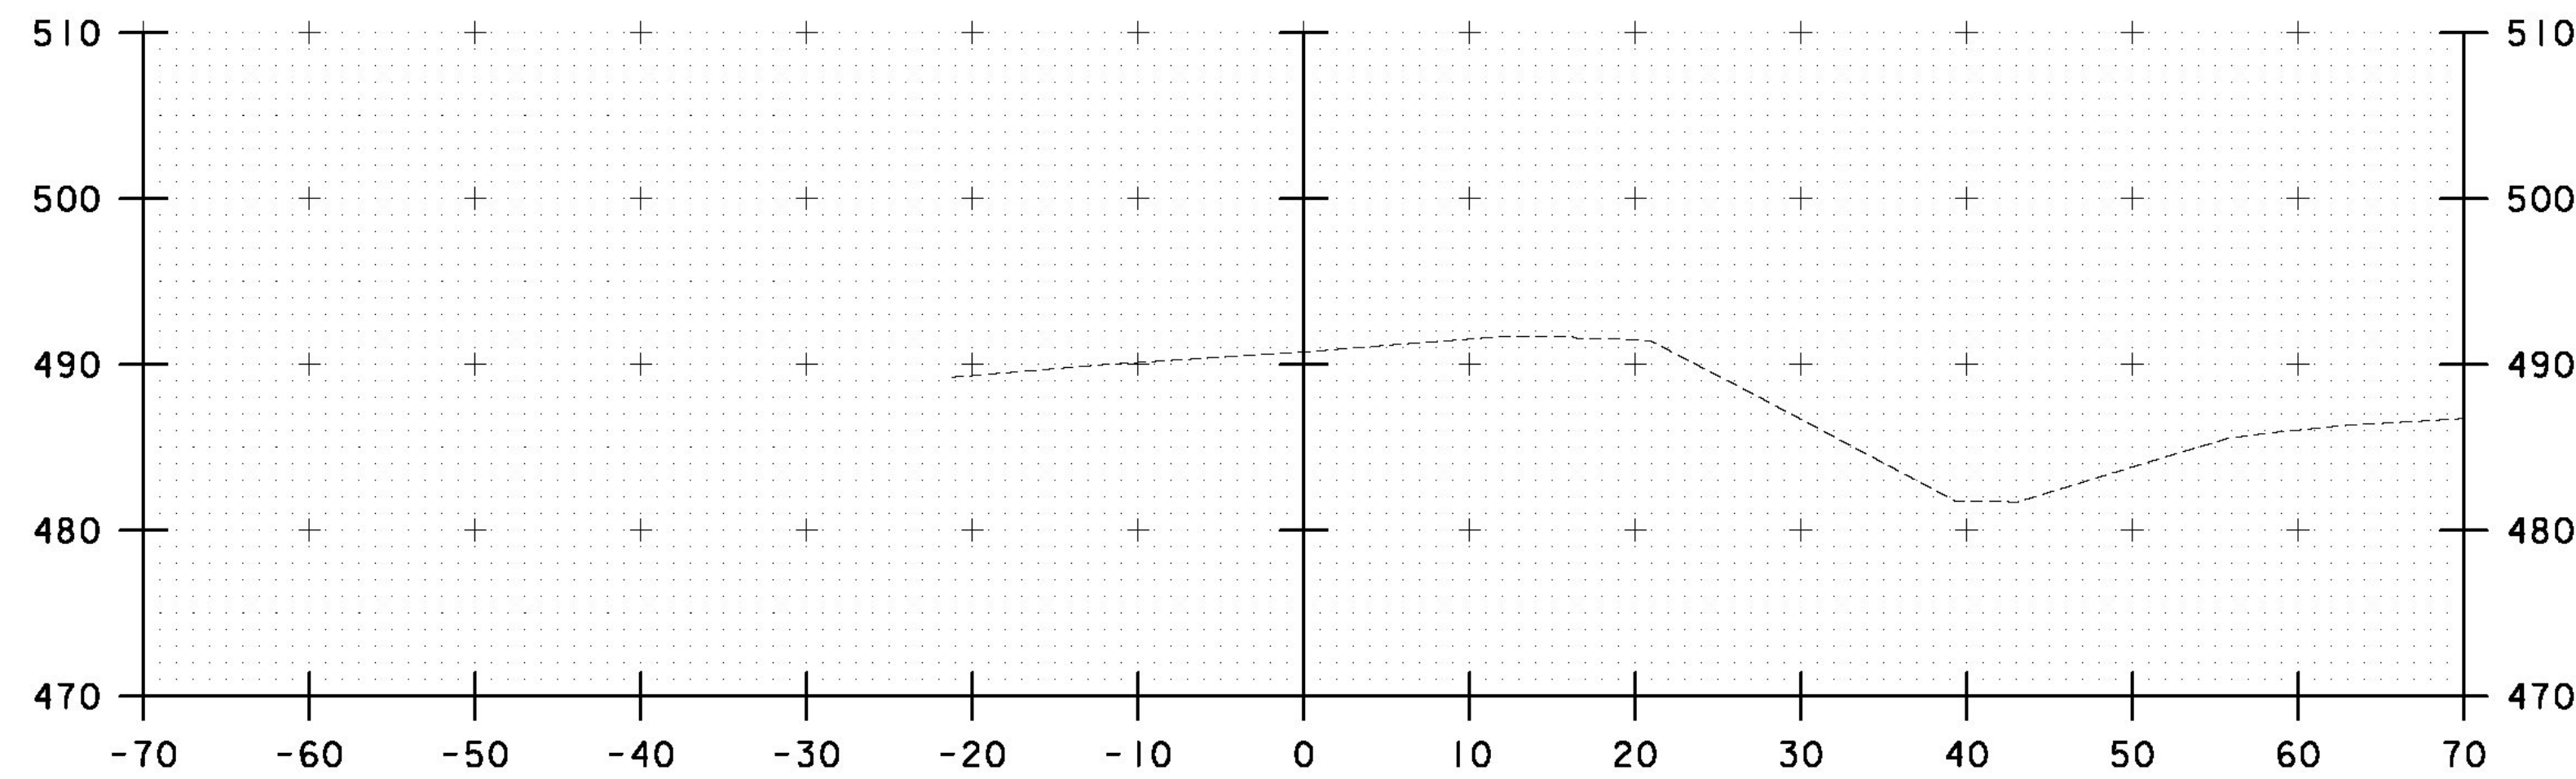


544+50

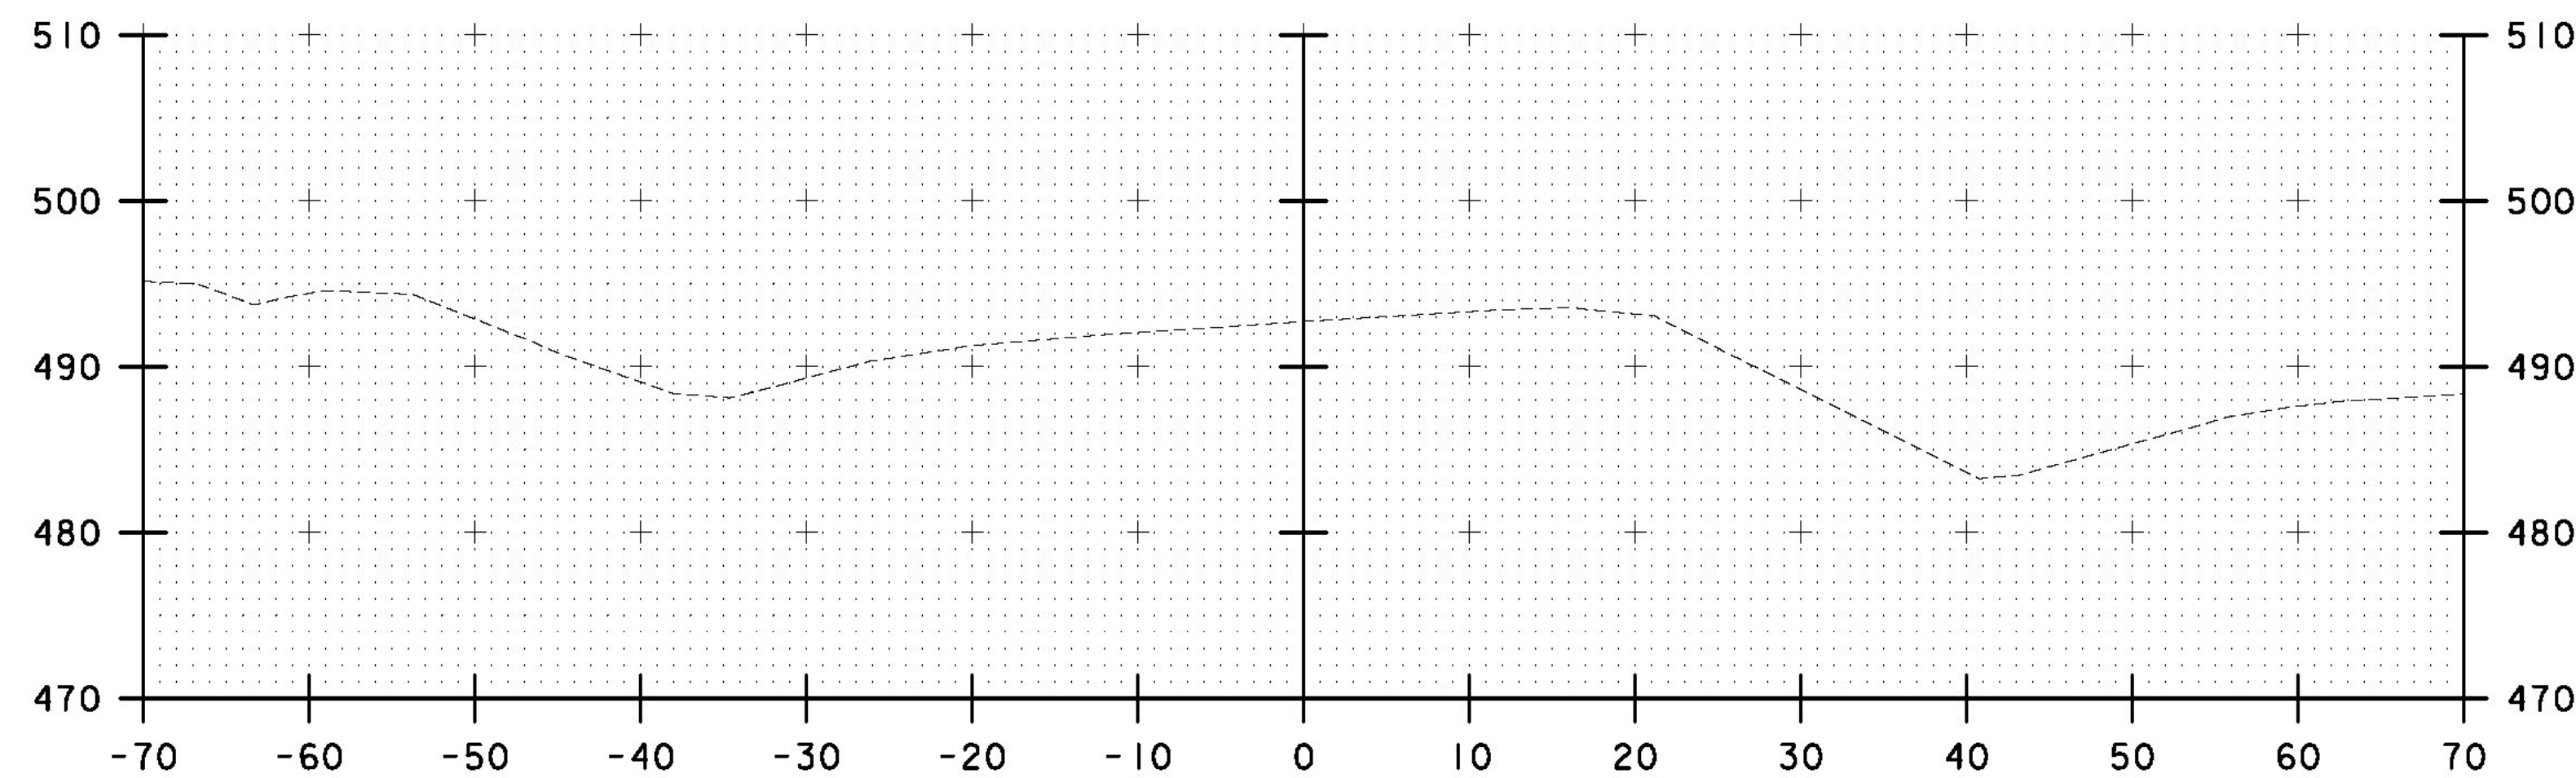

544+00

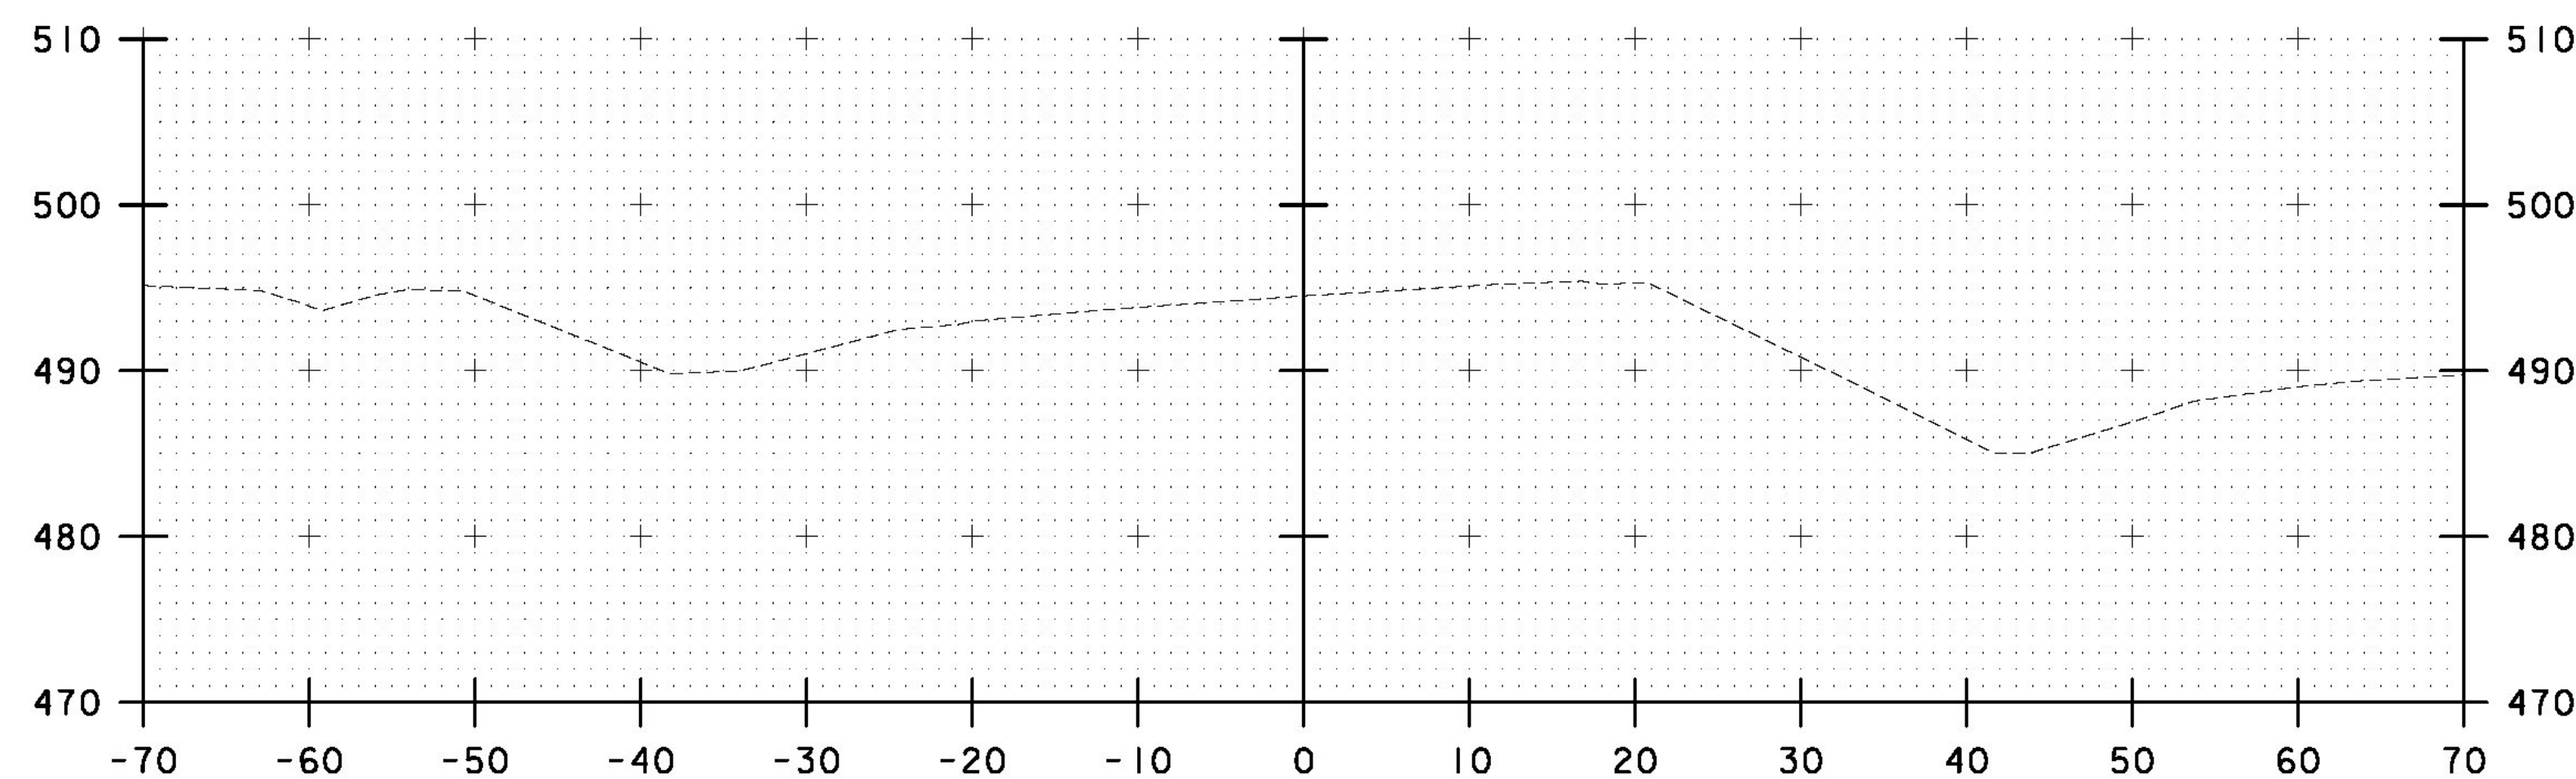

543+50  
 LIMIT OF WORK  
 END MILL AND OVERLAY

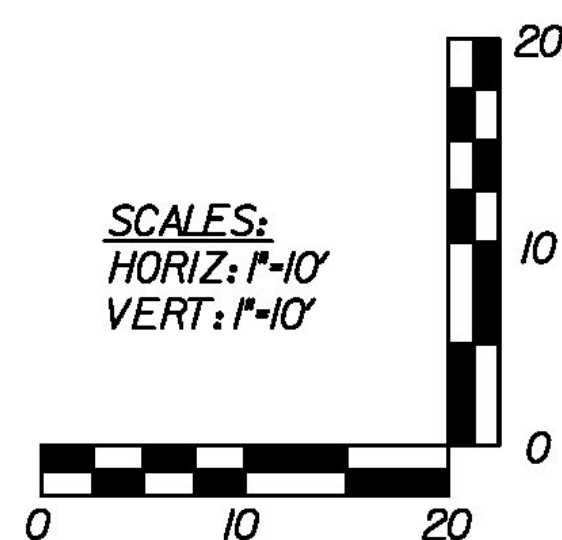

AS BUILT  
 RECORD PLANS

BECK & BELLUCCI, INC.

TYLININTERNATIONAL

STA. 542+00 TO STA. 544+50

PROJECT NAME: BRATTLEBORO

PROJECT NUMBER: IM 091-(150)

FILE NAME: HW-SRA-DGN-900.dgn

PROJECT LEADER: Phillip E. Kendall P.E.

DESIGNED BY: Phillip E. Kendall P.E.

CROSS SECTIONS 3 OF 7

PLOT DATE: 2/22/2013

DRAWN BY: J. Davis

CHECKED BY: D. Bryant, P.E.

SHEET HW-SRA-DGN-903