




564+50

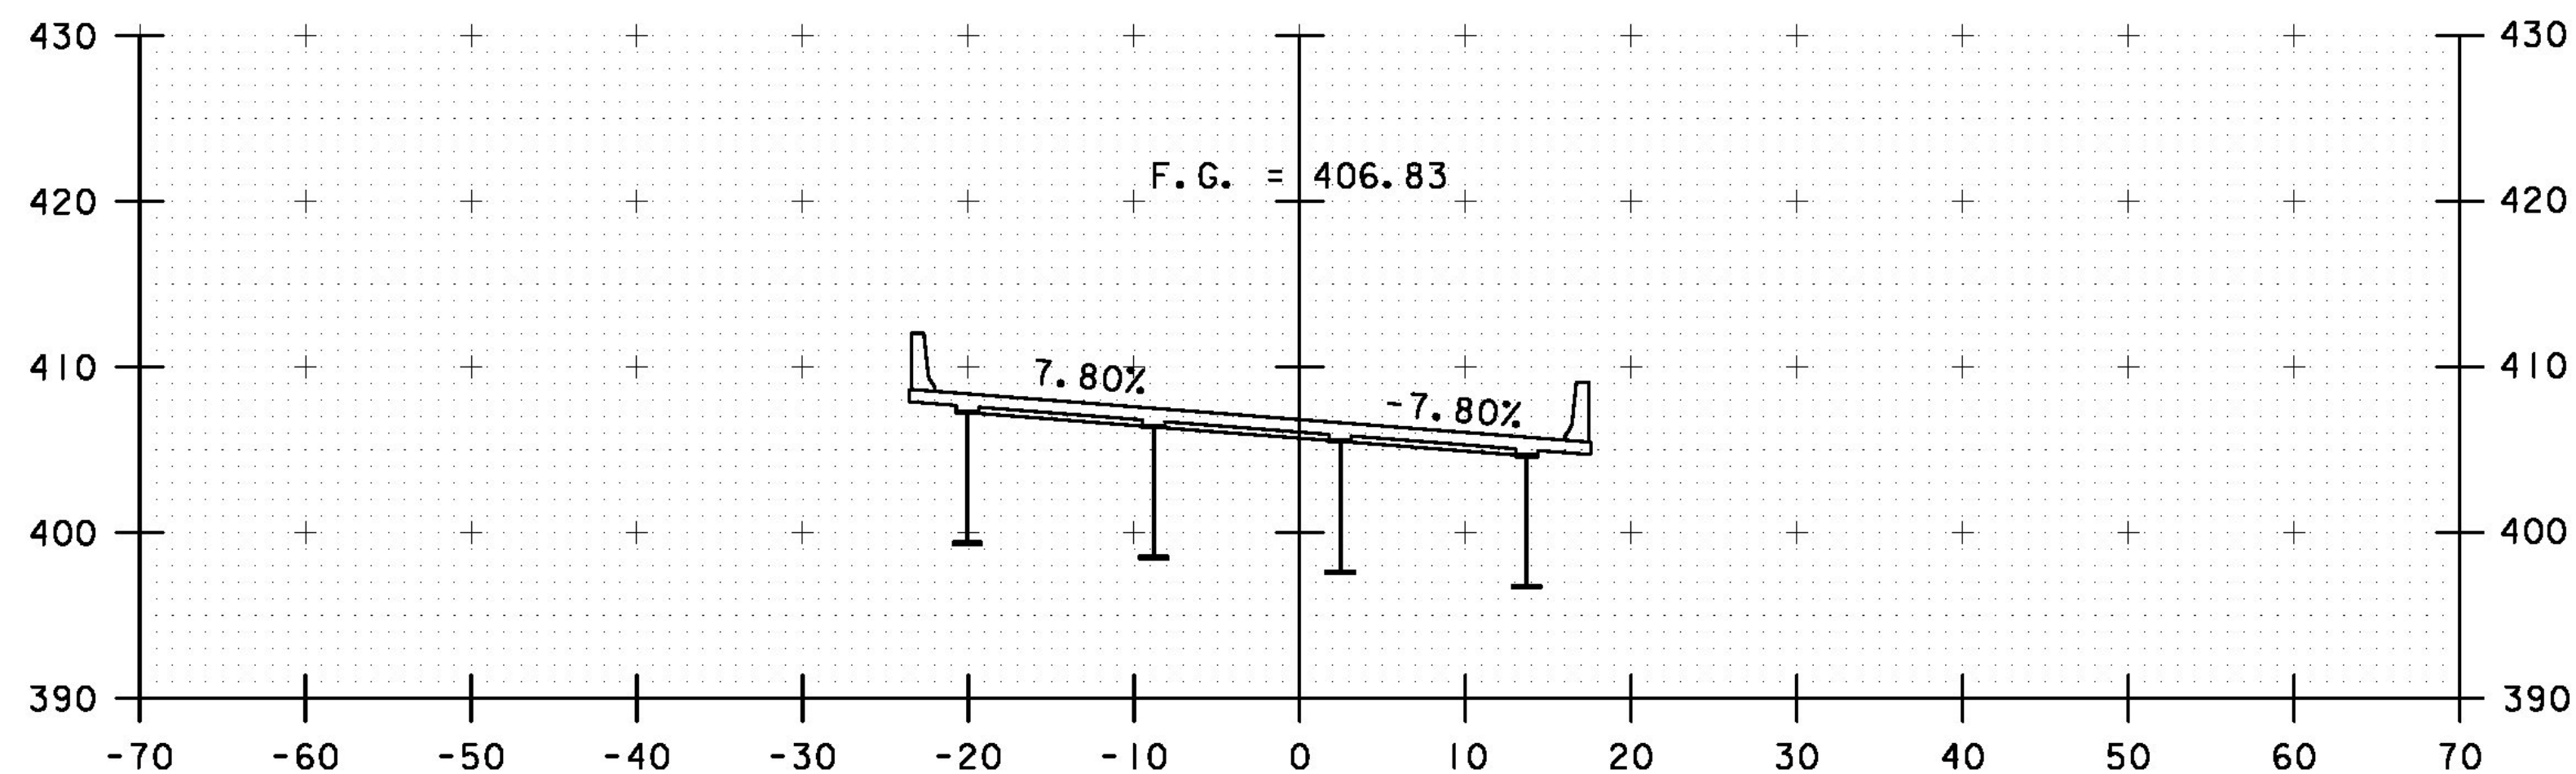


564+00

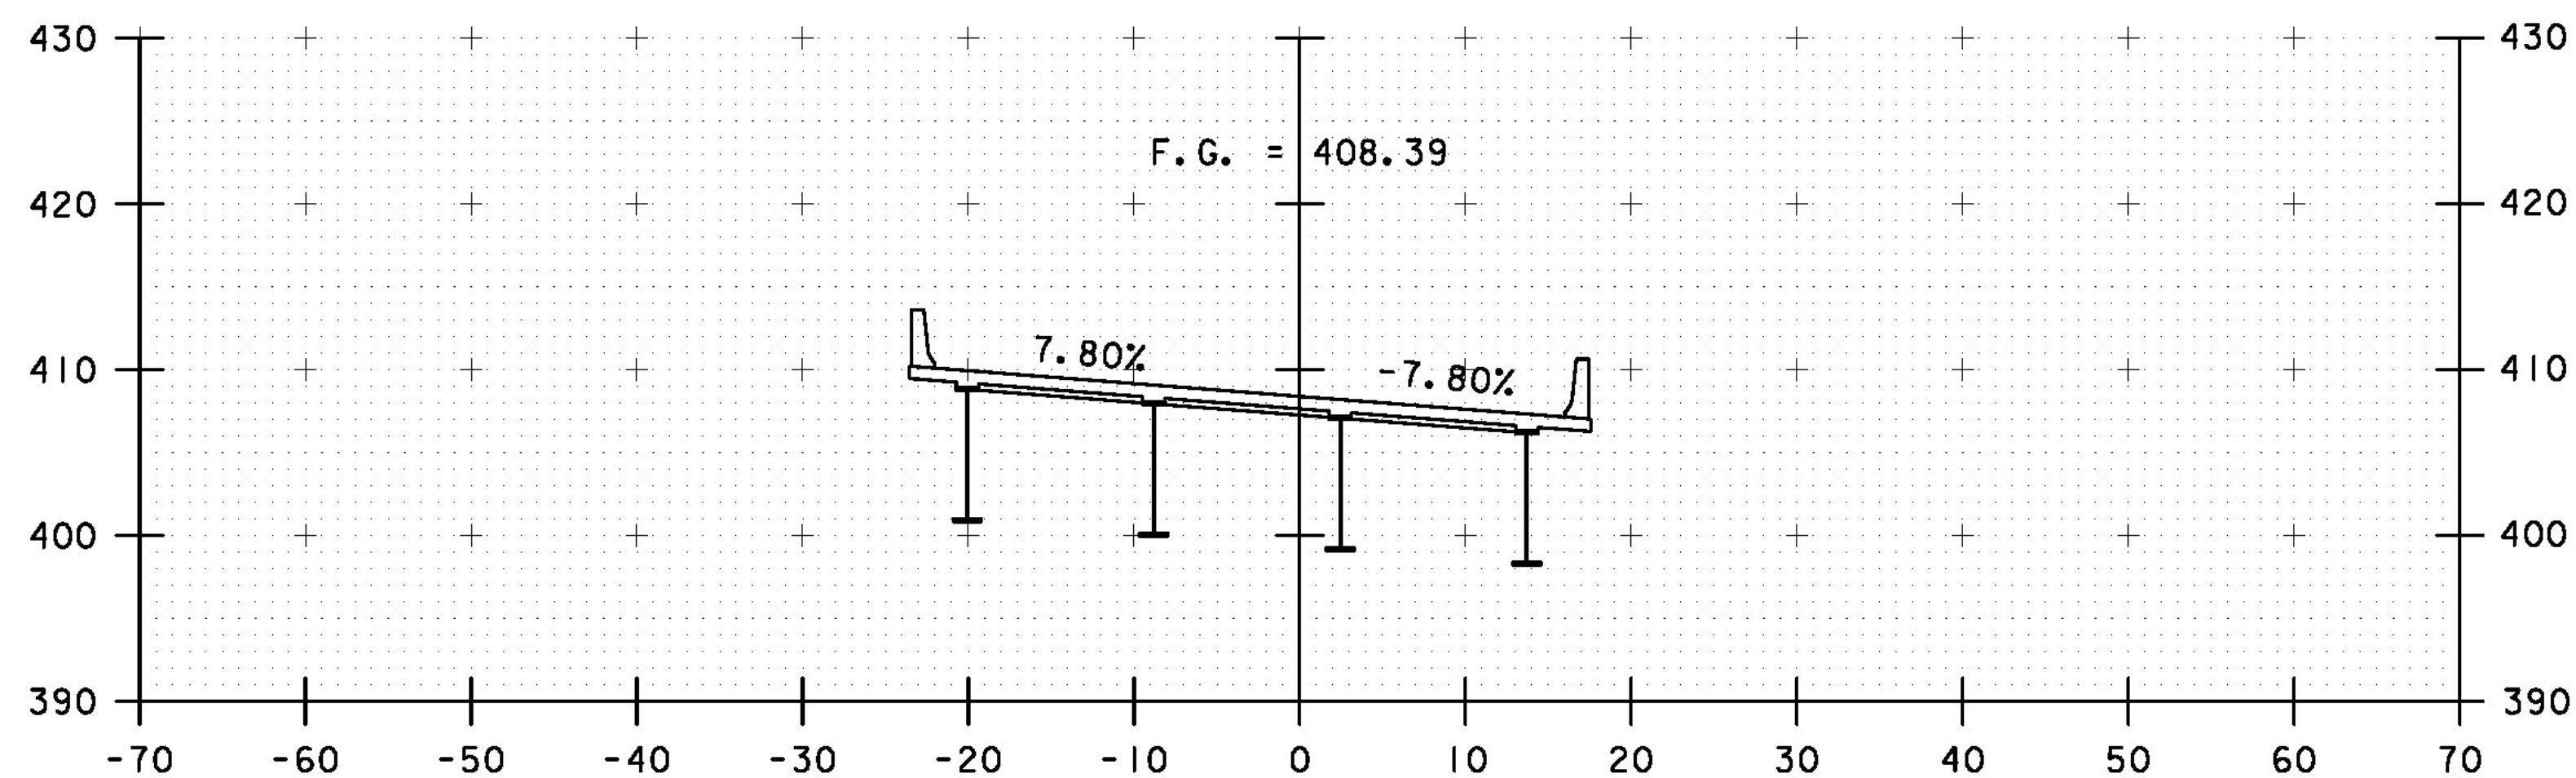


563+50

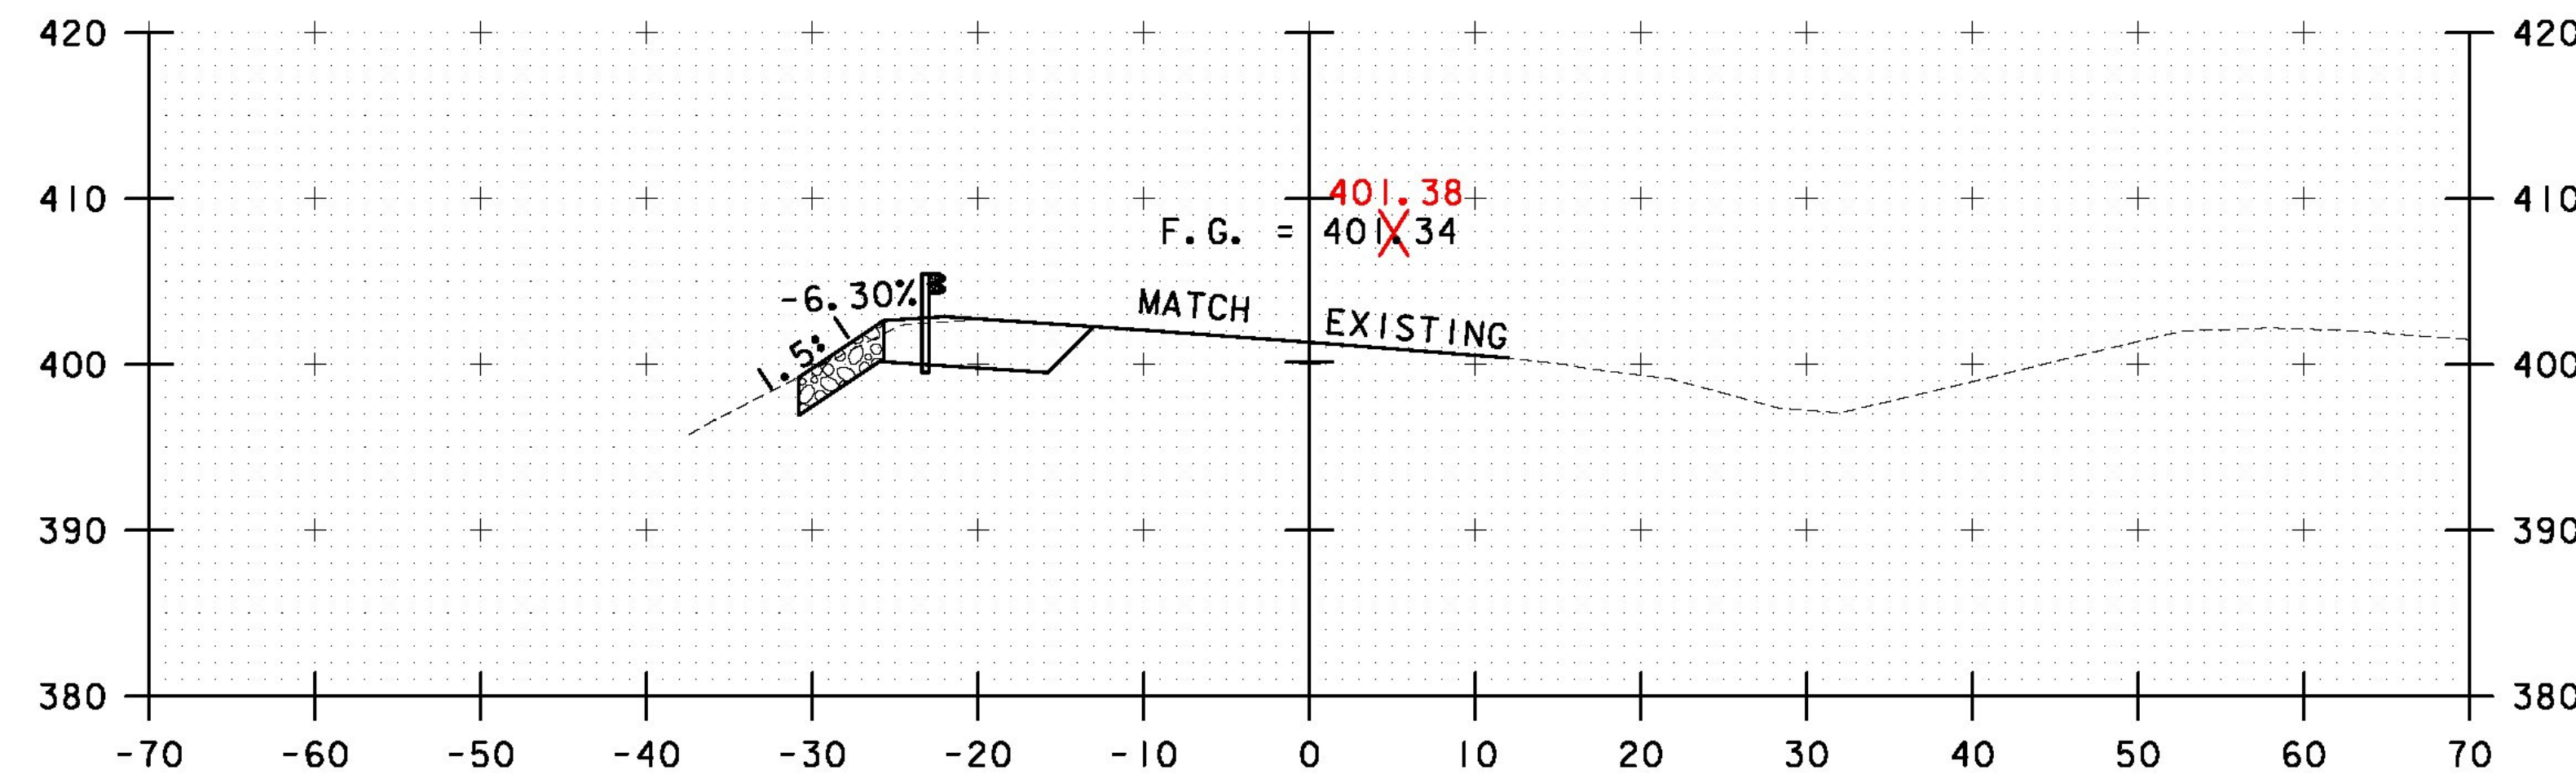


566+00

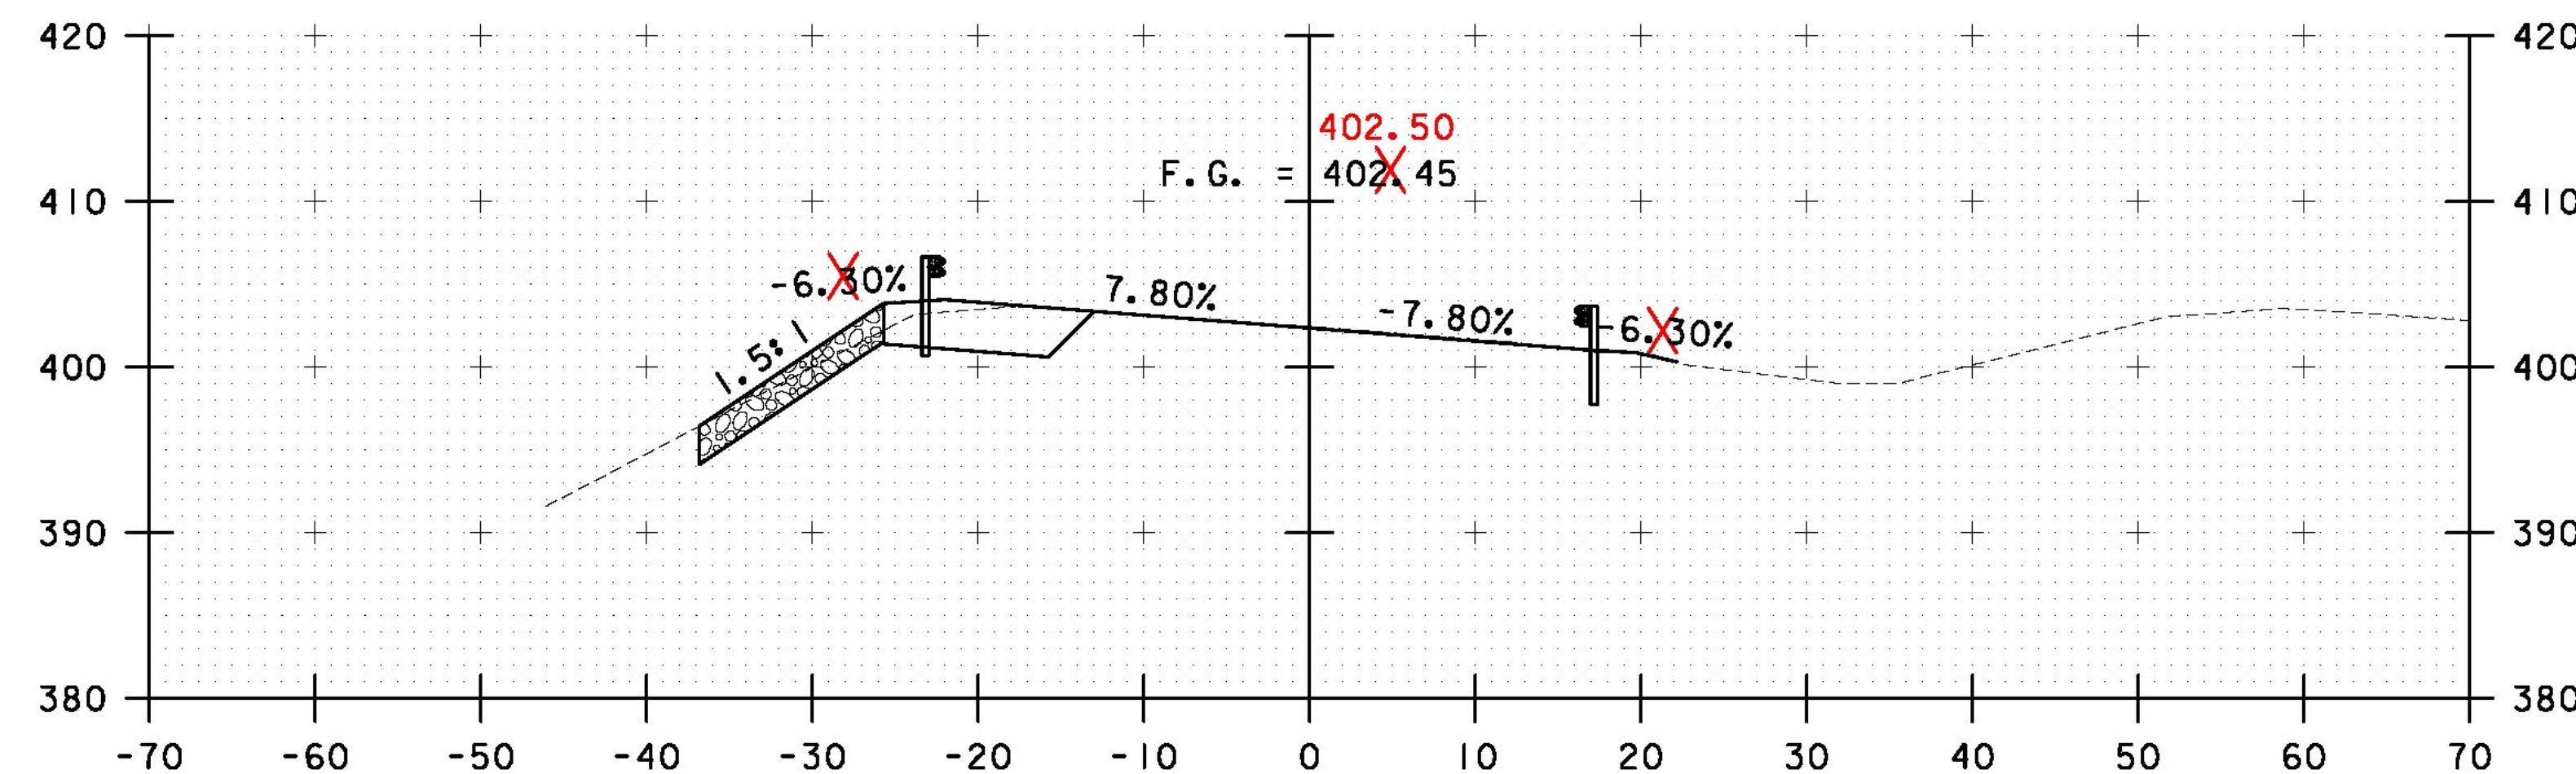

565+50  
END FULL DEPTH CONSTRUCTION  
BEGIN MILL AND OVERLAY

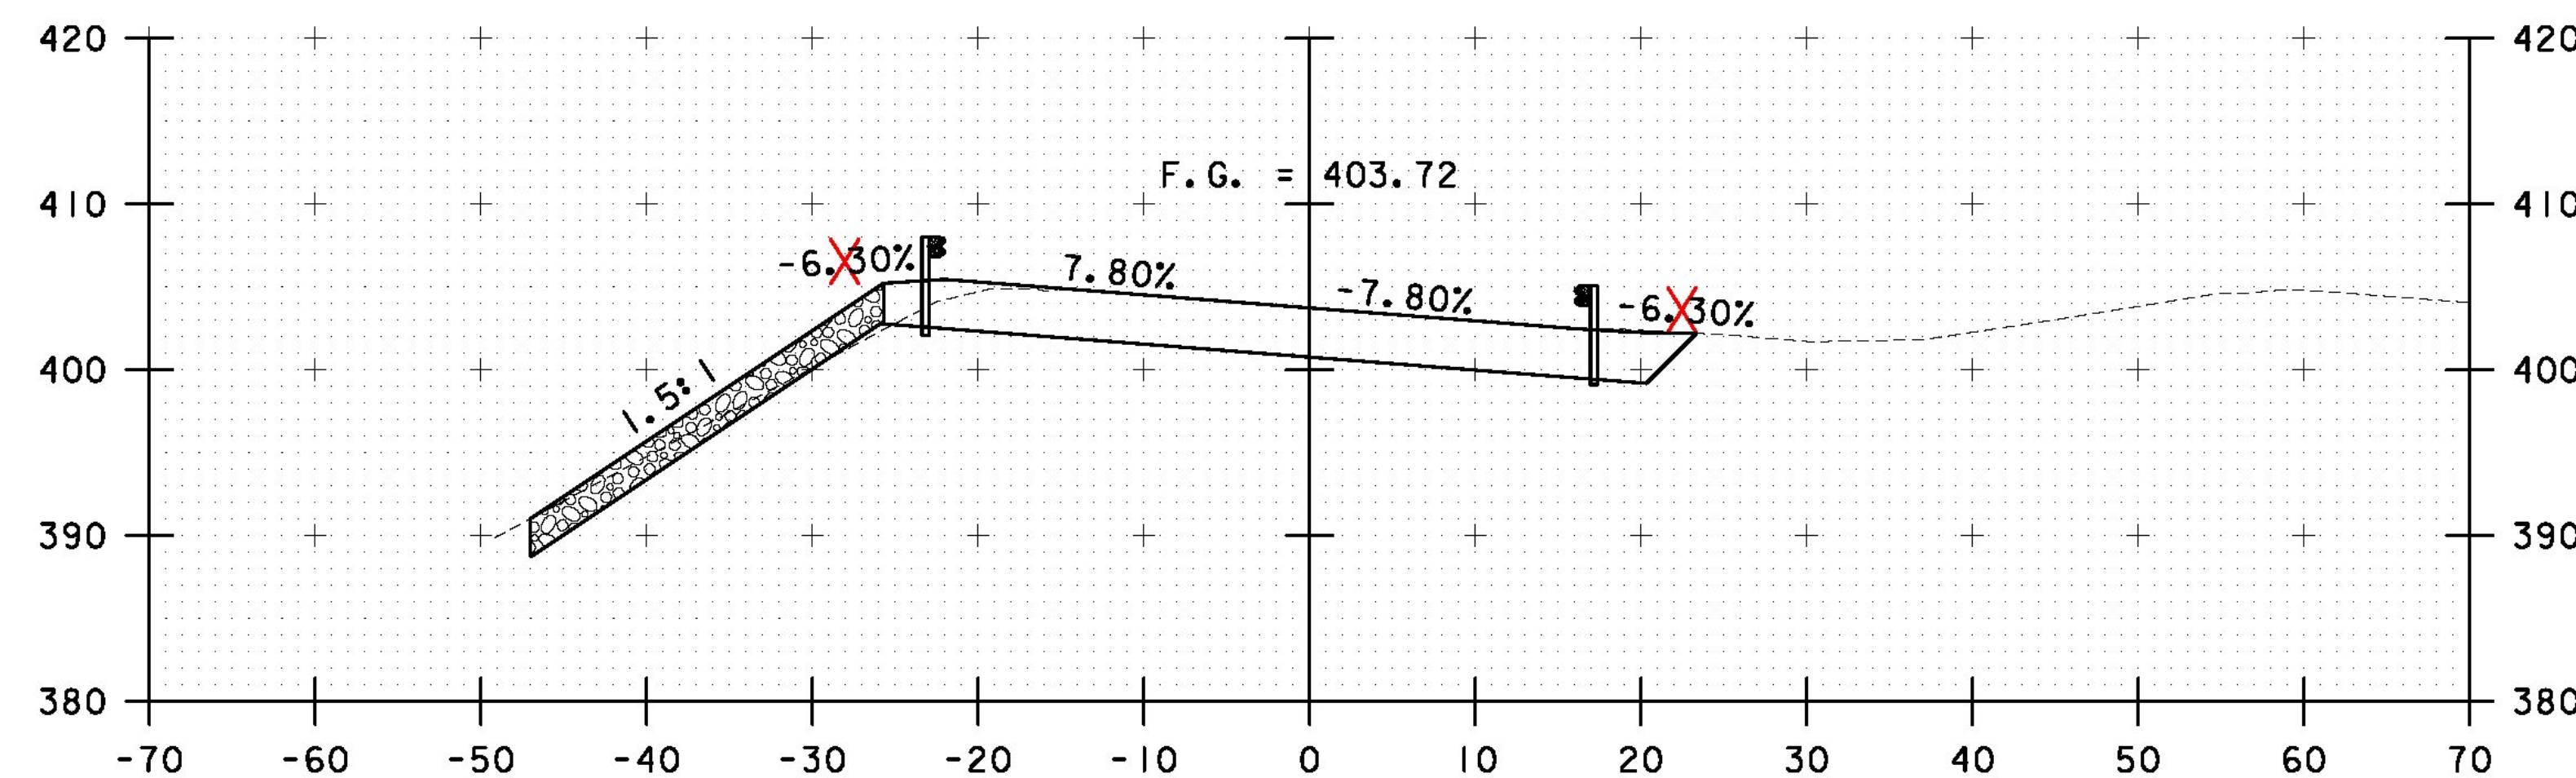

565+00

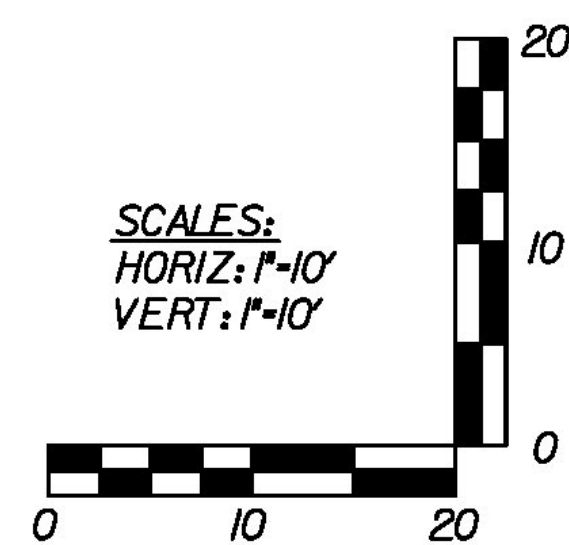

AS BUILT  
RECORD PLANS

BECK & BELLUCCI, INC.

TYLIN INTERNATIONAL

STA. 563+50 TO STA. 566+00

PROJECT NAME: BRATTLEBORO

PROJECT NUMBER: IM 091-(150)

FILE NAME: HW-SRA-DGN-900.dgn

PROJECT LEADER: Phillip E. Kendall P.E.

DESIGNED BY: Phillip E. Kendall P.E.

CROSS SECTIONS 6 OF 7

PLOT DATE: 2/22/2013

DRAWN BY: J. Davis

CHECKED BY: D. Bryant, P.E.

SHEET HW-SRA-DGN-906